


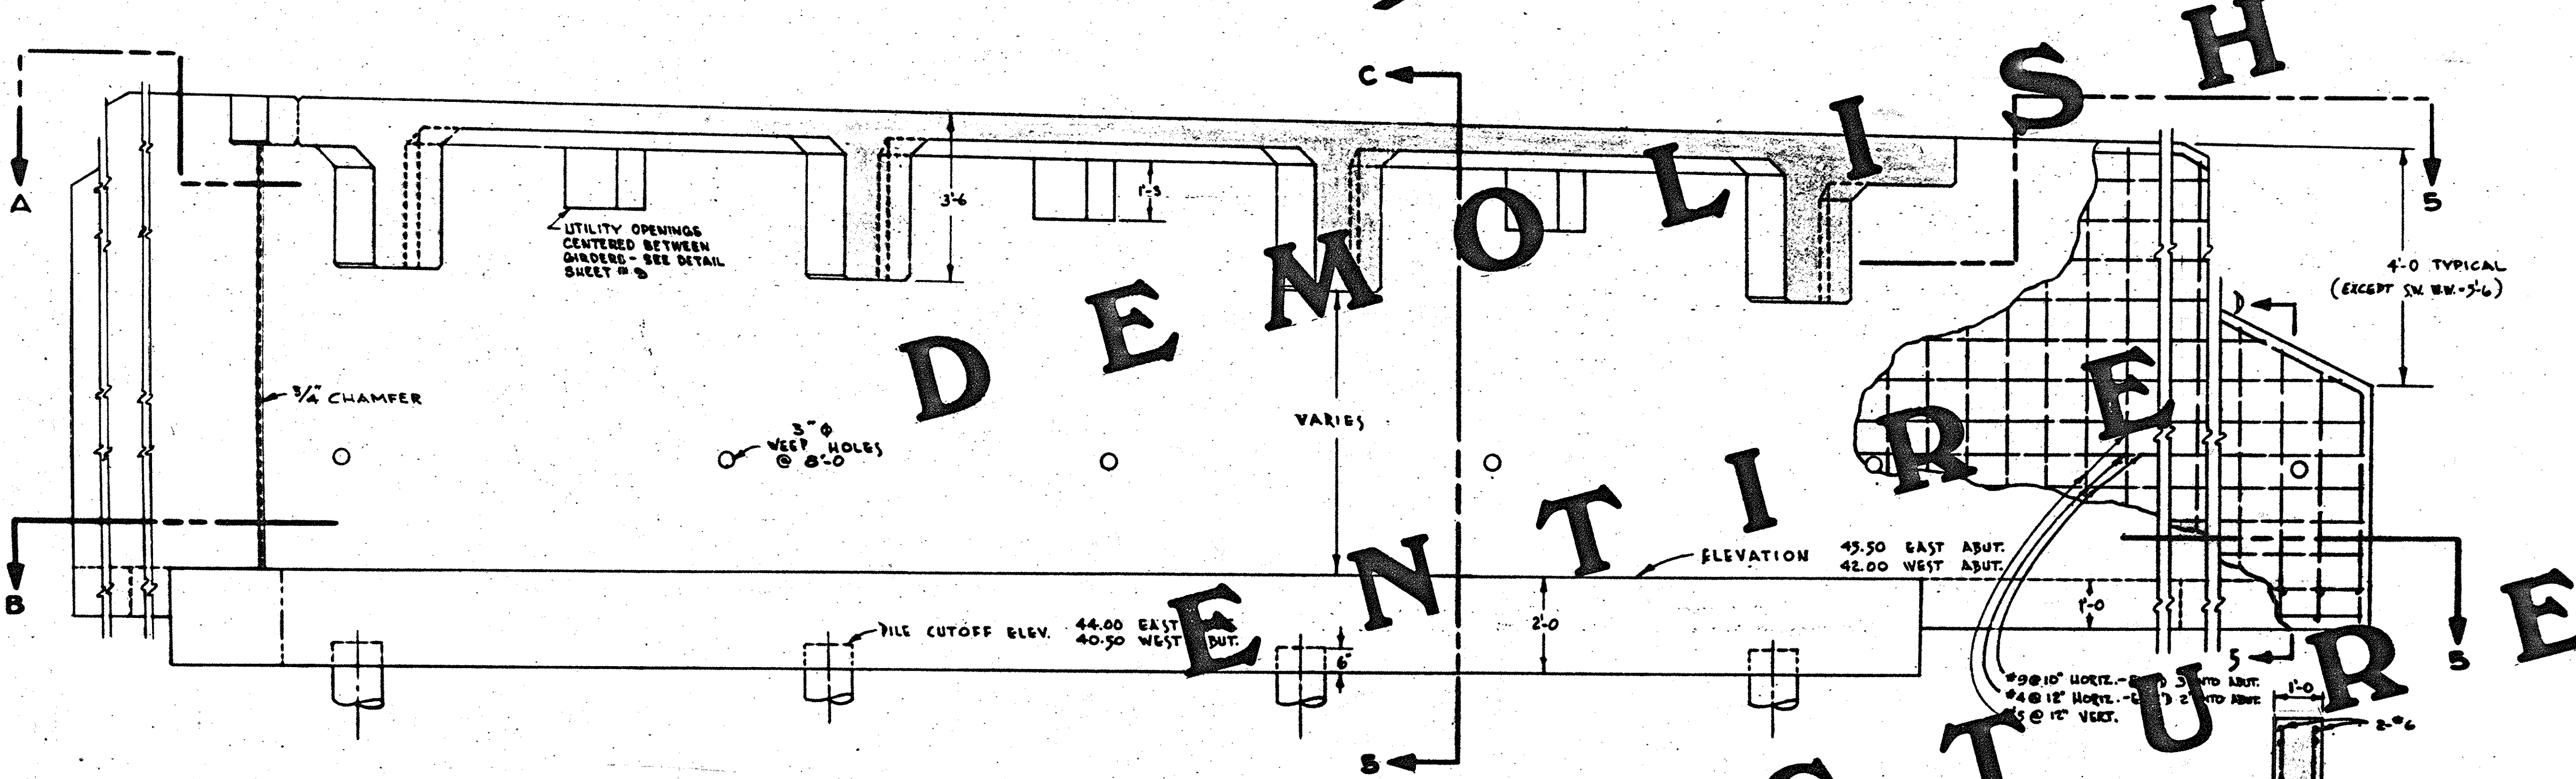


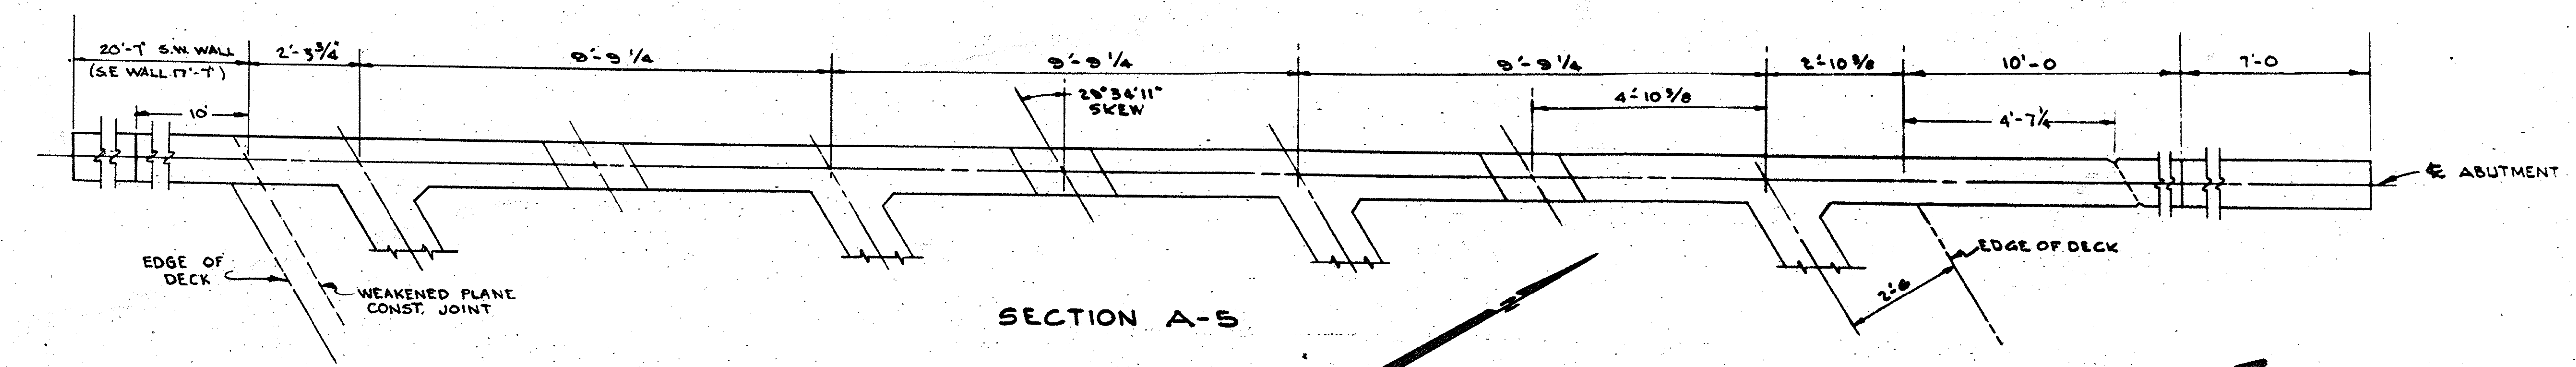

TYPICAL ABUTMENT DETAIL
(WEST ABUTMENT LOOKING WEST)

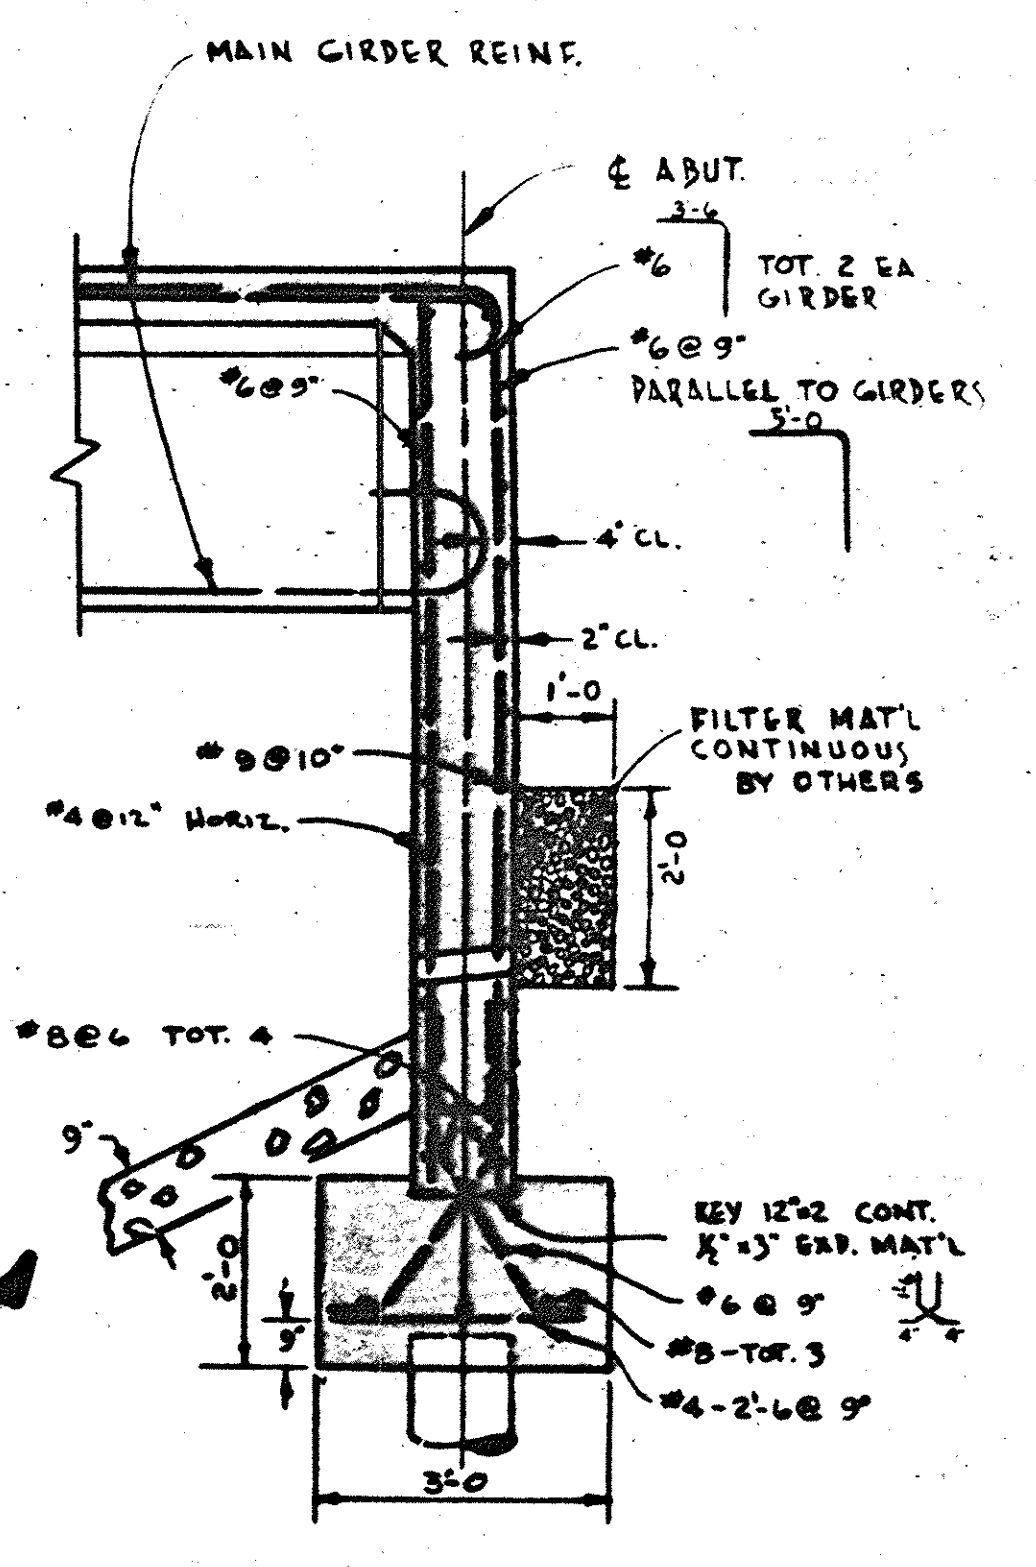

SECTION C-C
NOTE: BLOCK BACK OF UNUSED UTILITY OPENINGS WITH 2" MIN. REDWOOD. EDGE LAD MIN. 3" BY OTHERS

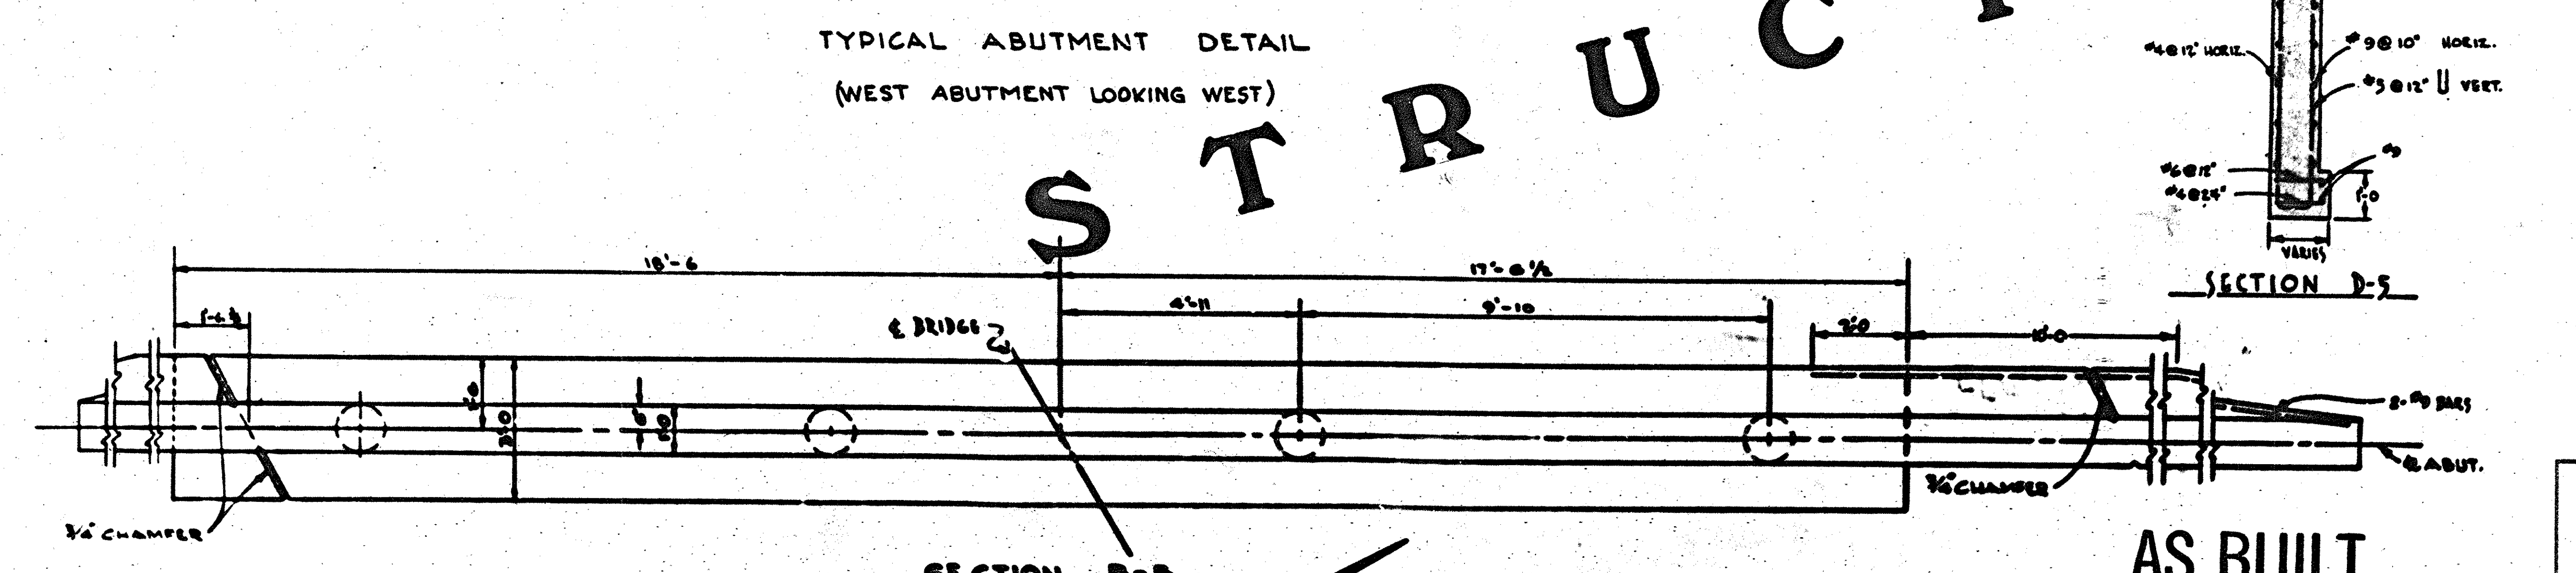

SECTION B-B

AS BUILT

WHILE THE INFORMATION IS BELIEVED TO BE ACCURATE, THE ORANGE COUNTY ENVIRONMENTAL MANAGEMENT AGENCY WILL NOT BE RESPONSIBLE FOR OMISSIONS, ERRORS, OR INACCURACIES.

1 1/2 0 1 2
3 inches on original drawing

ORANGE COUNTY ENVIRONMENTAL MANAGEMENT AGENCY			
TALBERT - MACARTHUR BRIDGE ACROSS SANTA ANA RIVER			
DEMOLITION DETAILS			
DATE	DESCRIPTION	PREPARED UNDER SUPERVISION OF	DATE
7/61	AS BUILT	John A. [Signature]	7/61
DESIGNED	CHECKED	SCALE	DWG. NO.
		AS SHOWN	7/61