
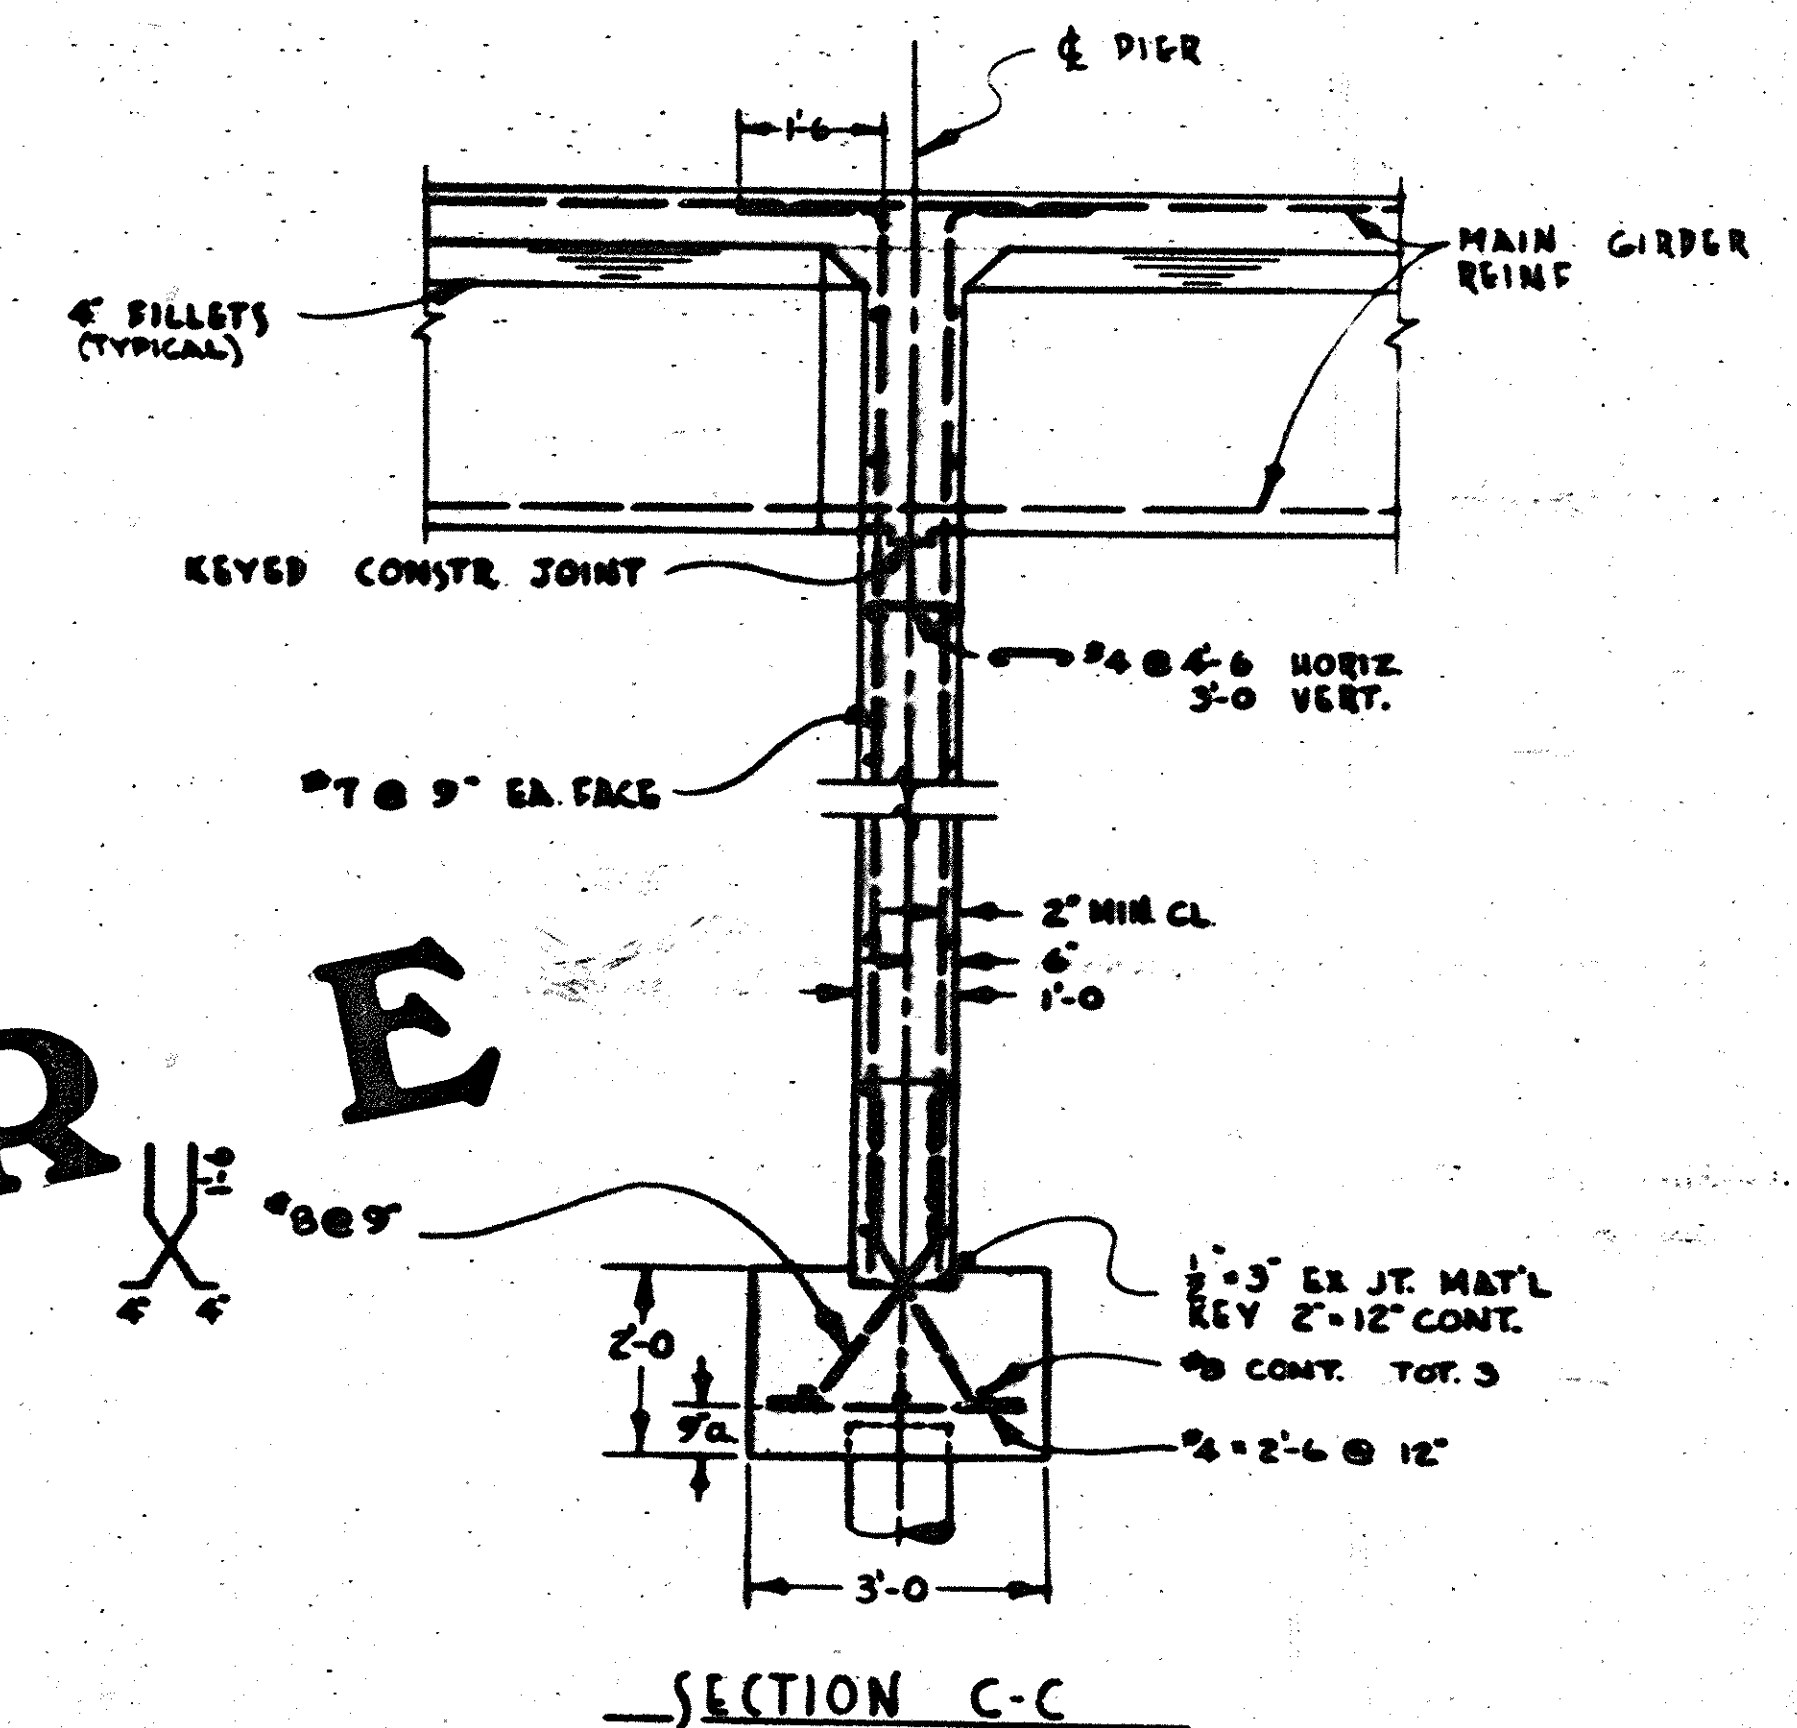
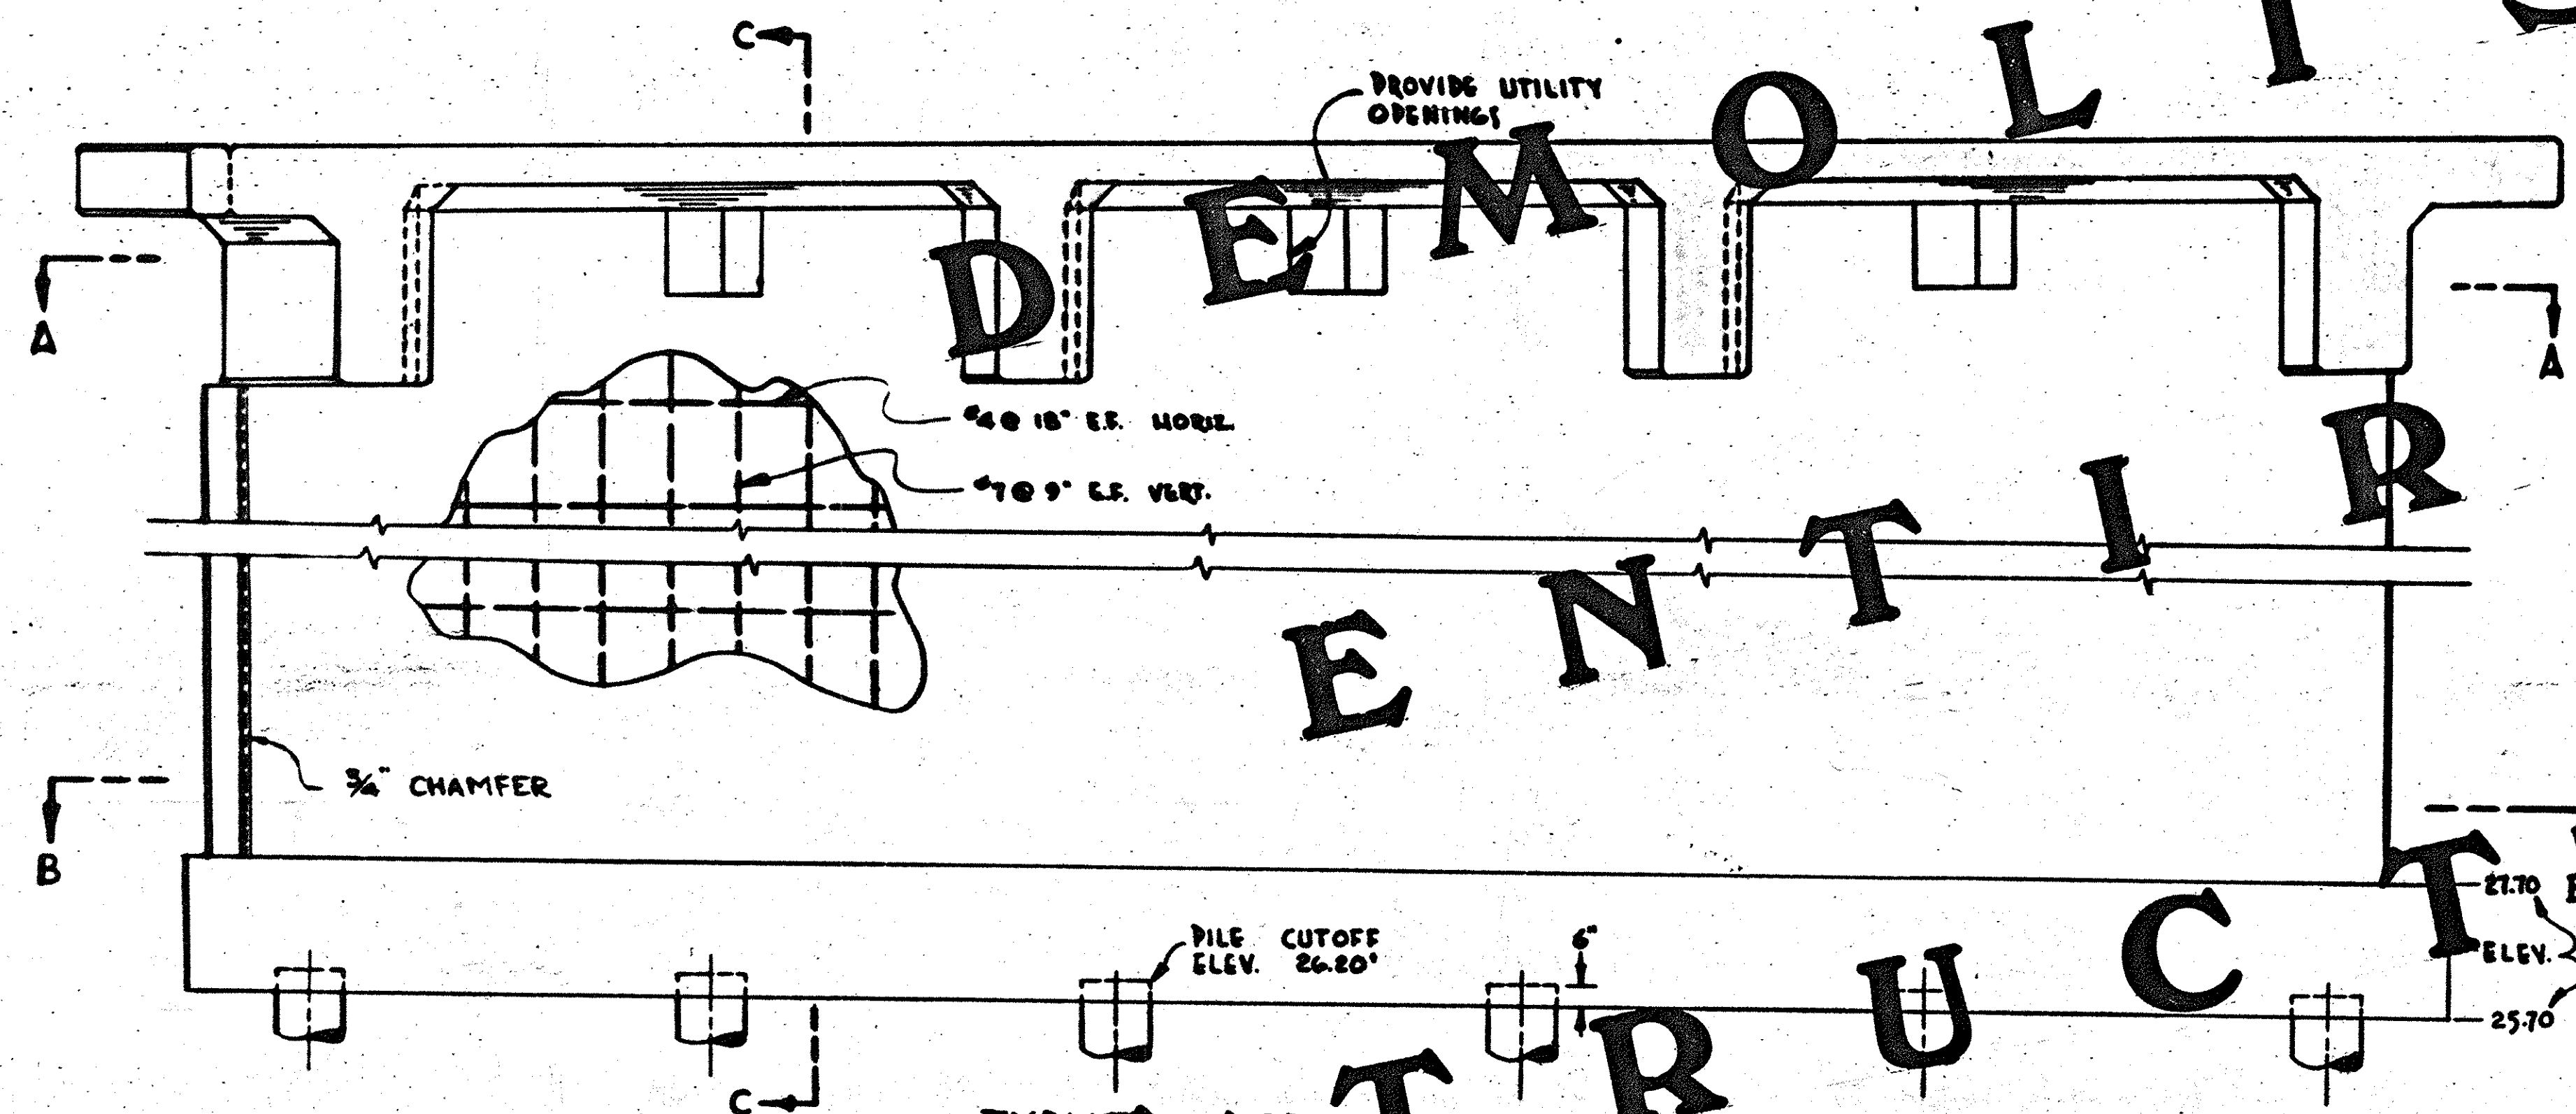


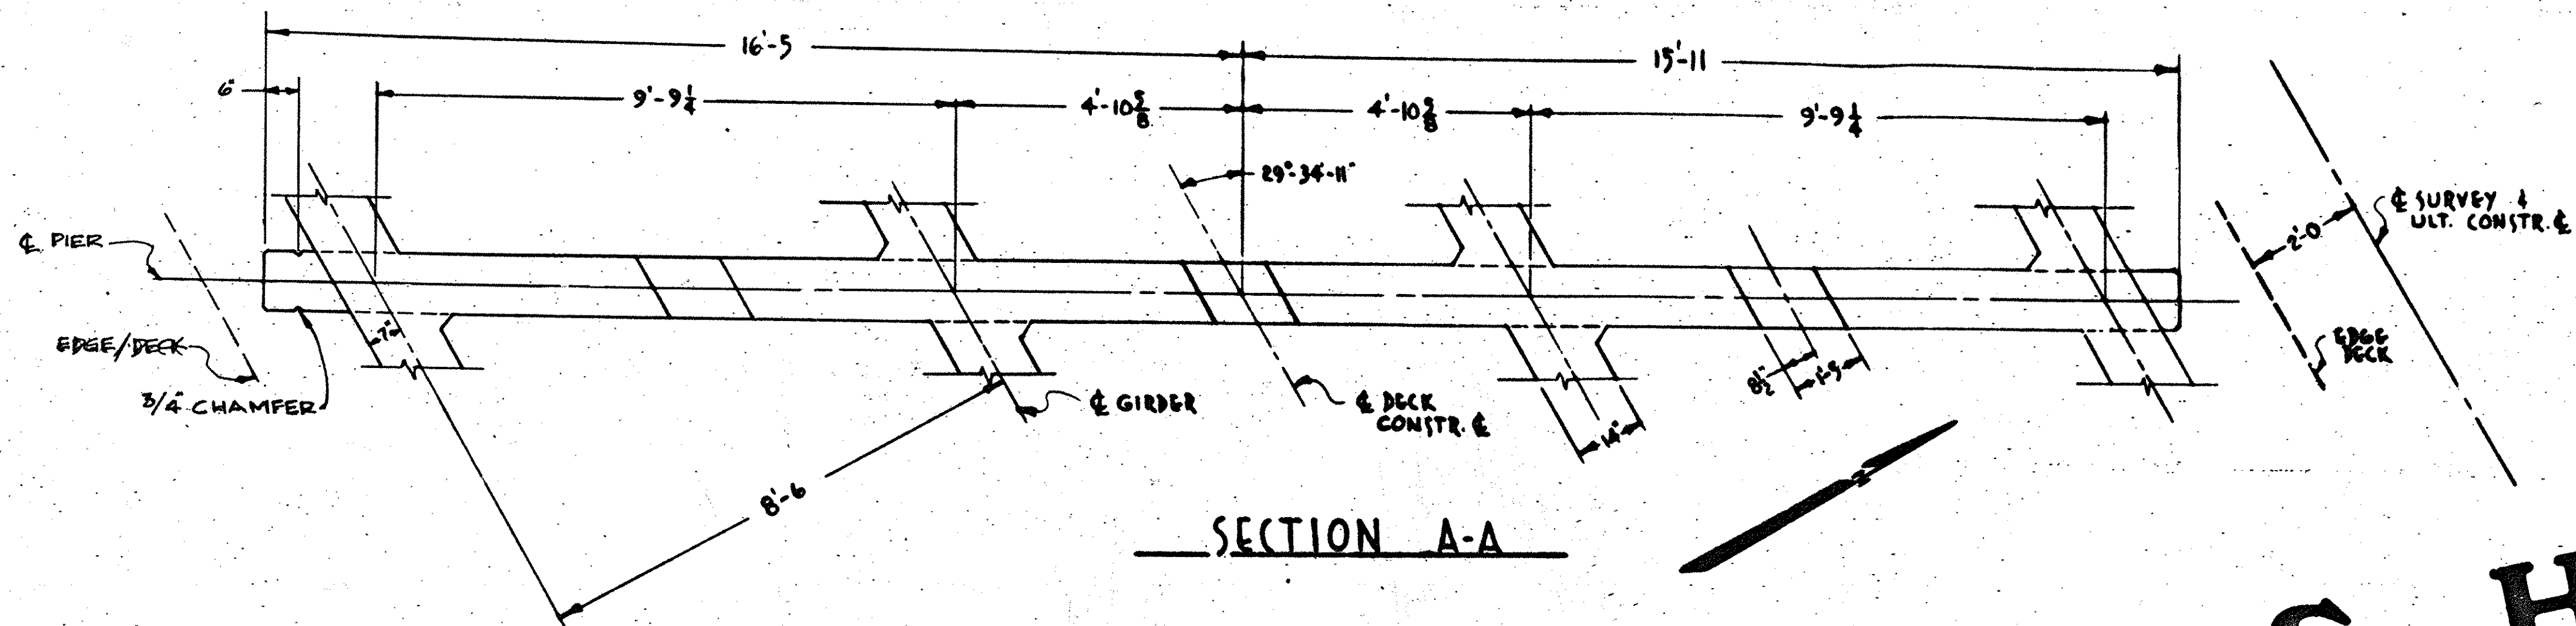

1/2 0 1 2
3 inches on original drawing

AS BUILT
WHILE THE INTENT OF THIS DRAWING IS BELIEVED TO BE ACCURATE, THE ORANGE COUNTY ENVIRONMENTAL MANAGEMENT AGENCY WILL NOT BE RESPONSIBLE FOR OMISSIONS, ERRORS, OR INACCURACIES.

ORANGE COUNTY ENVIRONMENTAL MANAGEMENT AGENCY			
TALBERT — MACARTHUR BRIDGE ACROSS SANTA ANA RIVER			
DEMOLITION DETAILS			
DATE	DESCRIPTION	PREPARED UNDER SUPERVISION OF	SHEET
7/61	AS BUILT	John A. [Signature]	23
DESIGNED	CHECKED	SCALE	DATE
		AS SHOWN	7/61
DRAWN	CHECKED	DWG. NO.	