






DIST	COUNTY	ROUTE	KILOMETER TOTAL PROJECT	POST SHEET No	TOTAL SHEETS
12	Ora	241	30.1	2	19

Richard W. Hoisington, Jr.
REGISTERED CIVIL ENGINEER
No. 42267
Exp. 3/31/00
CIVIL
STATE OF CALIFORNIA

PLANS APPROVAL DATE
COUNTY OF ORANGE
PUBLIC FACILITIES & RESOURCES DEPT.
300 N. FLOWER STREET
SANTA ANA, CA 92703-5000

The State of California or its officers or agents shall not be responsible for the accuracy or completeness of electronic copies of this plan sheet.

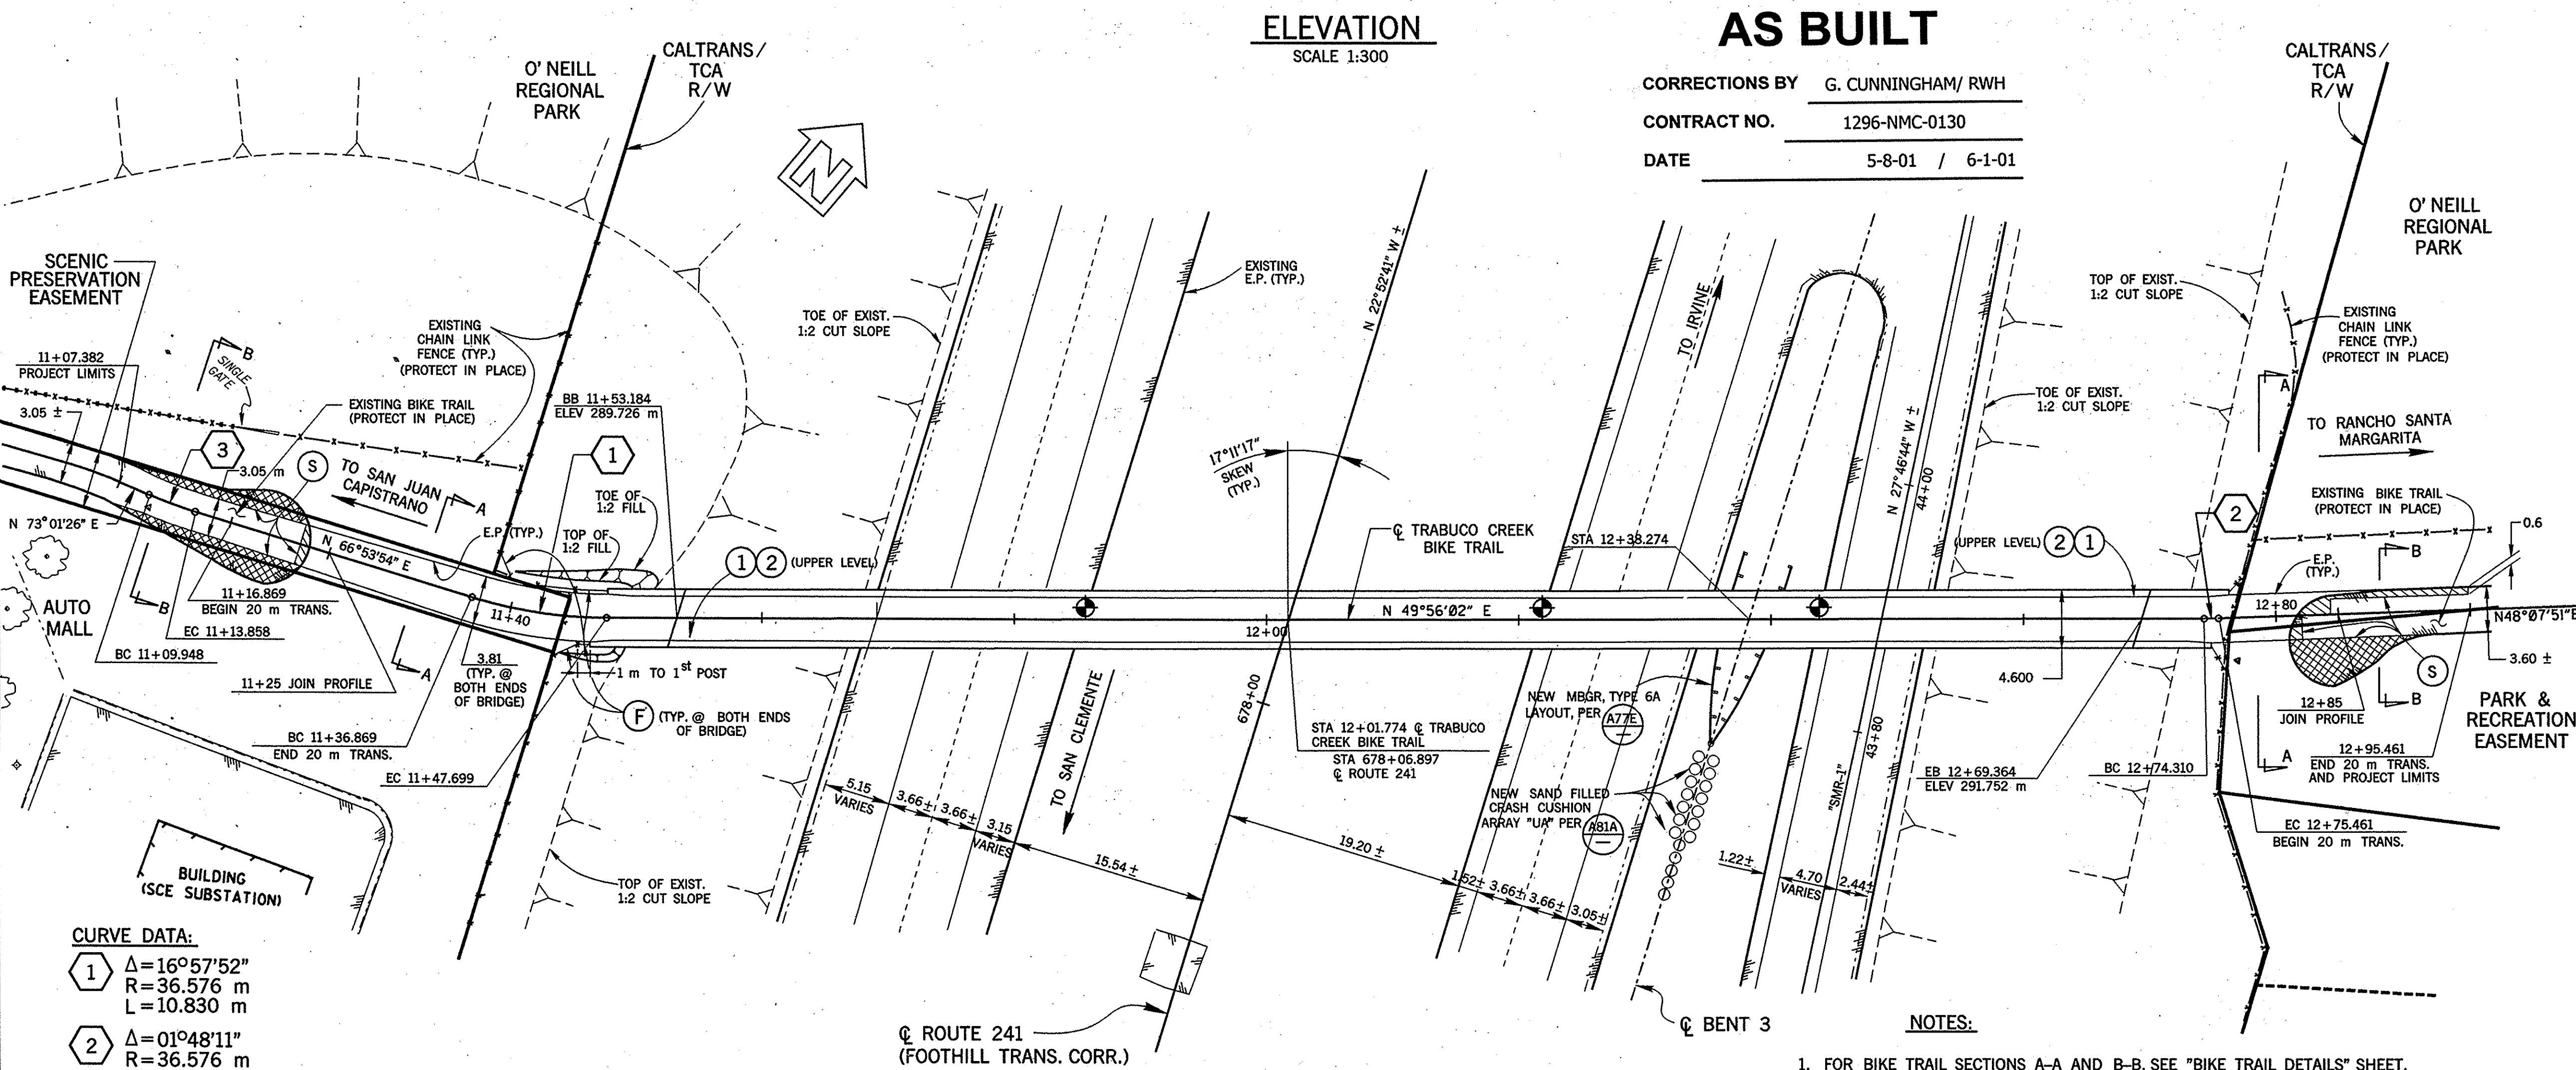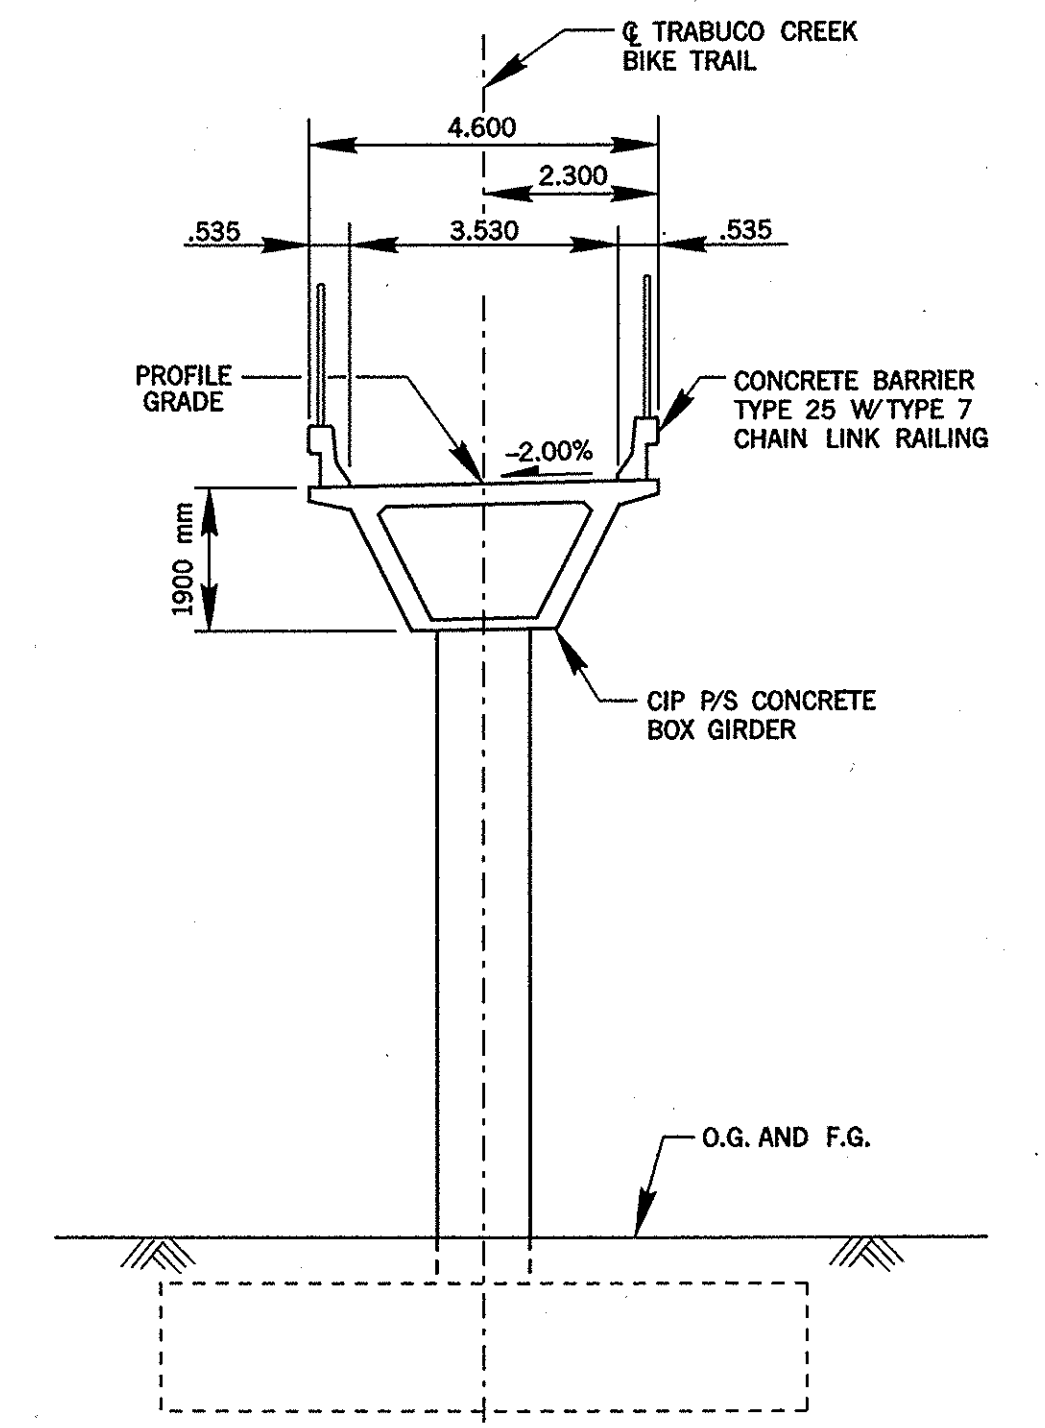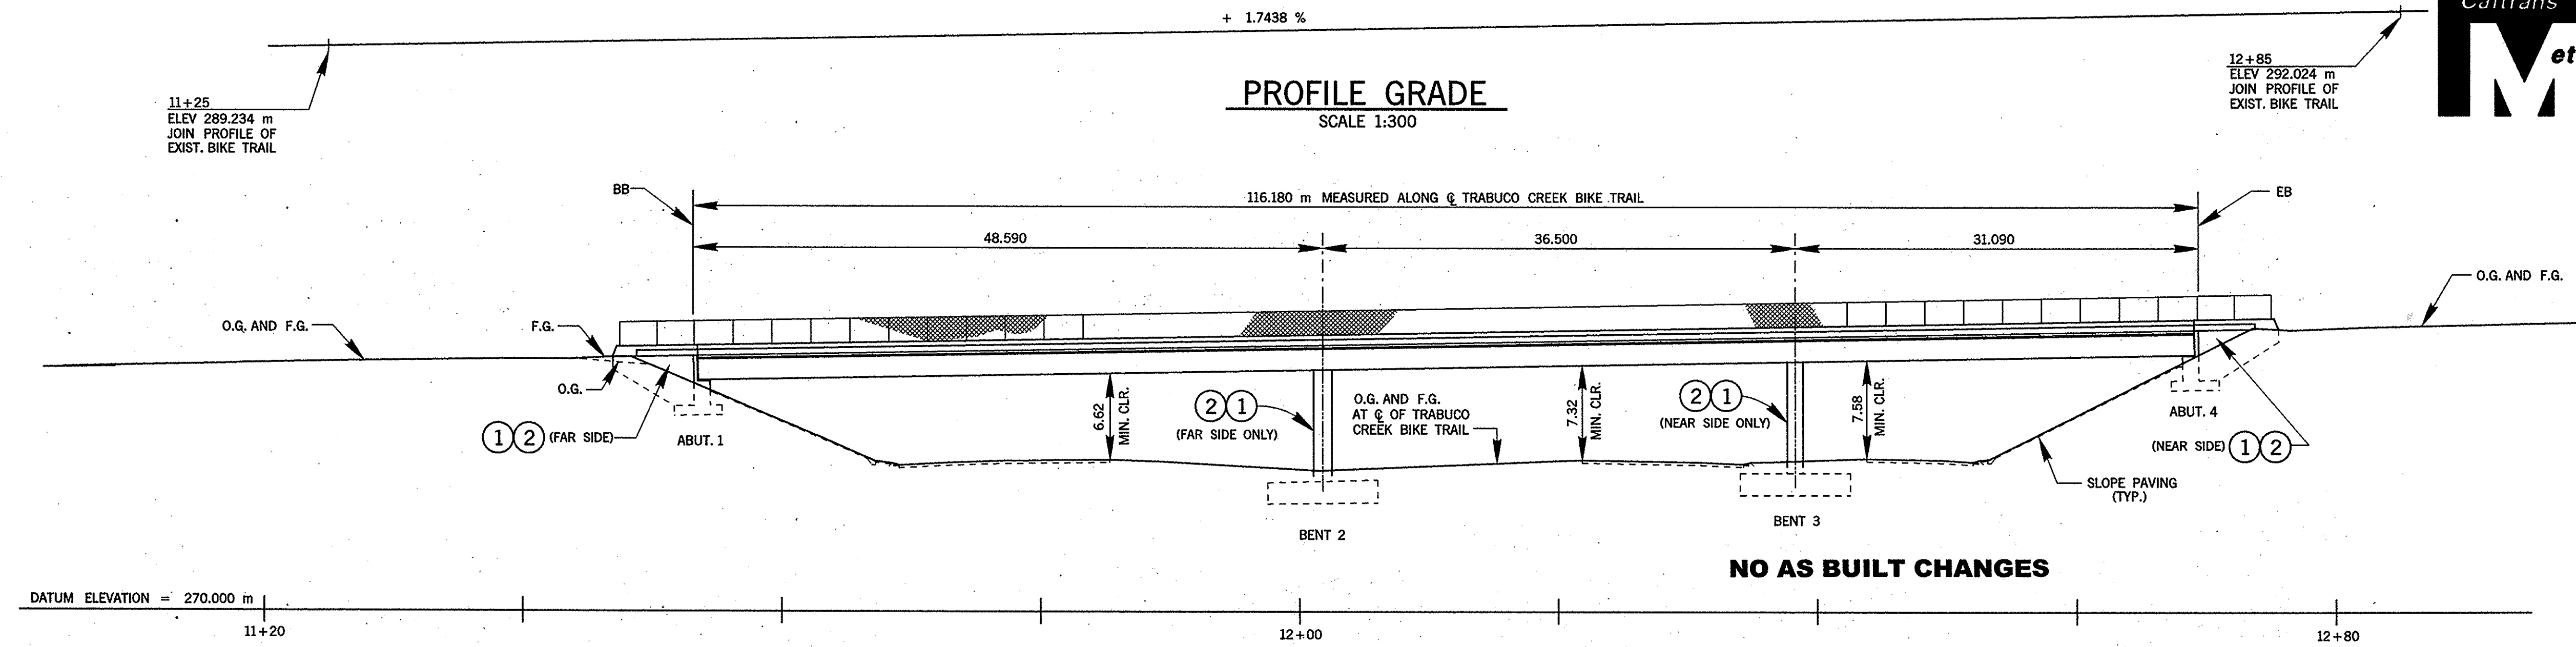

- TYPICAL SECTION**
SCALE 1:100
- LEGEND**
- 1 PAINT BRIDGE NO. 55-953
 - 2 PAINT "TRABUCO CREEK BIKE TRAIL OVERCROSSING" AND YEAR COMPLETED
 - POINT OF MINIMUM CLEARANCE
 - REMOVE EXISTING A.C. PAVEMENT. CONSTRUCT NEW A.C. BIKE PATH STRUCTURAL SECTION. (SEE "FOUNDATION PLAN".)
 - REMOVE EXISTING A.C. PAVEMENT. BACKFILL WITH EMBANKMENT MATERIAL TO MATCH ADJACENT FINISHED GRADE AS PER BIKE PATH STRUCTURAL SECTION (SEE "FOUNDATION PLAN".) AND COMPACT TO 90% R.C.
 - S SAWCUT EXISTING A.C. PAVEMENT AS SHOWN. MIN. DISTANCE FROM SAWCUT TO EXISTING E.P.=0.3 m. ALL SAWCUTS SHALL BE EITHER PARALLEL OR PERPENDICULAR TO Q BIKE TRAIL.
 - F INSTALL NEW 1.83 m CHAIN LINK FENCE PER CONNECTING BETWEEN EXISTING 1.83 m CHAIN LINK FENCE AND NEW BRIDGE CHAIN LINK RAILING. TIE-IN NEW FENCE TO EXISTING BY APPROXIMATELY BISECTING THE ANGLE BETWEEN THEM, AS SHOWN. REMOVE ABANDONED PORTIONS OF EXISTING 1.83 m CHAIN LINK FENCE IN BETWEEN TIE-IN POINTS.

- CURVE DATA:**
- 1 $\Delta=16^{\circ}57'52''$
R=36.576 m
L=10.830 m
 - 2 $\Delta=01^{\circ}48'11''$
R=36.576 m
L=1.151 m
 - 3 $\Delta=06^{\circ}07'32''$
R=36.576 m
L=3.910 m

- NOTES:**
- FOR BIKE TRAIL SECTIONS A-A AND B-B, SEE "BIKE TRAIL DETAILS" SHEET. FOR APPROACH SECTION, SEE "ABUTMENT DETAILS No. 1" SHEET.
 - FOR GENERAL NOTES, SEE "DECK CONTOURS" SHEET.
 - FOR DECK DRAINS SEE "GIRDER LAYOUT" SHEET.

ALL DIMENSIONS ARE IN METERS UNLESS OTHERWISE SHOWN

DESIGN OVERSIGHT STEVE NAKAO 6/2/99 SIGN OFF DATE	DESIGN BY RICH HOISINGTON DETAILS BY RICH HOISINGTON QUANTITIES BY RICH HOISINGTON	CHECKED JOHN SARAH, McLEAN & SCHULTZ CHECKED JOHN SARAH, McLEAN & SCHULTZ CHECKED JOHN SARAH, McLEAN & SCHULTZ	LOAD FACTOR DESIGN LIVE LOADING: HS20-44 AND PEDESTRIAN LOAD LAYOUT BY RICH HOISINGTON SPECIFICATIONS BY RICH HOISINGTON	PREPARED FOR THE STATE OF CALIFORNIA DEPARTMENT OF TRANSPORTATION	RICH HOISINGTON PROJECT ENGINEER	BRIDGE NO. 55-953 KILOMETER POST 30.1	TRABUCO CREEK BIKE TRAIL OVERCROSSING GENERAL PLAN	REVISION DATES (PRELIMINARY STAGE ONLY) 3/31/99 5/24/99	SHEET 2 OF 19
--	--	--	--	--	-------------------------------------	--	---	--	---------------

FILE -> \$REQUEST
d:\cadd\metric\trabuco\generalplan.dgn (3D)

CU
EA

DISREGARD PRINTS BEARING
EARLIER REVISION DATES

DATE PLOTTED -> \$DATE
05/13/99

TIME PLOTTED -> \$TIME
4:00 PM

USER
H.P.

Scale 300:1