


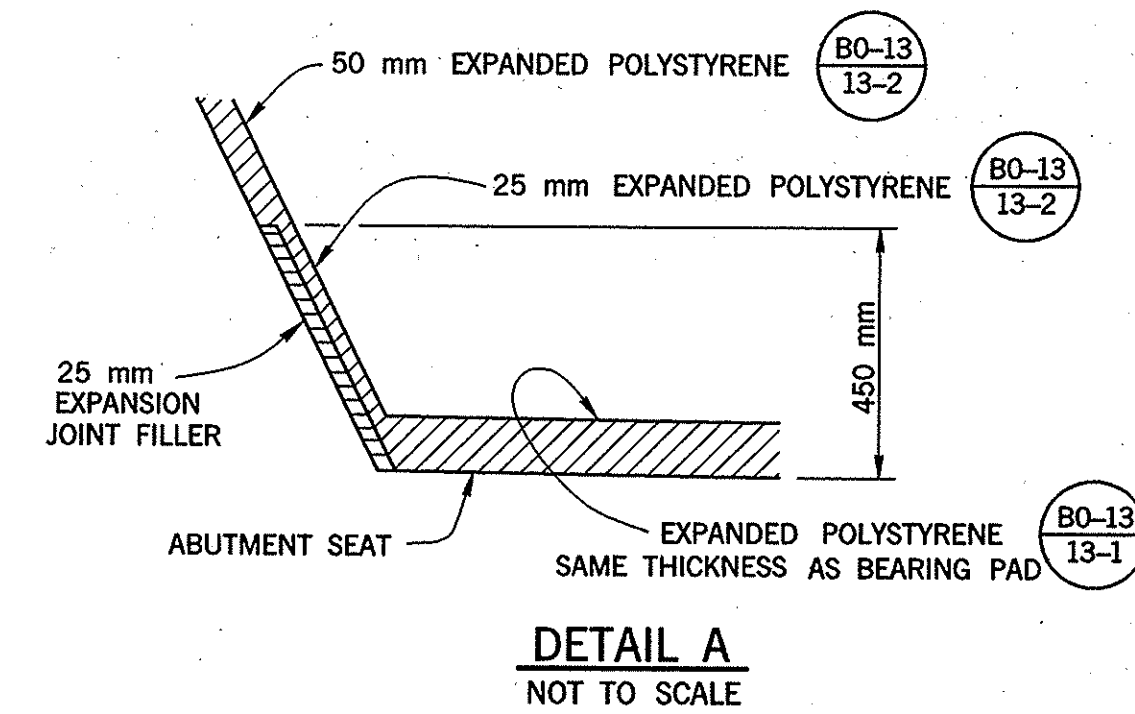


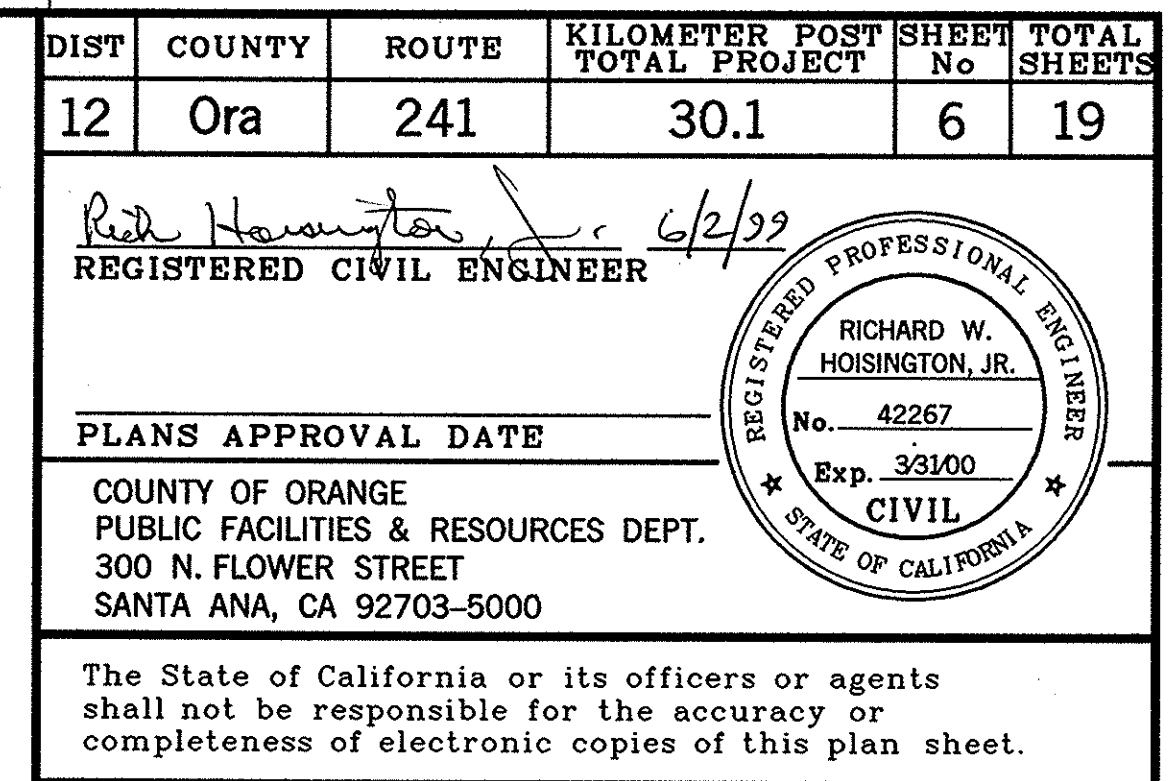

CORRECTIONS BY G. CUNNINGHAM/ RWH
CONTRACT NO. 1296-NMC-0130
DATE 5-8-01 / 6-1-01

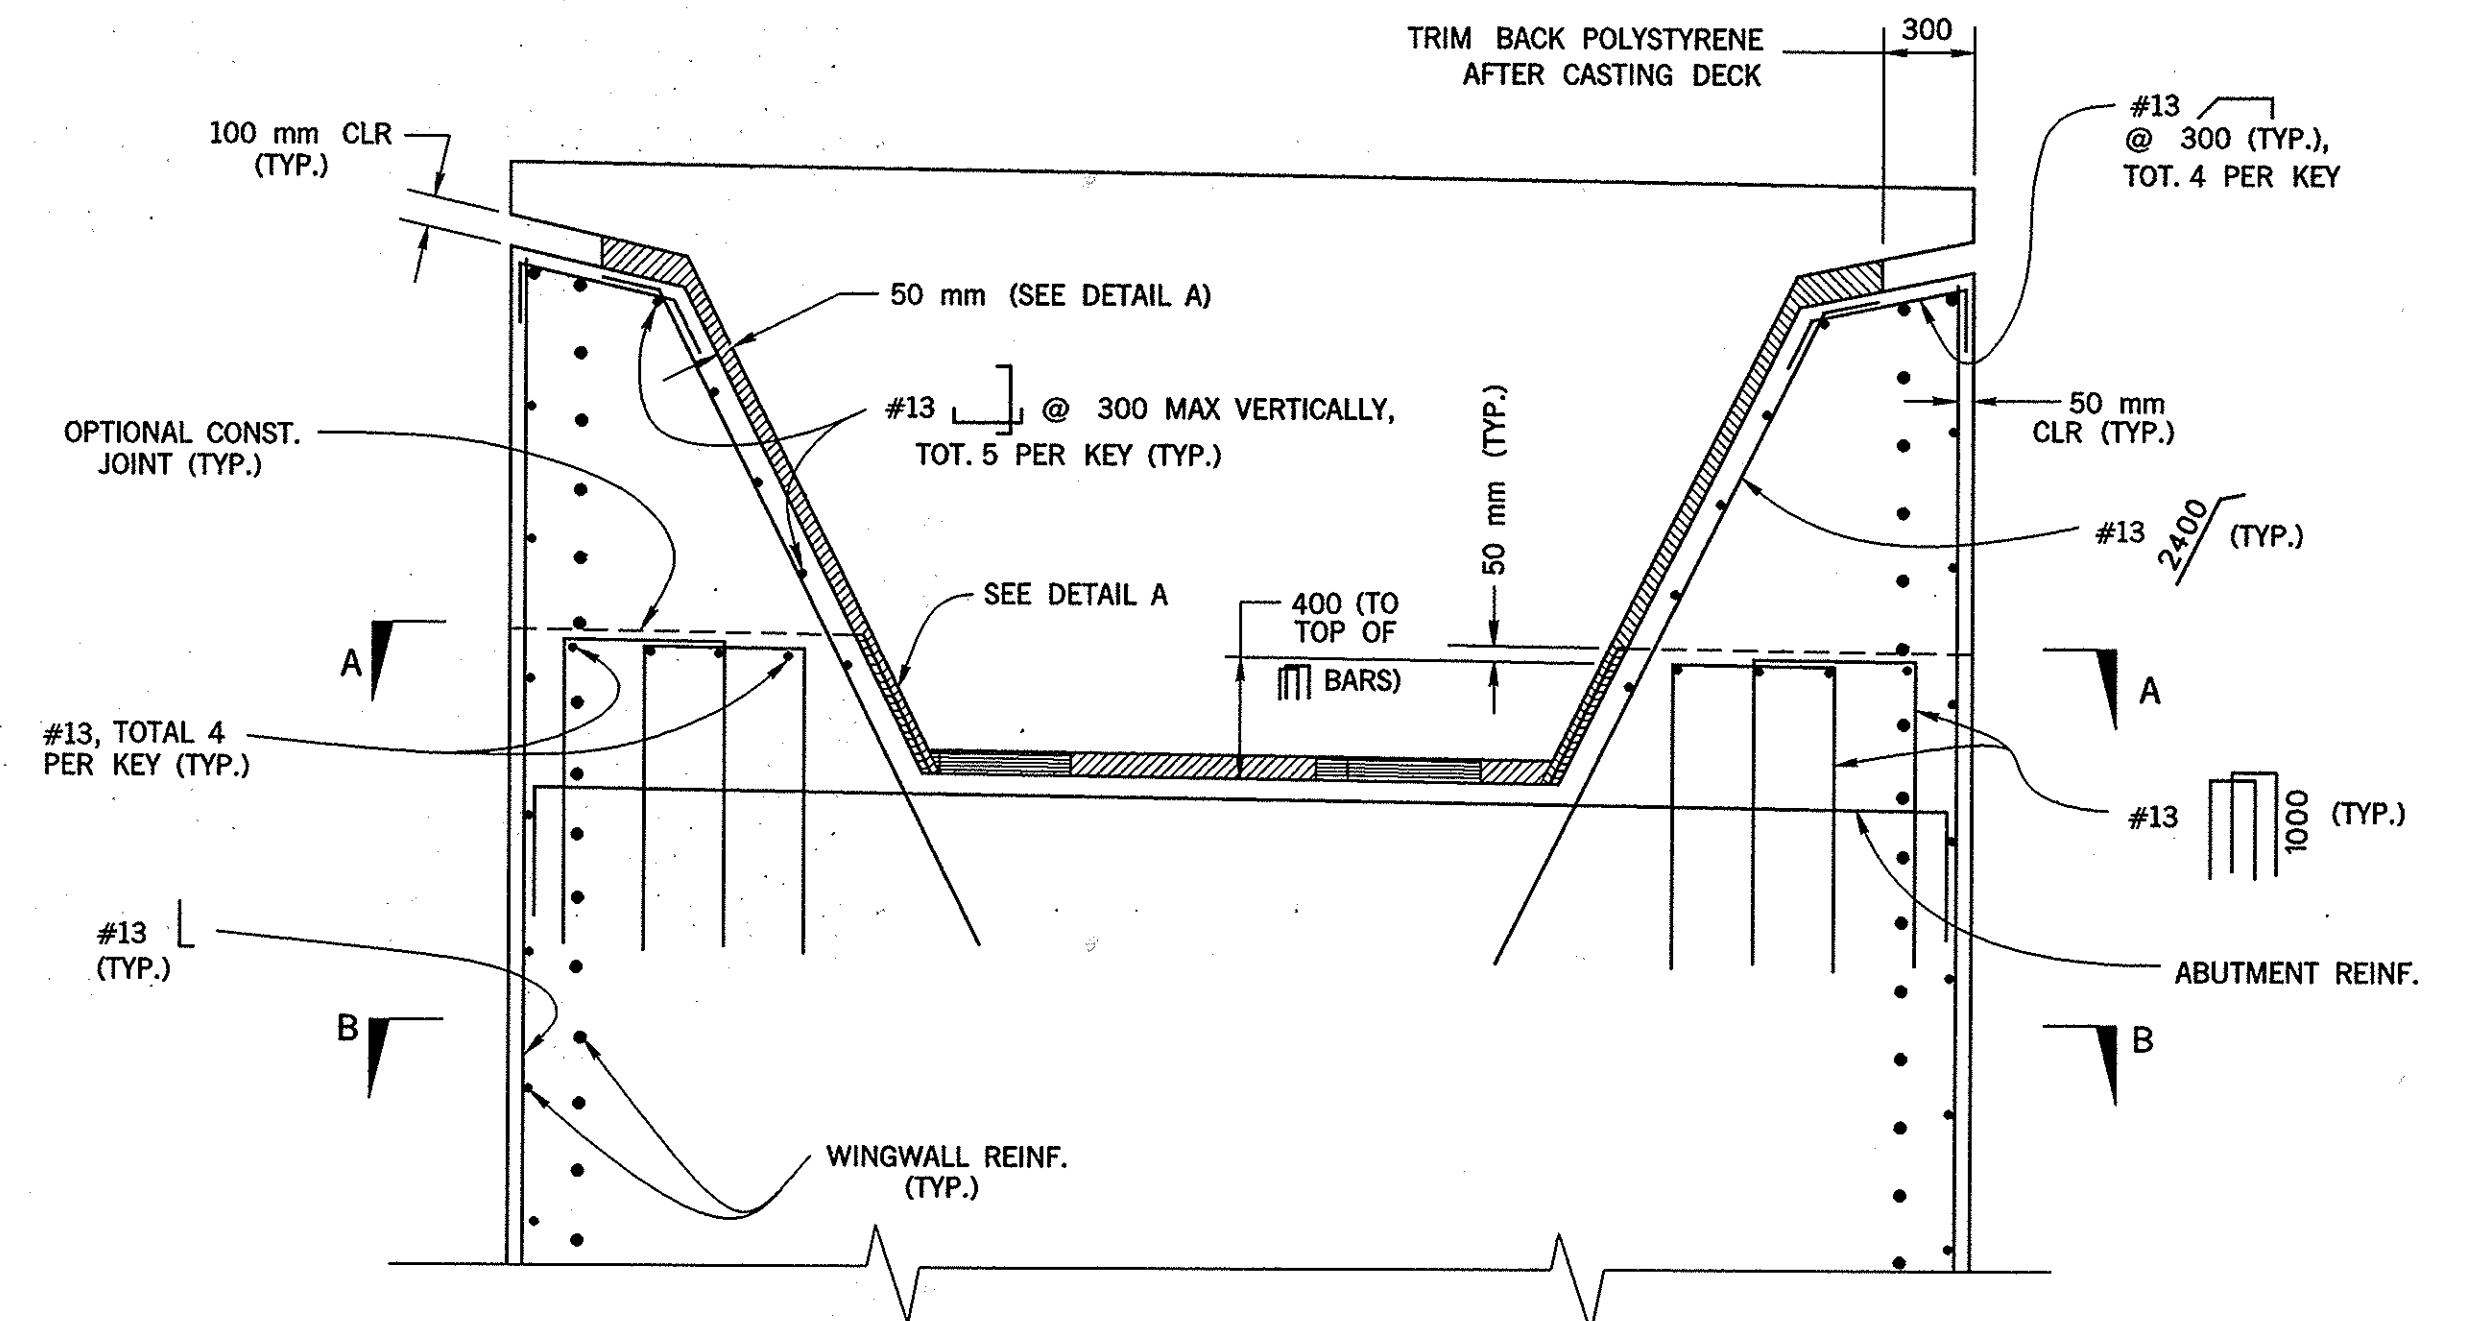


TYPICAL PART ELEVATION
SCALE 1:25

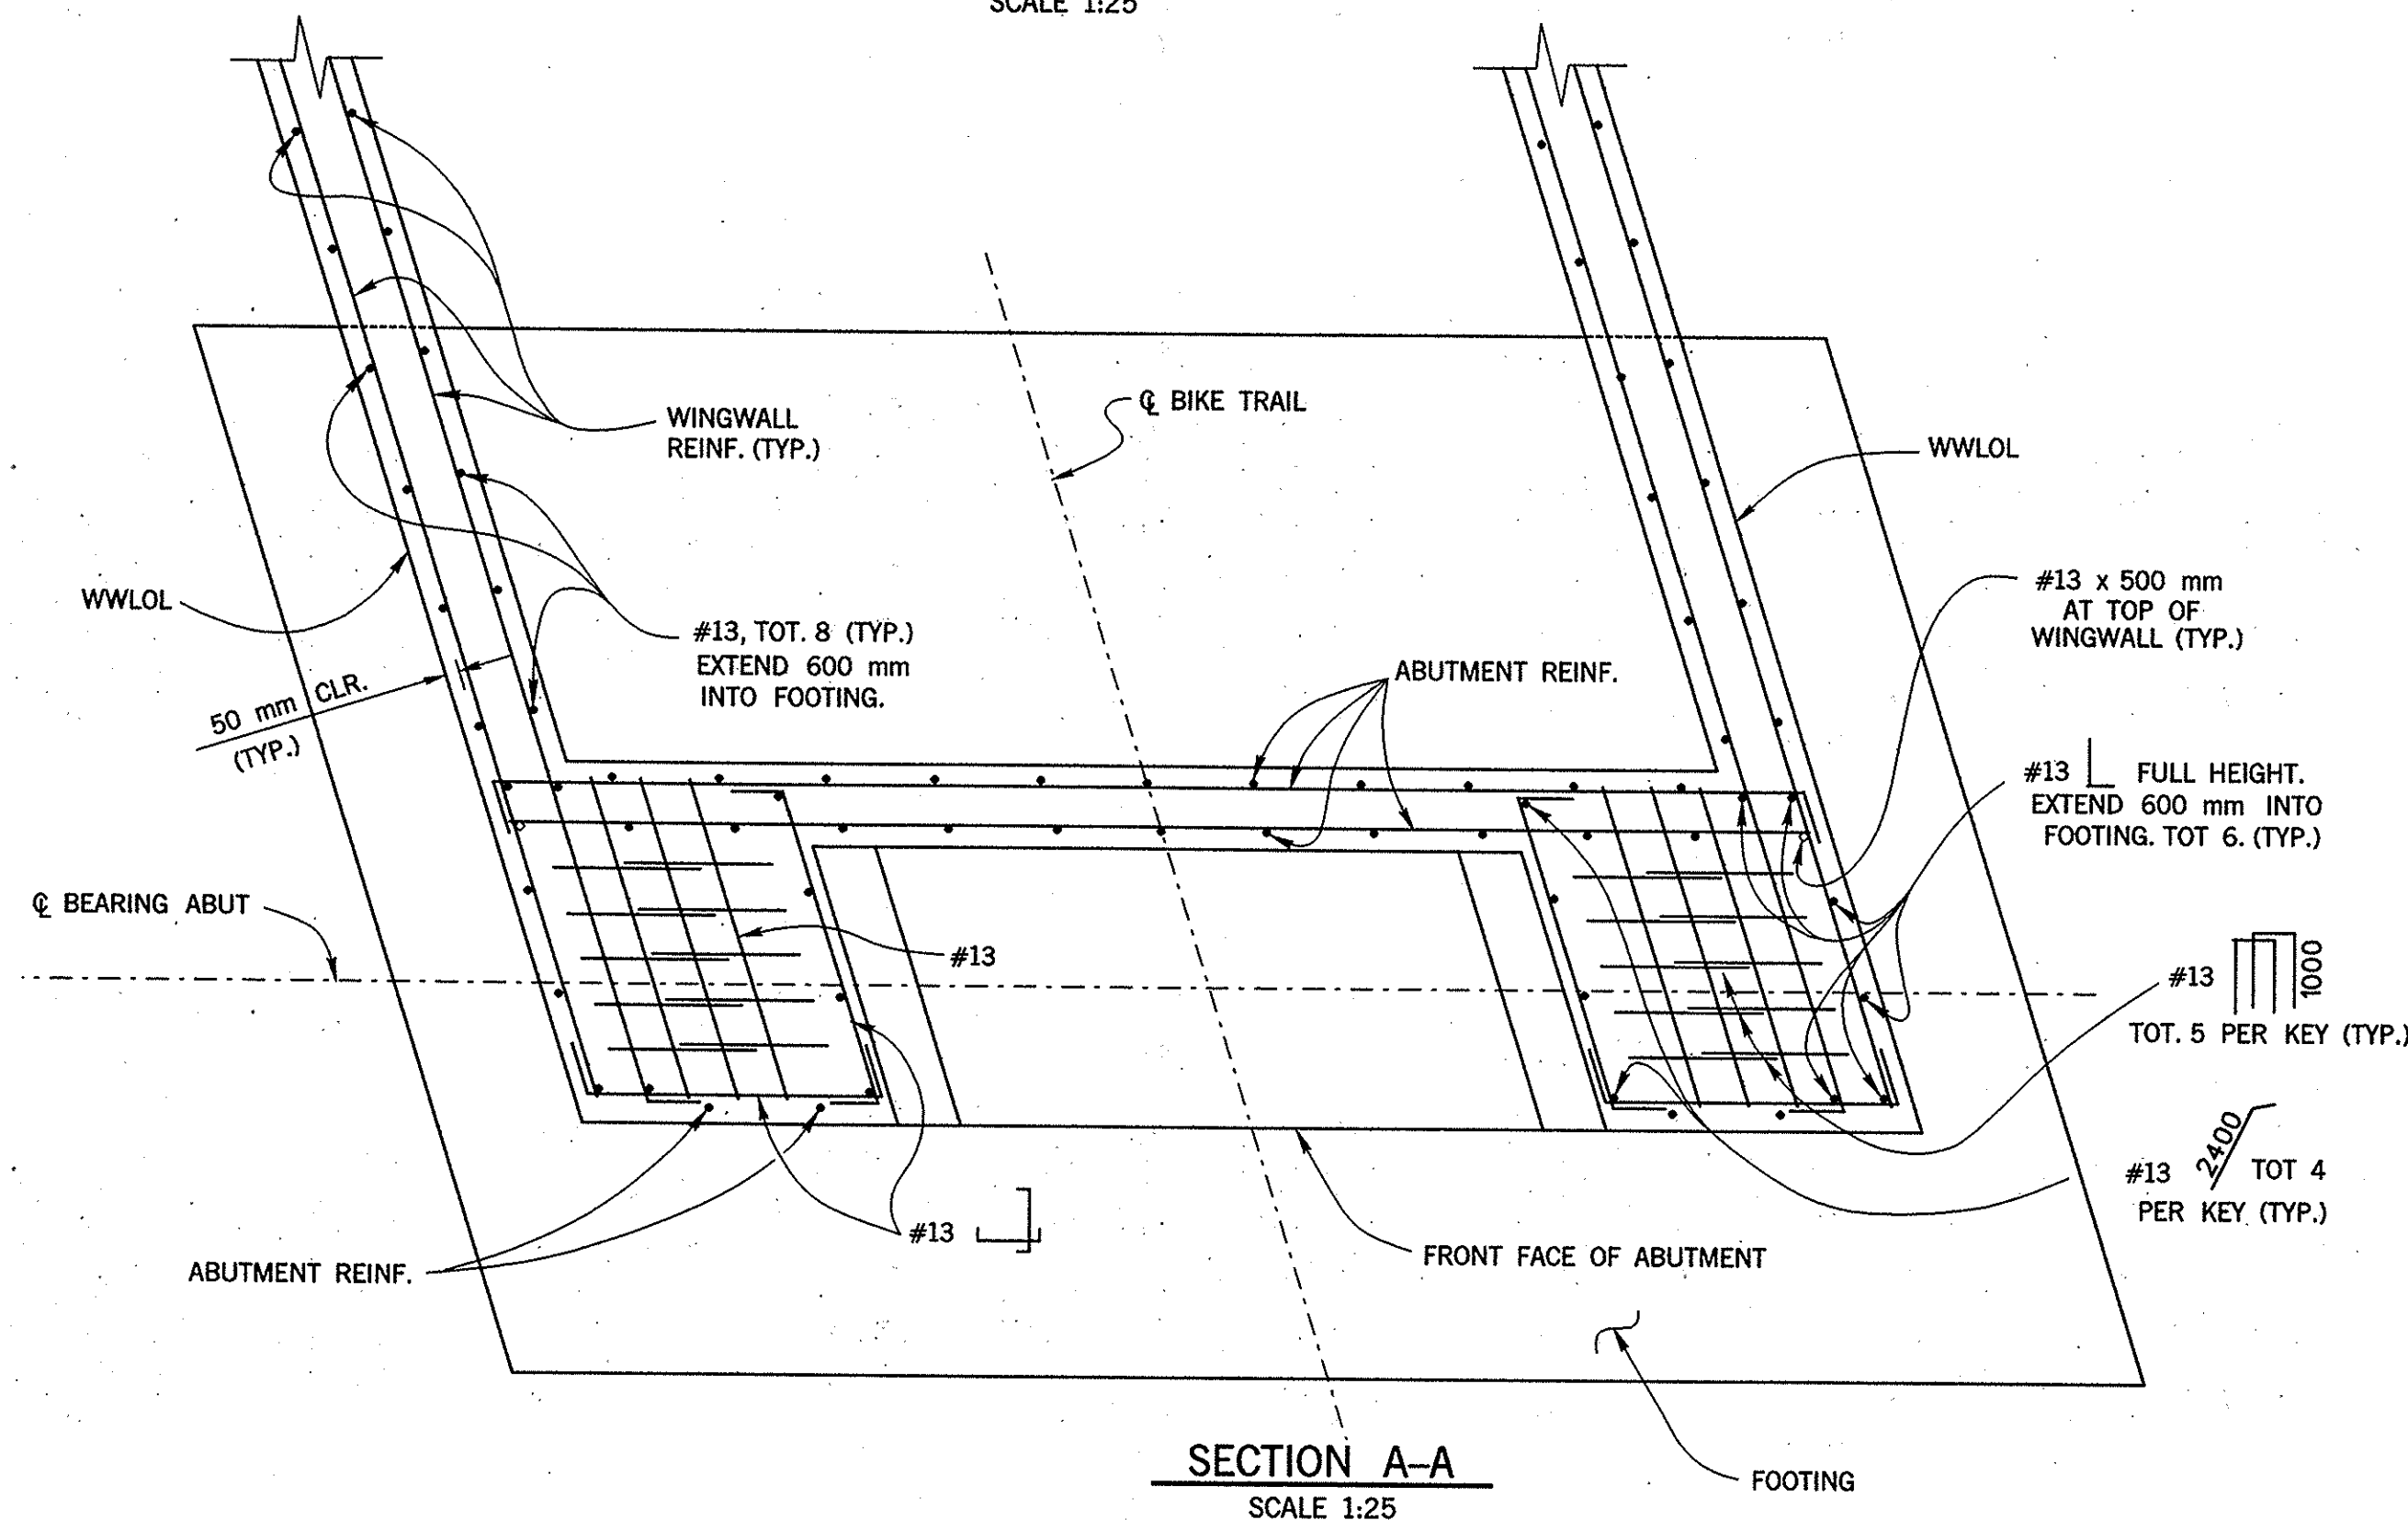

SECTION C-C
SCALE 1:25

SECTION A-A
SCALE 1:25

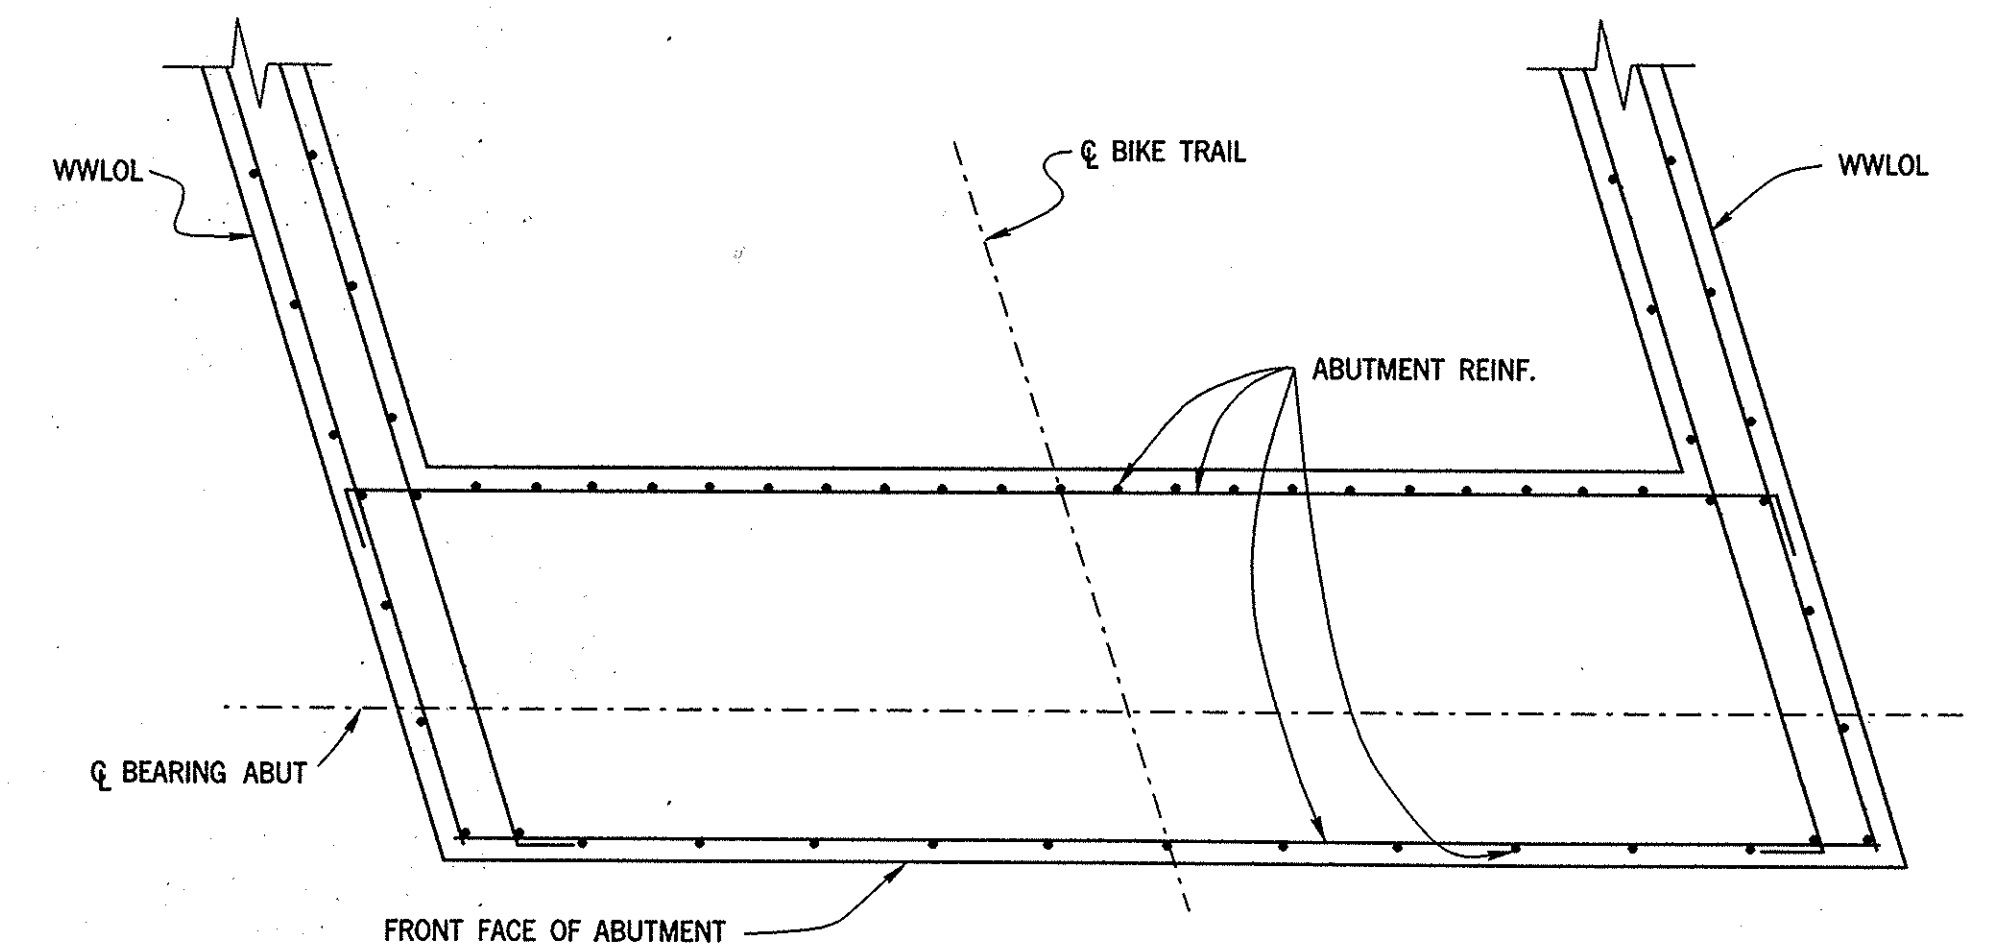

SECTION B-B

FOR REMAINING DETAILS, SHOWN BUT NOT IDENTIFIED,
SEE SECTION A-A

ALL DIMENSIONS ARE IN
MILLIMETERS UNLESS OTHERWISE SHOWN

STEVE NAKAO
DESIGN OVERSIGHT
STEVE NAKAO
6/2/99
SIGN OFF DATE

DESIGN	BY	RICH HOISINGTON	CHECKED	JOHN SARAH McLEAN & SCHULTZ
DETAILS	BY	RICH HOISINGTON	CHECKED	JOHN SARAH McLEAN & SCHULTZ
QUANTITIES	BY	RICH HOISINGTON	CHECKED	JOHN SARAH McLEAN & SCHULTZ

PREPARED FOR THE
STATE OF CALIFORNIA
DEPARTMENT OF TRANSPORTATION

RICH HOISINGTON
PROJECT ENGINEER

BRIDGE NO.
55-953
KILOMETER POS
30.1

TRABUCO CREEK BIKE TRAIL OVERCROSSING
ABUTMENT DETAILS NO. 2

DESIGN DETAIL SHEET (METRIC) (REV. 9/2/98)

ORIGINAL SCALE IN MILLIMETERS
FOR REDUCED PLANS

CU
EA

DISREGARD PRINTS BEARING
EARLIER REVISION DATES—

REVISION DATES (PRELIMINARY STAGE ONLY)

SHEET	OF
6	19

FILE -) \$REQUEST
d:/cadd/metric/trabuco/abutdet2.dgn (3D)

```

19
of
-----
USURNAME *$USER  DATE PLOTTED *$DATE      TIME PLOTTED *$TIME
H.P.              04/15/99                2:00 PM

```