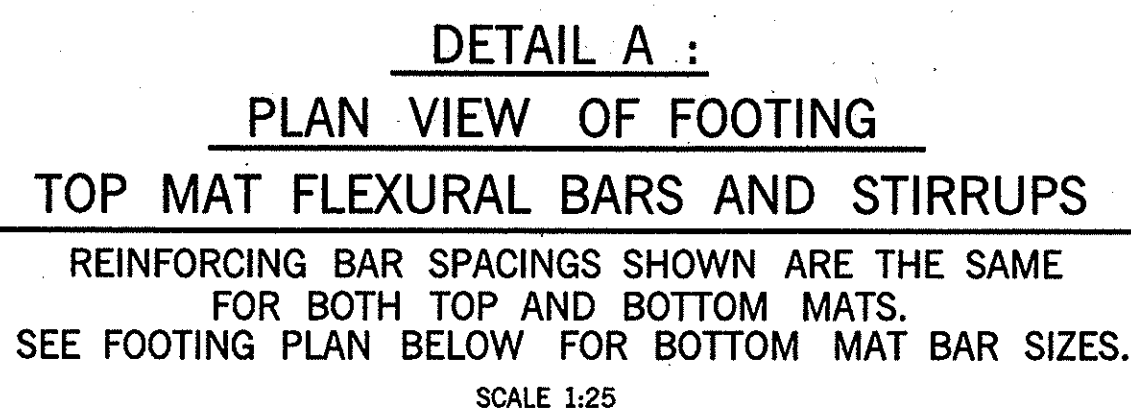
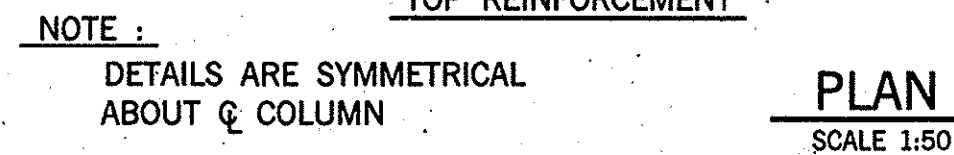
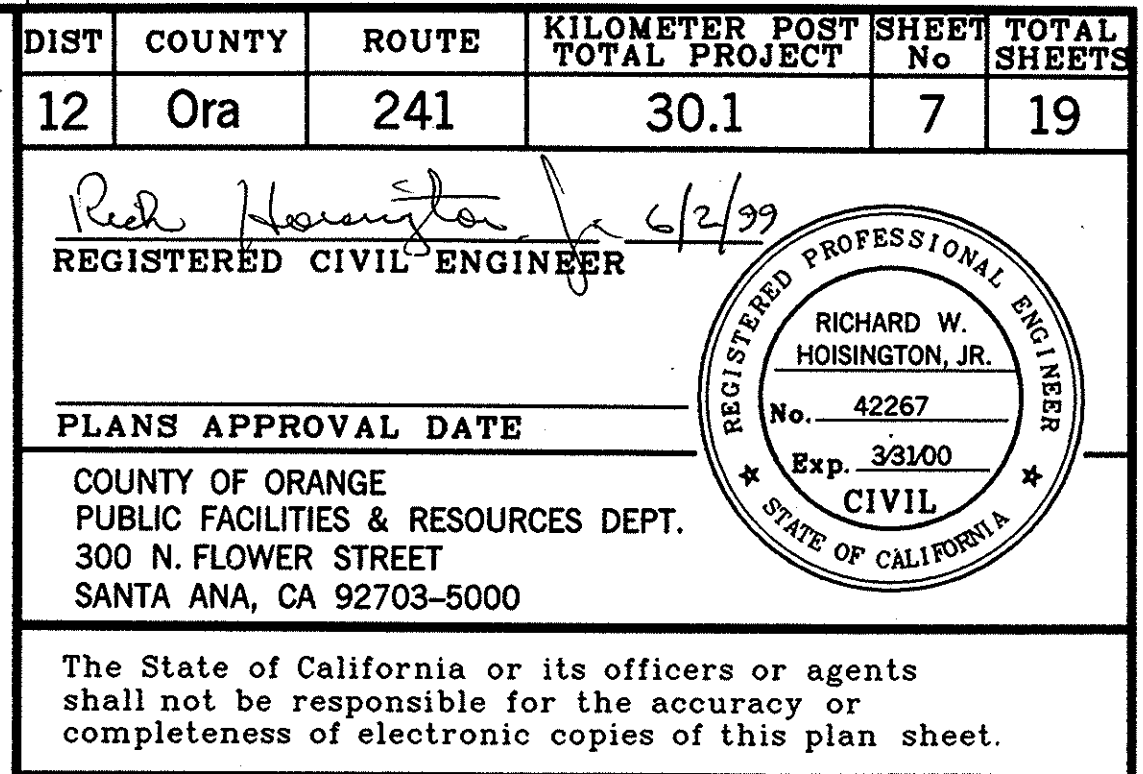


ALL DIMENSIONS ARE IN
MILLIMETERS UNLESS OTHERWISE SHOWN

TRABUCO CREEK BIKE TRAIL OVERCROSSING
BENT DETAILS NO. 1

DISREGARD PRINTS BEARING EARLIER REVISION DATES →	REVISION DATES (PRELIMINARY STAGE ONLY)									SHEET	OF
	33199	52499								7	19