




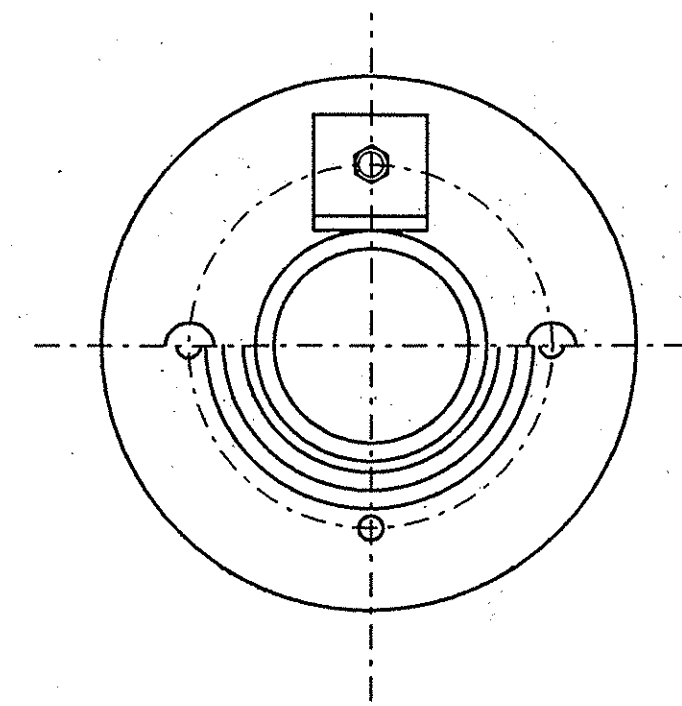

SPLIT SECTION A-A

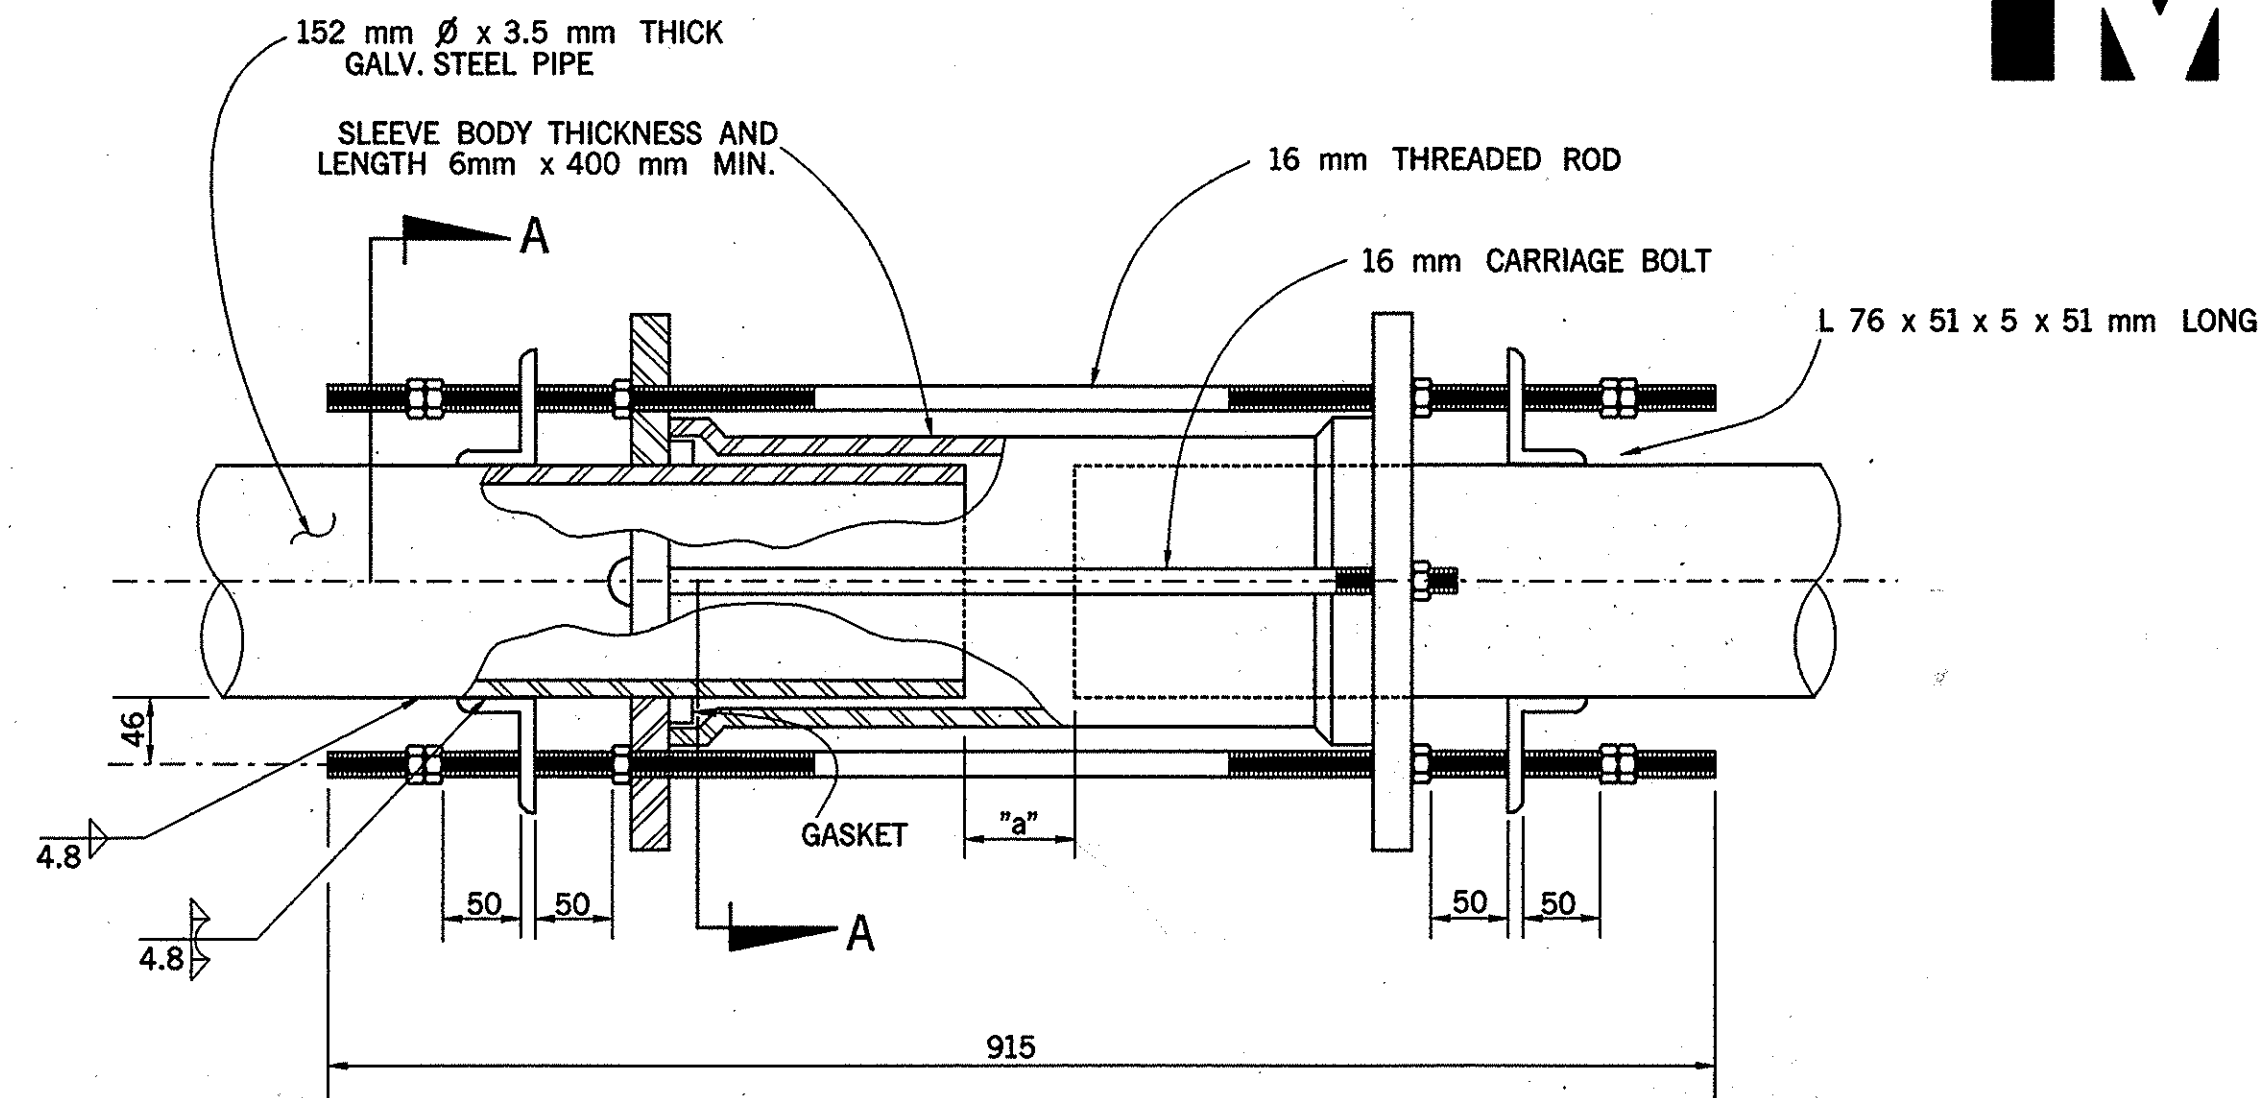

EXPANSION COUPLING DETAIL

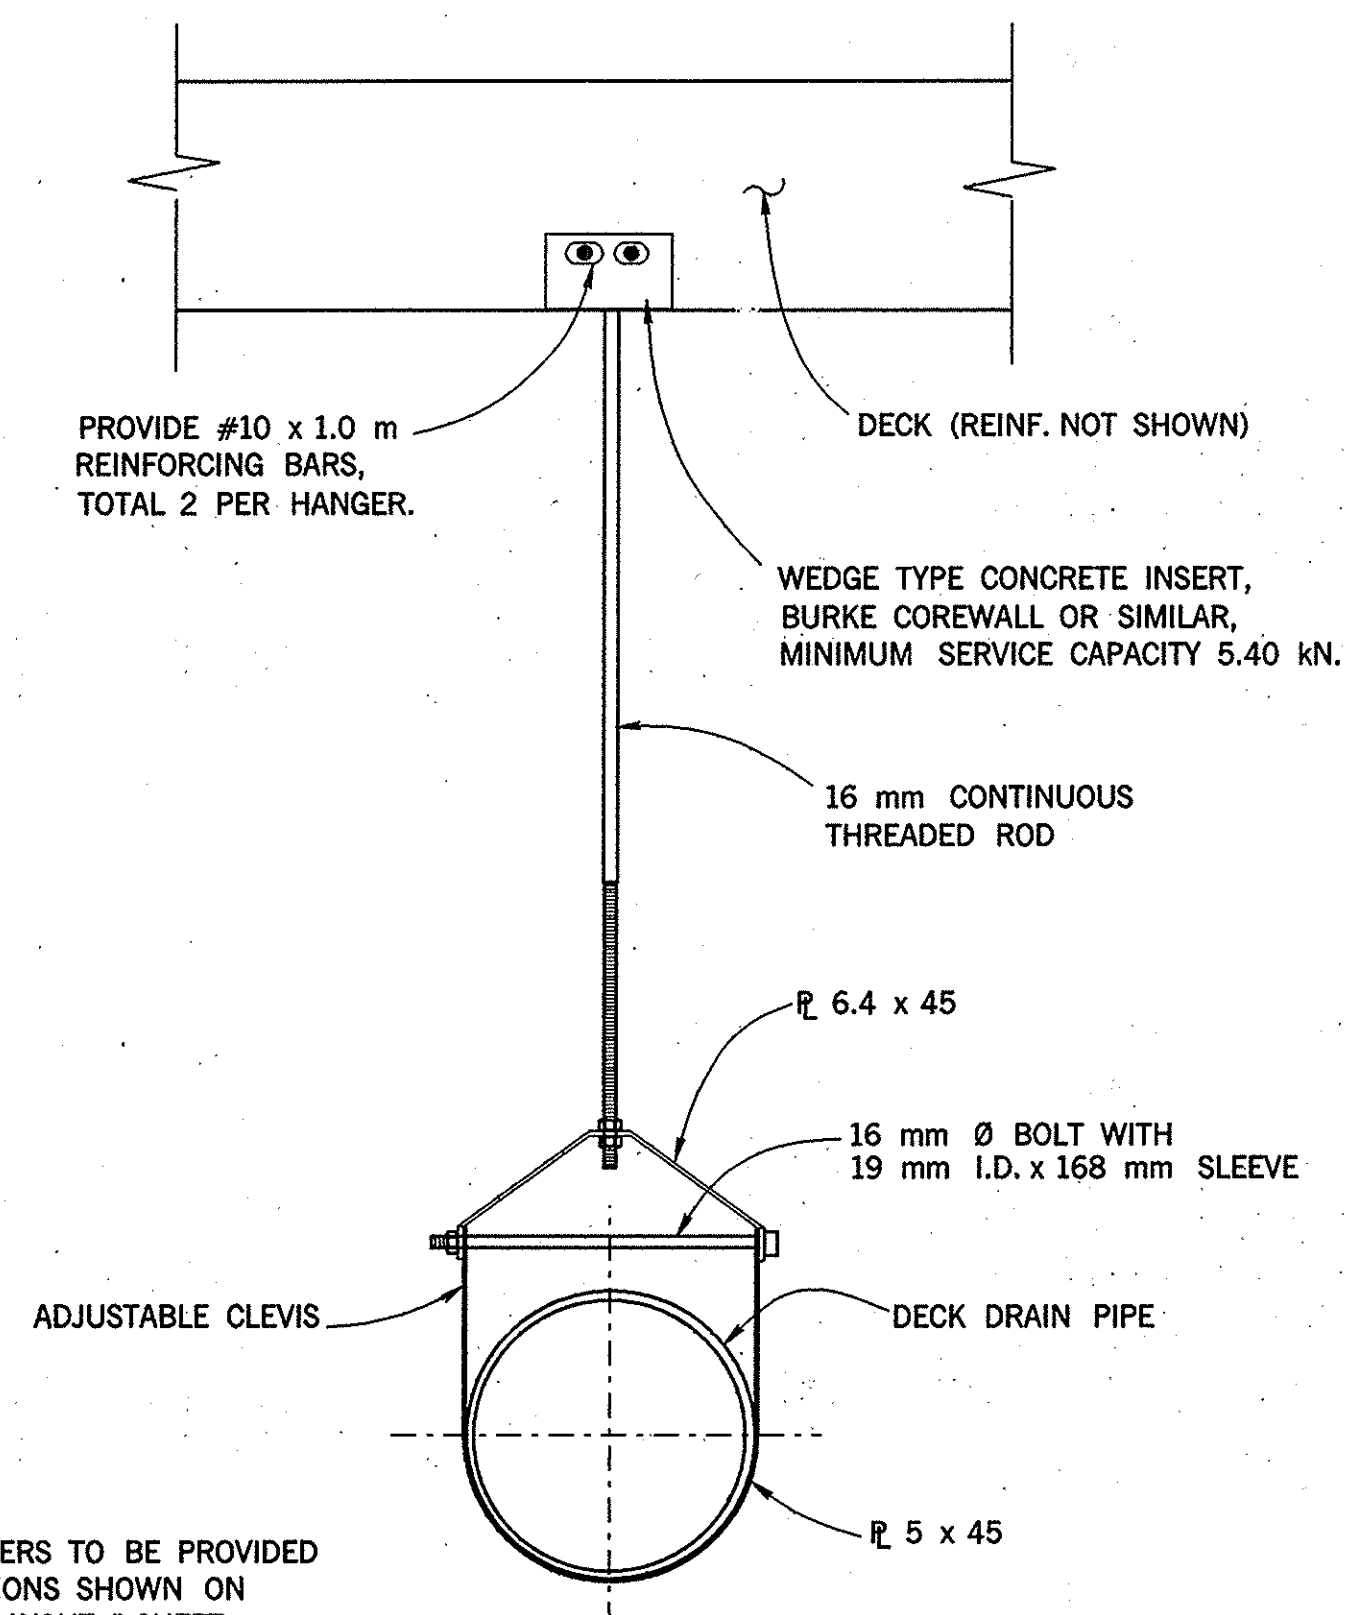

DECK DRAIN PIPE SUPPORT

NOTES :

1. SEE (B7-e) FOR "NOTES", "DRAIN PIPE ALIGNMENT" AND "SLEEVE CONNECTION". FOR DECK DRAIN LAYOUT, SEE "GIRDER LAYOUT" SHEET.
2. ALL EXPANSION COUPLING HARDWARE TO BE GALVANIZED. FOR DIMENSION "a", SEE "JOINT SEAL ASSEMBLY DETAILS" SHEET.
3. ALL PIPE HANGER HARDWARE SHALL BE GALVANIZED.
4. ALL DRAIN PIPE CONNECTIONS SHALL BE WATERTIGHT.

AS BUILT

CORRECTIONS BY G. CUNNINGHAM/ RWH
CONTRACT NO. 1296-NMC-0130
DATE 5-8-01 / 6-1-01

NO SCALE, UNLESS OTHERWISE SHOWN

ALL DIMENSIONS ARE IN
MILLIMETERS UNLESS OTHERWISE SHOWN

DESIGN	BY	RICH HOISINGTON	CHECKED	JOHN SARAH McLEAN & SCHULTZ
DETAILS	BY	RICH HOISINGTON	CHECKED	JOHN SARAH McLEAN & SCHULTZ
QUANTITIES	BY	RICH HOISINGTON	CHECKED	JOHN SARAH McLEAN & SCHULTZ

PREPARED FOR THE
STATE OF CALIFORNIA
DEPARTMENT OF TRANSPORTATION

RICH HOISINGTON
PROJECT ENGINEER

BRIDGE NO.
55-953
KILOMETER POST
30.1

TRABUCO CREEK BIKE TRAIL OVERCROSSING
DECK DRAIN DETAILS NO. 1

[illegible]

ORIGINAL SCALE IN MILLIMETERS
FOR REDUCED PLANS

CU	
EA	

DISREGARD PRINTS BEARING
EARLIER REVISION DATES—

REVISION DATES (PRELIMINARY STAGE ONLY)

SHEET	OF
11	19

FILE =) \$REQUEST	d:/cadd/metric/trabuco/deckdrn.dgn (2D)
-------------------	---

```

      19 OF 11
=====
USERNAME *USER    DATE PLOTTED *DATE   TIME PLOTTED *TIME
          H.P.           01/06/99         1:00 PM

```