






DIST	COUNTY	ROUTE	KILOMETER POST TOTAL PROJECT	SHEET No	TOTAL SHEETS
12	Oran	241	30.1	15	19
REGISTERED CIVIL ENGINEER Richard W. Hoisington, Jr. No. 42267 Exp. 3/31/00 CIVIL STATE OF CALIFORNIA					
PLANS APPROVAL DATE COUNTY OF ORANGE PUBLIC FACILITIES & RESOURCES DEPT. 300 N. FLOWER STREET SANTA ANA, CA 92703-5000					
The State of California or its officers or agents shall not be responsible for the accuracy or completeness of electronic copies of this plan sheet.					

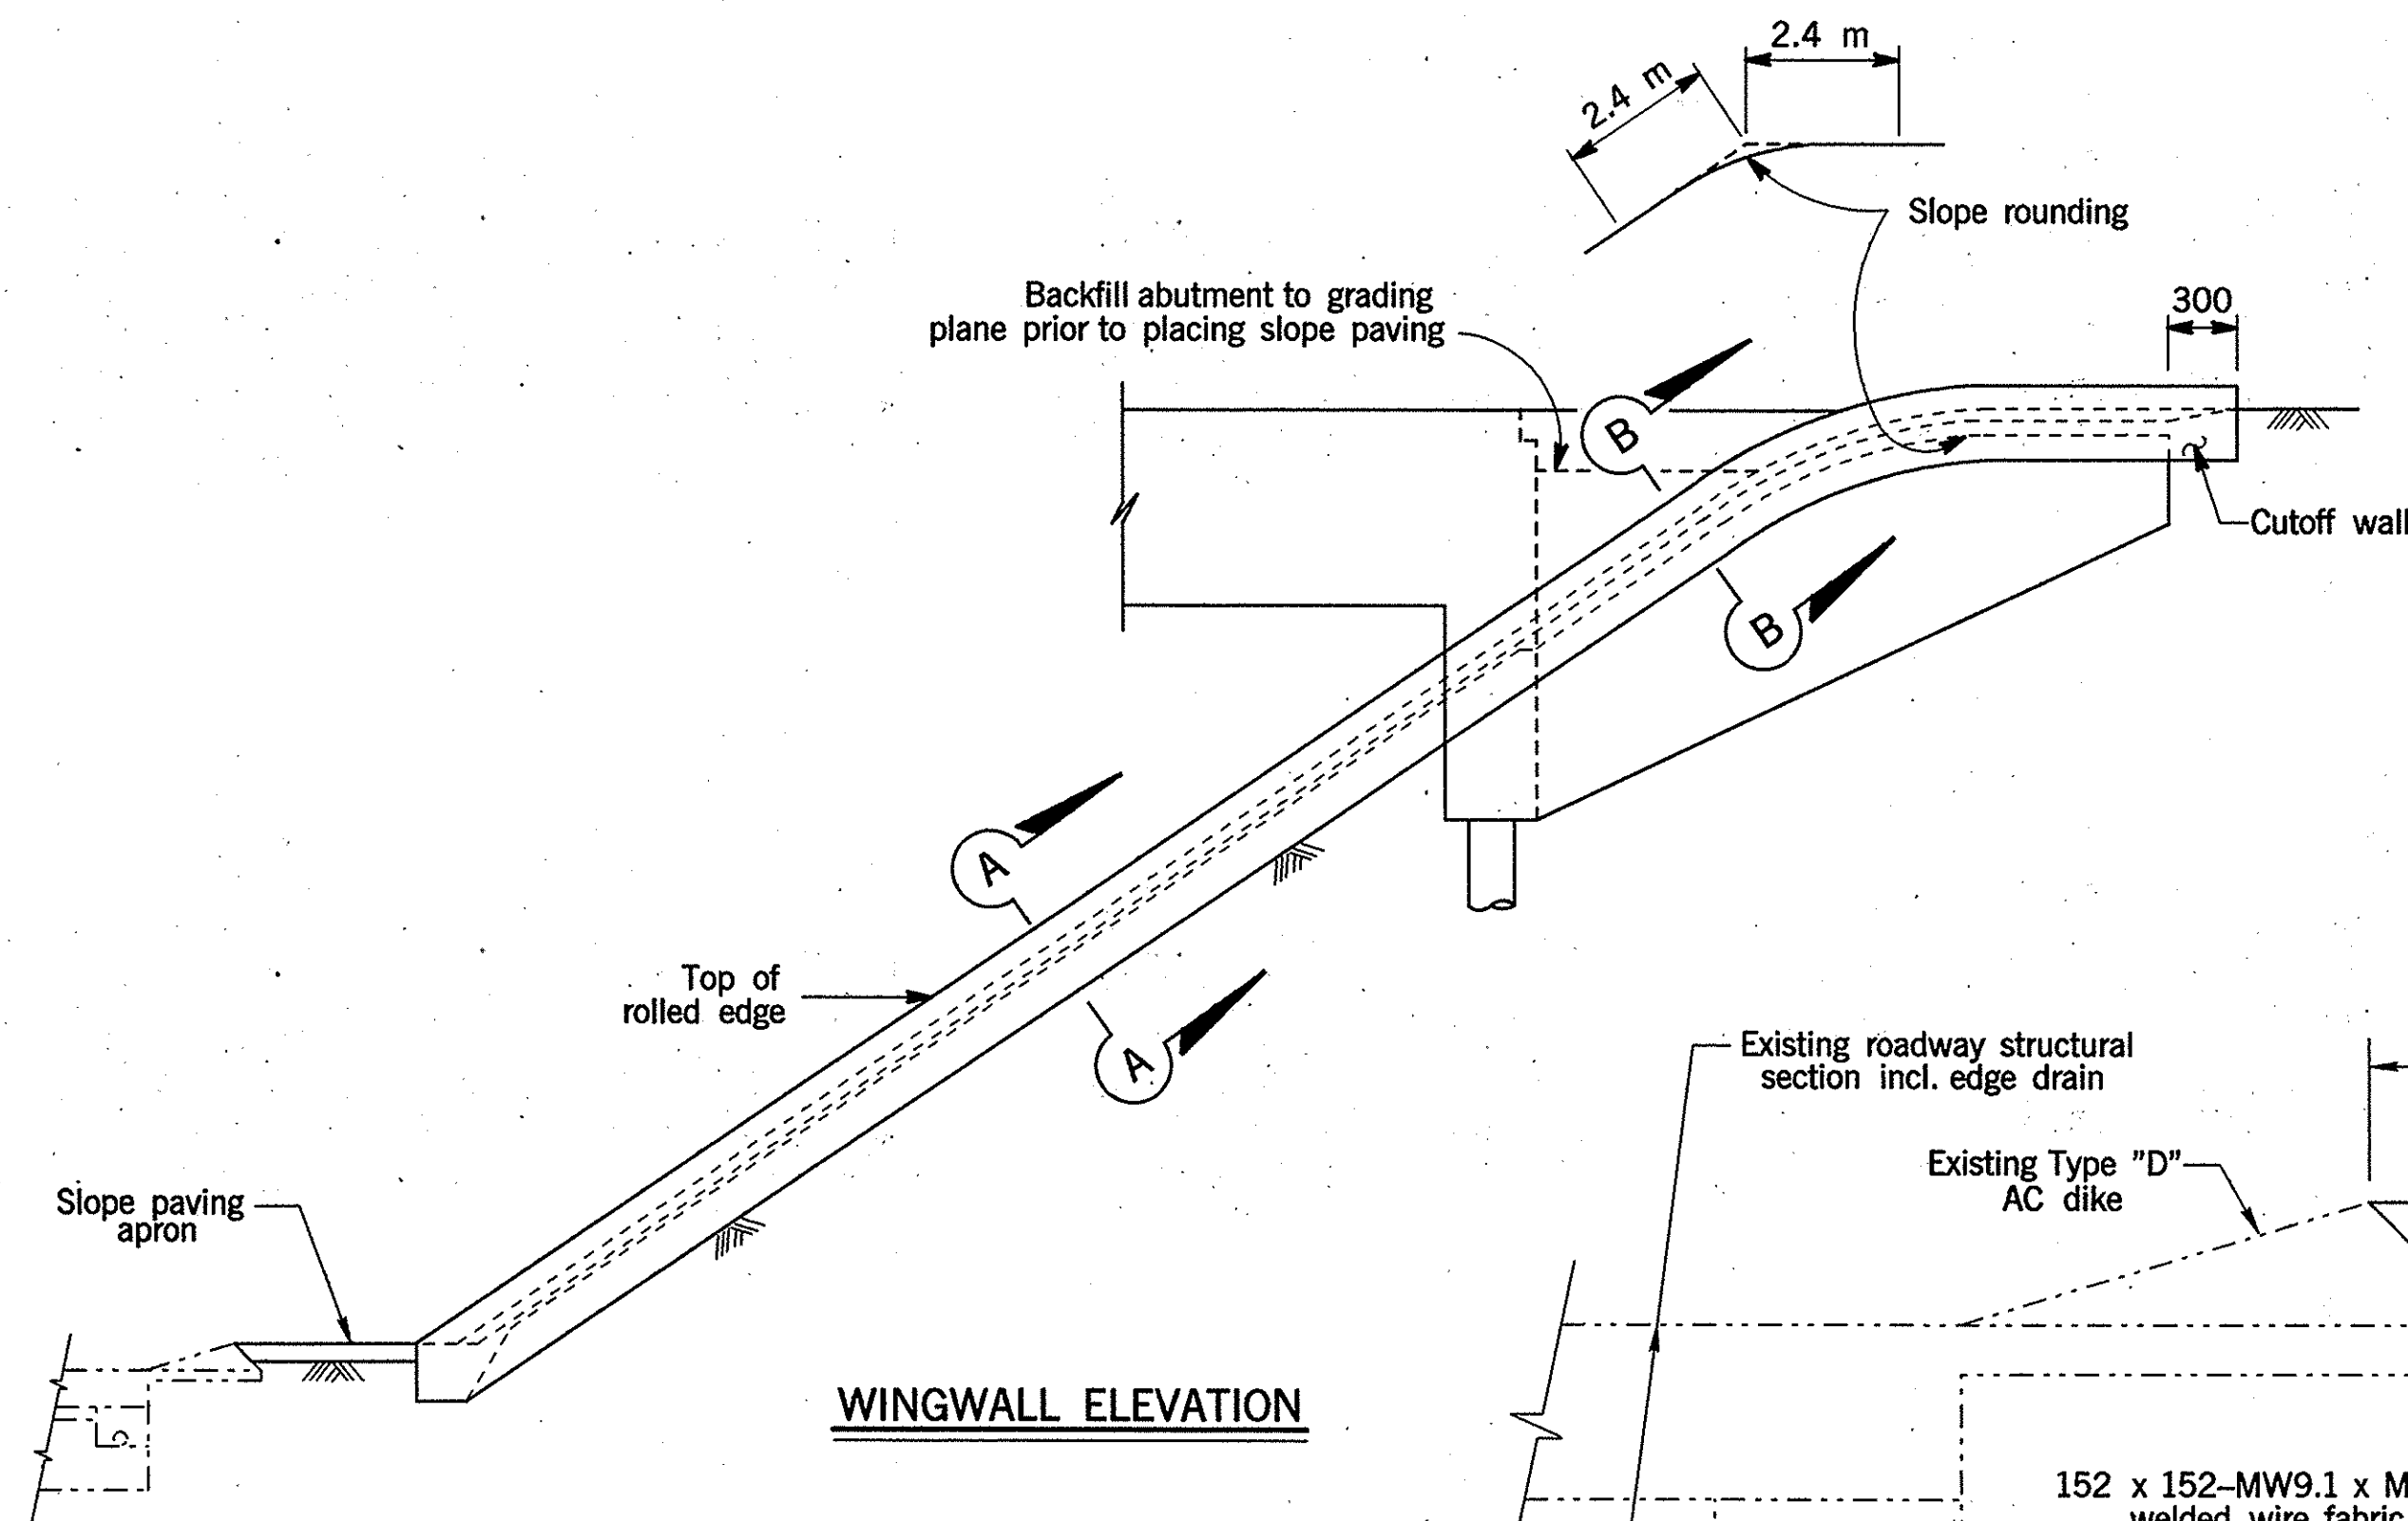

WINGWALL ELEVATION

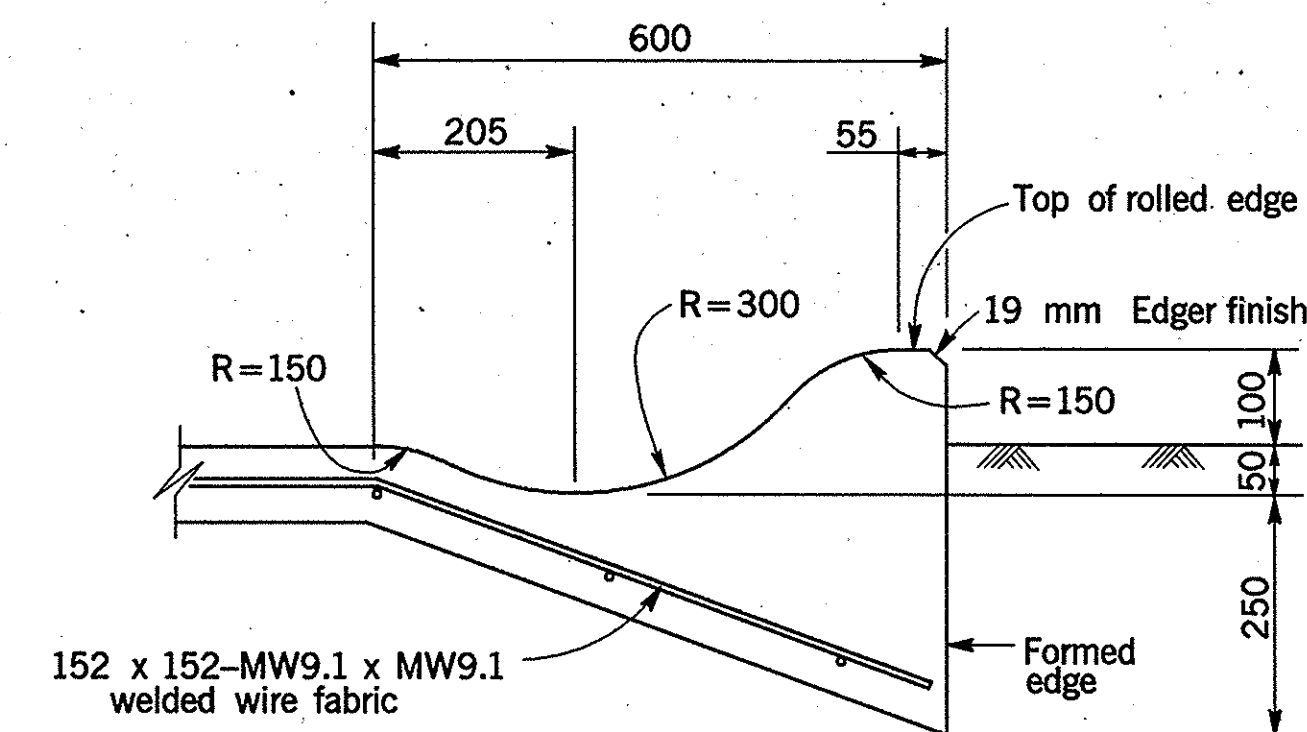


SECTION A-A

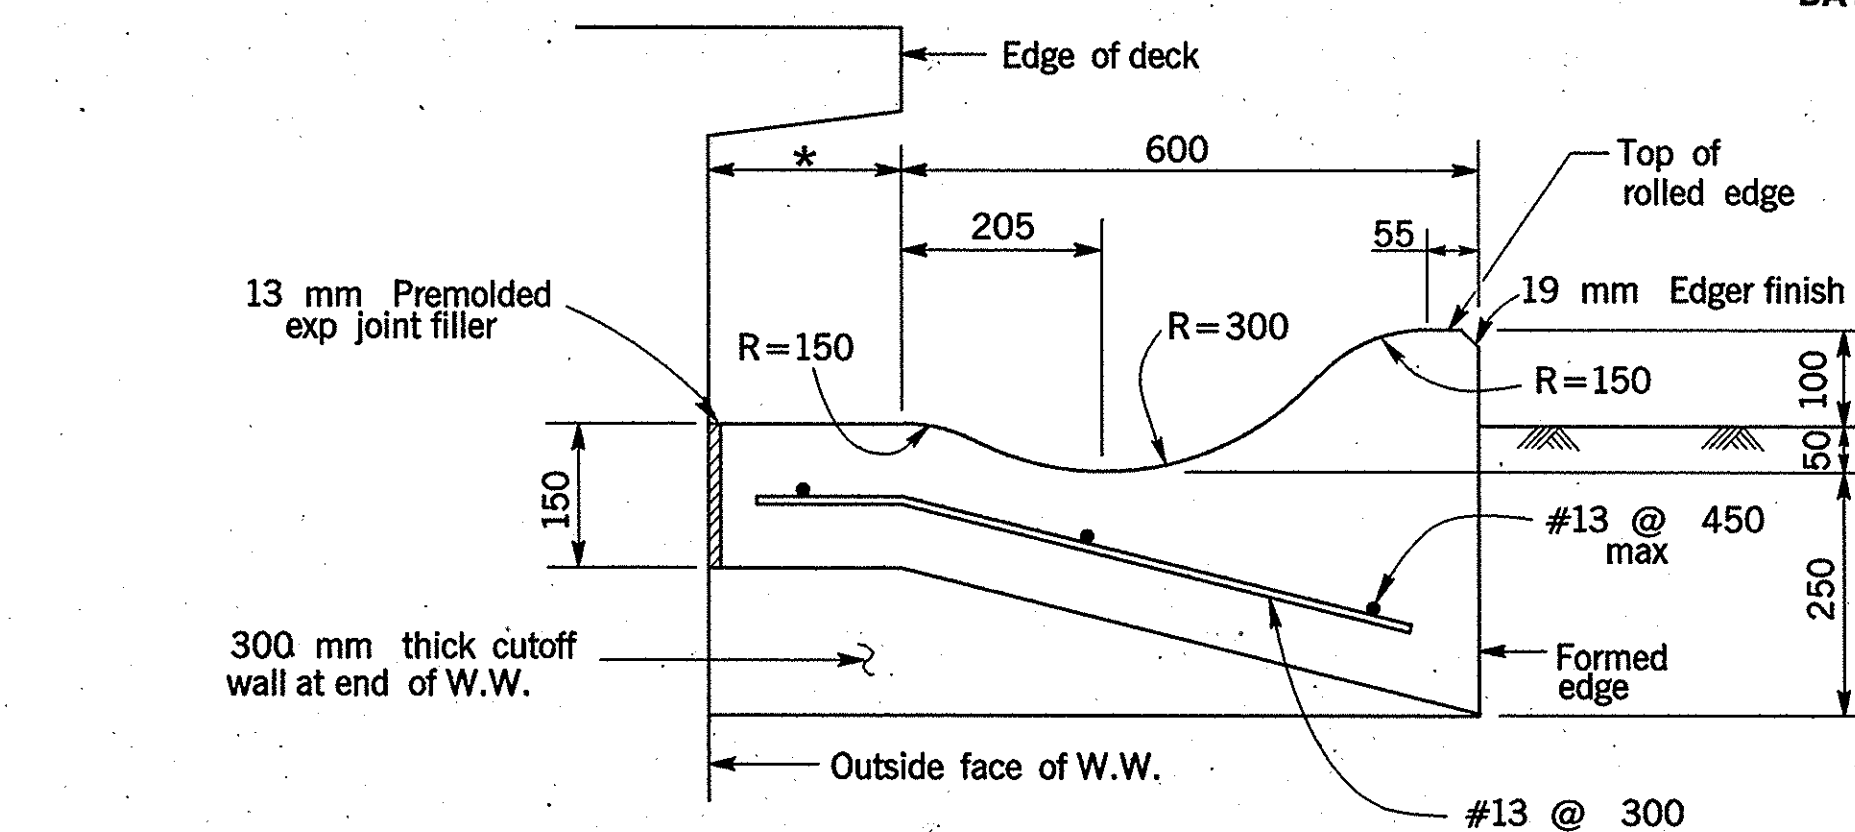

SECTION B-B


* This dimension becomes zero when edge of deck is at outside face of W.W.

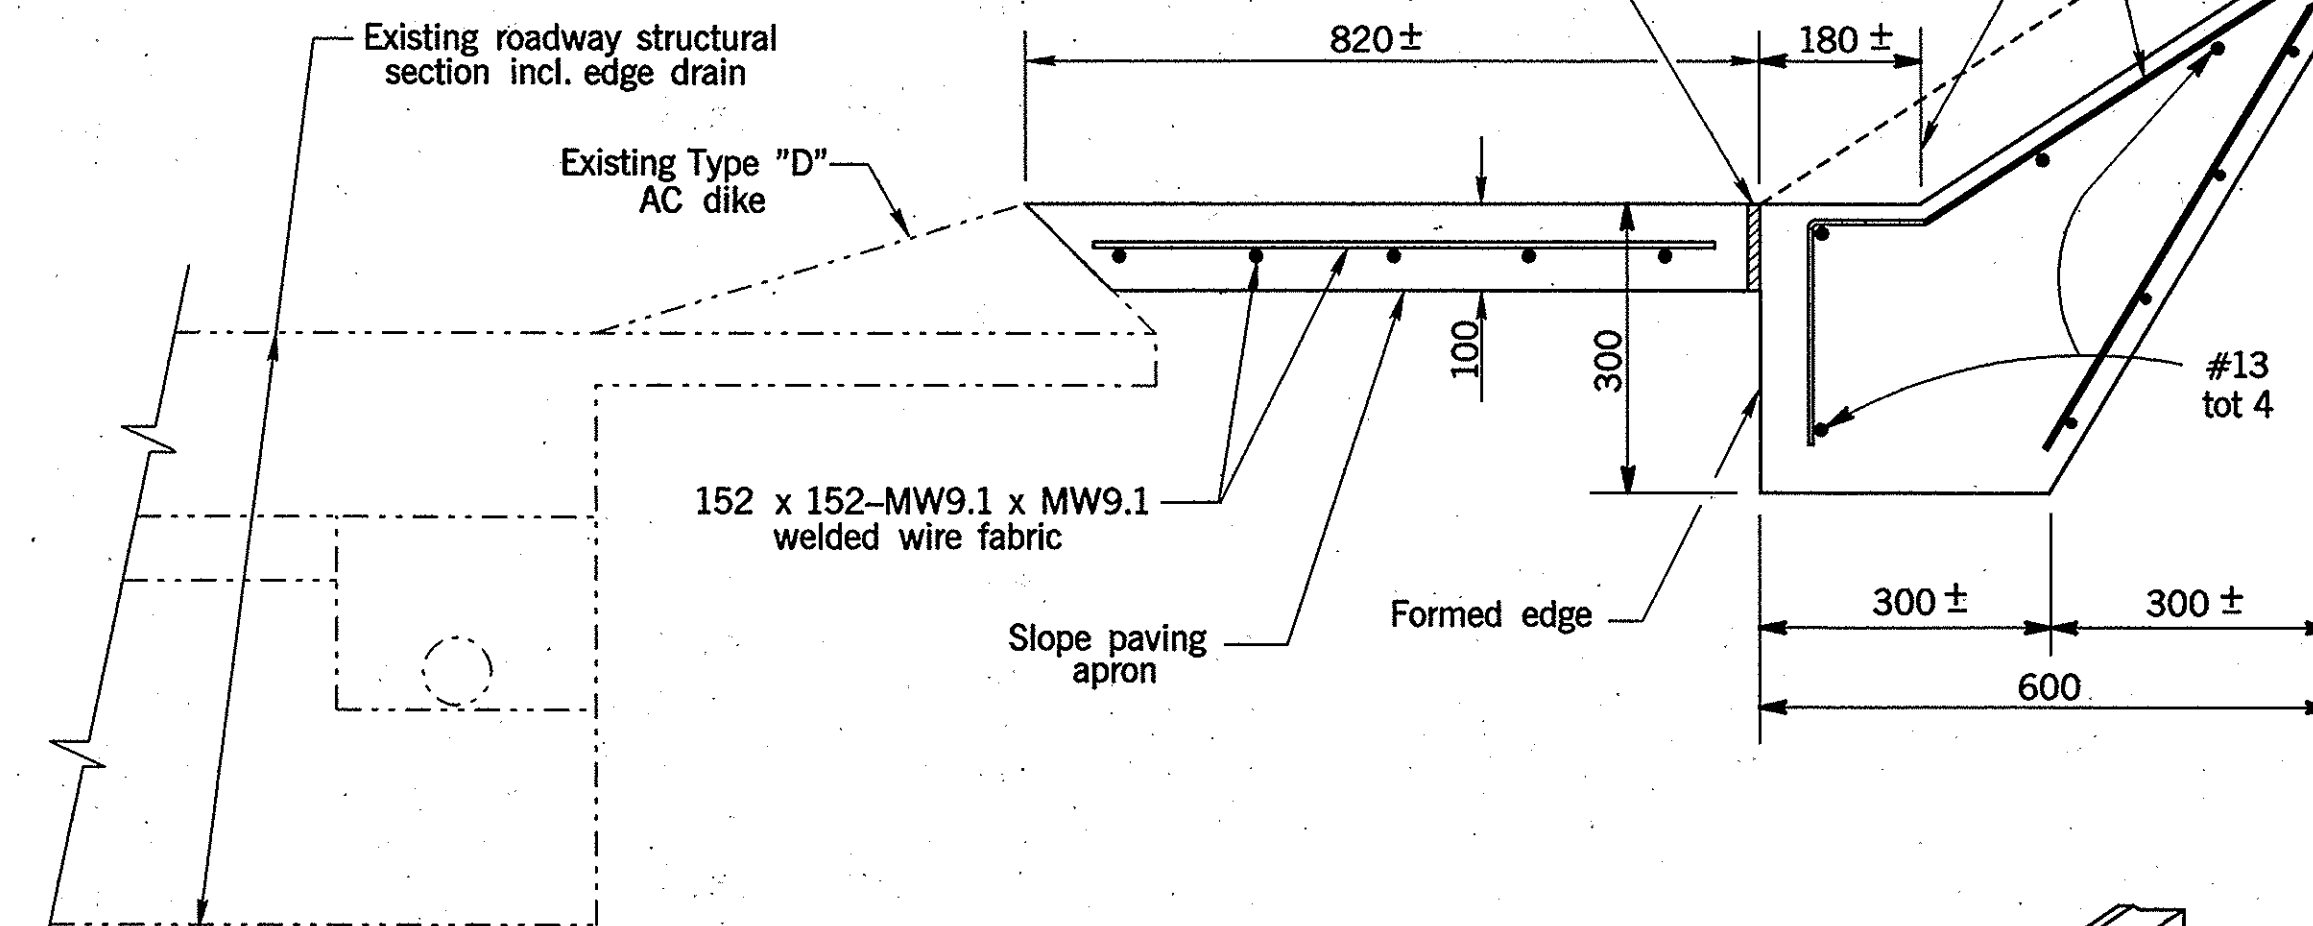


TYPICAL SECTION - CONCRETE PAVING

NO AS BUILT CHANGES
AS BUILT



CORRECTIONS BY G. CUNNINGHAM/ RWH
CONTRACT NO. 1296-NMC-0130
DATE 5-8-01 / 6-1-01

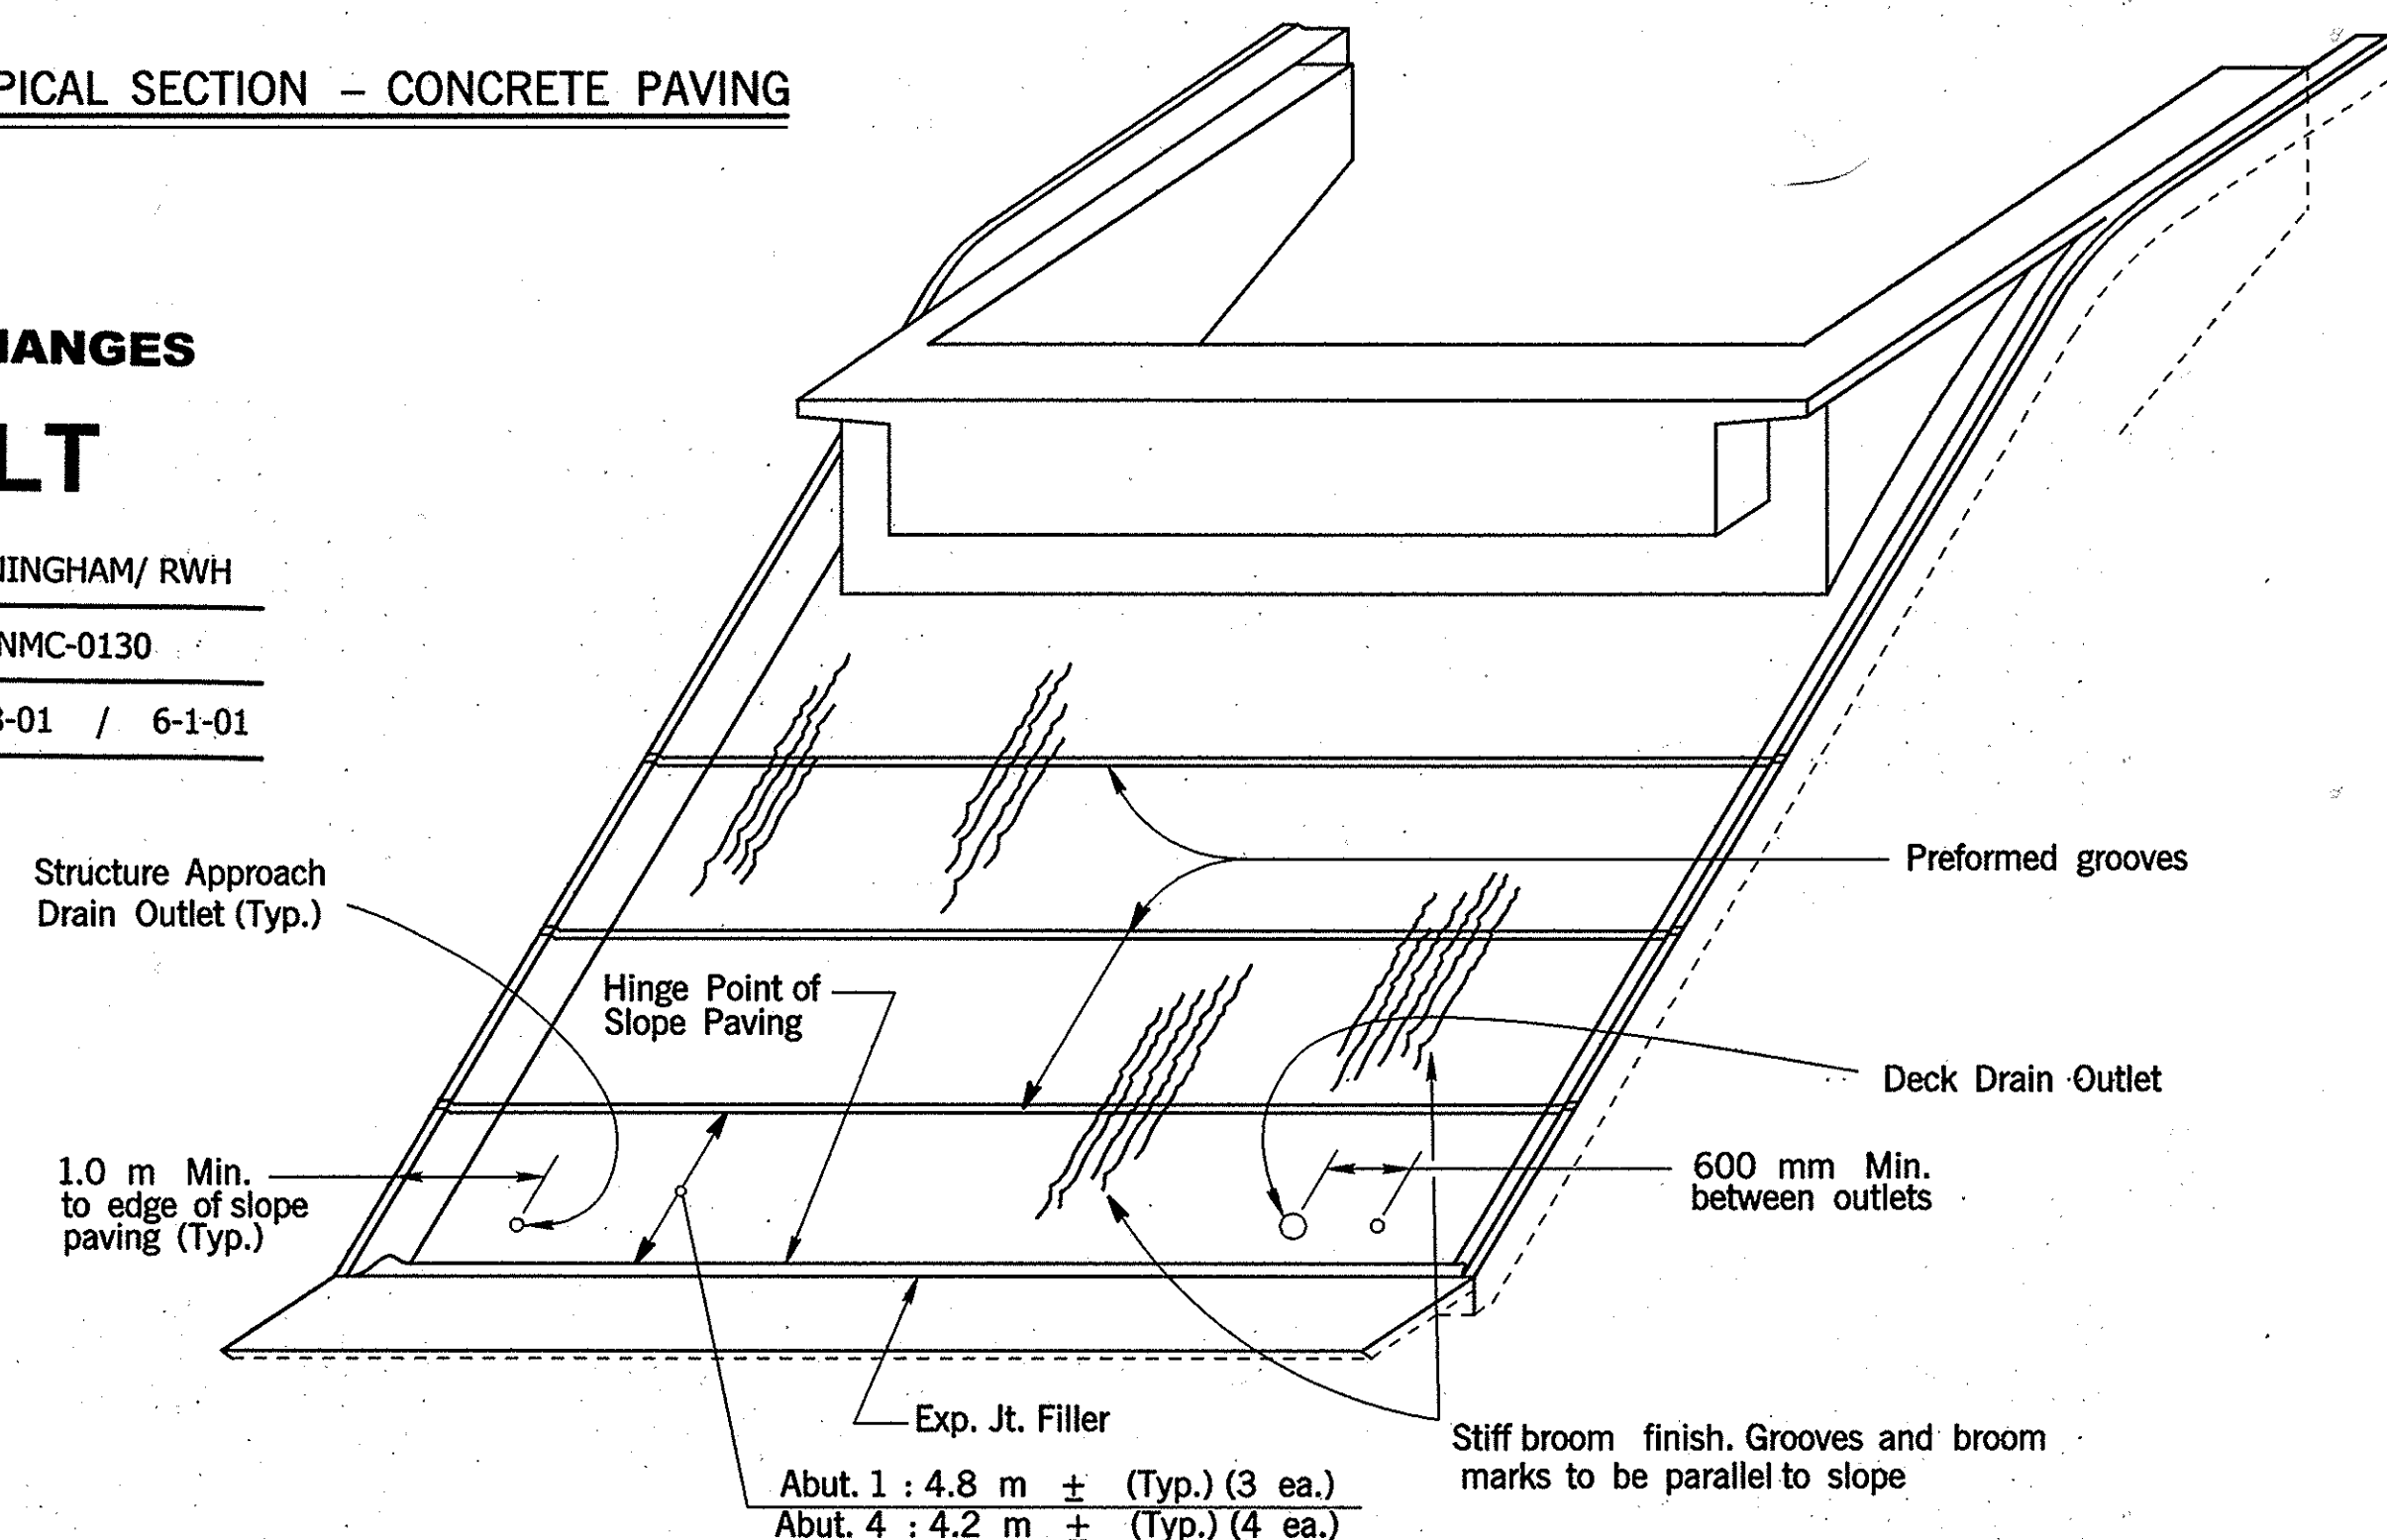

PICTORIAL VIEW OF TYPICAL INSTALLATION

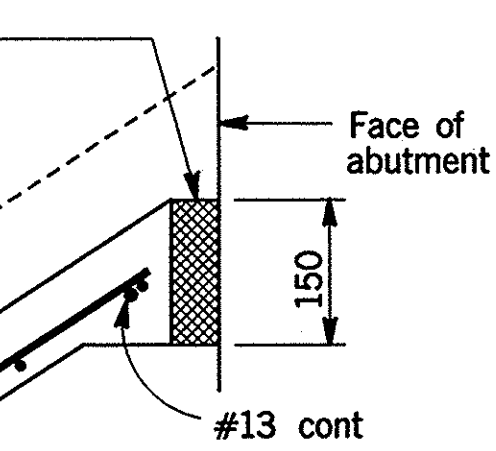

DRAINAGE DETAILS

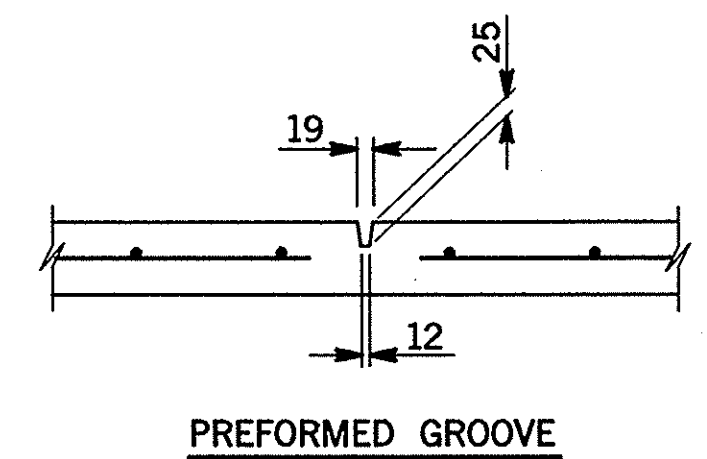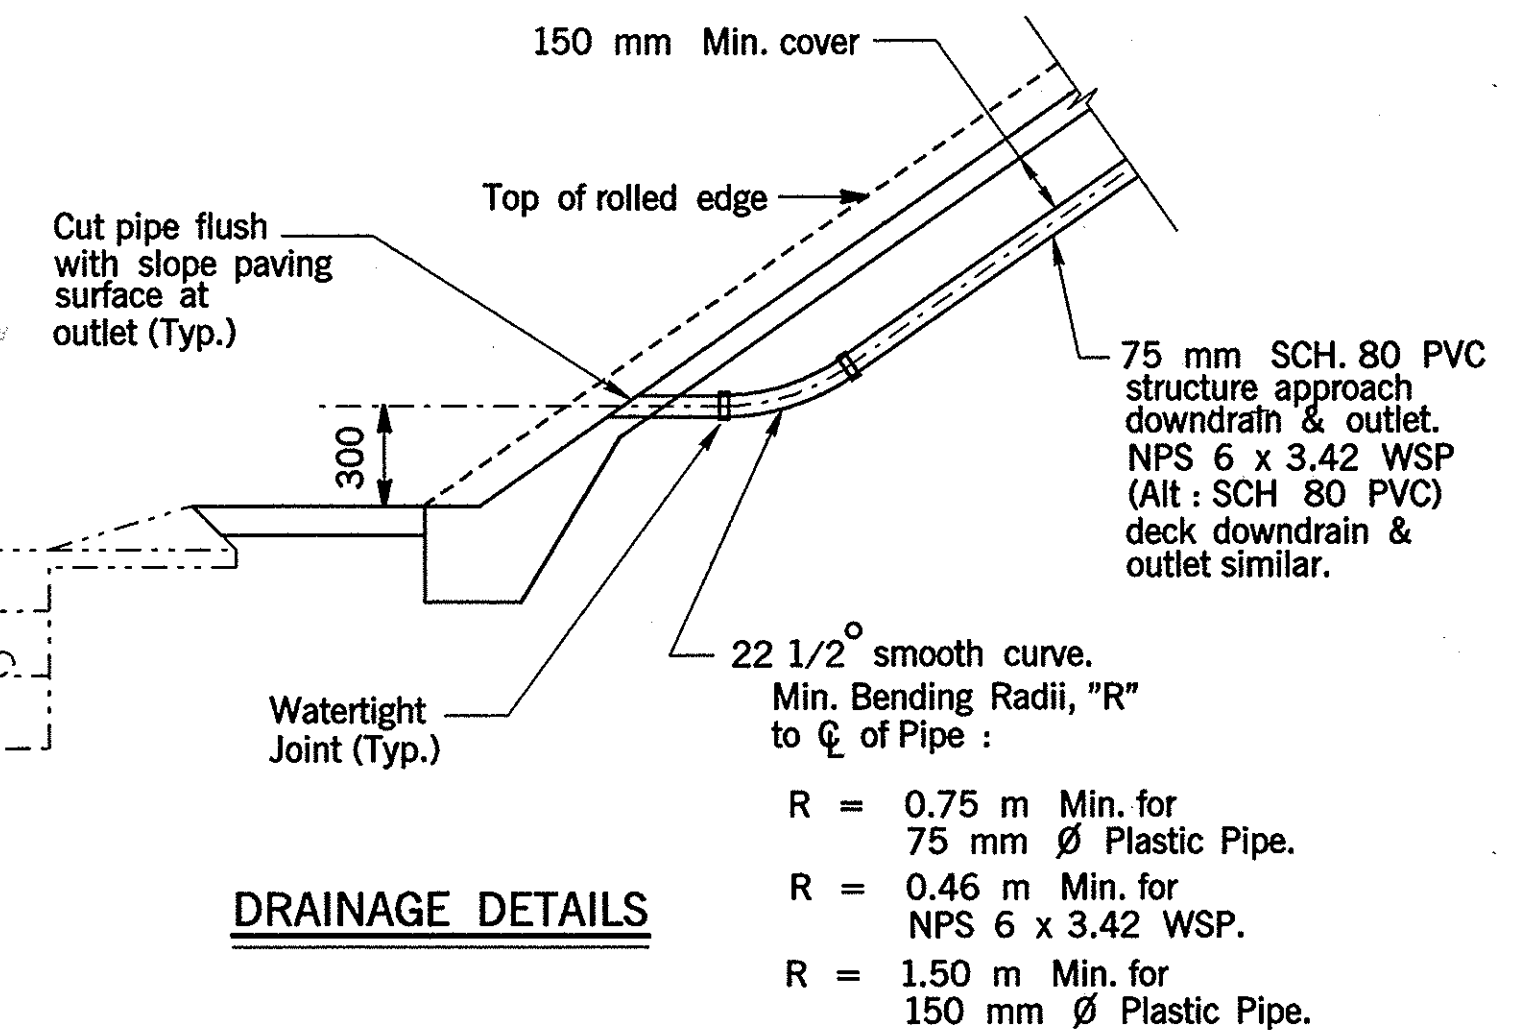

NOTE:

ABUTMENT SHOWN IS SCHEMATIC ONLY. SEE ABUTMENT DRAWINGS FOR ACTUAL ABUTMENT DETAILS.

NO SCALE, UNLESS OTHERWISE SHOWN

ALL DIMENSIONS ARE IN MILLIMETERS UNLESS OTHERWISE SHOWN

Steve NAKAO
DESIGN OVERSIGHT
6/2/99
SIGN OFF DATE

DESIGN DETAIL SHEET (METRIC) (REV. 9/2/88)

DESIGN	BY RICH HOISINGTON	CHECKED JOHN SARAH McLEAN & SCHULTZ
DETAILS	BY RICH HOISINGTON	CHECKED JOHN SARAH McLEAN & SCHULTZ
QUANTITIES	BY RICH HOISINGTON	CHECKED JOHN SARAH McLEAN & SCHULTZ

PREPARED FOR THE
STATE OF CALIFORNIA
DEPARTMENT OF TRANSPORTATION

CU
EA

FILE -> \$REQUEST
d:\cadd\metric\trabuco\sloppavn.dgn (3D)

BRIDGE NO.	55-953
KILOMETER POST	30.1

TRABUCO CREEK BIKE TRAIL OVERCROSSING
SLOPE PAVING DETAILS

DISREGARD PRINTS BEARING
EARLIER REVISION DATES

REVISION DATES (PRELIMINARY STAGE ONLY)

3/31/99

SHEET 15 OF 19

DATE PLOTTED -> DATE 06/13/99
TIME PLOTTED -> TIME 10:00 AM
USERNAME -> USER