





DIST	COUNTY	ROUTE	KILOMETER POST TOTAL PROJECT	SHEET No	TOTAL SHEETS
12	Ora	241	30.1	18	19
Red Houshington 6/2/99 REGISTERED CIVIL ENGINEER REGISTERED PROFESSIONAL ENGINEER RICHARD W. HOISINGTON, JR. No. 42267 Exp. 3/31/00 CIVIL STATE OF CALIFORNIA					
PLANS APPROVAL DATE					
COUNTY OF ORANGE PUBLIC FACILITIES & RESOURCES DEPT. 300 N. FLOWER STREET SANTA ANA, CA 92703-5000					
The State of California or its officers or agents shall not be responsible for the accuracy or completeness of electronic copies of this plan sheet.					

NO AS BUILT CHANGES
AS BUILT


CORRECTIONS BY G. CUNNINGHAM/ RWH
CONTRACT NO. 1296-NMC-0130
DATE 5-8-01 / 6-1-01

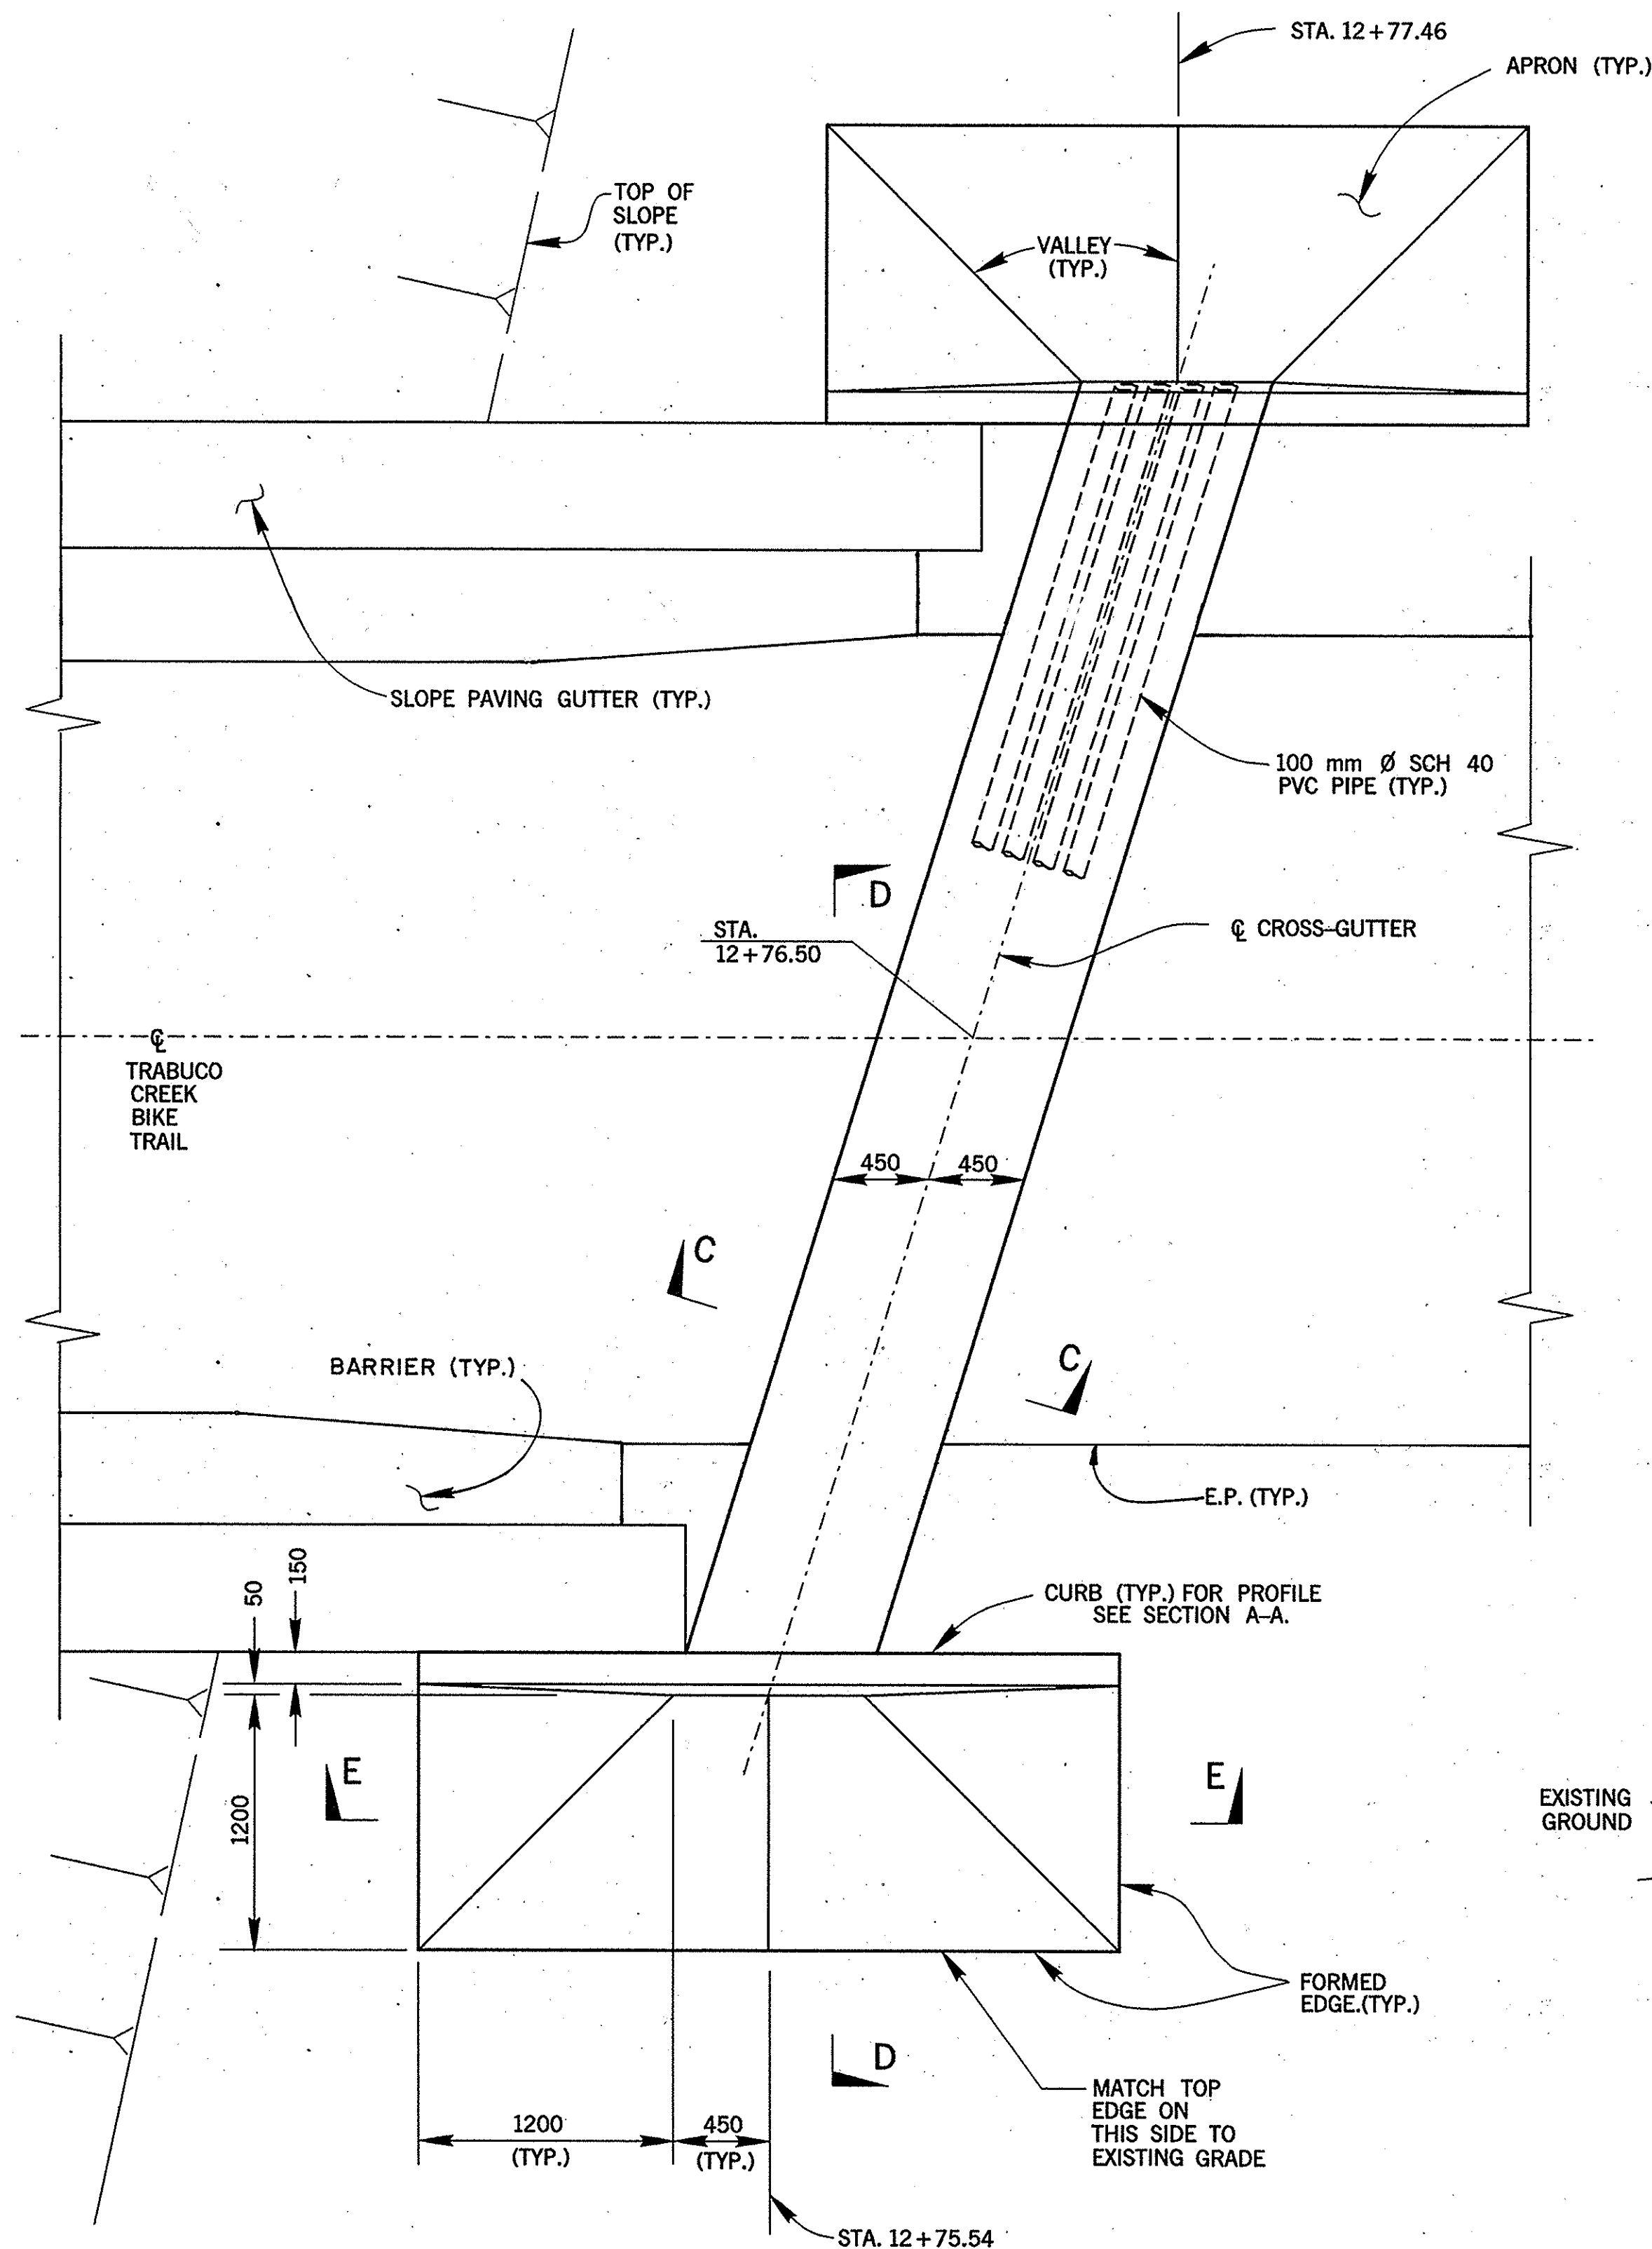


PLAN VIEW OF
CROSS GUTTER & APRONS
AT ABUT. 4
SCALE 1:25

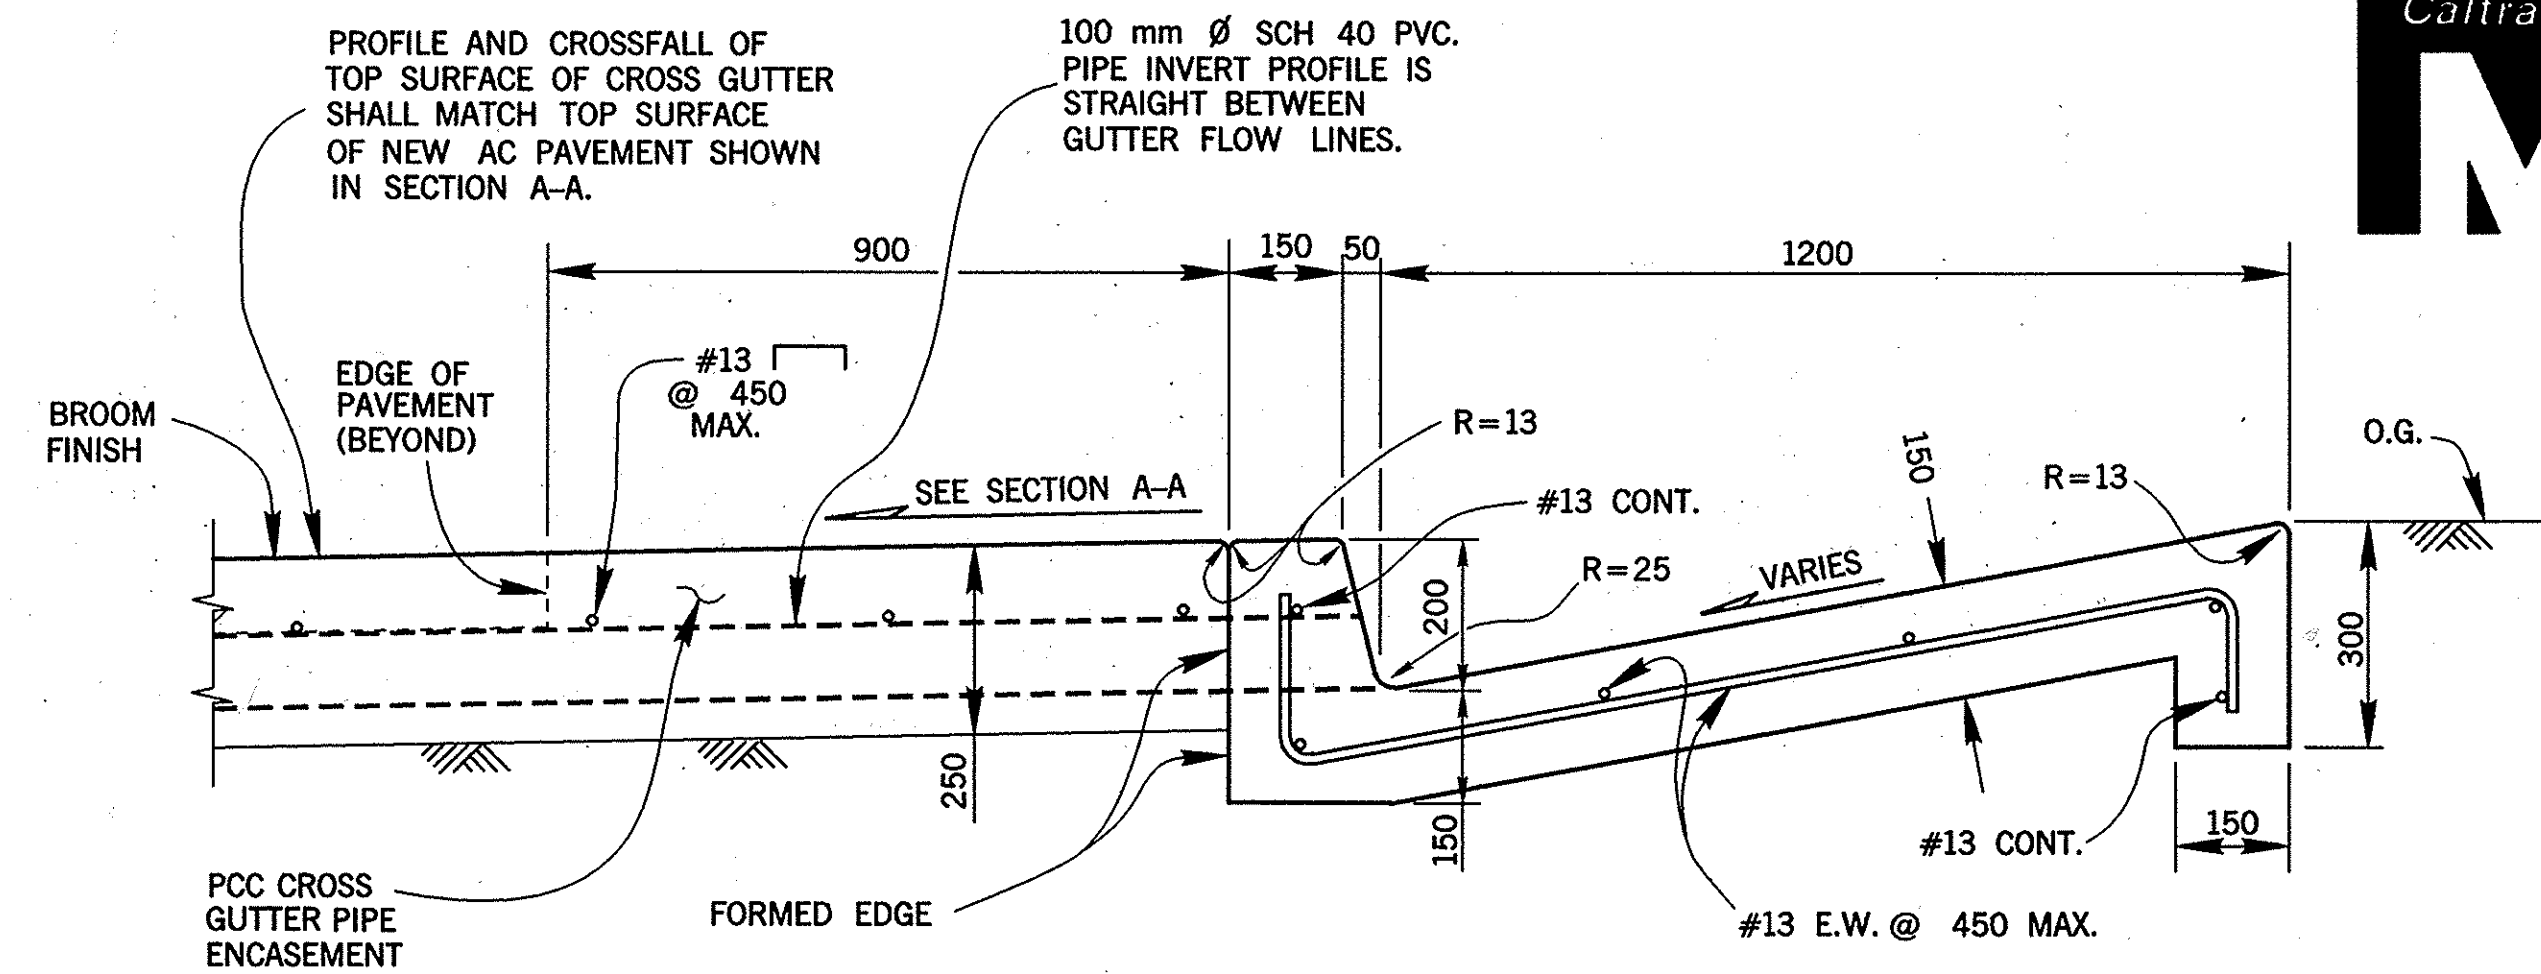


SECTION D-D
SCALE 1:10

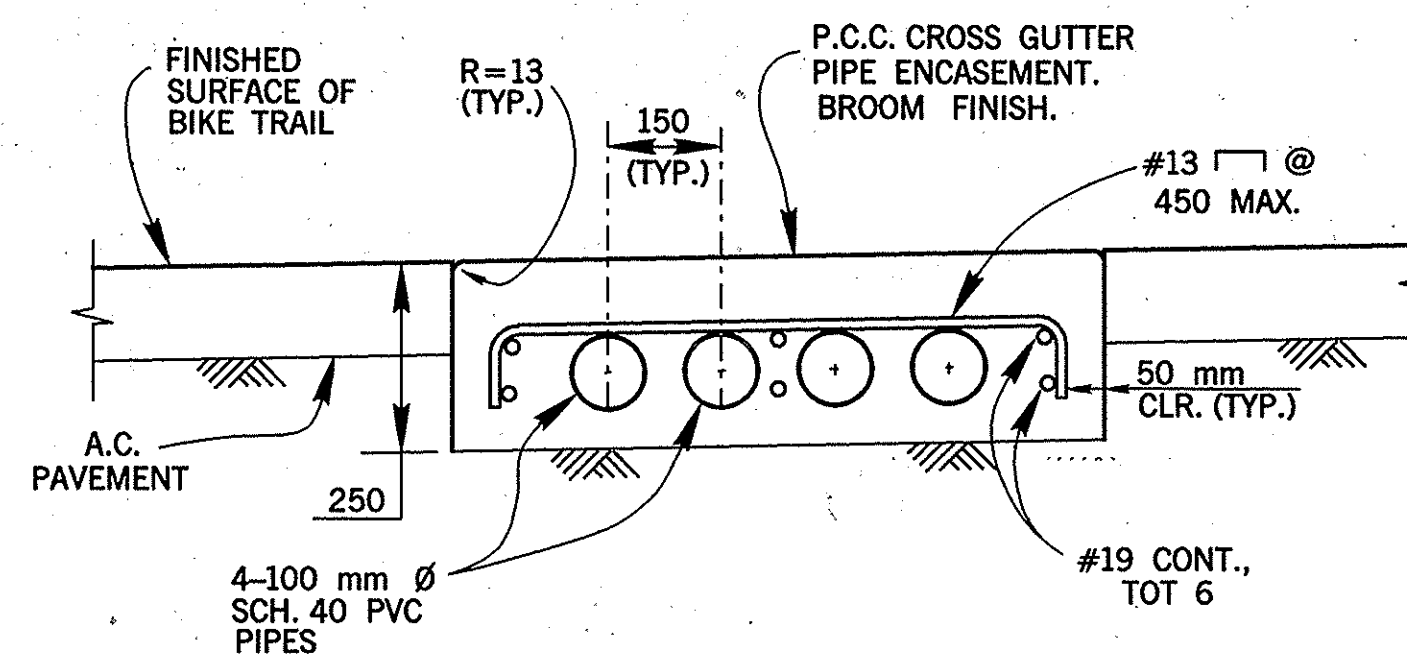

SECTION C-C
SCALE 1:10

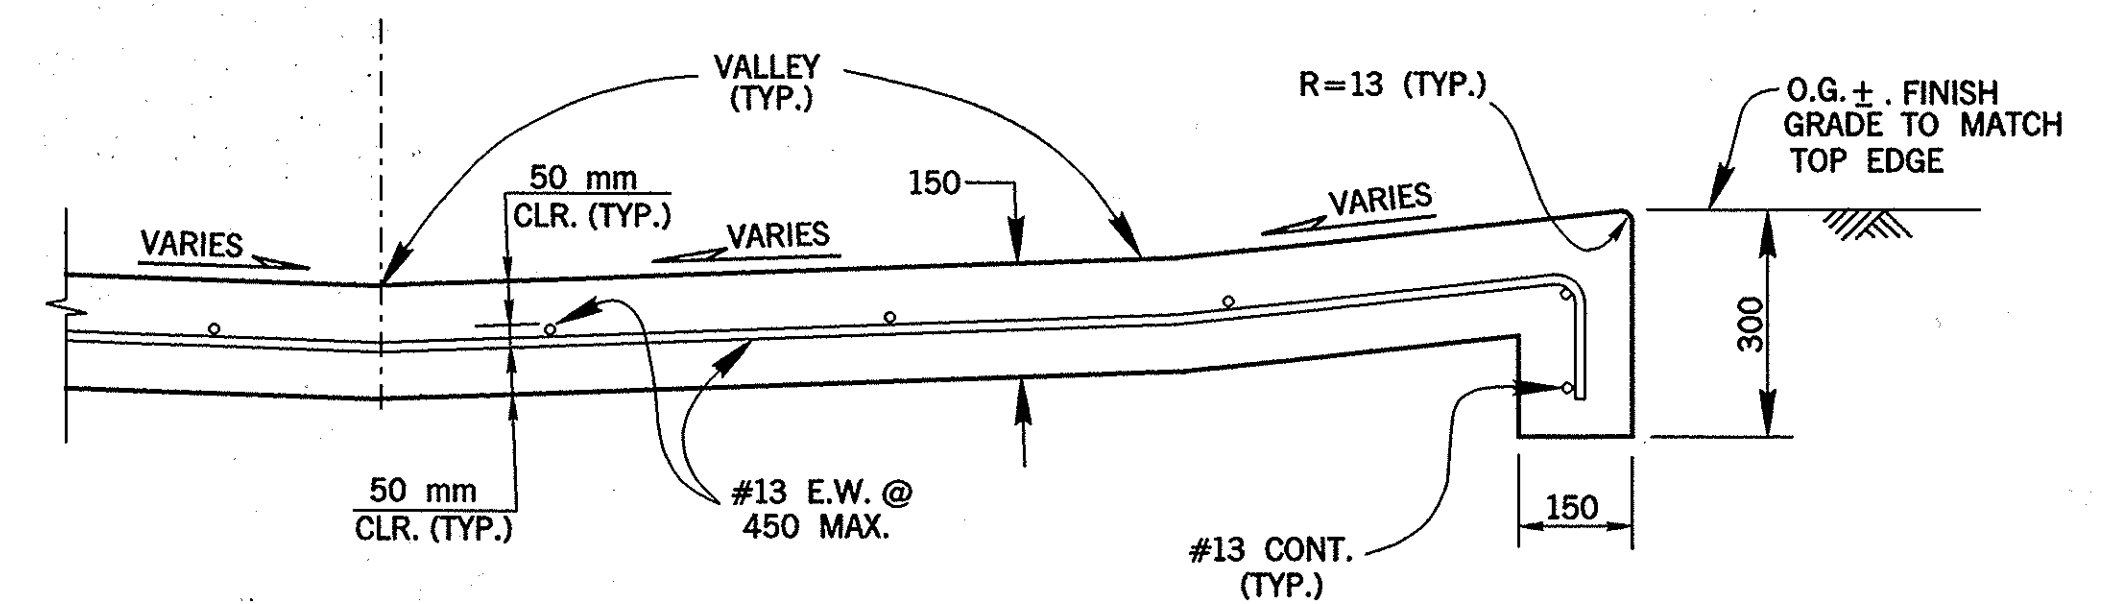


PARTIAL SECTION E-E
SCALE 1:10

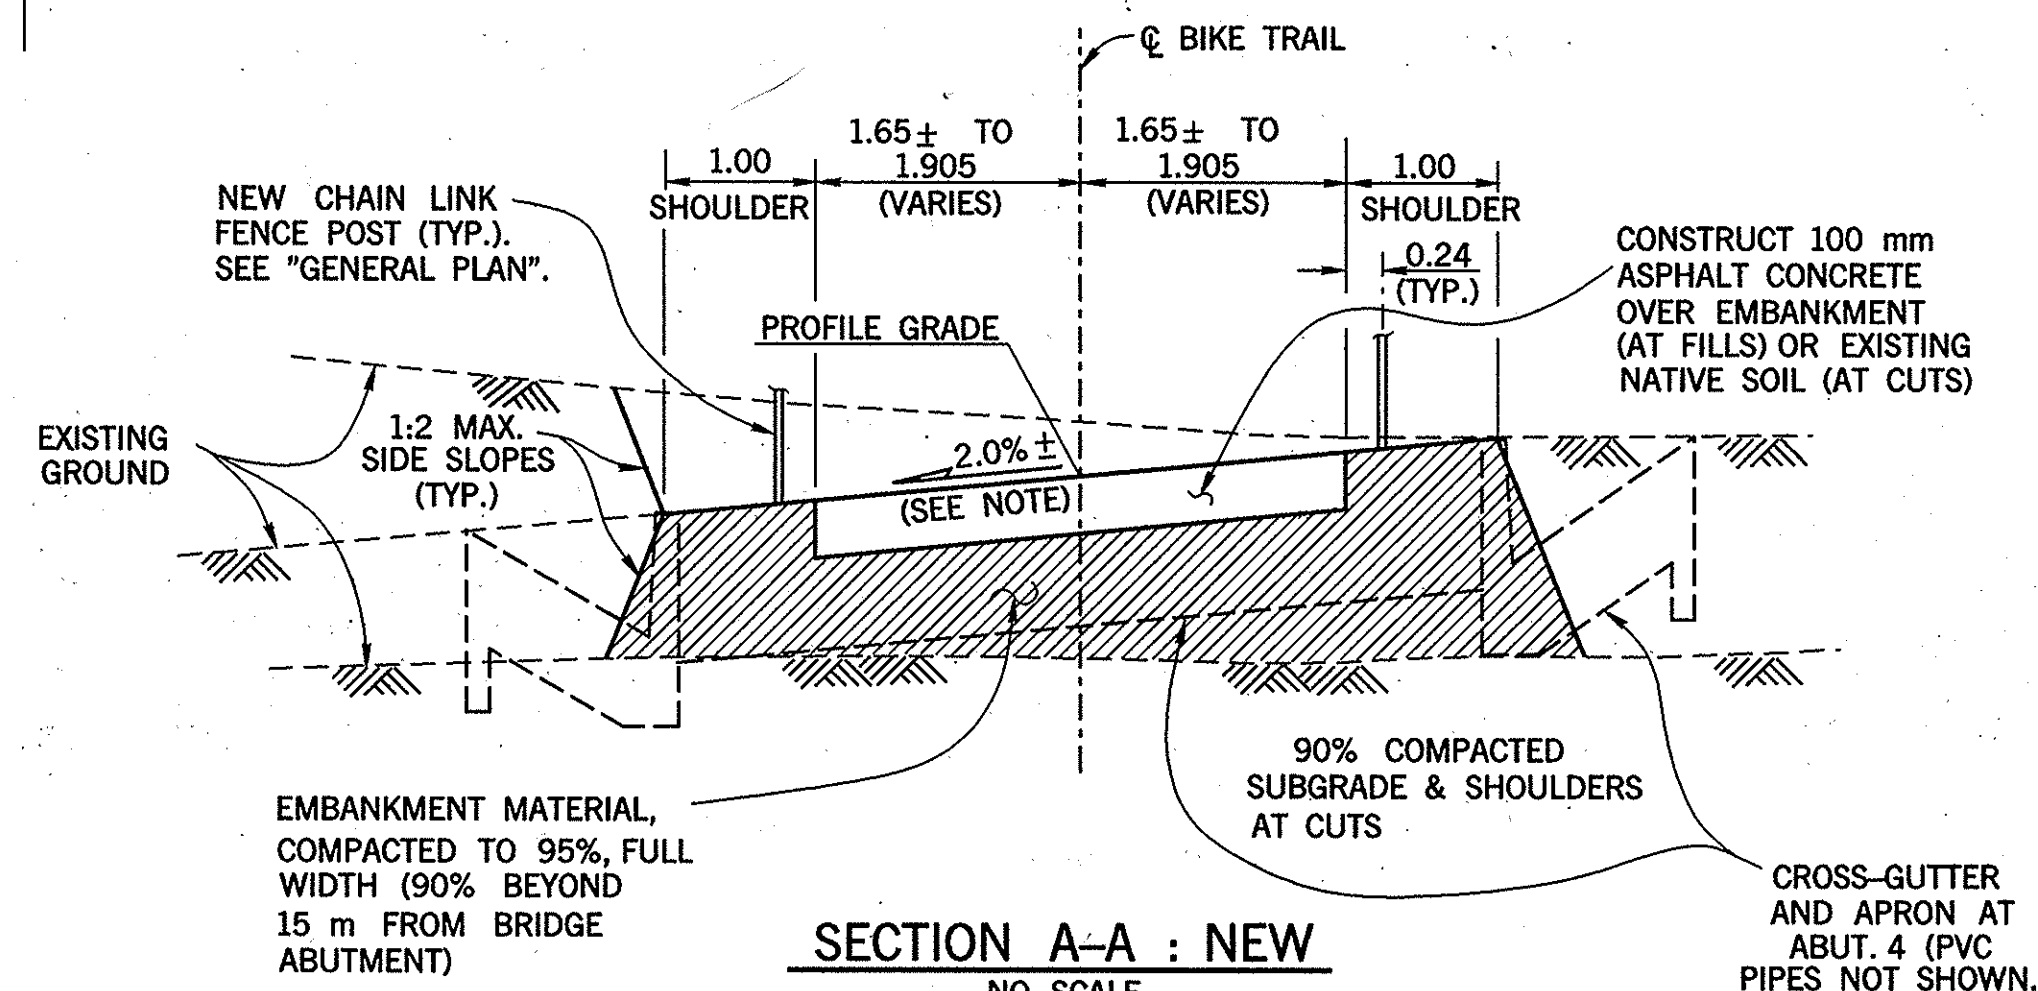

SECTION A-A : NEW
NO SCALE
STA. 11+23.4± TO STA. 11+48.1± AND
STA. 12+74.6± TO STA. 12+81.0±

NOTE :
THE CONTRACTOR SHALL PROVIDE A SMOOTH
TRANSITION BETWEEN THE EXISTING CROSSFALL
OF 2%± @ TIE-IN POINTS AND THE BRIDGE
CROSSFALL OF 2%, AS DIRECTED BY THE ENGINEER.

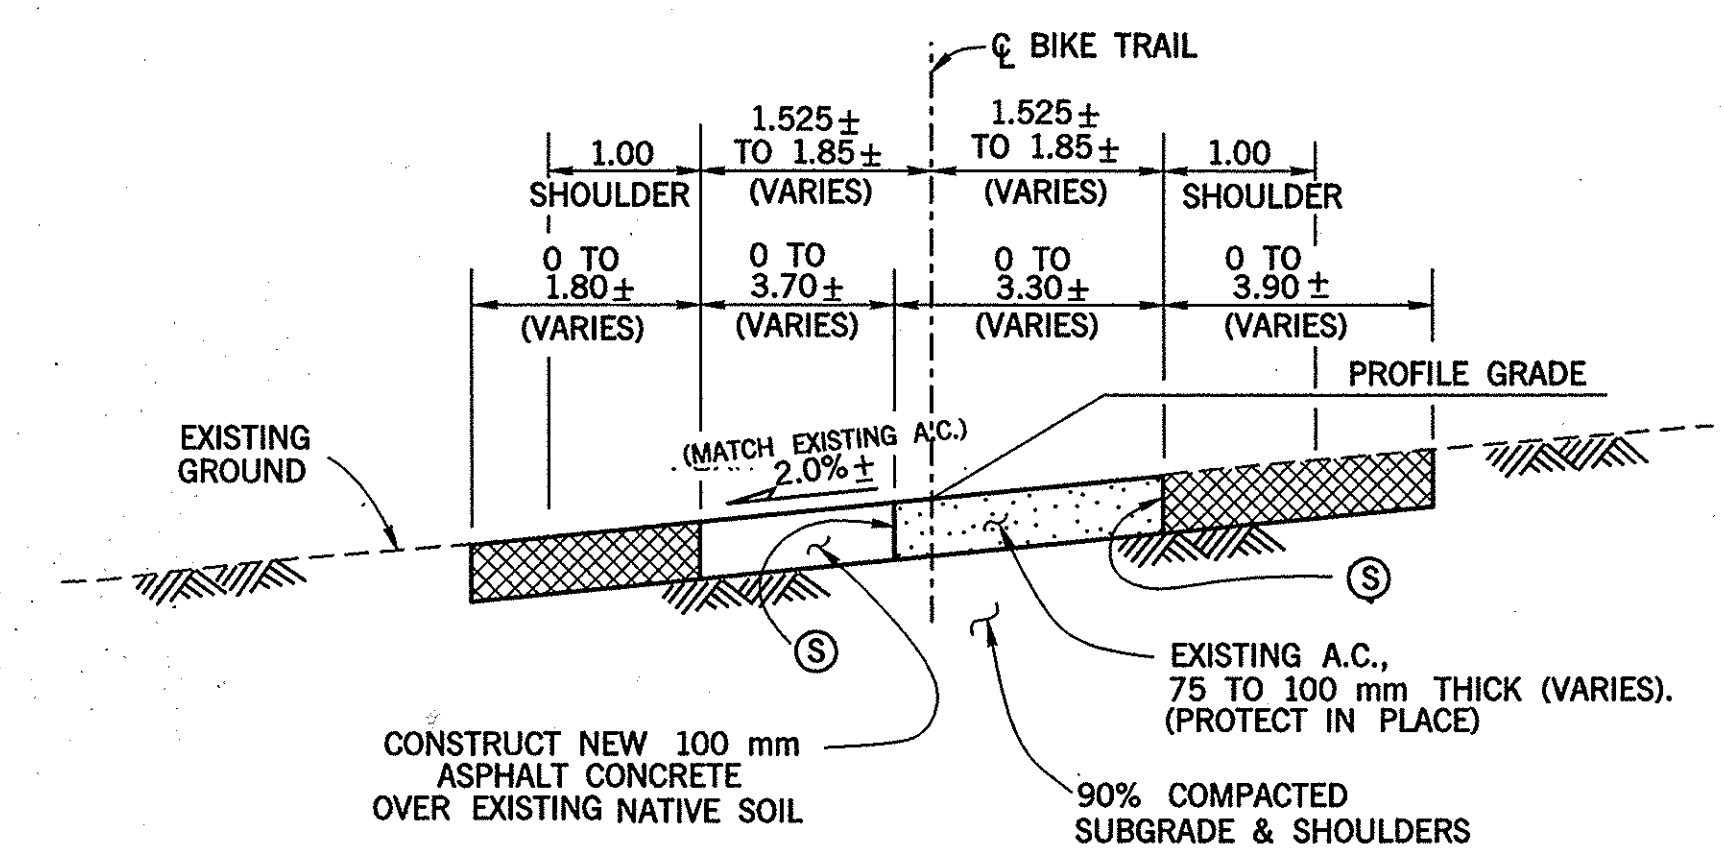

SECTION B-B : NEW/EXISTING
NO SCALE
STA. 11+07.38± TO STA. 11+23.4± AND
STA. 12+81.0± TO STA. 12+95.46±

BIKE PATH STRUCTURAL SECTIONS
(SEE "GENERAL PLAN" SHEET FOR PLAN VIEW.)

ALL DIMENSIONS ARE IN
MILLIMETERS UNLESS OTHERWISE SHOWN

Steve Nakao
DESIGN OVERSIGHT
STEVE NAKAO
6/2/99
SIGN OFF DATE

DESIGN	BY	RICH HOISINGTON	CHECKED	JOHN SARAH McLEAN & SCHULTZ
DETAILS	BY	RICH HOISINGTON	CHECKED	JOHN SARAH McLEAN & SCHULTZ
QUANTITIES	BY	RICH HOISINGTON	CHECKED	JOHN SARAH McLEAN & SCHULTZ

PREPARED FOR THE
STATE OF CALIFORNIA
DEPARTMENT OF TRANSPORTATION

RICH HOISINGTON
PROJECT ENGINEER

BRIDGE NO.	55-953
KILOMETER POST	30.1

TRABUCO CREEK BIKE TRAIL OVERCROSSING
BIKE TRAIL DETAILS

DESIGN DETAIL SHEET (METRIC) (REV. 9/2/98)

ORIGINAL SCALE IN MILLIMETERS
FOR REDUCED PLANS

CU
EA

DISREGARD PRINTS BEARING
EARLIER REVISION DATES

REVISION DATES (PRELIMINARY STAGE ONLY)

SHEET 18 OF 19

FILE -> \$REQUEST
d:\cadd\metric\trabuco\bike\trd1.dgn (3P)

SCALE 25:1