
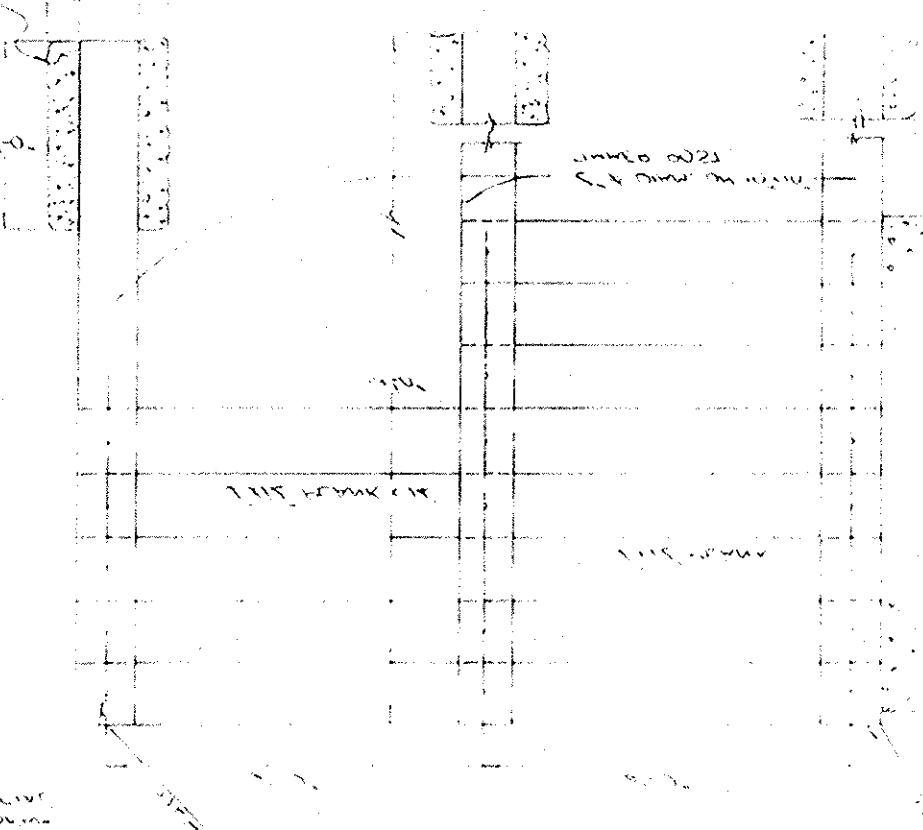


[illegible]

Hand-drawn floor plan of a building. The plan shows a large central hall (बैठक) and several smaller rooms. Handwritten labels in Hindi are present, such as 'कitchen' (kitchen), 'बैठक' (meeting room), and 'दफ्तर' (office). The drawing is on a grid background.

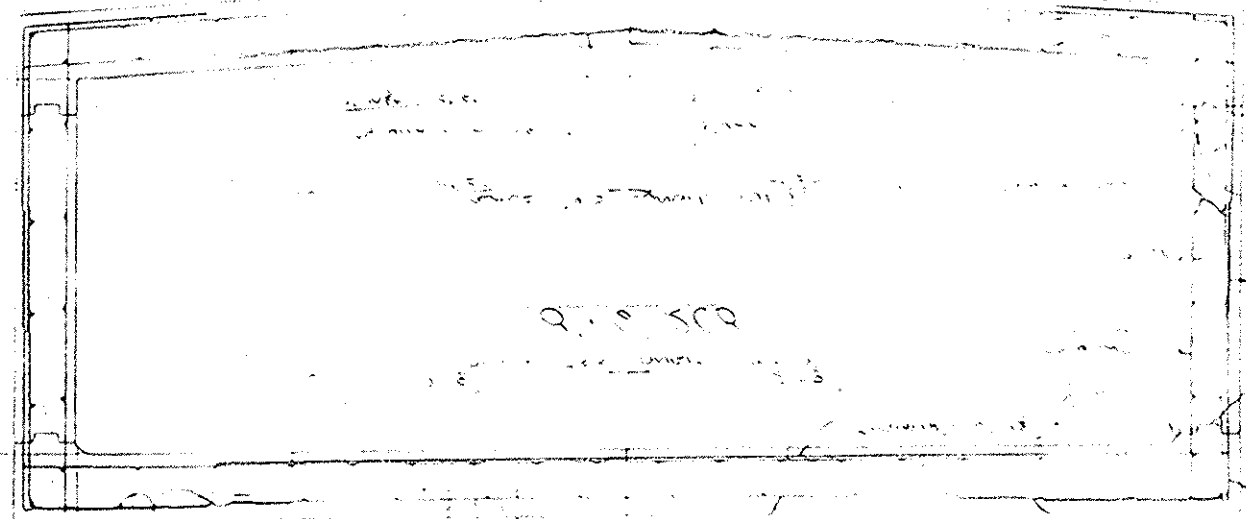

1. The first step is to identify the problem or question that needs to be answered. This involves understanding the context and the specific information required.

[illegible]

Q. 1. 2. 3. 4. 5.