

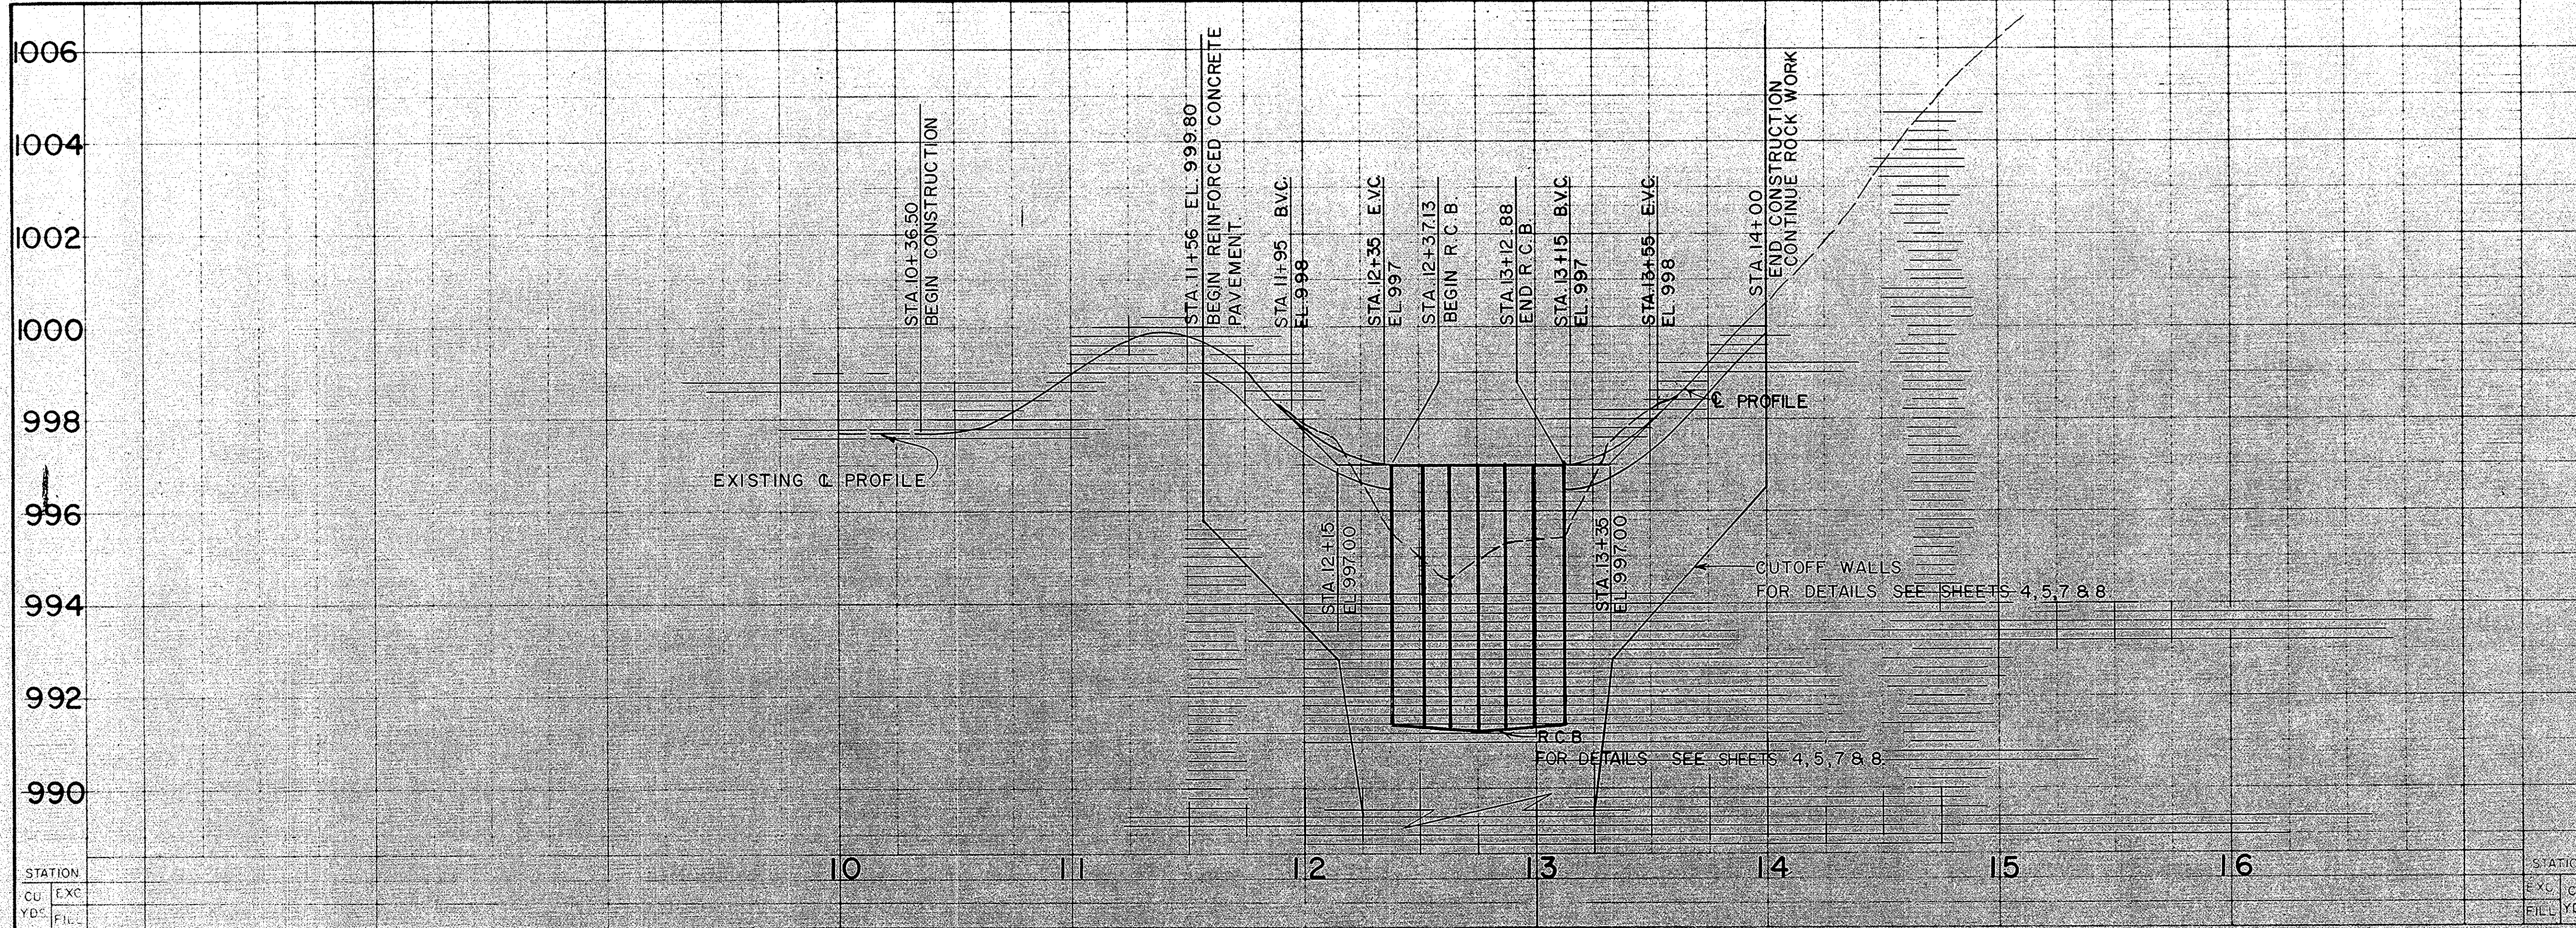


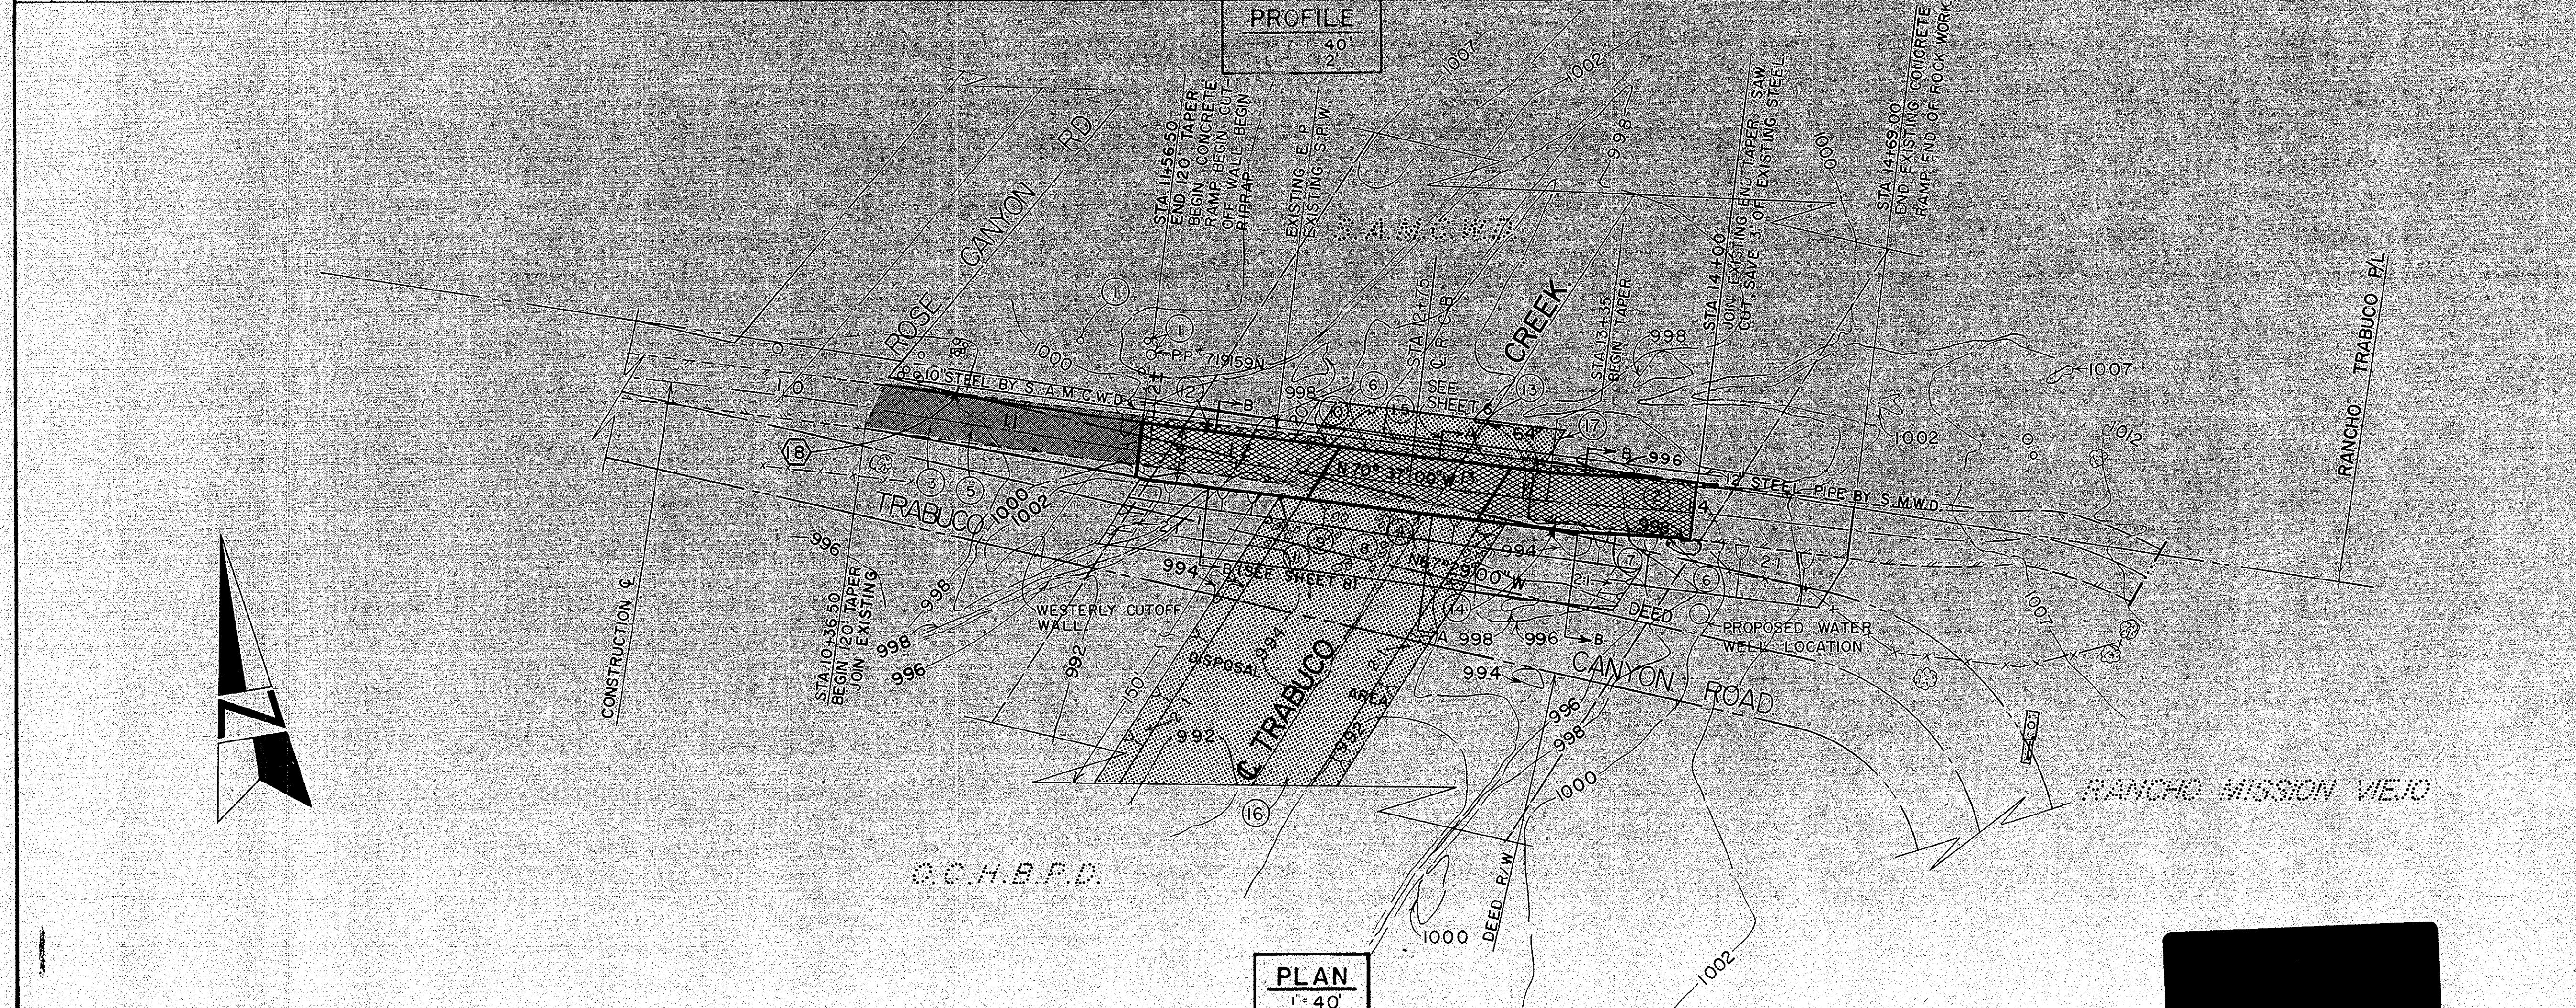

CONSTRUCTION NOTES

1. Protect in place.
2. Remove existing reinforced concrete road.
3. Remove.
4. Construct reinforced concrete culvert per detail, see sheets 4 & 5.
5. Construct 3" A.C. pavement.
6. Construct reinforced concrete pavement with cutoff walls per detail, sheets 4, 6, 7 & 8.
7. Construct concreted 1/4 ton rock riprap slope protection per detail, sheets 6 & 8.
8. Construct 1/2 ton riprap blanket.
9. Construct drainage system in riprap per detail, sheets 6 & 8.
10. Construct guard rail per O.C. standard 403 details on sheet 7 & 9.
11. Construct 12" filter blanket over filter fabric per detail, sheets 6 & 8.
12. Saw cut existing concrete road 2 ft. from u/s side as shown.
13. Protect existing sheet pile wall.
14. Remove existing sheet pile wall.
15. Protect water lines.
16. Grade to drain.
17. Daylight u/s side from box invert to approximate channel invert (elevation 995.00).

18 Relocation.

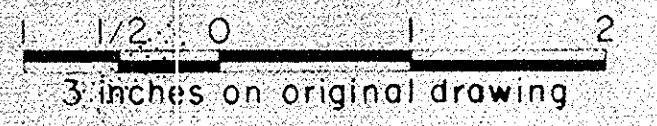

1080 CONSTRUCTION NOTE 18.		ORANGE COUNTY ENVIRONMENTAL MANAGEMENT AGENCY	
		TRABUCO CANYON ROAD ROAD PLAN AND PROFILE	
MARK	DATE	DESCRIPTION	PREPARED UNDER SUPERVISION OF <i>M.A. Murphy</i> 9/1/80
DESIGNED <i>H.S.H.</i>		SCALE <i>AS SHOWN</i>	DATE <i>6-80</i>
DRAWN <i>H.S.H.</i>		CHECKED <i>H.S.H.</i>	DWG. NO. <i>2</i>

DR 20 13306