



ELEVATION
SCALE 1" = 4' (SKEWED 64°)

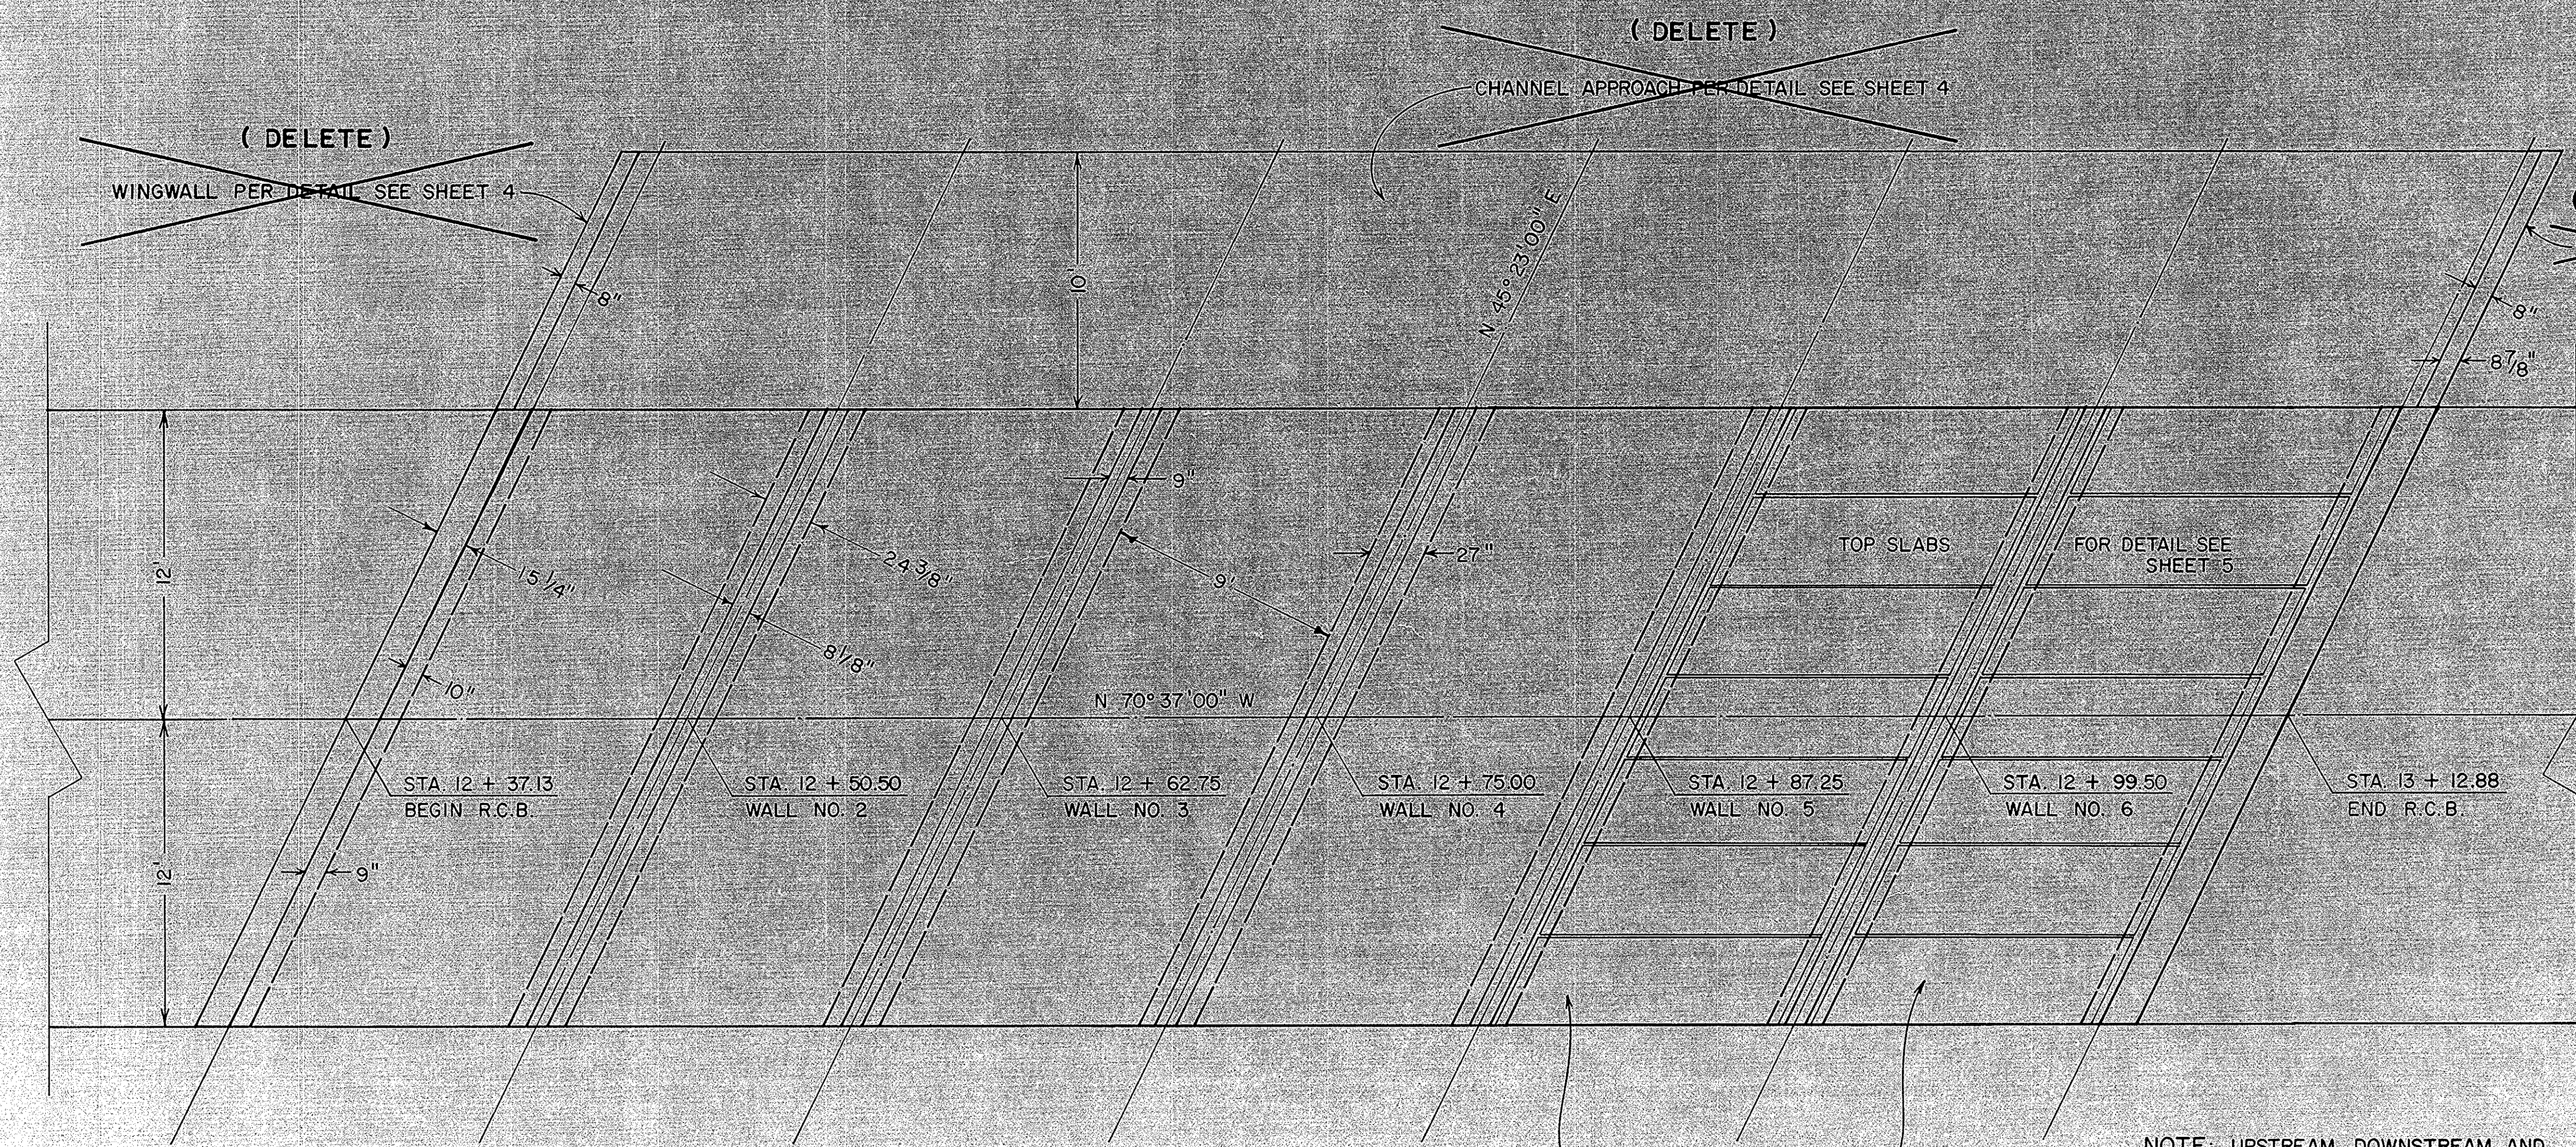

PLAN
SCALE 1" = 4'

NOTE: UPSTREAM, DOWNSTREAM AND CHANNEL APPROACH CUTOFF WALLS ARE NOT SHOWN

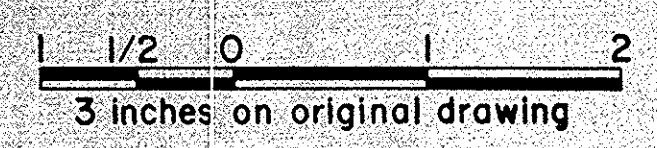

X 10-80 DELETE CHANNEL APPROACH.		ORANGE COUNTY ENVIRONMENTAL MANAGEMENT AGENCY			
		TRABUCO CANYON ROAD			
		GENERAL LAYOUT			
MARK	DATE	DESCRIPTION	PREPARED UNDER SUPERVISION OF	DATE	SHEET
		REVISIONS	M. J. Murphy		3
DESIGNED	H.S.H.	SCALE	DATE	DWG. NO.	
DRAWN	AS SHOWN	CHECKED	8-80		

DR 20 13306