
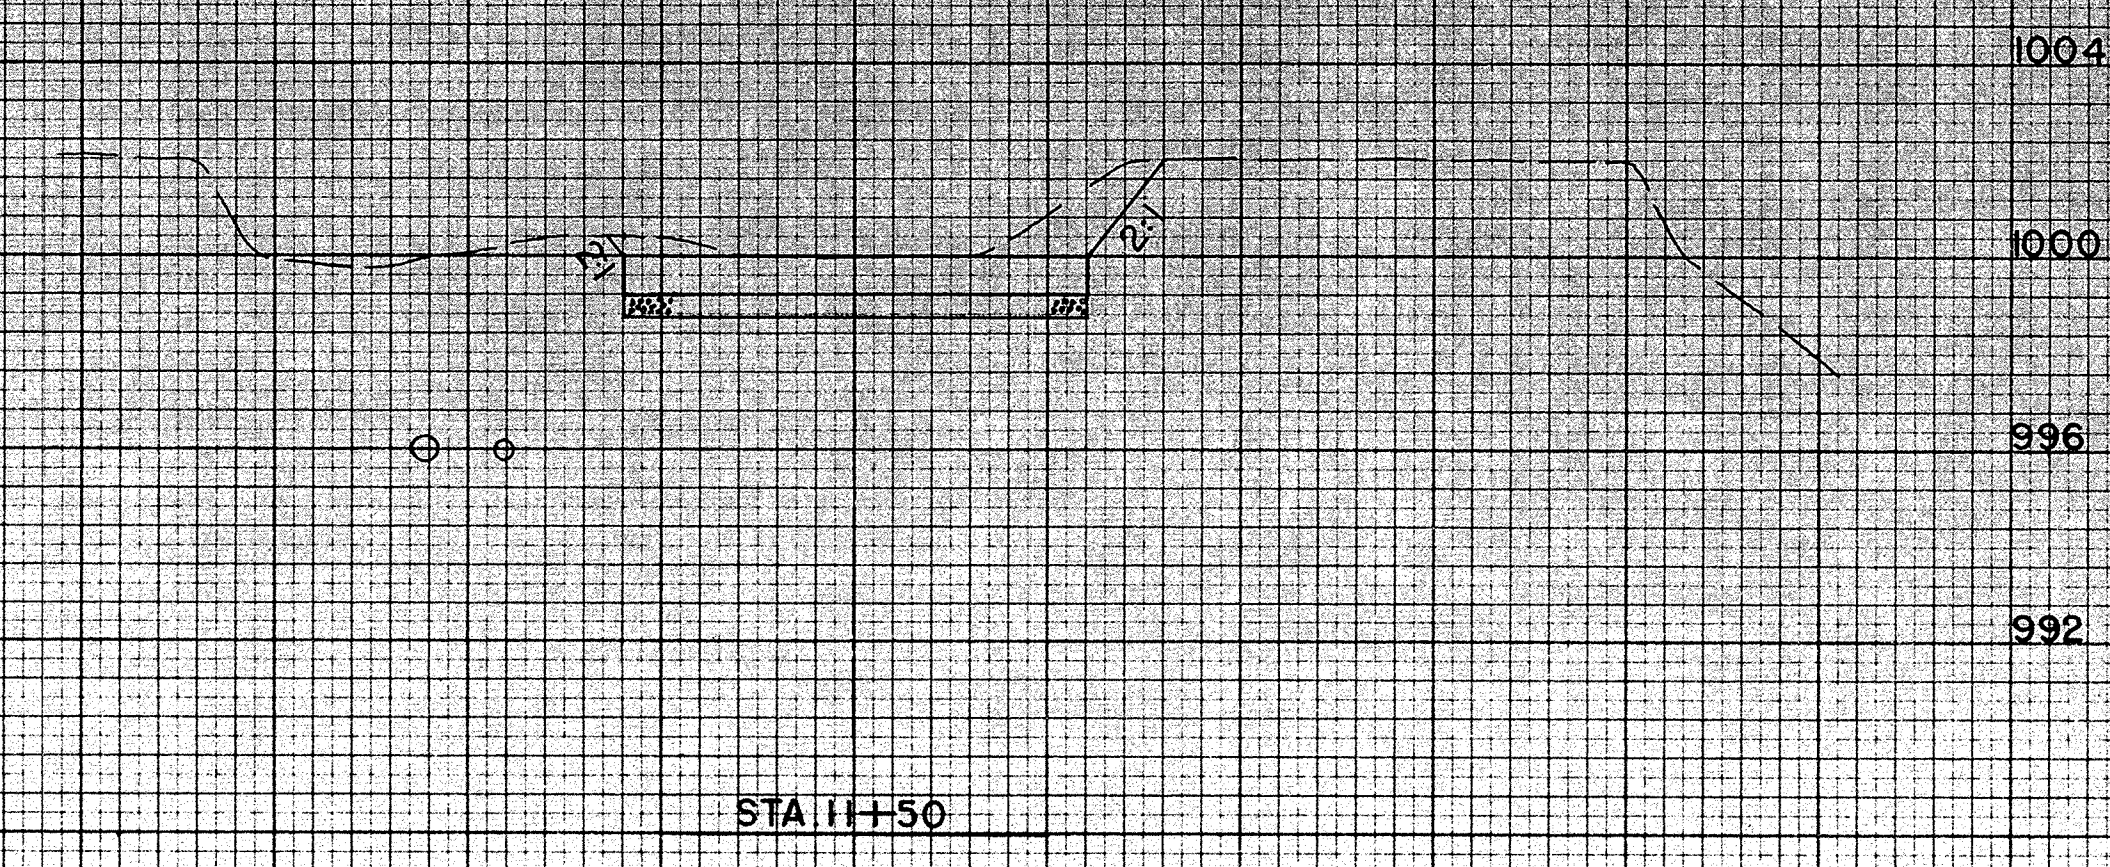
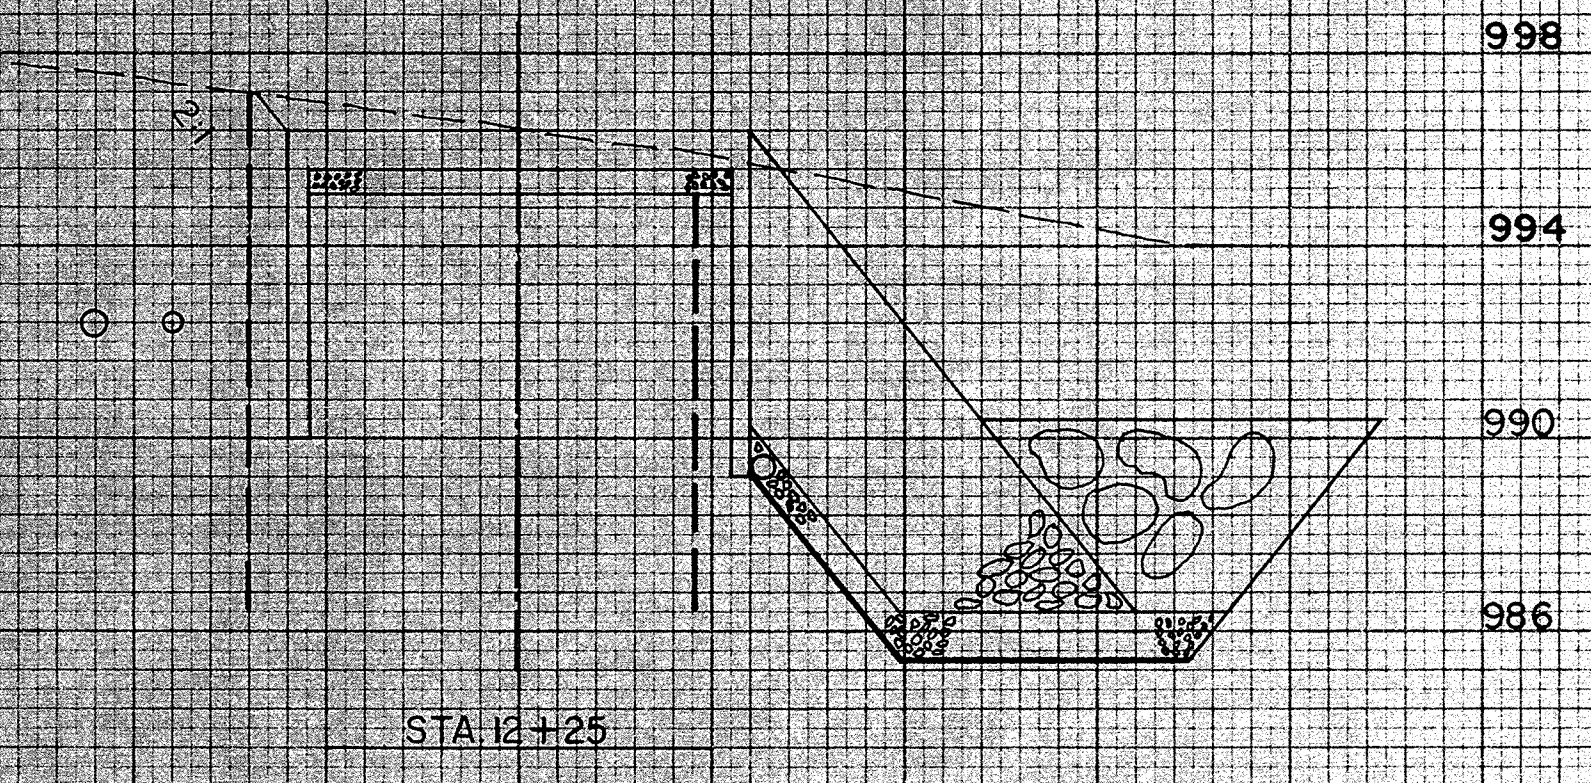
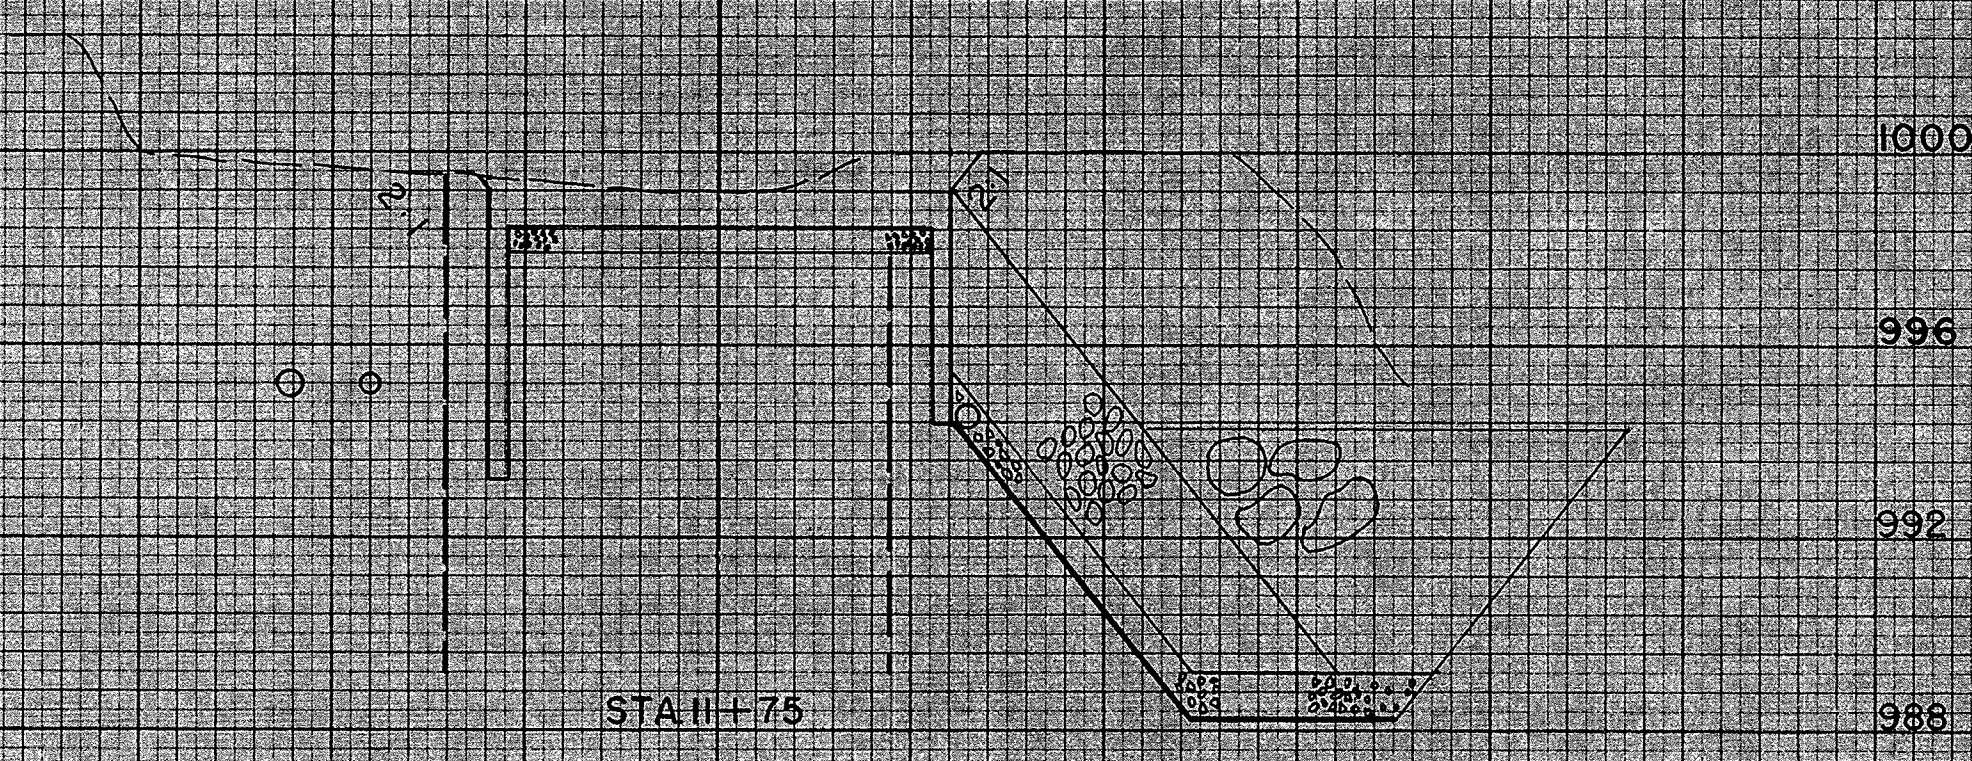
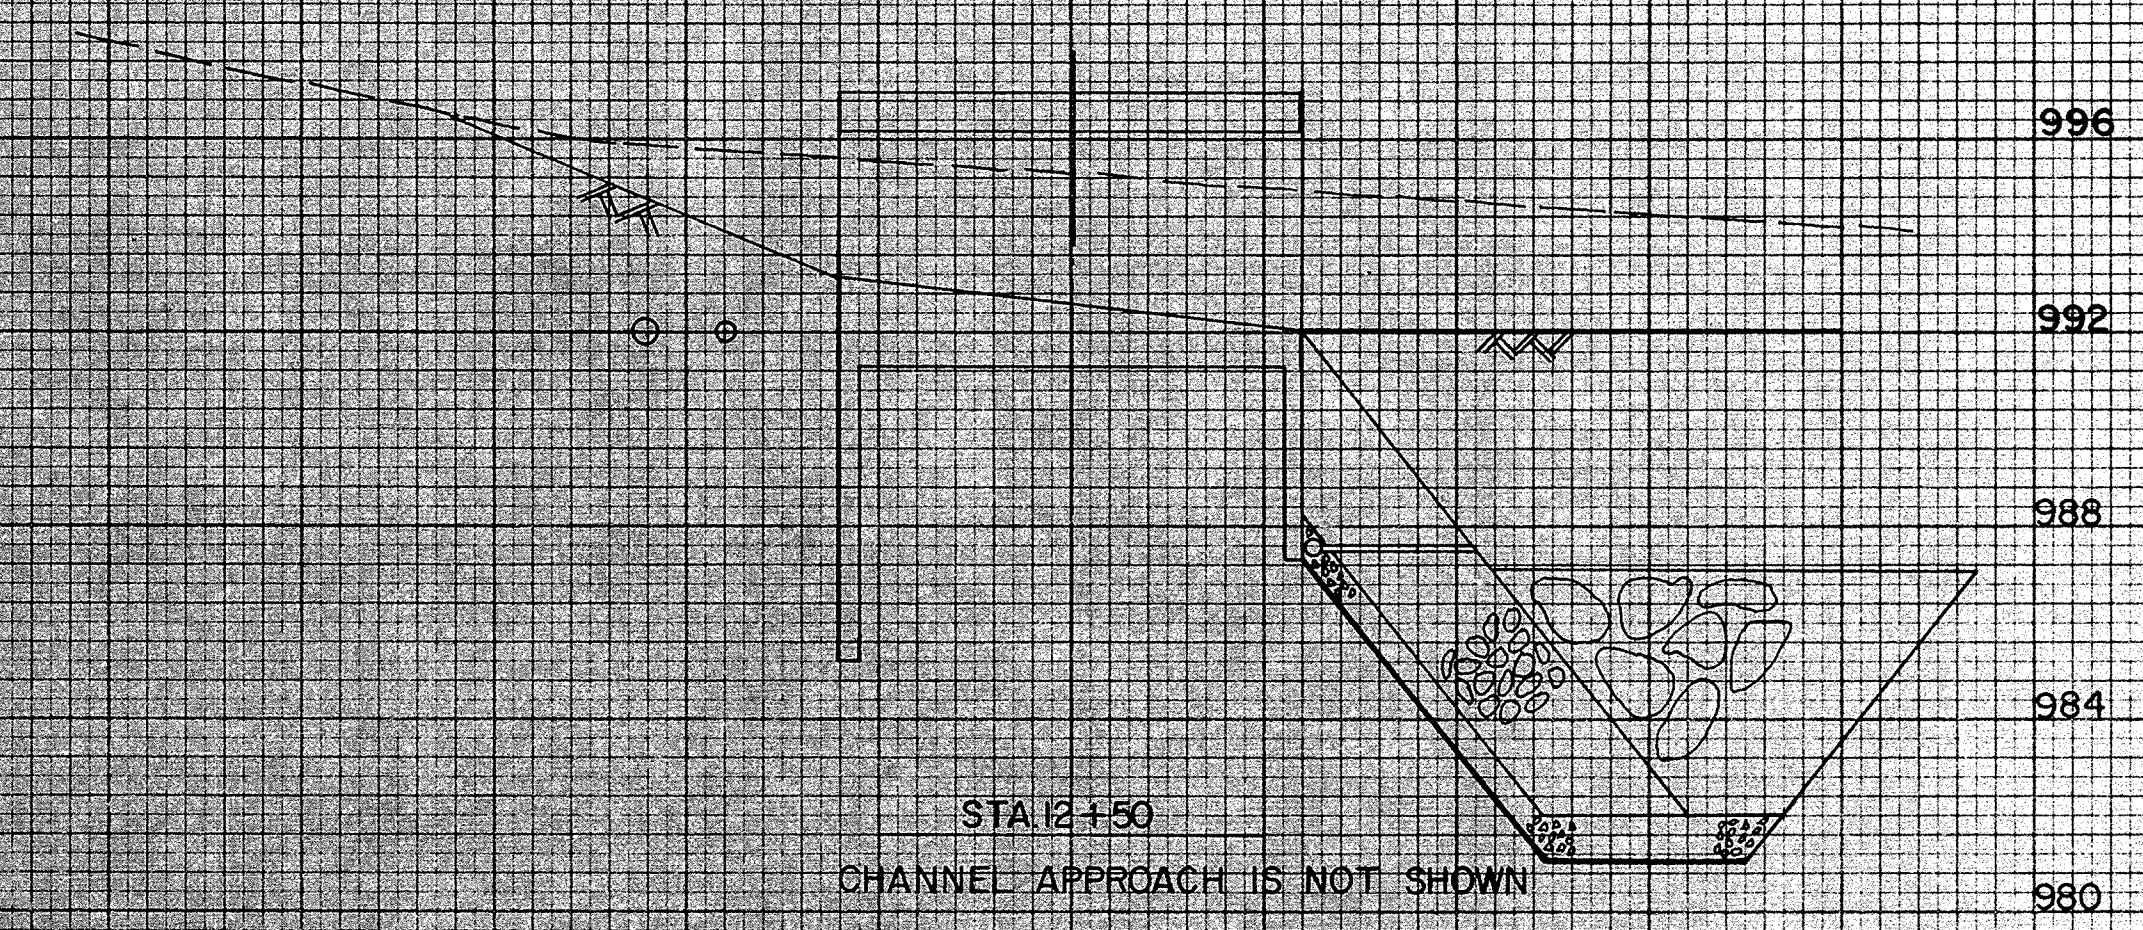


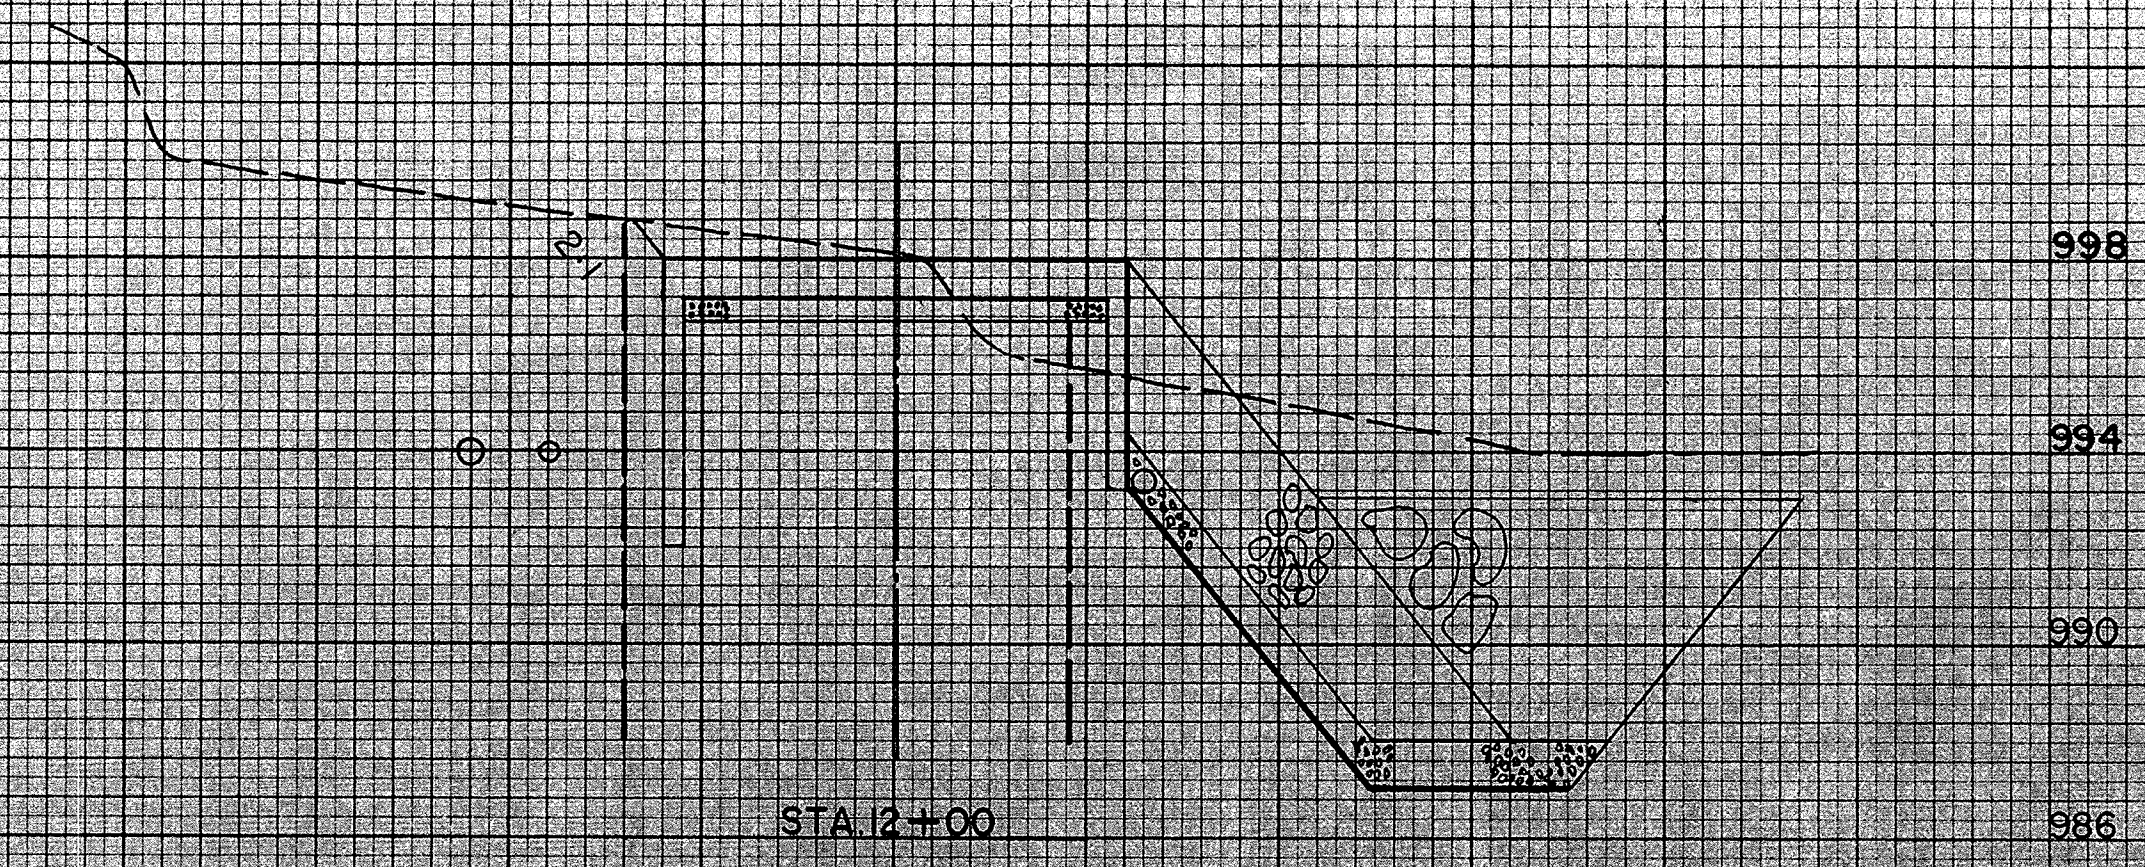

SCALE:
VER. 1" = 4'
HOR. 1" = 10'

ORANGE COUNTY
ENVIRONMENTAL MANAGEMENT AGENCY

TRABUCO CANYON ROAD
ROAD CROSS SECTIONS

MARK	DATE	DESCRIPTION	PREPARED UNDER SUPERVISION OF	DATE	SHEET
			M.C. Murphy	5/1/80	10
REVISIONS					
DESIGNED		H.S.H.	SCALE	DATE	DWG. NO.
DRAWN		H.S.H.	AS SHOWN	7-80	