


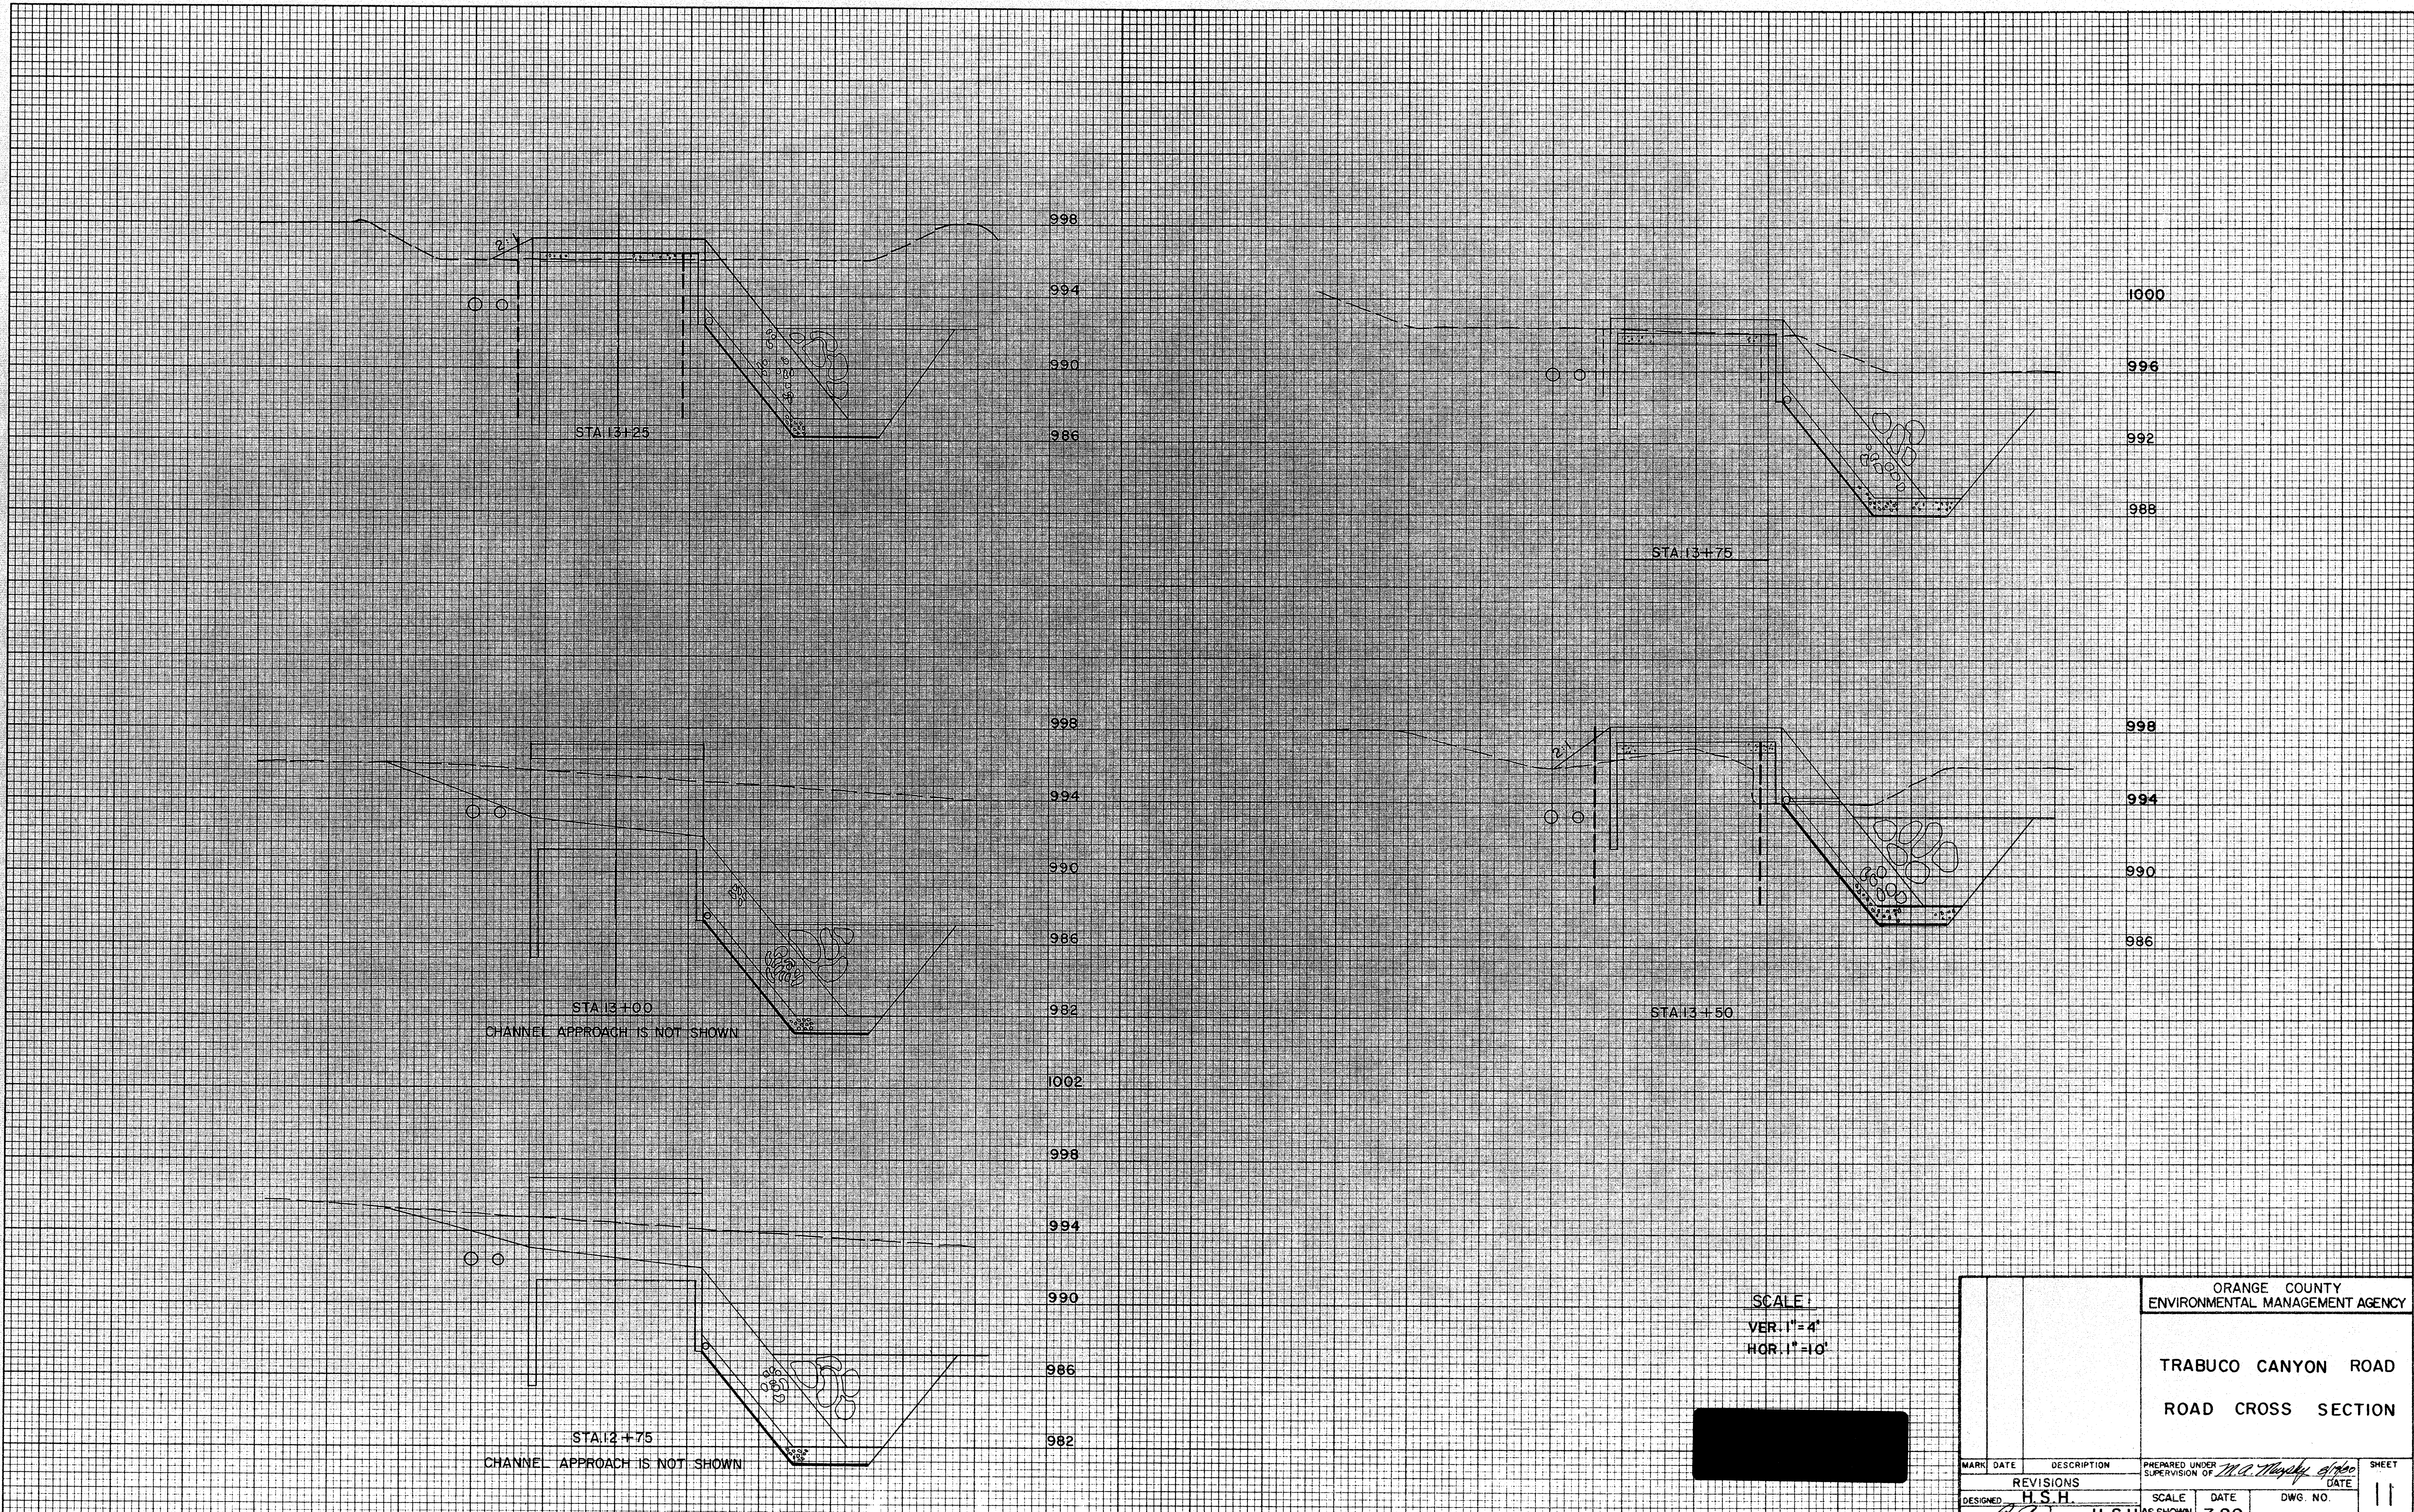

ORANGE COUNTY ENVIRONMENTAL MANAGEMENT AGENCY	
TRABUCO CANYON ROAD ROAD CROSS SECTION	
MARK	DATE
REVISIONS	
DESIGNED	H.S.H.
DRAWN	H.S.H.
CHECKED	H.S.H.
SCALE	DATE
AS SHOWN	7-80
DWG. NO.	11