



CONSTRUCTION NOTES


1. INSTALL 10" DUCTILE IRON WATER PIPELINE BETWEEN STA. 12+00.08 AND STA. 13+64.63 AS SHOWN.
2. CONSTRUCT AN AIR VACUUM RELEASE VALVE AT STA. 12+00.08.
3. CAD WELD 2#6 WIRES ACROSS EACH JOINT PER DETAIL SEE SHEET 14.
4. COAT EXPOSED STEEL WITH 2 COATS OF E C 244 OR AN APPROVED EQUAL (NUTS,BOLTS,FLANGES,REINFORCING BARS)
5. PRESSURE TEST SHALL BE 250 P.S.I.
6. EXISTING 10" W.S.P. CM / LM PIPE SHALL REMAIN IN SERVICE UNTIL NEW PIPE HAS BEEN PRESSURE TESTED,CHLORINATED AND PASSED THE BACTERIA TEST.
7. THE EXISTING WATER MAIN SHALL BE OUT OF SERVICE A MAXIMUM OF 24 HOURS DURING CONNECTION OF THE NEW PIPELINE.
8. THE S.A.M.C.W.D. SHALL BE NOTIFIED 72 HOURS BEFORE PROPOSED SHUTDOWN. APPROVAL MUST BE OBTAINED FROM DISTRICT MANAGER FOR SHUTDOWN.

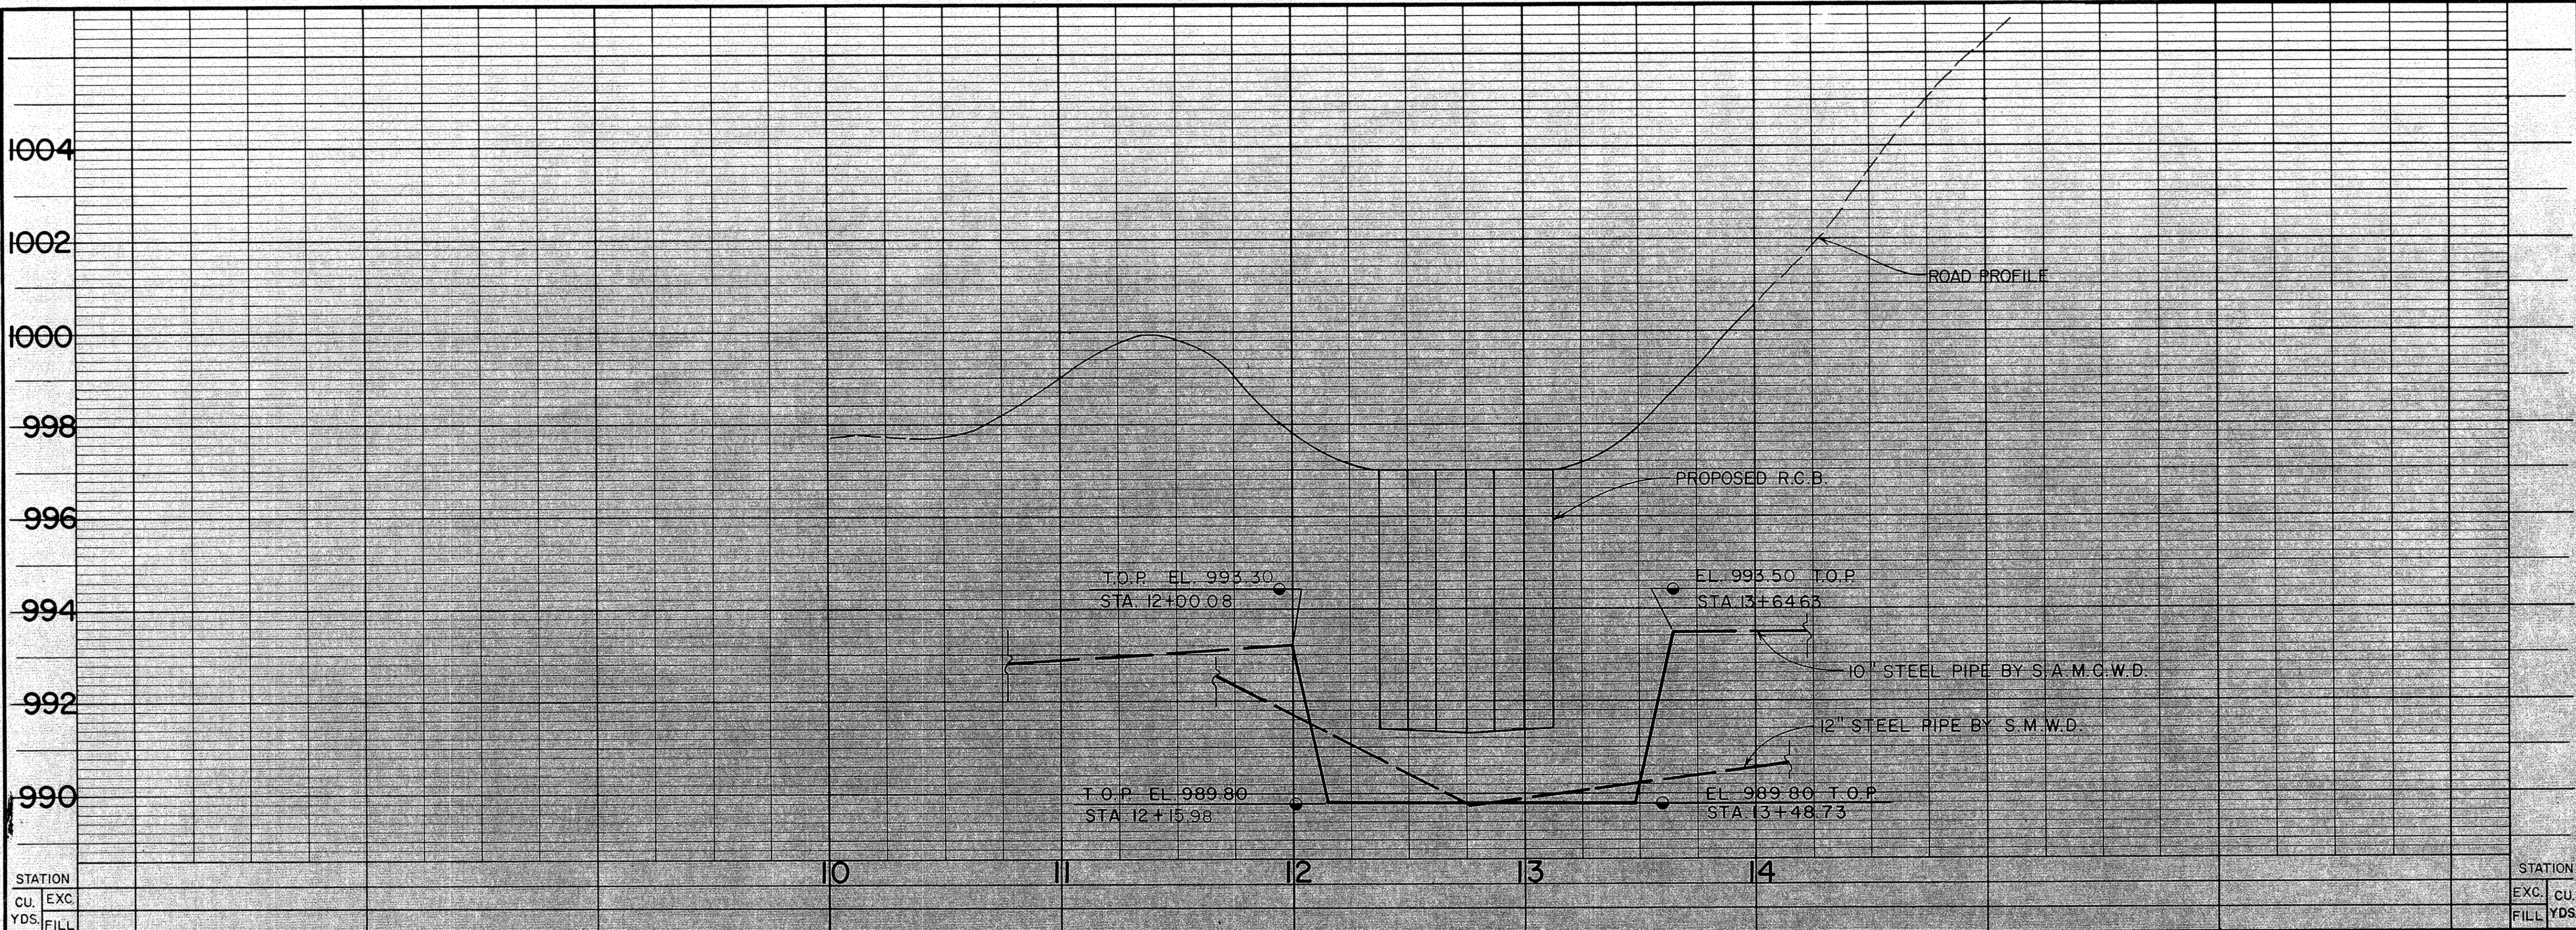

PROFILE
HORIZ. 1" = 40'
VERT. 1" = 2'

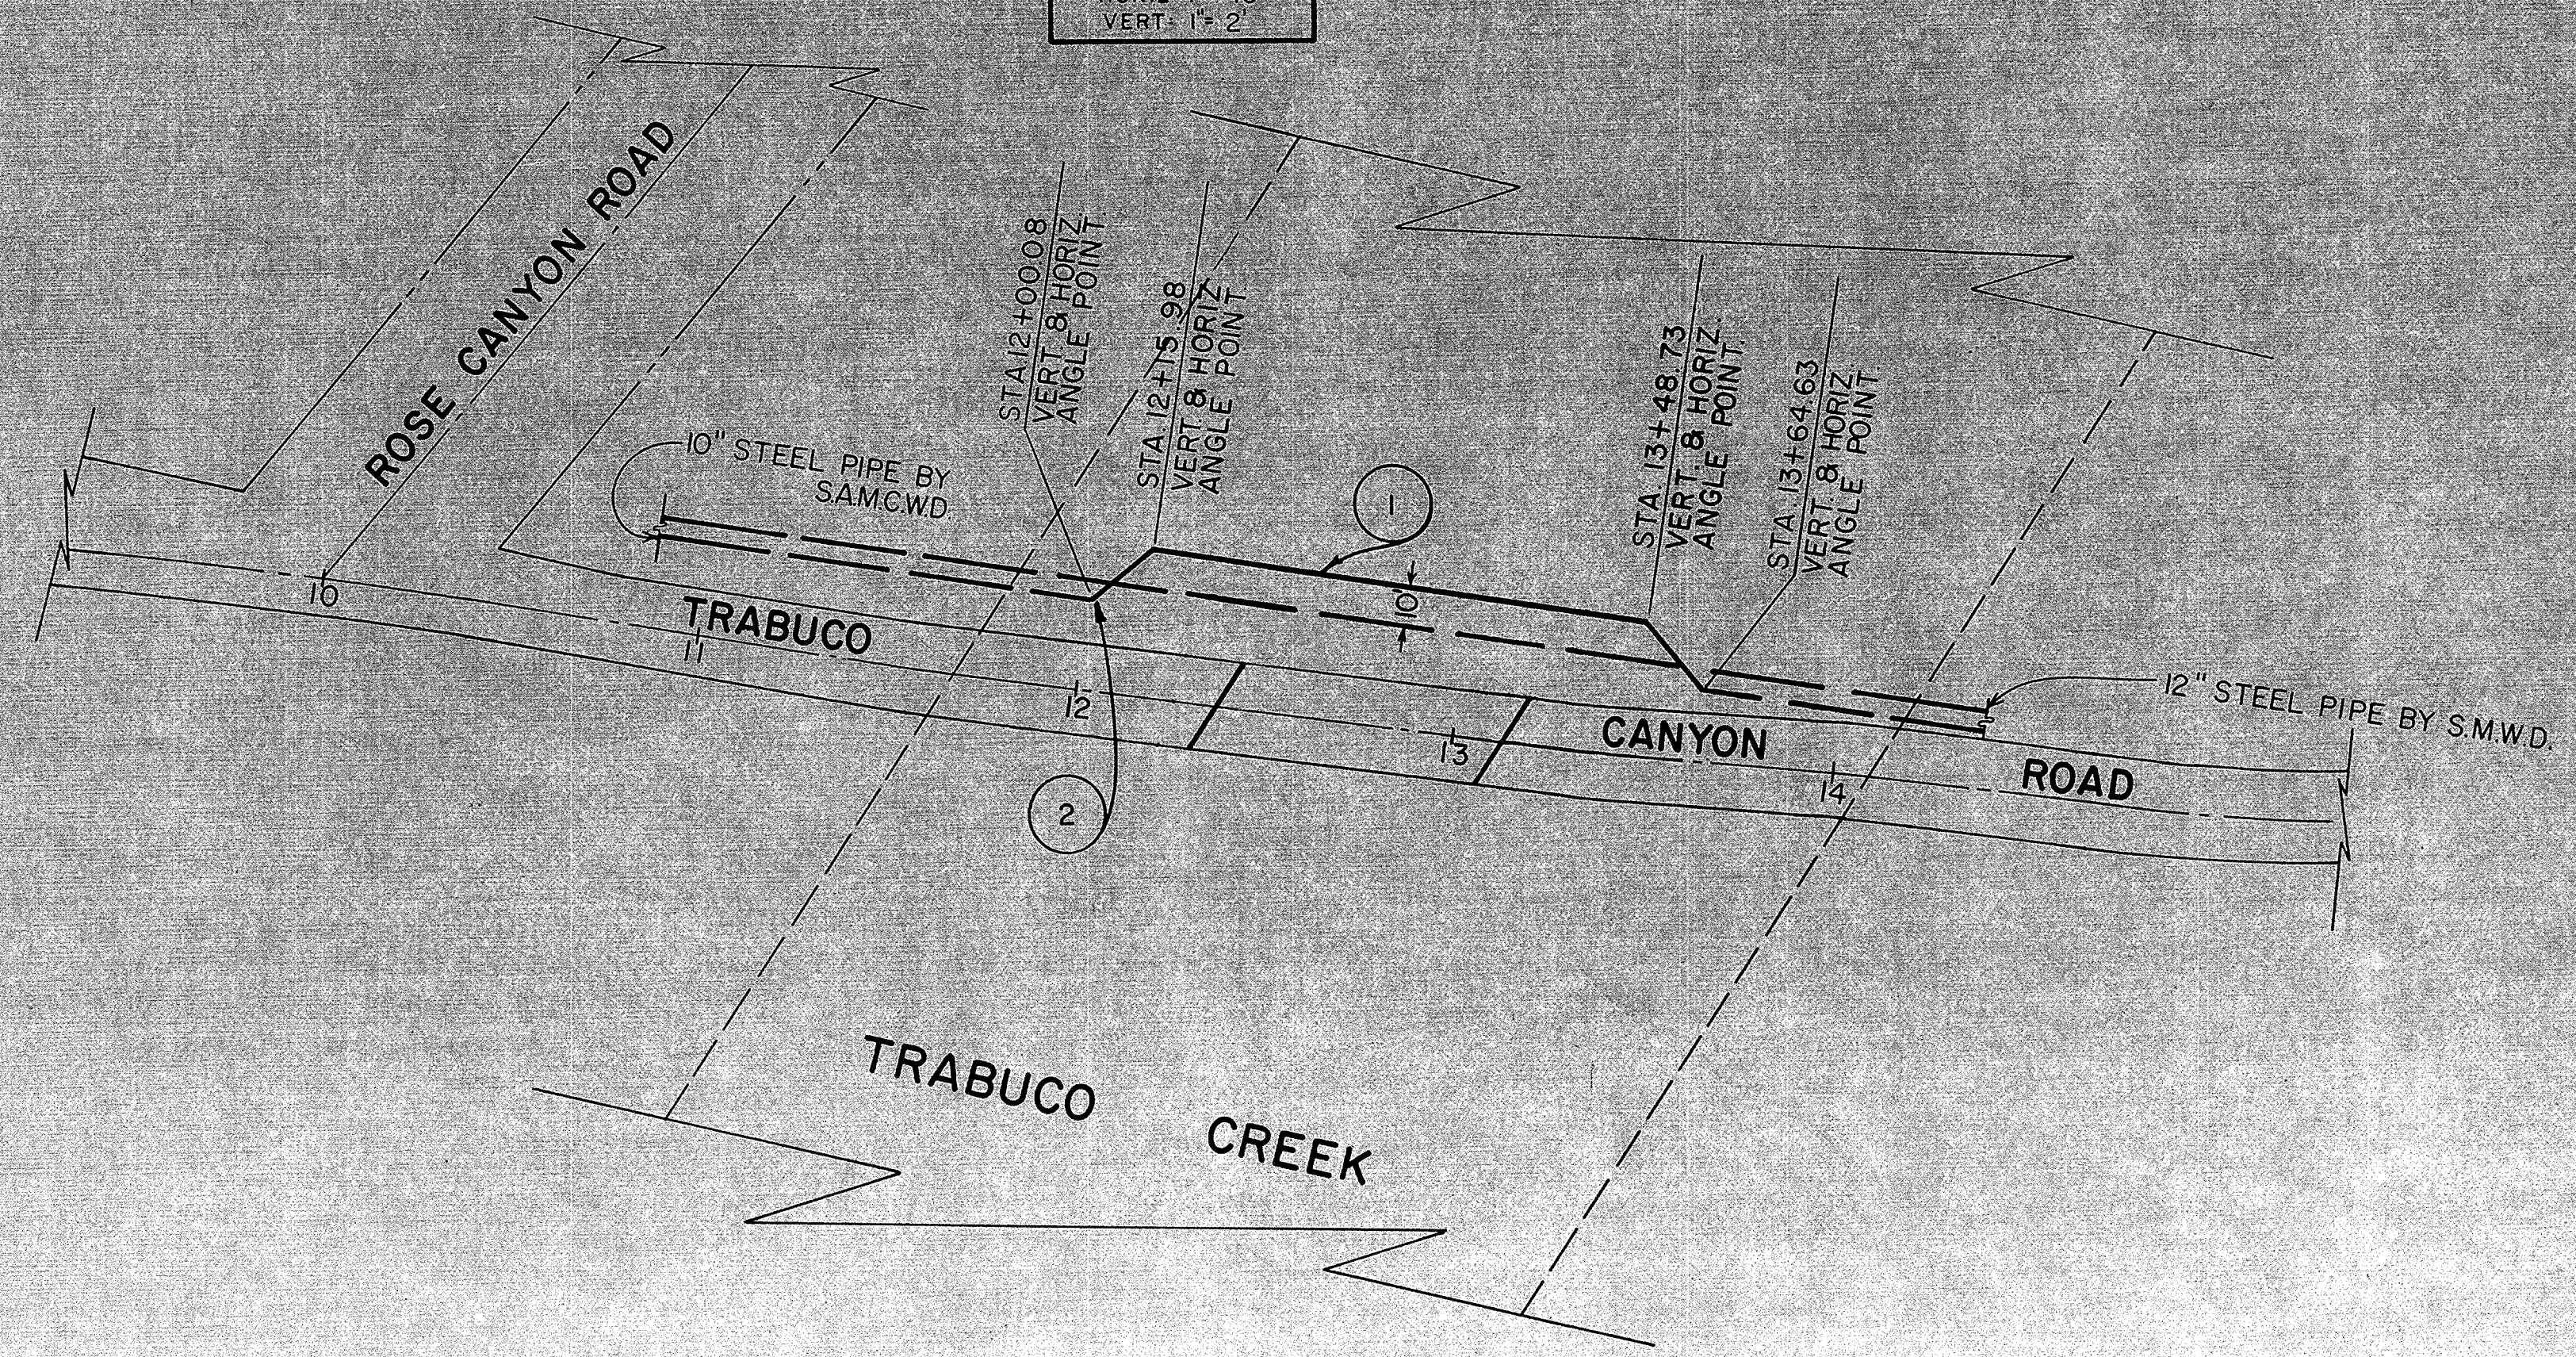

PLAN
1" = 40'

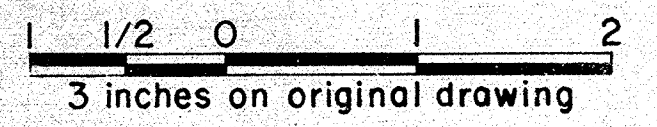

ORANGE COUNTY ENVIRONMENTAL MANAGEMENT AGENCY	
TRABUCO CANYON ROAD AT TRABUCO CREEK	
RELOCATION OF SANTA ANA MOUNTAIN COUNTY WATER DISTRICT WATER LINE	
MARK	DATE
REVISIONS	
DESIGNED	H.S.H.
DRAWN	as shown
CHECKED	H.S.H.
SCALE	AS SHOWN
DATE	9-80
DWG. NO.	13

DR 20 13306