
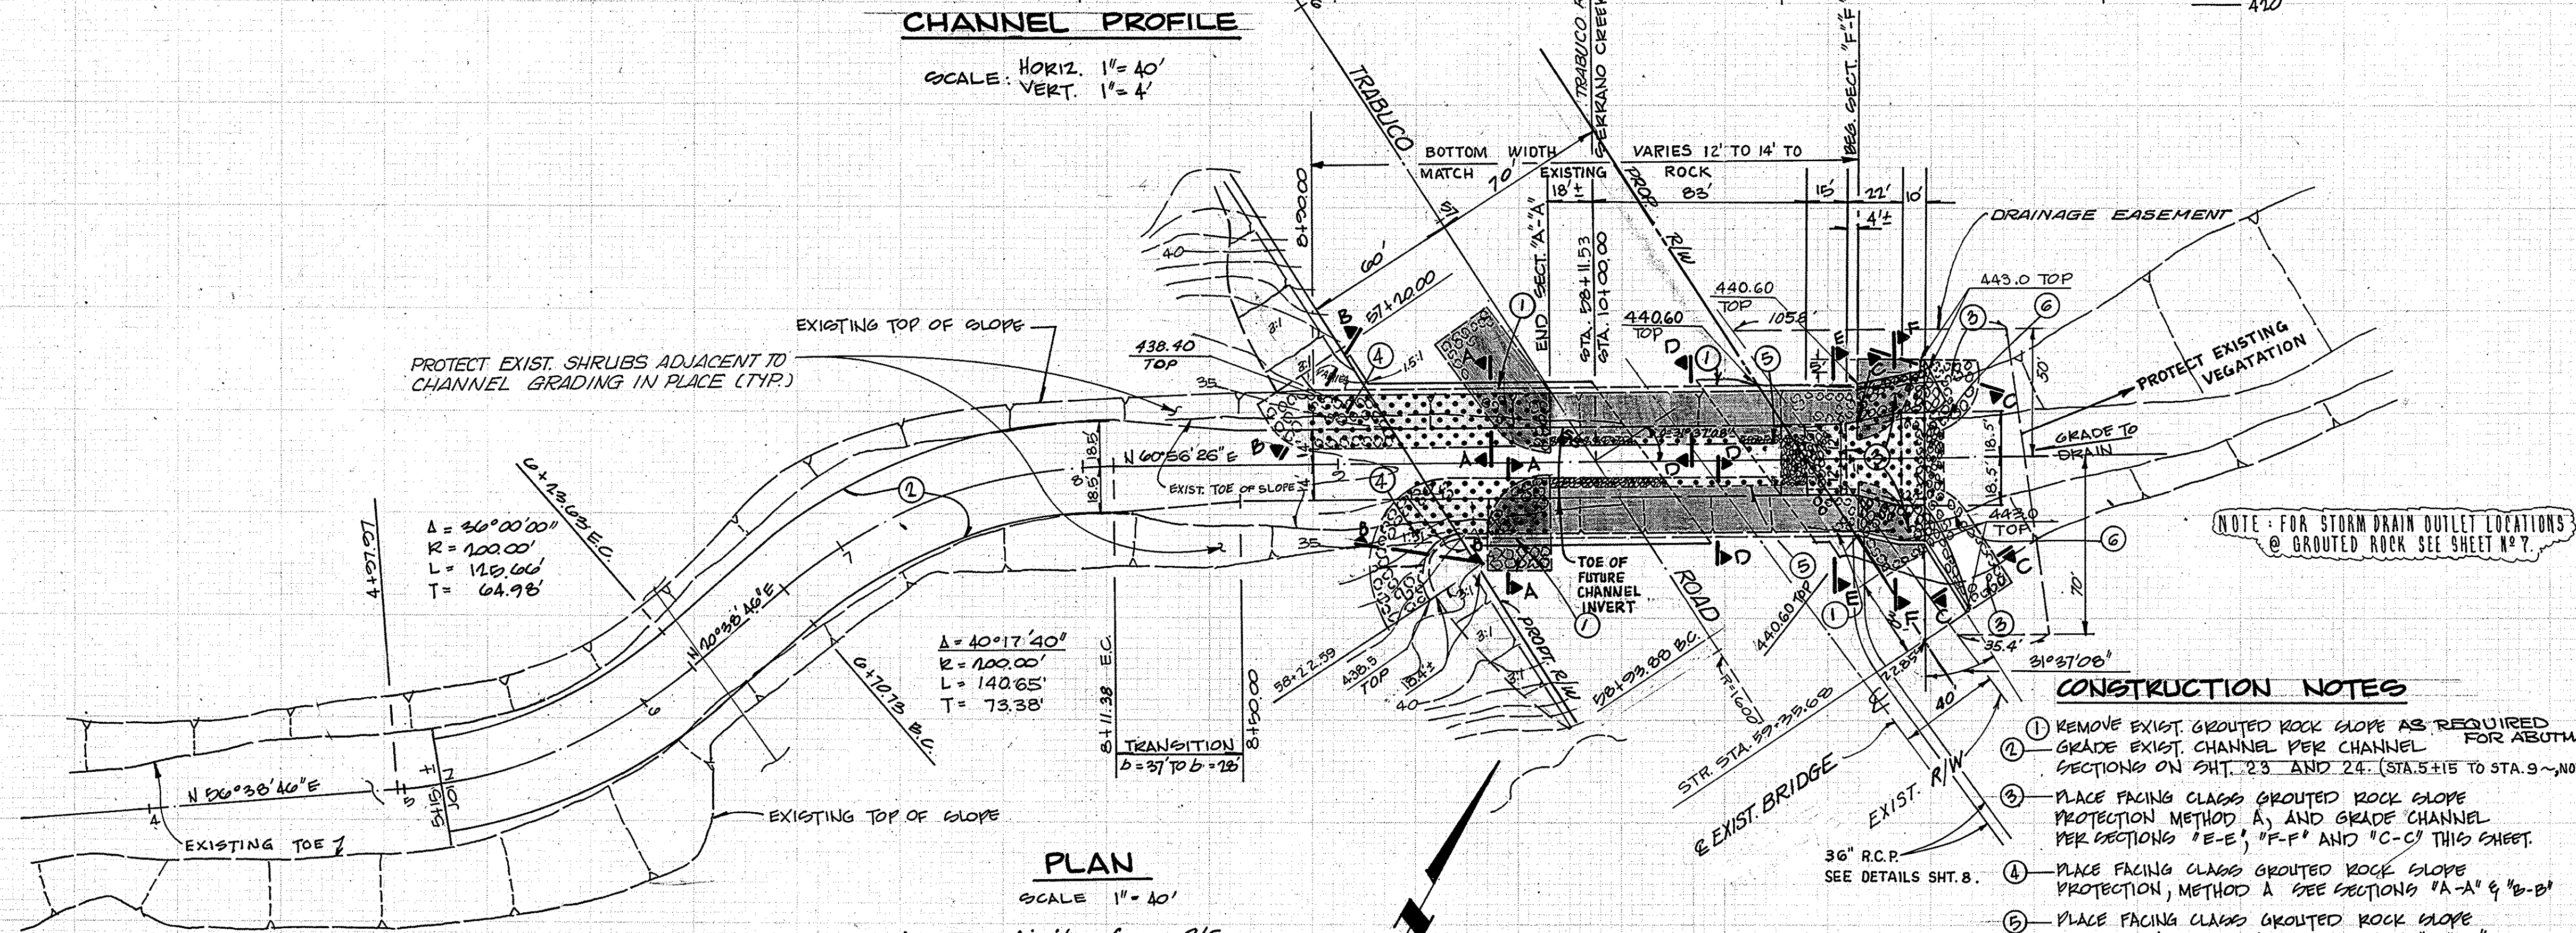
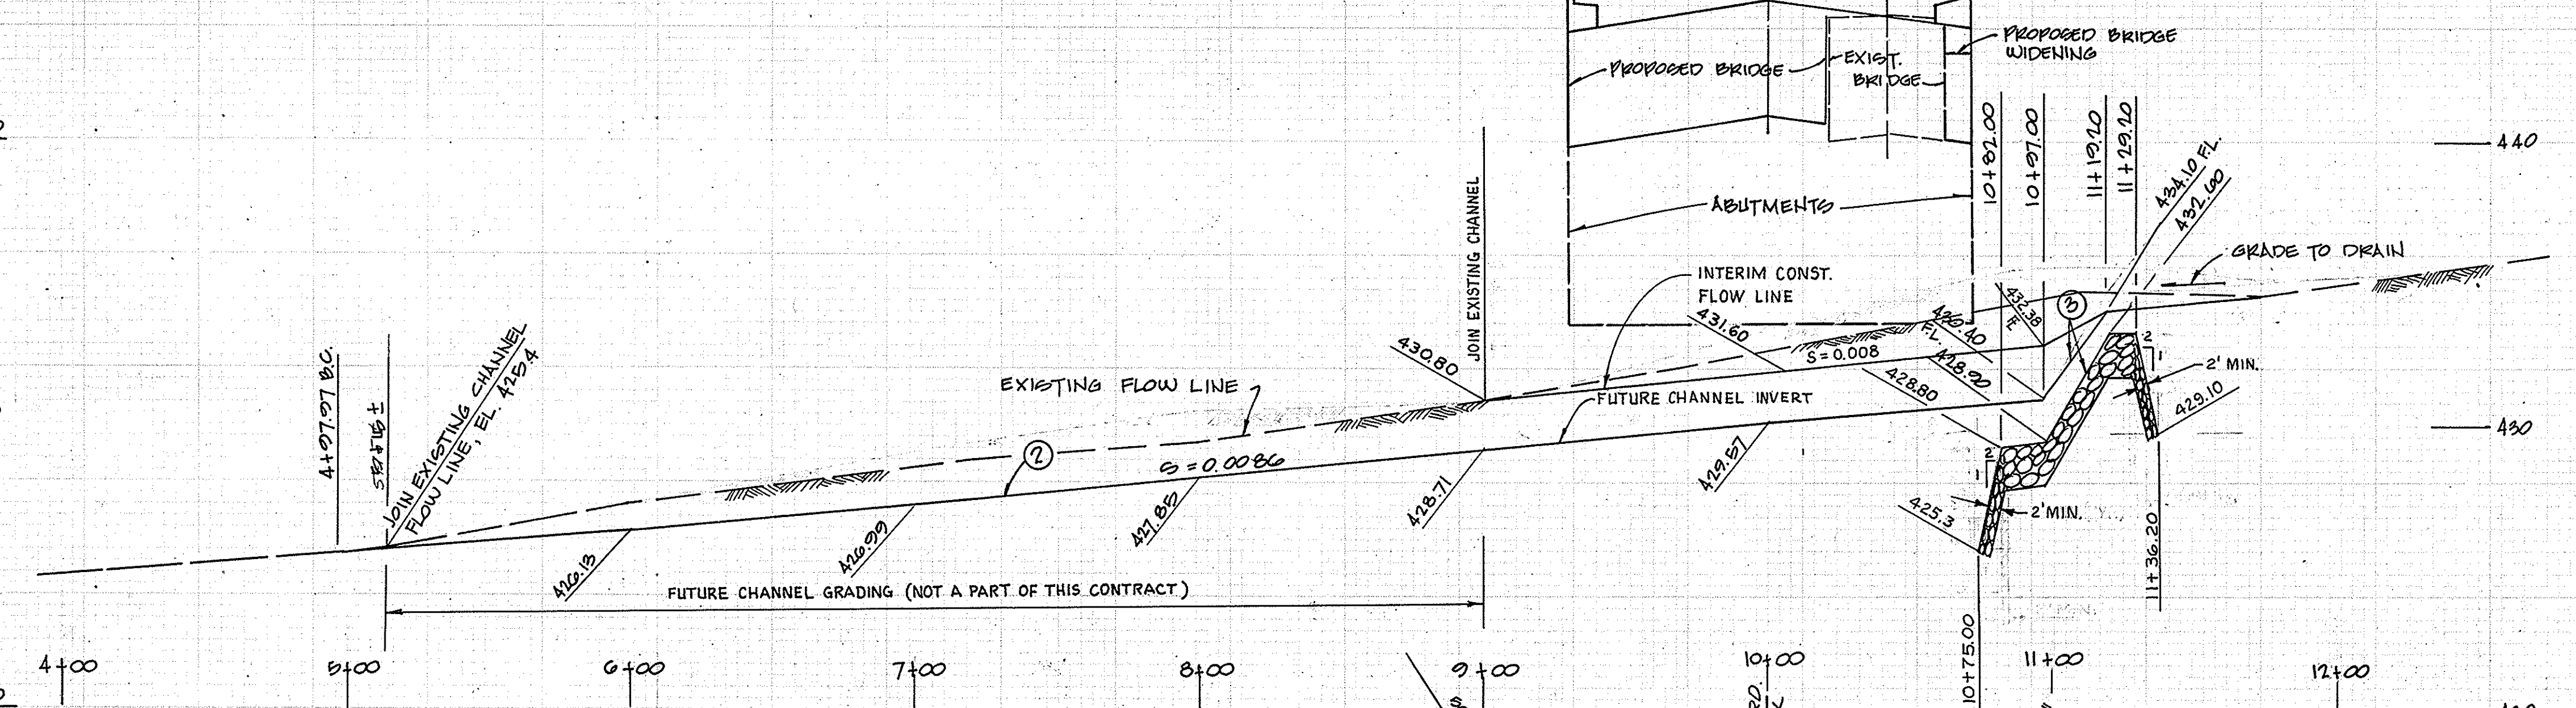
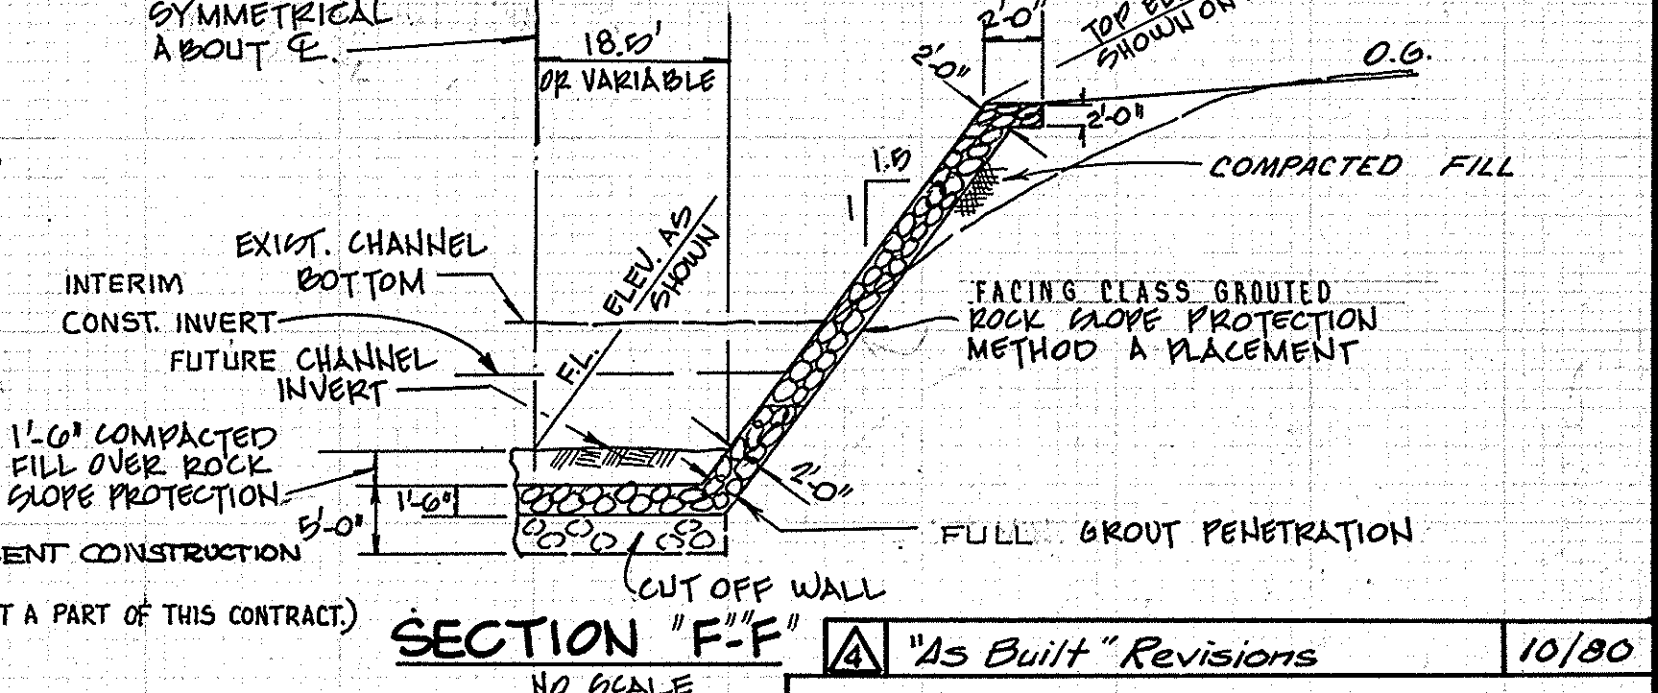
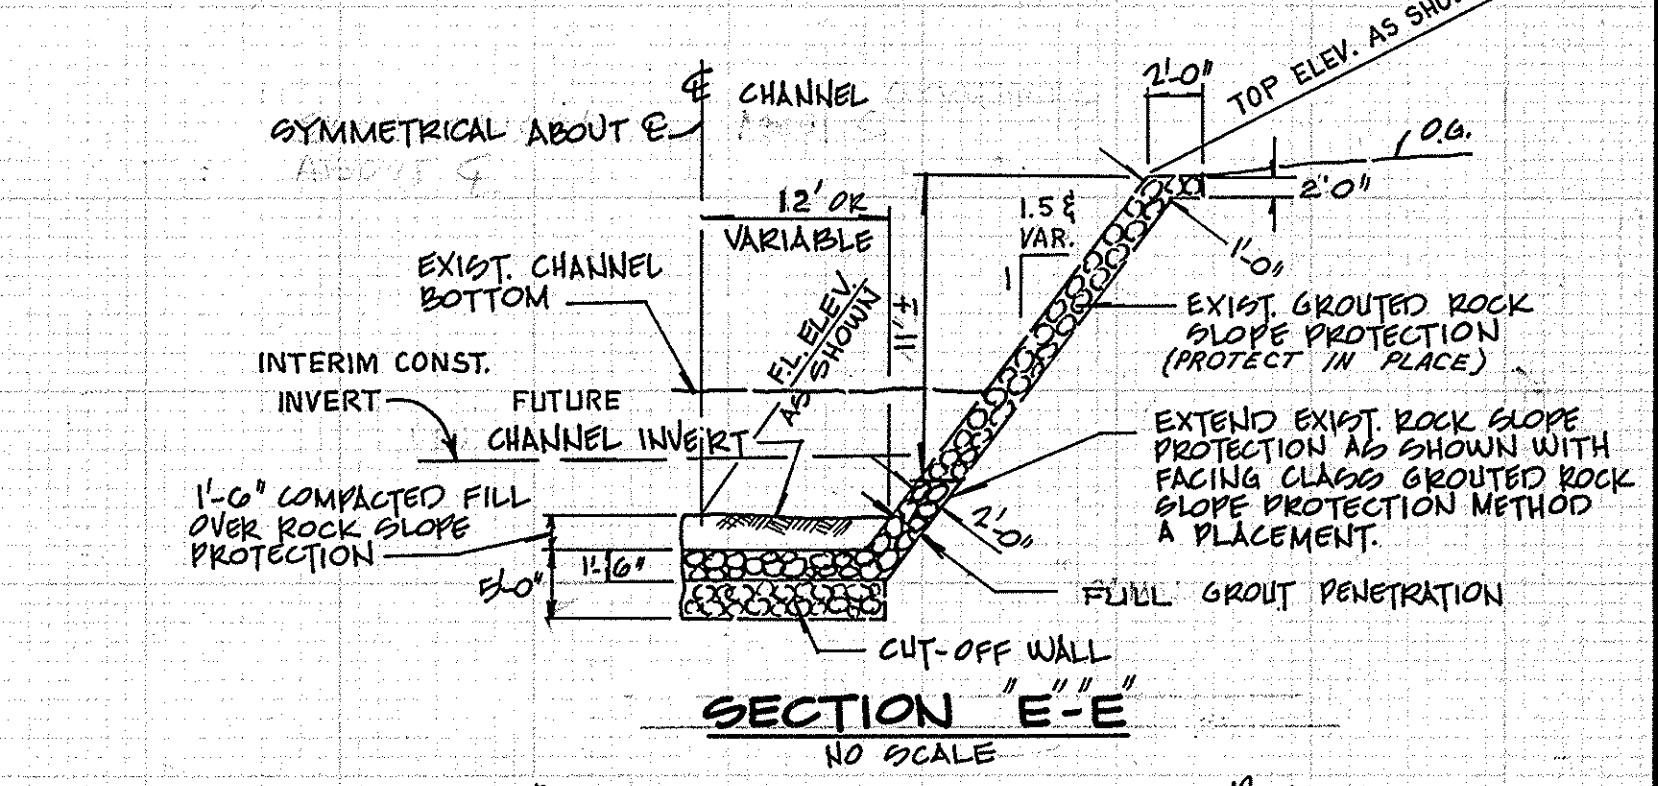
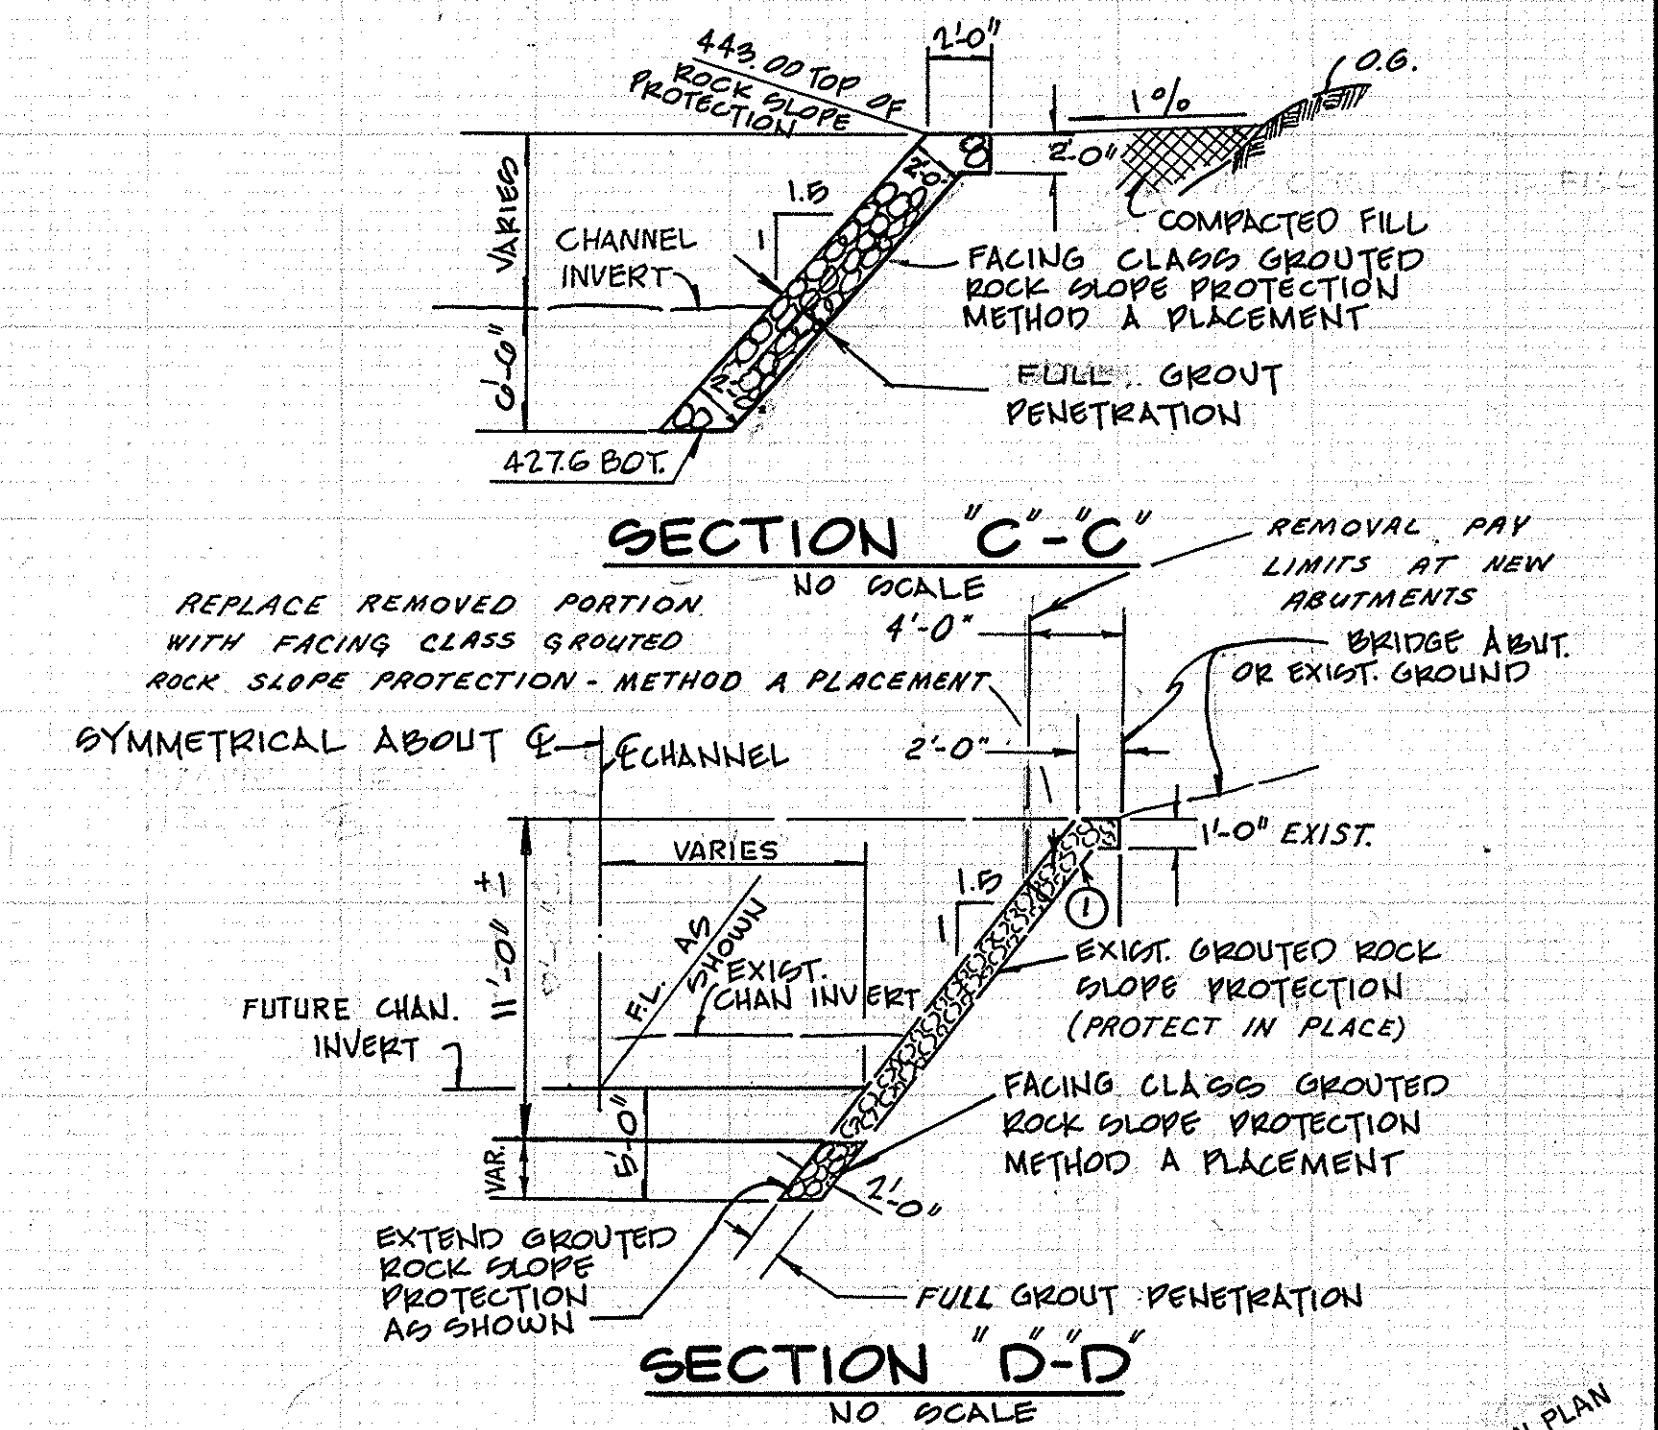
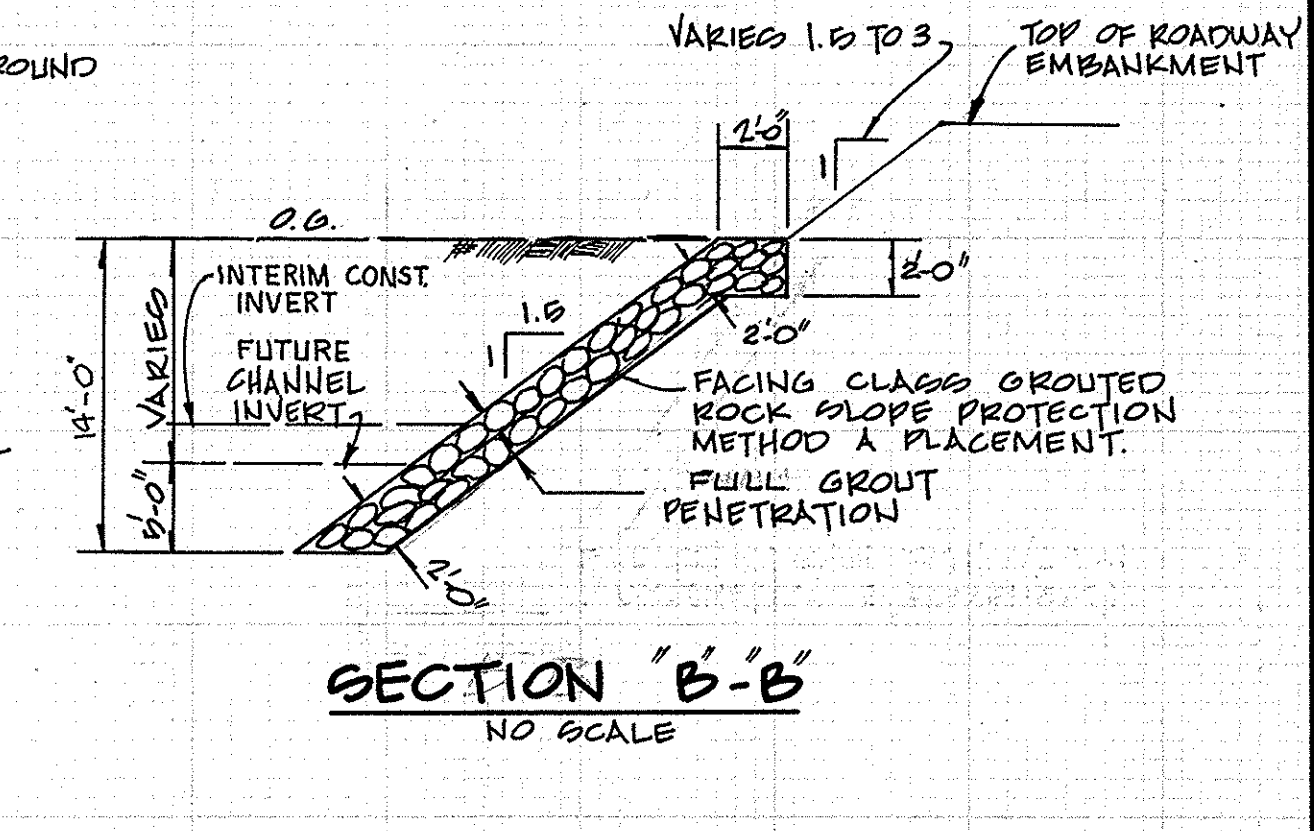
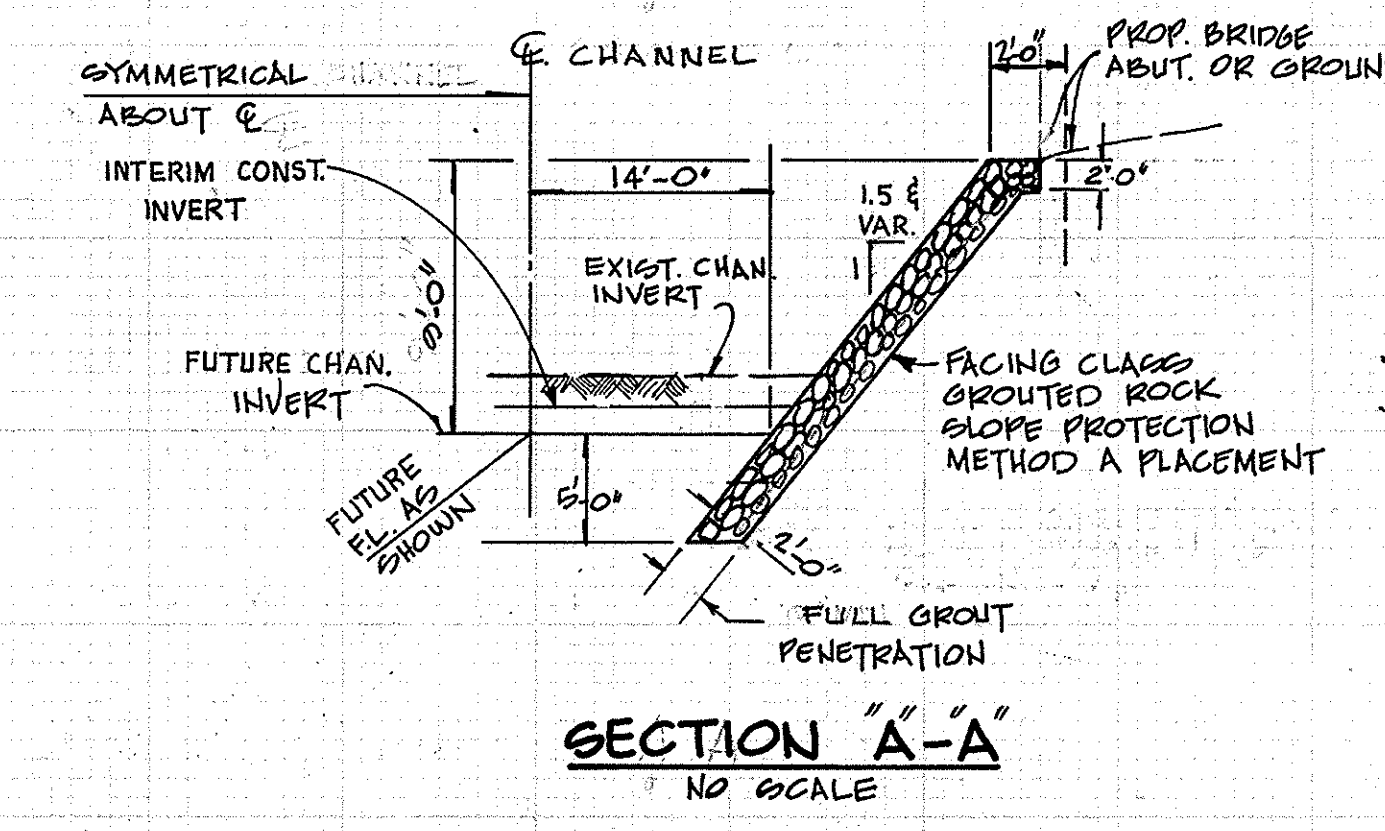


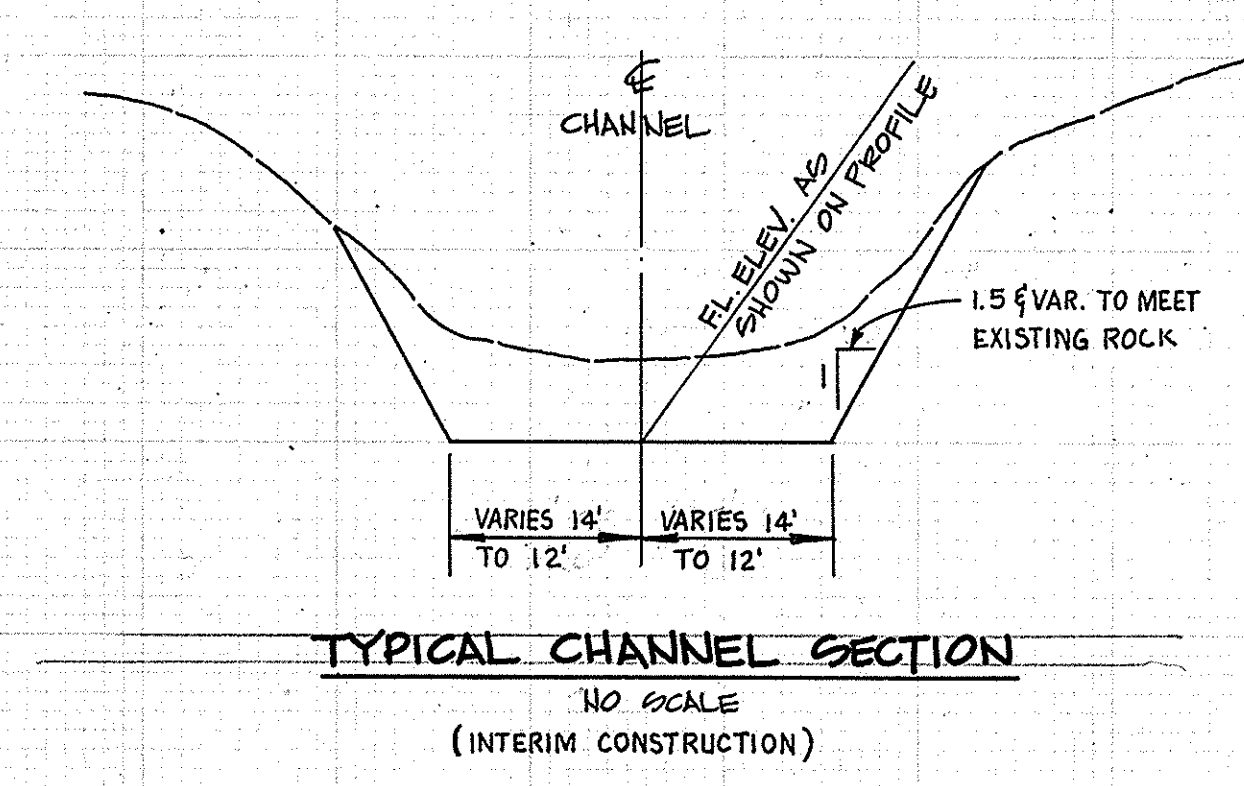

- CONSTRUCTION NOTES**
1. REMOVE EXIST. GROUTED ROCK SLOPE AS REQUIRED FOR ABUTMENT CONSTRUCTION.
 2. GRADE EXIST. CHANNEL PER CHANNEL SECTIONS ON SHT. 23 AND 24 (STA. 5+15 TO STA. 9+00 - NOT A PART OF THIS CONTRACT).
 3. PLACE FACING CLASS GROUTED ROCK SLOPE PROTECTION METHOD A, AND GRADE CHANNEL PER SECTIONS "E-E", "F-F" AND "C-C" THIS SHEET.
 4. PLACE FACING CLASS GROUTED ROCK SLOPE PROTECTION, METHOD A, SEE SECTIONS "A-A" & "B-B".
 5. PLACE FACING CLASS GROUTED ROCK SLOPE PROTECTION, METHOD A, SEE SECTION "D-D".
 6. BACK-FILL OVER PROPOSED ROCK SLOPE PROTECTION TO APPROXIMATE EXISTING CHANNEL SLOPES.

AS BUILT		DR# 18 (12517)	
ORANGE COUNTY ROAD DEPARTMENT			
TRABUCO ROAD BRIDGE SR-6 OVER SERRANO CREEK			
SERRANO CREEK CHANNEL PLAN AND DETAILS			
#12517 Trabuco Rd Phase II Sheet 13 of 40 Red. 2411 Cross Section		SCALE: AS NOTED SHEET 13 OF 40	