
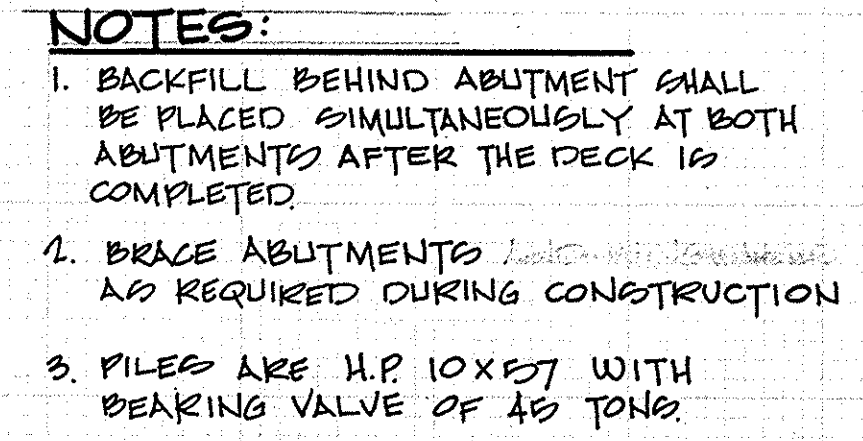
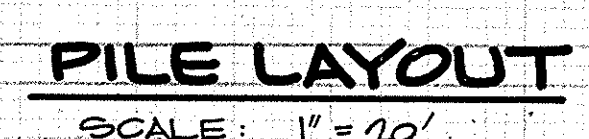


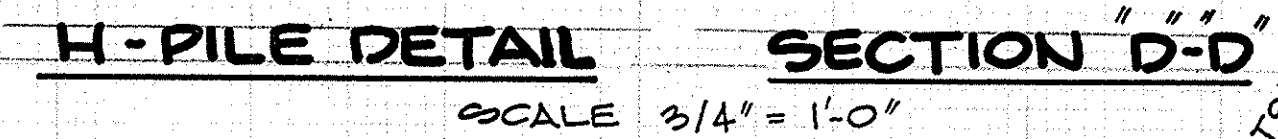

- ## PILING DATA
- | | |
|----|--|
| 1. | MIN. PILE PENETRATION - EL. 419.00 |
| 2. | EST. AVERAGE PILE TIP ELEVATION - 415.00 |
| 3. | AVERAGE "AS BUILT" PILE TIP ELEVATION - 415.00 |
| 4. | AVERAGE PILE CUT-OFF ELEVATION - 432.8 |

ORANGE COUNTY ROAD DEPARTMENT				
FC	TRABUCO ROAD			
8-762	BRIDGE SR-G			
	OVER			
	SERRANO CREEK			
	PILE LAYOUT, STRUCTURE			
	EXCAVATION & BACKFILL			
	DETAILS			
Drawn: _____	SCALE	AS NOTED		
Checked: _____				SHEET 17 OF 40
Approved: _____				
DATE				