

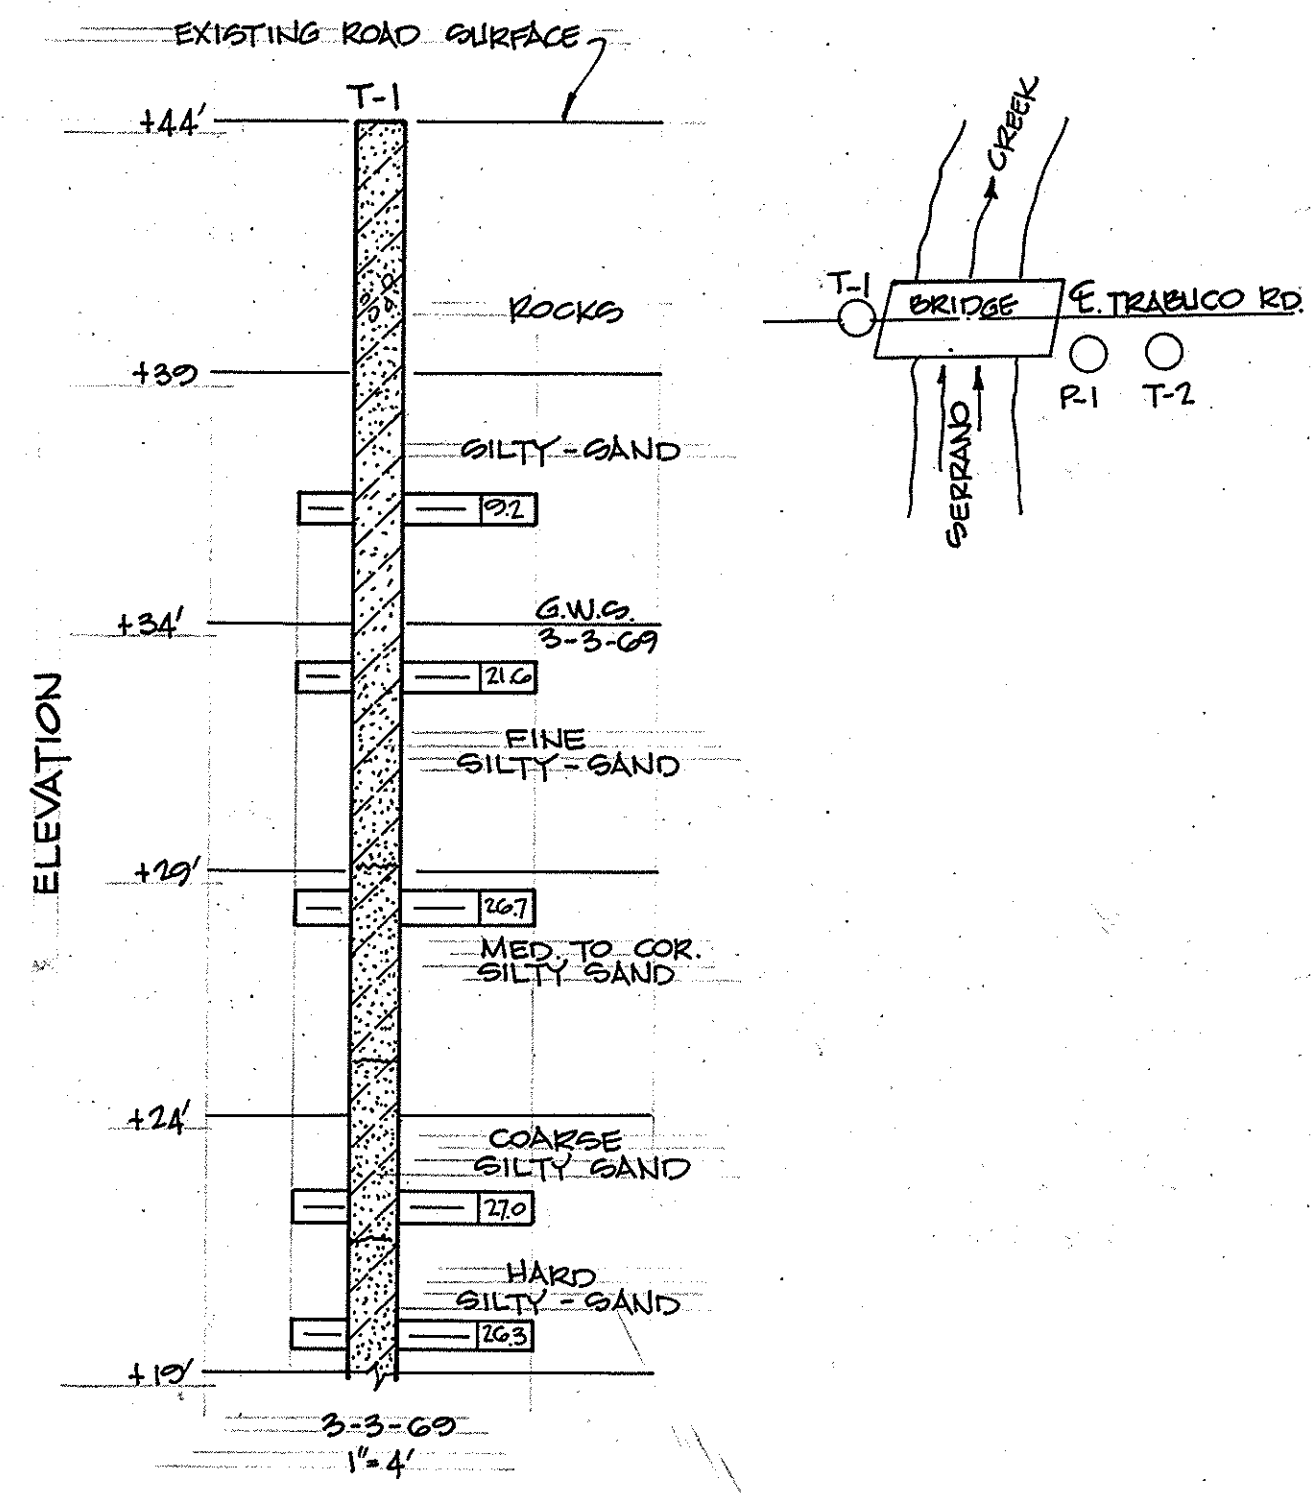
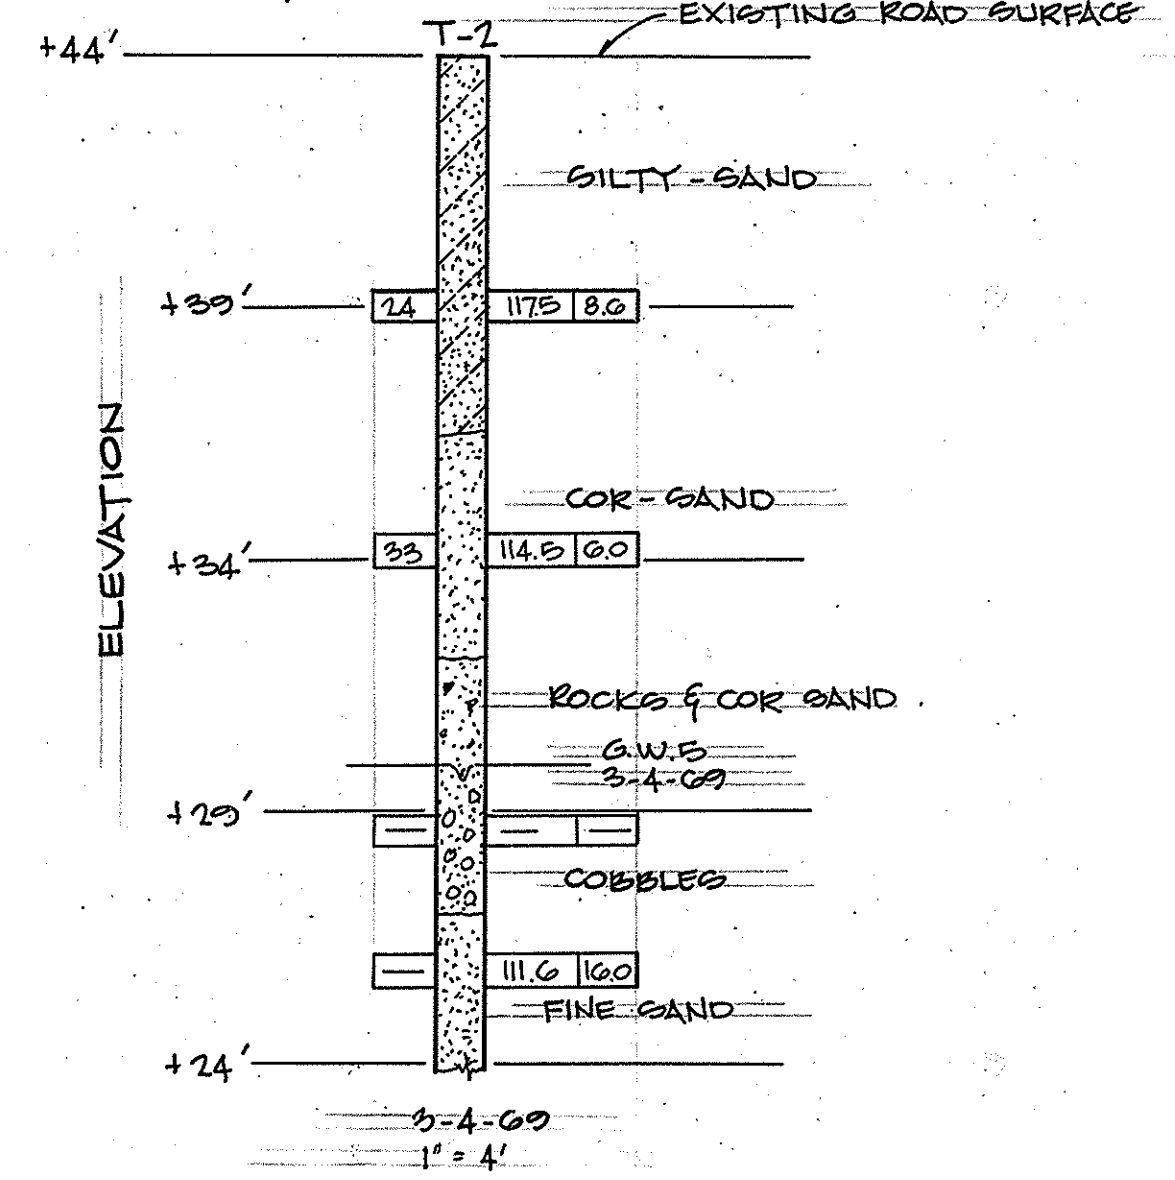


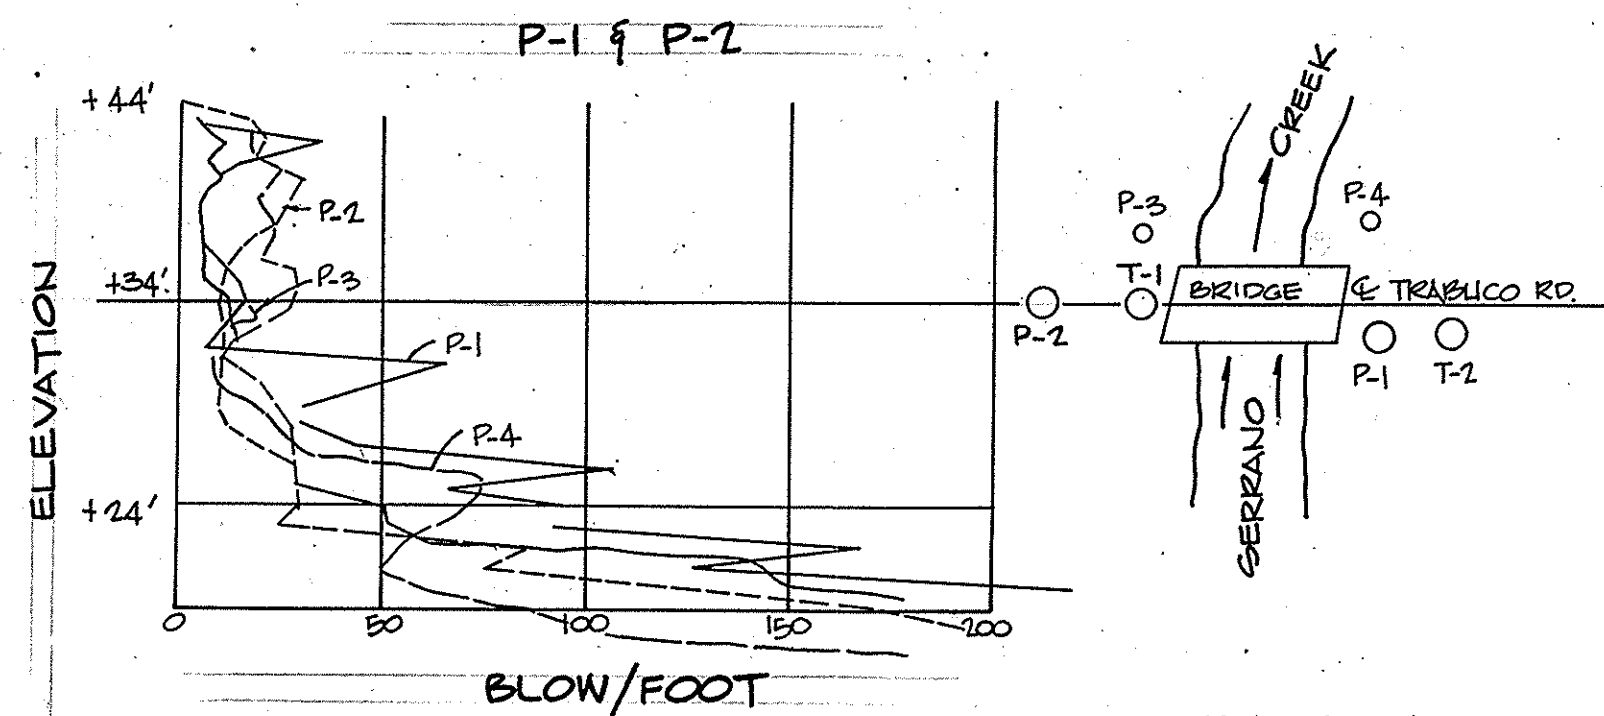


EXIST. BRIDGE AVERAGE
AS BUILT PILE TIP = EL. 415 ±

#12517
Trabuco Rd. Phase II
Sheet 22 of 40
Rev. 2411
Cronaflex

LEGEND OF EARTH MATERIALS

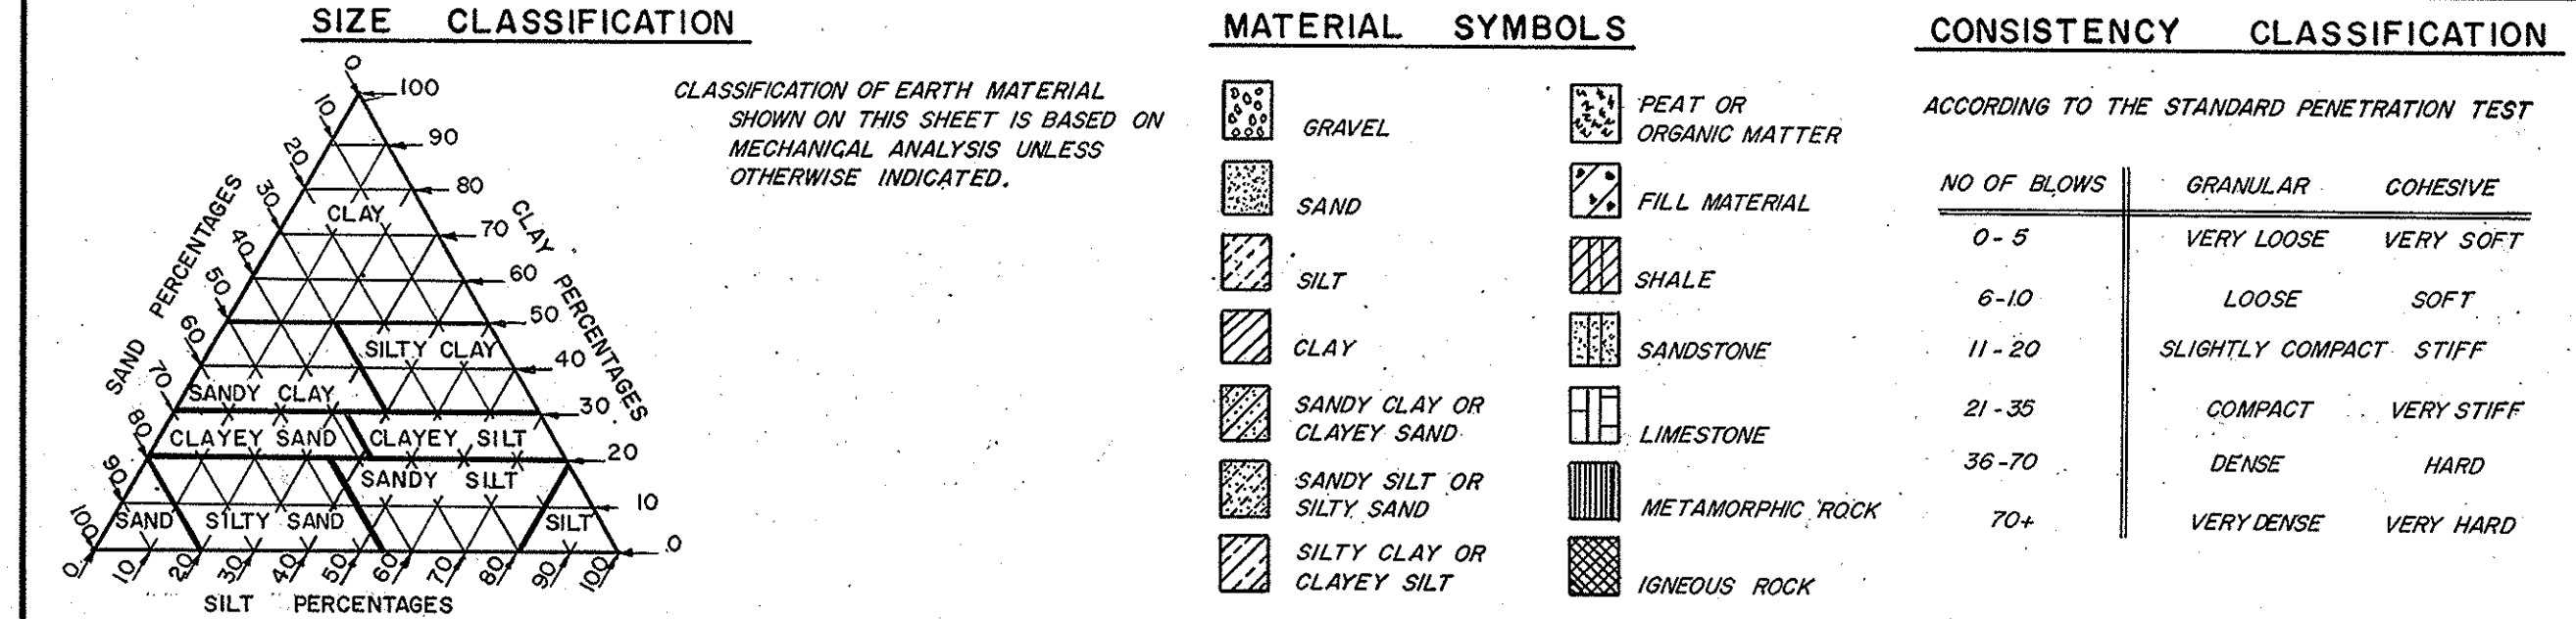

LEGEND OF BORING OPERATIONS

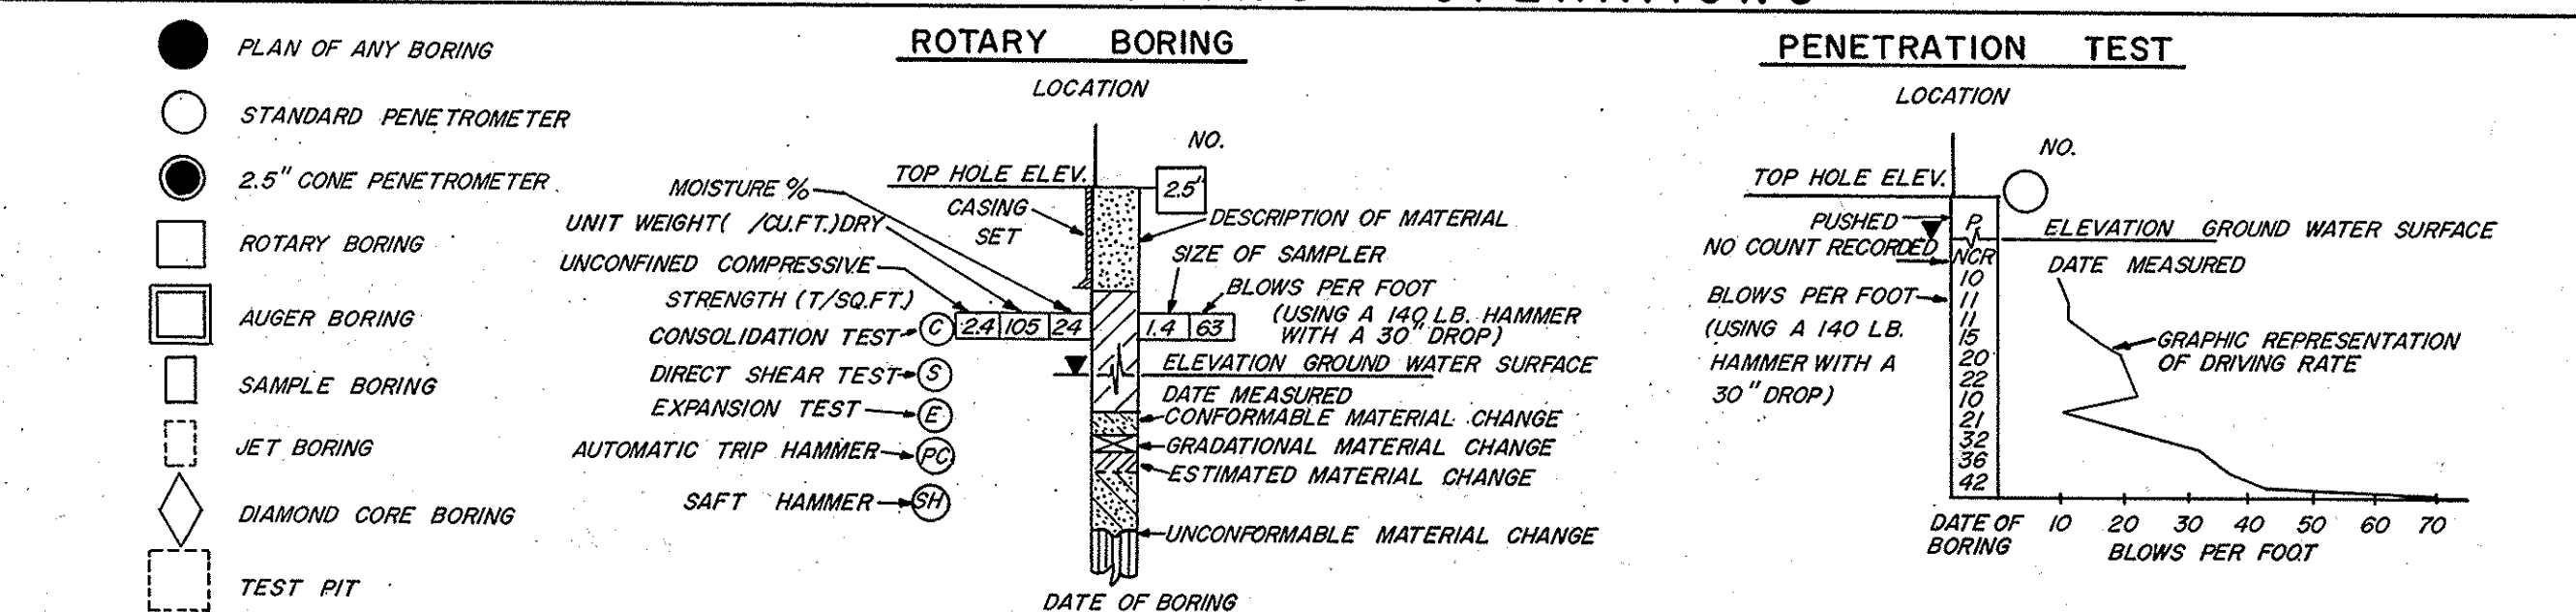

ORANGE COUNTY ROAD DEPARTMENT
MATERIALS LABORATORY
LOG OF TEST BORINGS
FOR

TRABUCO ROAD BRIDGE
GR - G
OVER SERRANO CREEK

DATE: _____ REVISION: _____ DRAWN BY: _____ CHECKED BY: _____

SCALE: AS NOTED BRIDGE DRAWING