
SAN BETWEEN REAL STATES AND BETWEEN COUNTY SAN BETWEEN REAL STATES AND STATE

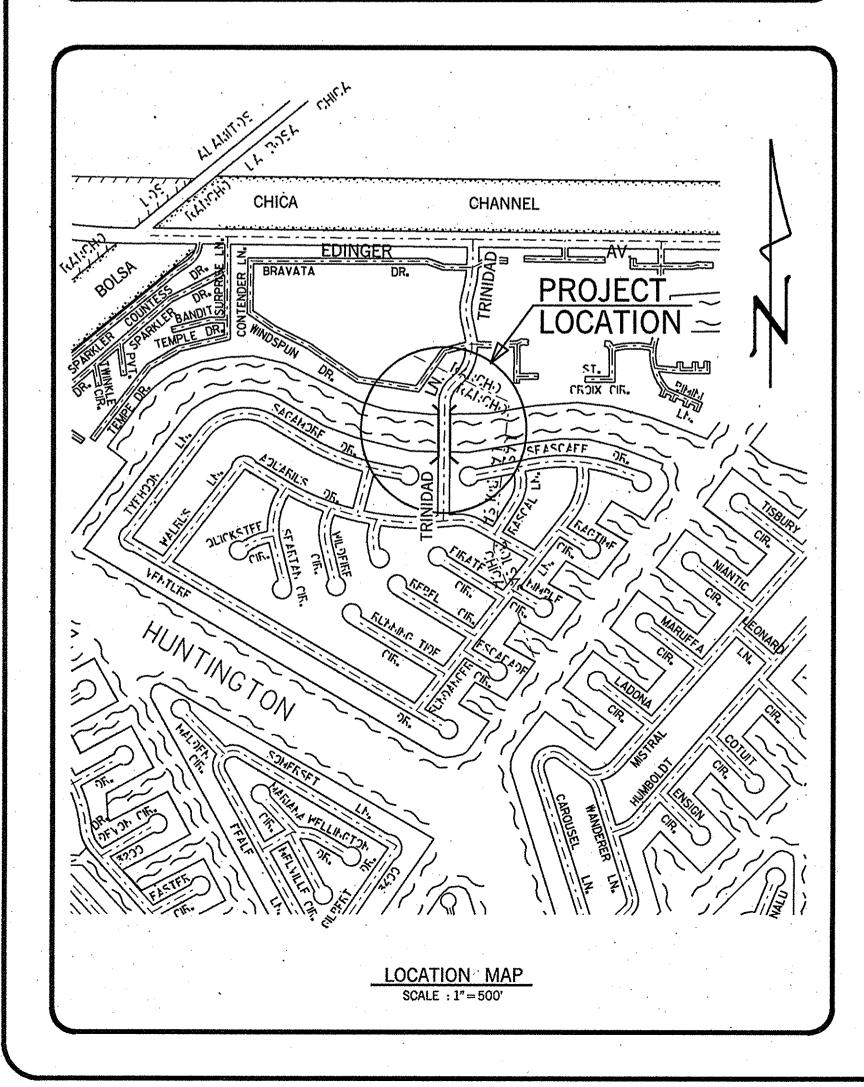

ORANGE COUNTY PUBLIC FACILITIES & RESOURCES DEPARTMENT

SANTA ANA, CALIFORNIA

JOHN W. SIBLEY, DIRECTOR

PLANS FOR SEISMIC RETROFIT OF THE

TRINIDAD LANE BRIDGE OVER INLAND WATERWAY

BRIDGE No. 55C-0260

BRLOZB - 5955 (025)

EA # 12-401964L

MARCH, 1999

PUBLIC FACILITIES & RESOURCES DEPARTMENT

FUNDED BY: CALTRANS

CITY OF HUNTINGTON BEACH APPROVED FOR CONSTRUCTION WITHIN THE CITY OF HUNTINGTON BEACH REPLIEBLE 2/19/93 ROBERT EICHBLATT, CITY ENGINEER DATE

CITY OF HUNTINGTON BEACH

APPROVAL FOR CONTRACT ADMINISTRATION PURPOSES APPROVED: K.R.SMITH, CHIEF ENGINEER PUBLIC FACILITIES & RESOURCES DEPARTMENT

LIM & NASCIMENTO ENGINEERING 1971 EAST FOURTH STREET, SUITE 200 SANTA ANA, CA 92705

PLANS PREPARED BY

IN D E X O F S H E E T S

SHEET

DESCRIPTIO

- TITLE SHEET
- 2 GENERAL PLA
- 3 ABUTMENT RETROFIT DETAILS
- 4 ANCHOR SLAB DETAILS NO. 1
- 5 ANCHOR SLAB DETAILS NO. 2
- 6 MISCELLANEOUS DETAILS
- 7 LOG OF TEST BORINGS No. 1
- 8 LOG OF TEST BORINGS No. 2
- 9 CONSTRUCTION TRAFFIC CONTROL PLAN

RECORD DRAWINGS

CONTRACTOR: BEADOR CONSTRUCTION

RESIDENT ENGINEER: MAX ANDERSON

INSPECTOR: MIKE REETZ


PROJECT COMPLETED: OCTOBER /26/99

AS BUILT DRAWINGS COMPLETED: SEPTEMBER /01

UTILITY OWNER	PHONE NO.	CONTACT
	and a second of the second of	
THE GAS COMPANY	(714) 634–3041	JIM BEVANS
TIME WARNER COMMUNICATIONS	(714) 895–6886x885	CHRIS DONNELLY
CITY OF HUNTINGTON BEACH-WATER	(714) 536–5431	JOHN VON HOLLE
CITY OF HUNTINGTON BEACH-SEWER	(714) 536–5074	BOB BICHOLATI II
GTE CALIFORNIA, INC.	(714) 375–6702	PAT DILLON
SOUTHERN CALIFORNIA EDISON CO.	(714) 895–0306	AL O'HARA
UNDERGROUND SERVICE ALERT	1 (800) 422–4133	

GENERAL NOTES:

- 1. THE CONTRACTOR SHALL VERIFY ALL CONTROLLING FIELD DIMENSIONS BEFORE ORDERING OR FABRICATING ANY MATERIALS.
- THE COUNTY OF ORANGE IS ADMINISTERING THIS RETROFIT CONTRACT ON BEHALF OF THE CITY OF HUNTINGTON BEACH. AT PROJECT'S NOTICE OF COMPLETION, OWNERSHIP AND MAINTENANCE RESPONSIBILITIES SHALL REVERT BACK TO THE CITY.

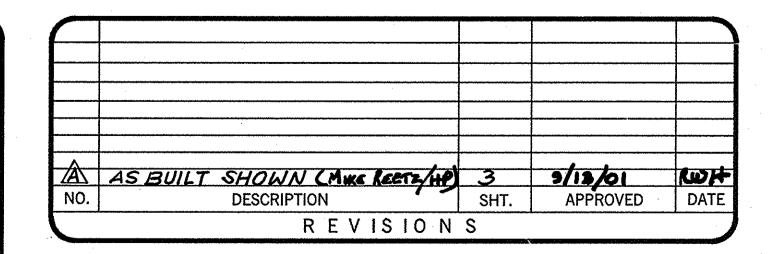

W. O. NO. <u>ER11586</u>
DWG. NO. ____

SHEET 1 OF