


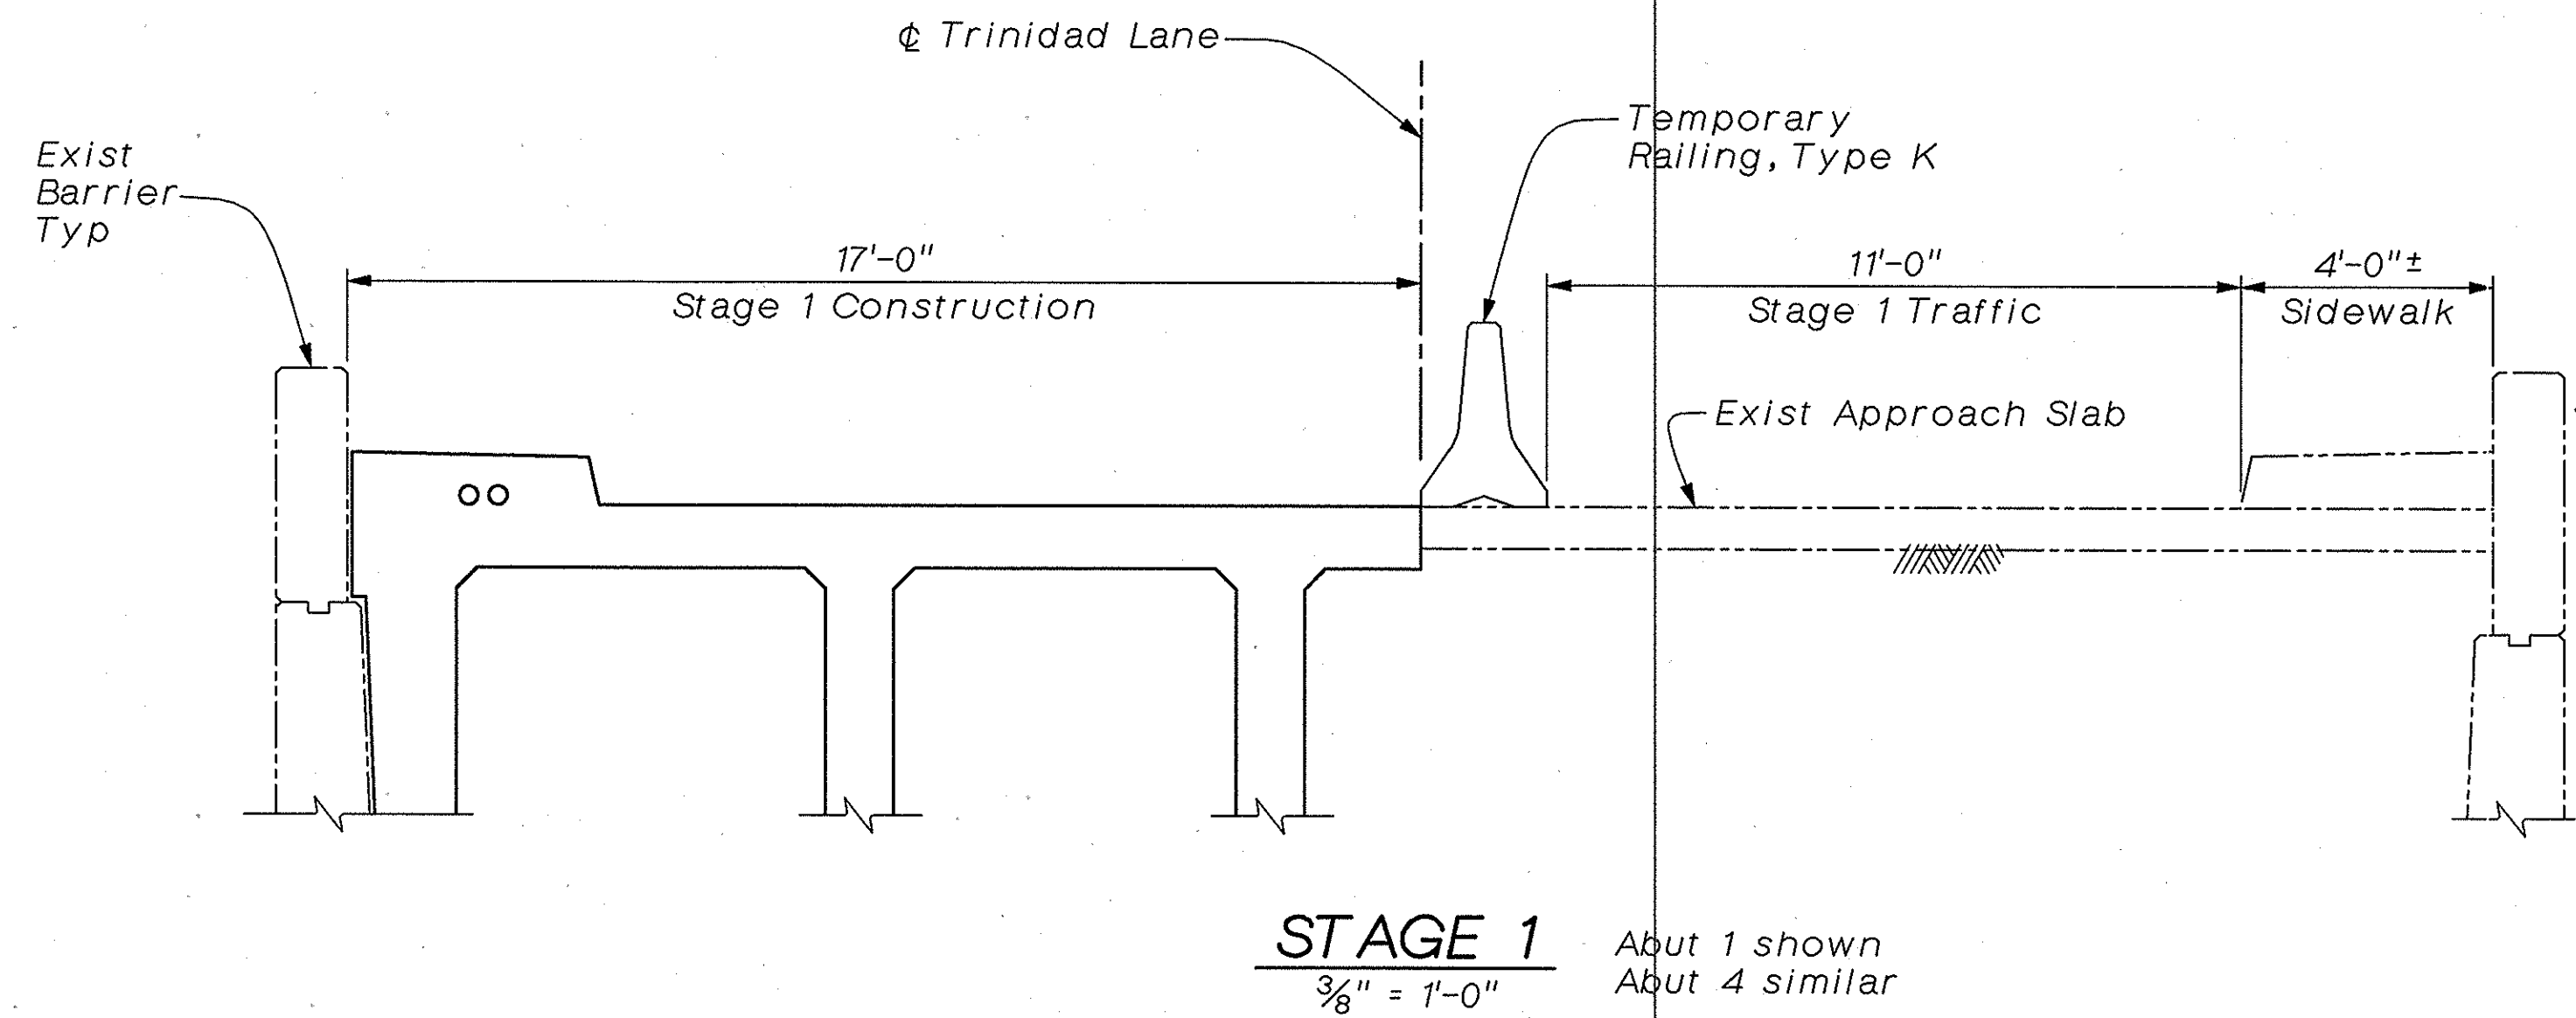


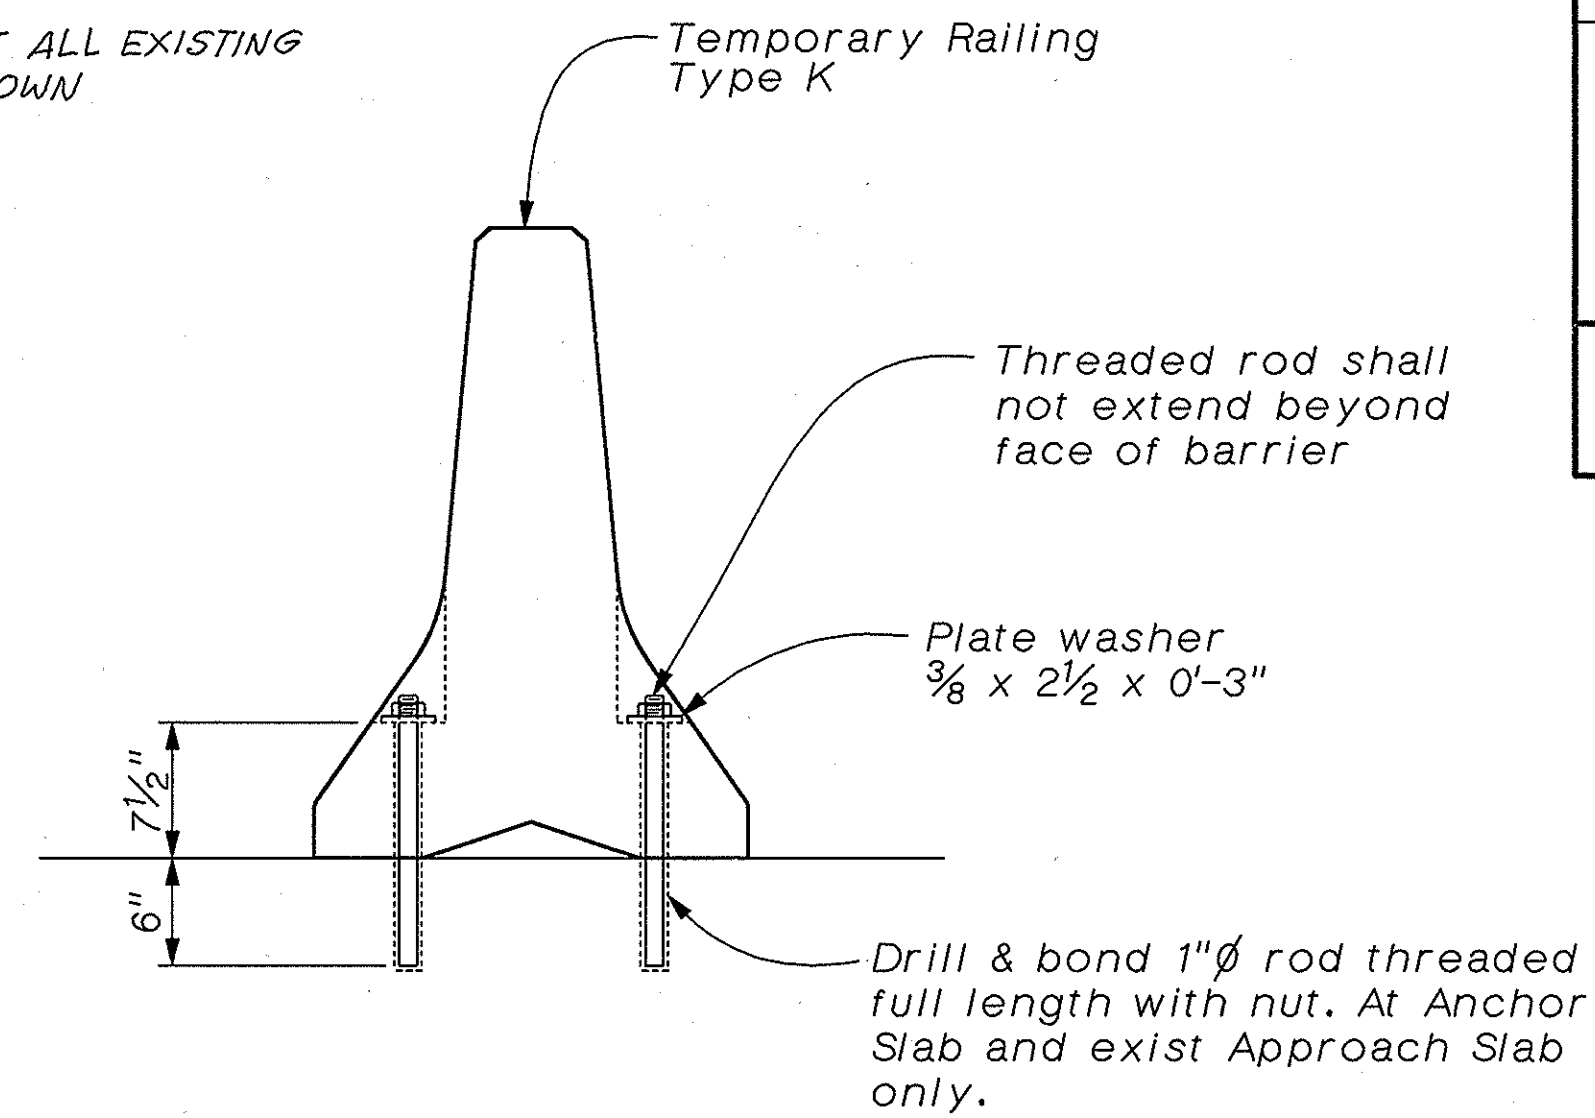


NOTE: NOT ALL EXISTING UTILITIES SHOWN

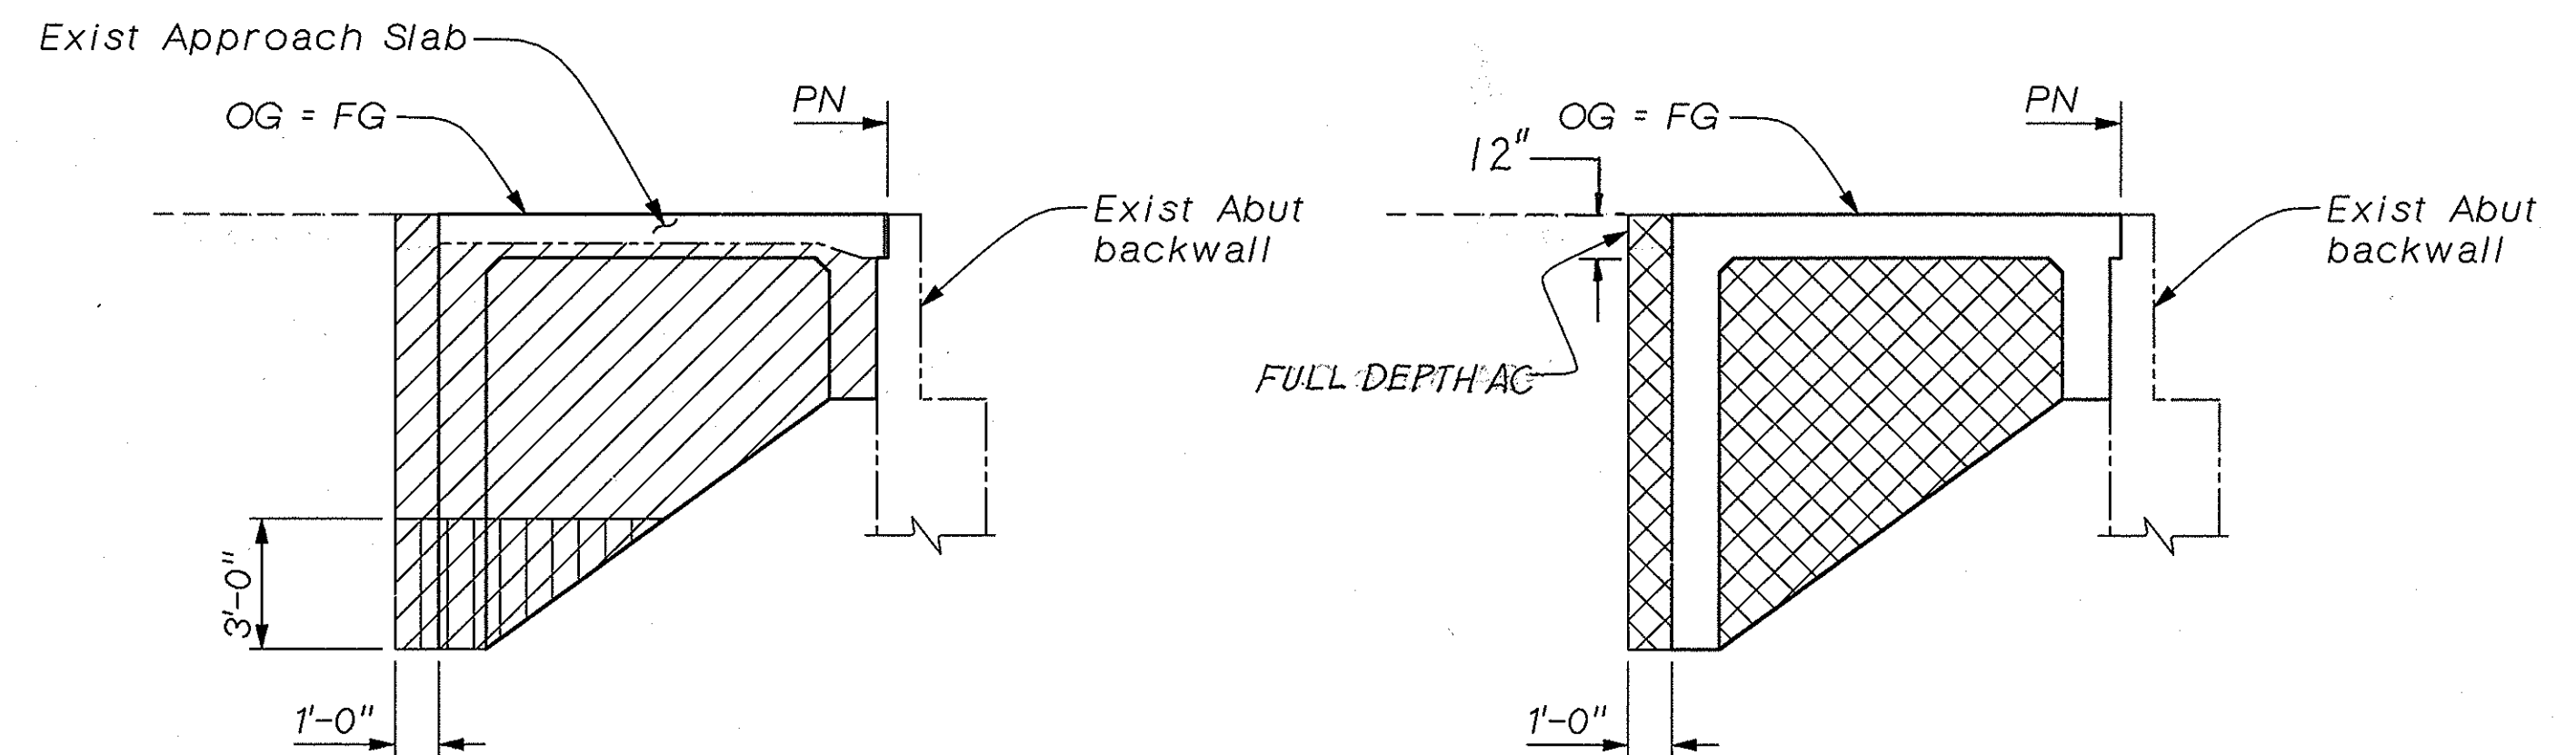

RAILING ANCHORAGE
No Scale

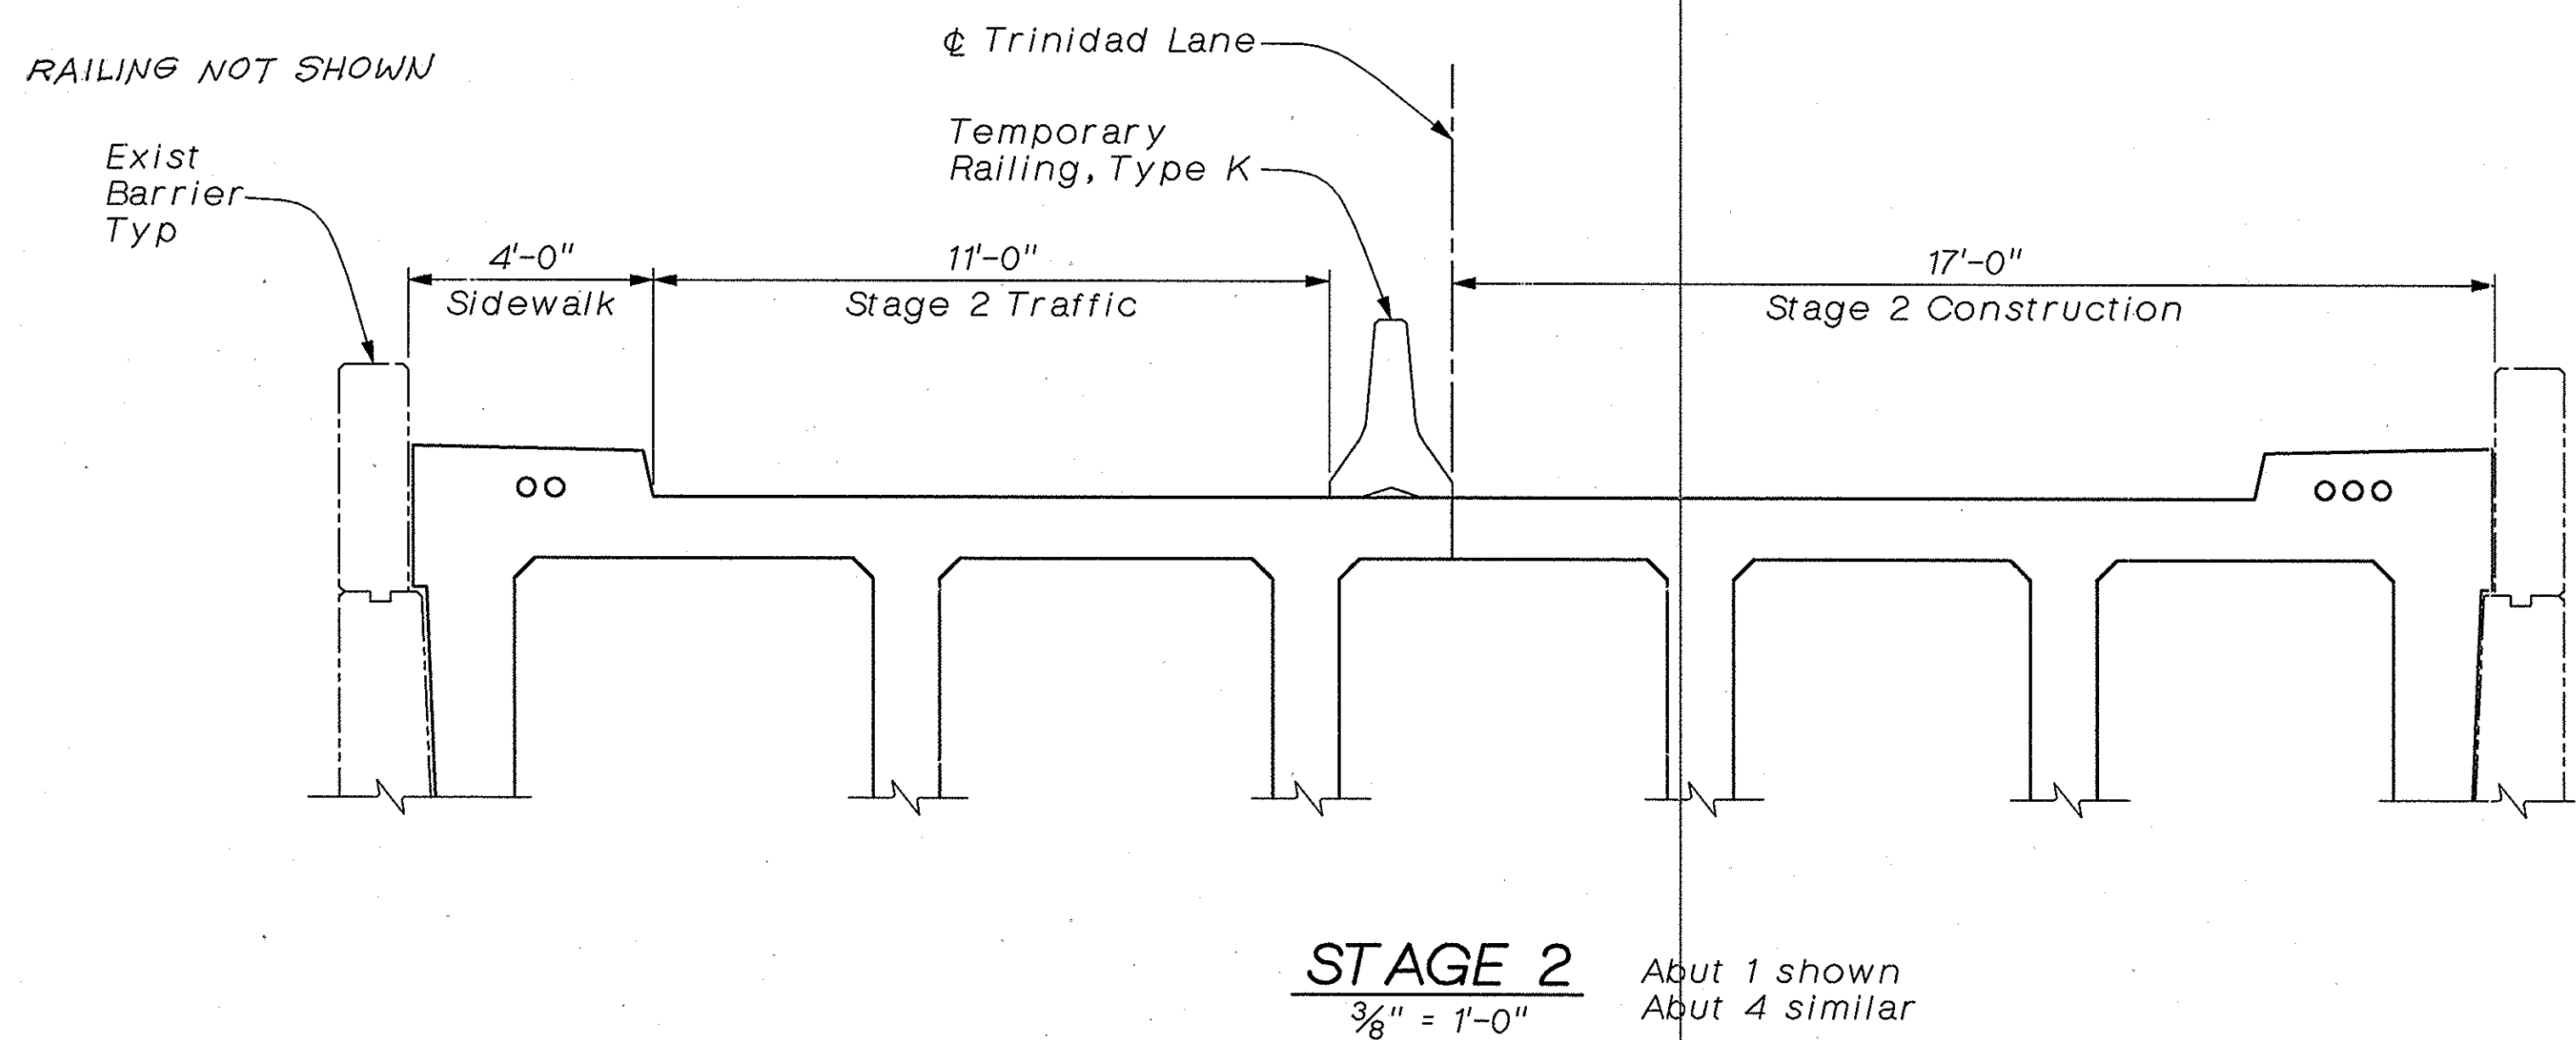

LONGITUDINAL SECTION

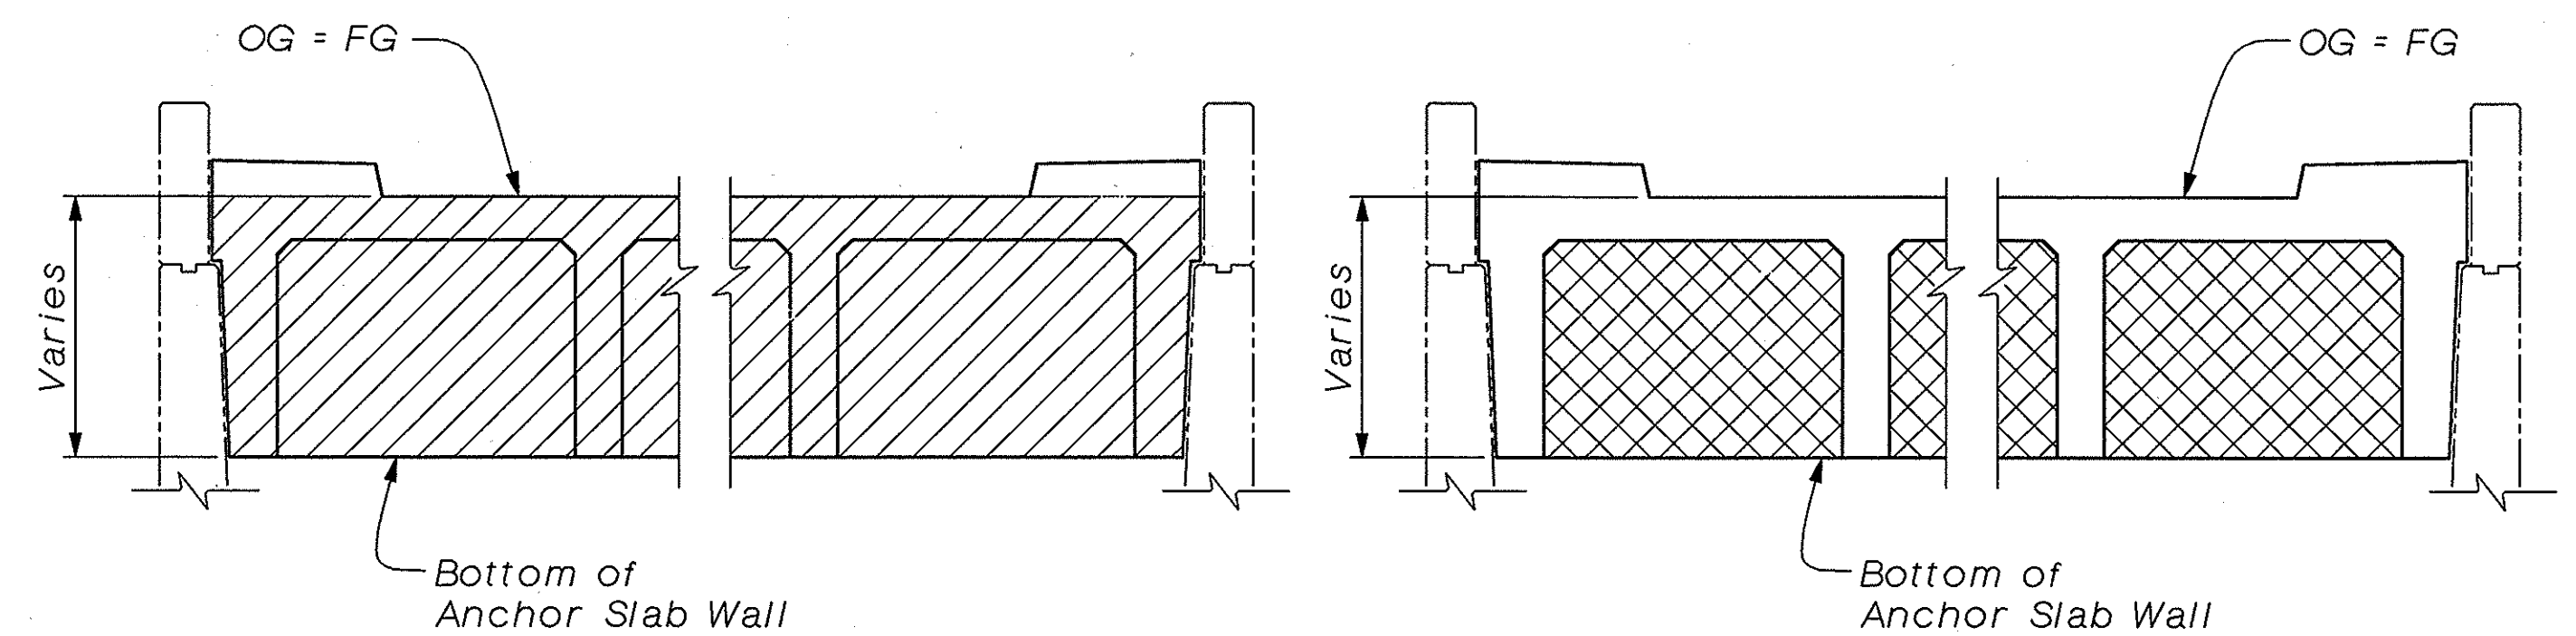

TRANSVERSE SECTION

LIMITS OF PAYMENT FOR EXCAVATION AND BACKFILL
No Scale

LEGEND

- Concrete Approach Slab Removal
- Structure Excavation (Bridge)
- Structure Backfill (Bridge)
- Structure Excavation (Type D)

SECTION E-E
No Scale
Abut 1 shown
Abut 4 similar

APPROACH SLAB REMOVAL LIMITS

Note:
The Contractor shall verify all controlling field dimensions before ordering or fabricating any material.

SHAWN SUN DESIGN OVERSIGHT 12/29/97 SIGN OFF DATE	DESIGN	BY M. ZAHEDI	CHECKED S. XIE/A. HOU	PREPARED FOR THE CITY OF HUNTINGTON BEACH	G.J. NASCIMENTO PROJECT ENGINEER	BRIDGE NO.	TRINIDAD ISLAND CHANNEL BRIDGE					
	DETAILS	BY B. TORUNO	CHECKED J. LU			55C-0260						
	QUANTITIES	BY H. LAM	CHECKED A. TRUONG			POST MILE	MISCELLANEOUS DETAILS					
				ORIGINAL SCALE IN INCHES FOR REDUCED PLANS	CU 12 152 EA L02109	DISREGARD PRINTS BEARING EARLIER REVISION DATES →	REVISION DATES (PRELIMINARY STAGE ONLY)				SHEET	OF
				0 1 2 3							5	7