

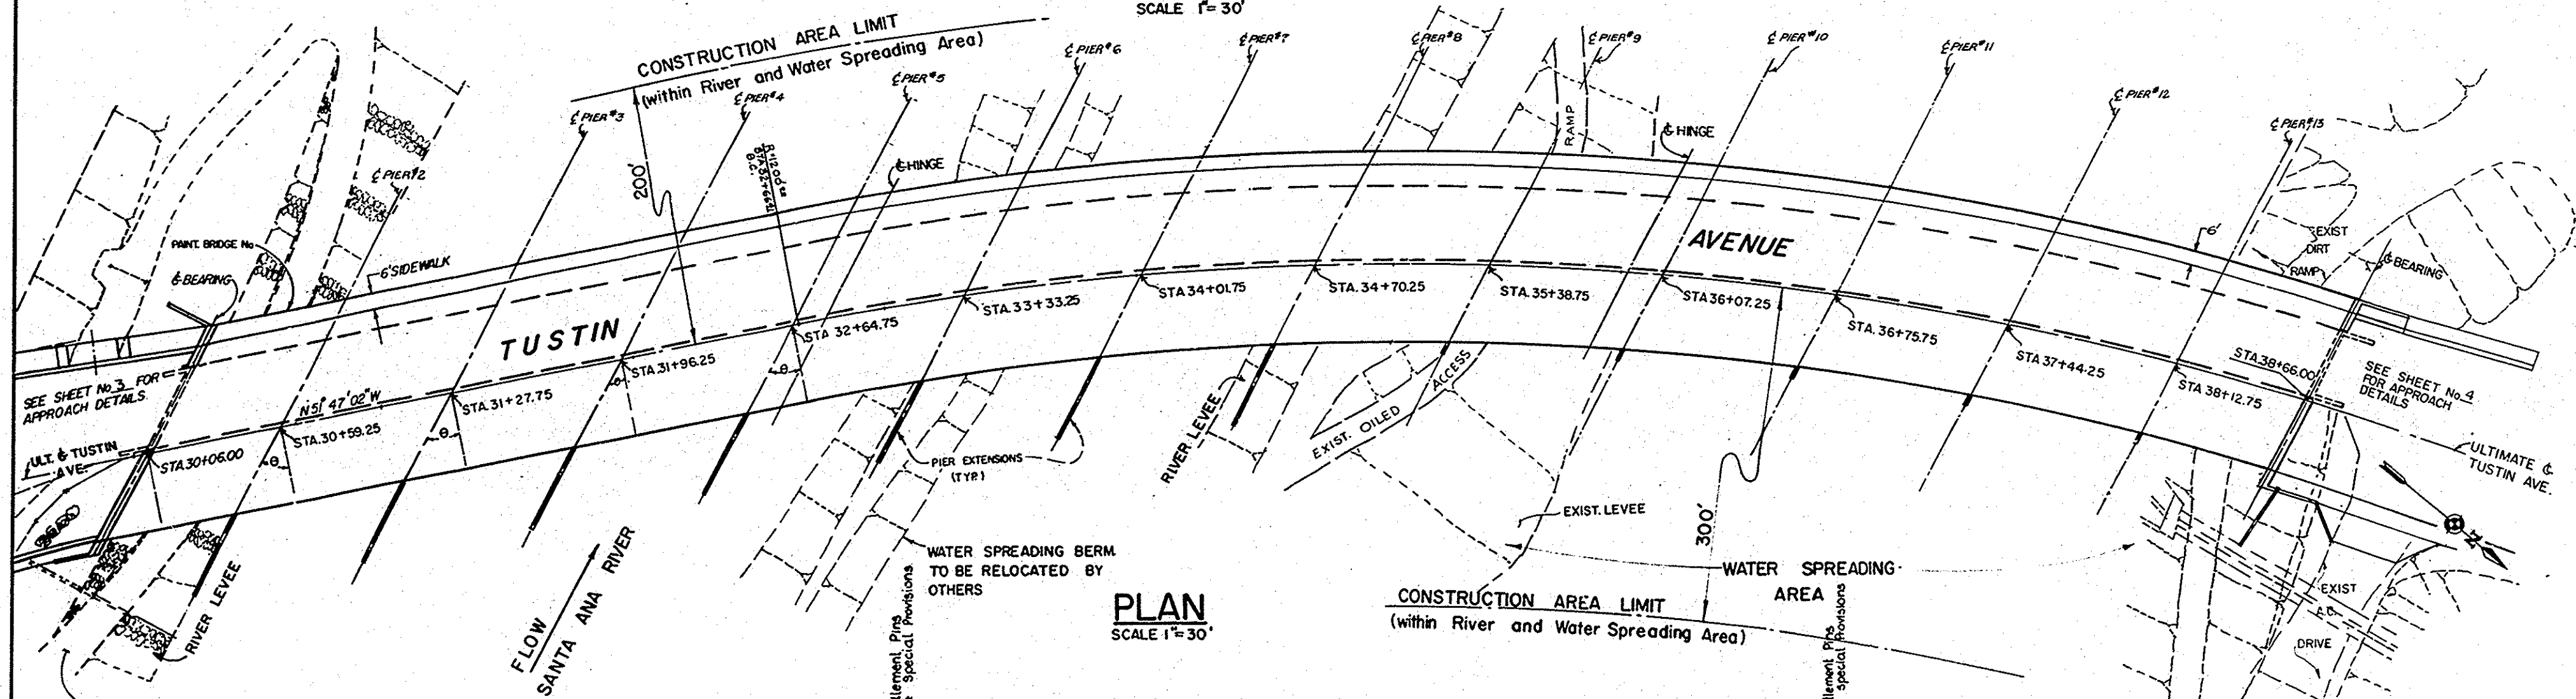


SUPERELEVATION DIAGRAM
SCALE - 1"=30' HORIZ., 1"=2% VERT.

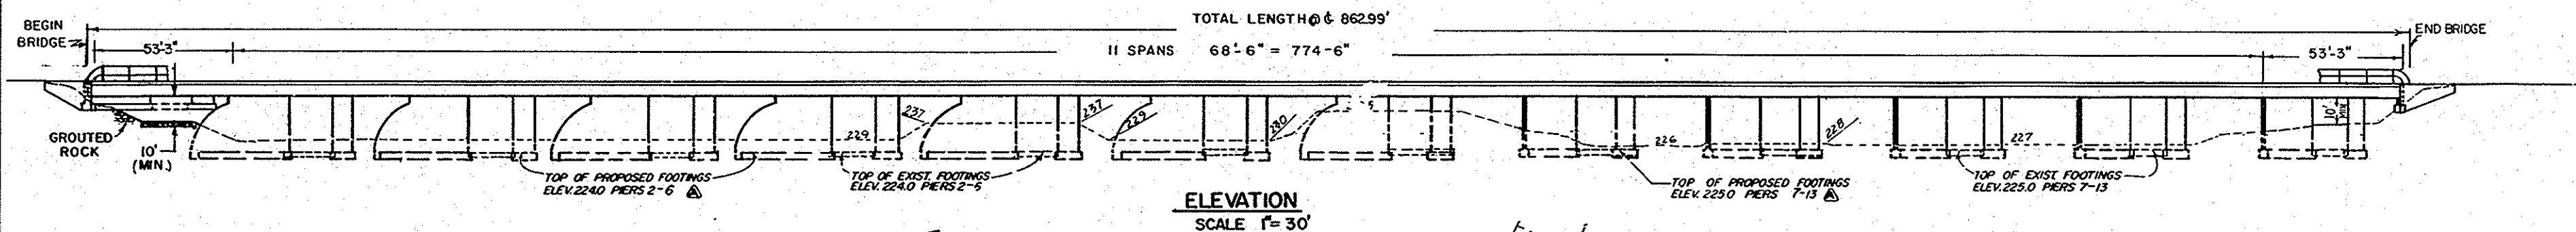

PLAN
SCALE 1"=30'

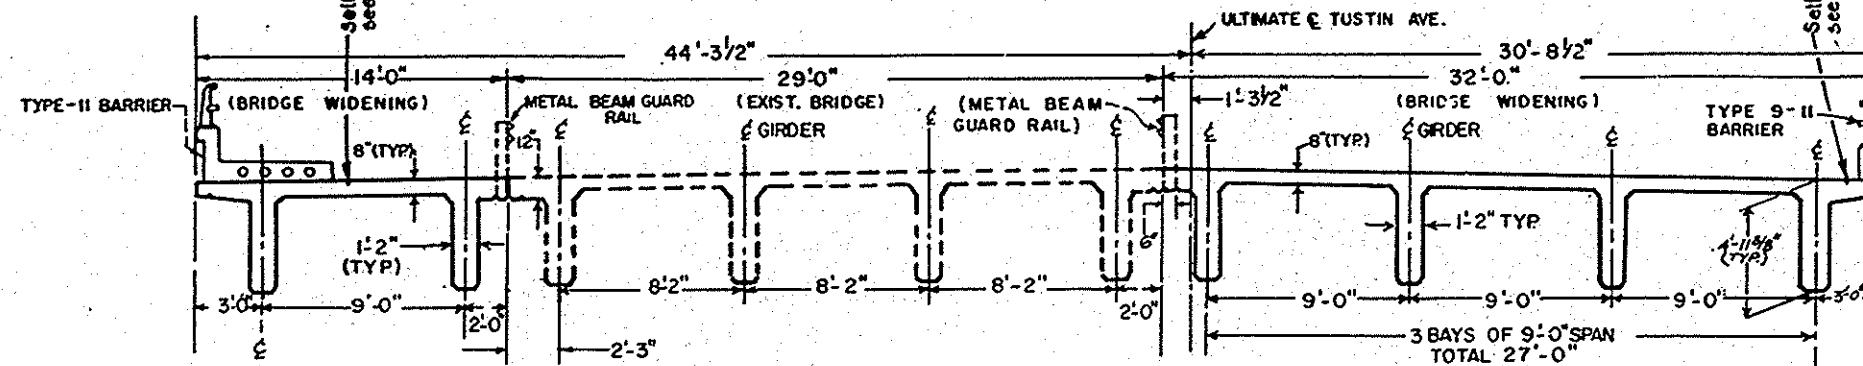

TYPICAL SECTION
SCALE 3/16"=1'-0"

θ = SKEW ANGLE

ABUT. 1	38° 26' 00"
PIER 2	38° 26' 00"
PIER 3	38° 26' 00"
PIER 4	38° 26' 00"
PIER 5	38° 26' 00"
PIER 6	35° 14' 31"
PIER 7	31° 58' 17"
PIER 8	28° 42' 02"
PIER 9	25° 25' 48"
PIER 10	22° 09' 34"
PIER 11	18° 53' 20"
PIER 12	15° 37' 05"
PIER 13	12° 20' 51"
ABUT. 14	9° 48' 18"

Dr. 8 12952
Street Improvements
Sheet 6 of 35
Red 24.1
Linen

ORANGE COUNTY ENVIRONMENTAL MANAGEMENT AGENCY	
TUSTIN AVE. BRIDGE SA-7A AT SANTA ANA RIVER	
GENERAL PLAN	
MARK	DATE
REVISIONS	
DESIGNED	DATE
DRAWN	CHECKED
SCALE	DWG. NO.
AS SHOWN	6
SHEET 35	

DR. 8 (12952)