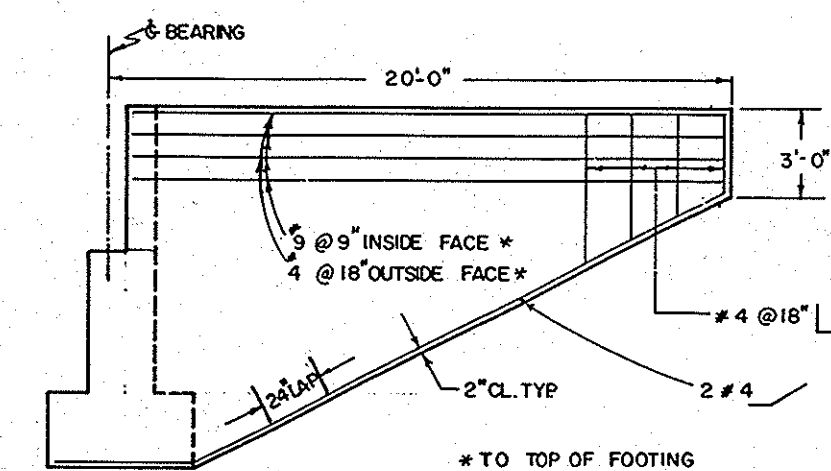


[illegible]

TYPICAL SECTION **ABUTMENT No. 14**
SECTION AA
 SCALE 1/2" = 1'-0" 1 1/2 0 1
 3 inches on original drawing

 3-81	ORANGE COUNTY ENVIRONMENTAL MANAGEMENT AGENCY TUSTIN AVE. BRIDGE SA-7A AT SANTA ANA RIVER ABUTMENT # 14 DETAIL		SHEET
			9
			35
MARK	DATE	DESCRIPTION	PREPARED UNDER SUPERVISION OF <i>M.A. Mandy</i>
REVISIONS			DATE
DESIGNED <i>MA</i>	SCALE		DATE
DRAWN <i>K.K.P.</i>	AS SHOWN		DWG. NO.
CHECKED <i>K.P.</i>			

Dr. 8 12952
Street Improvements
Sheet 9 of 35
Red 24;1
Linen

DR 812952