
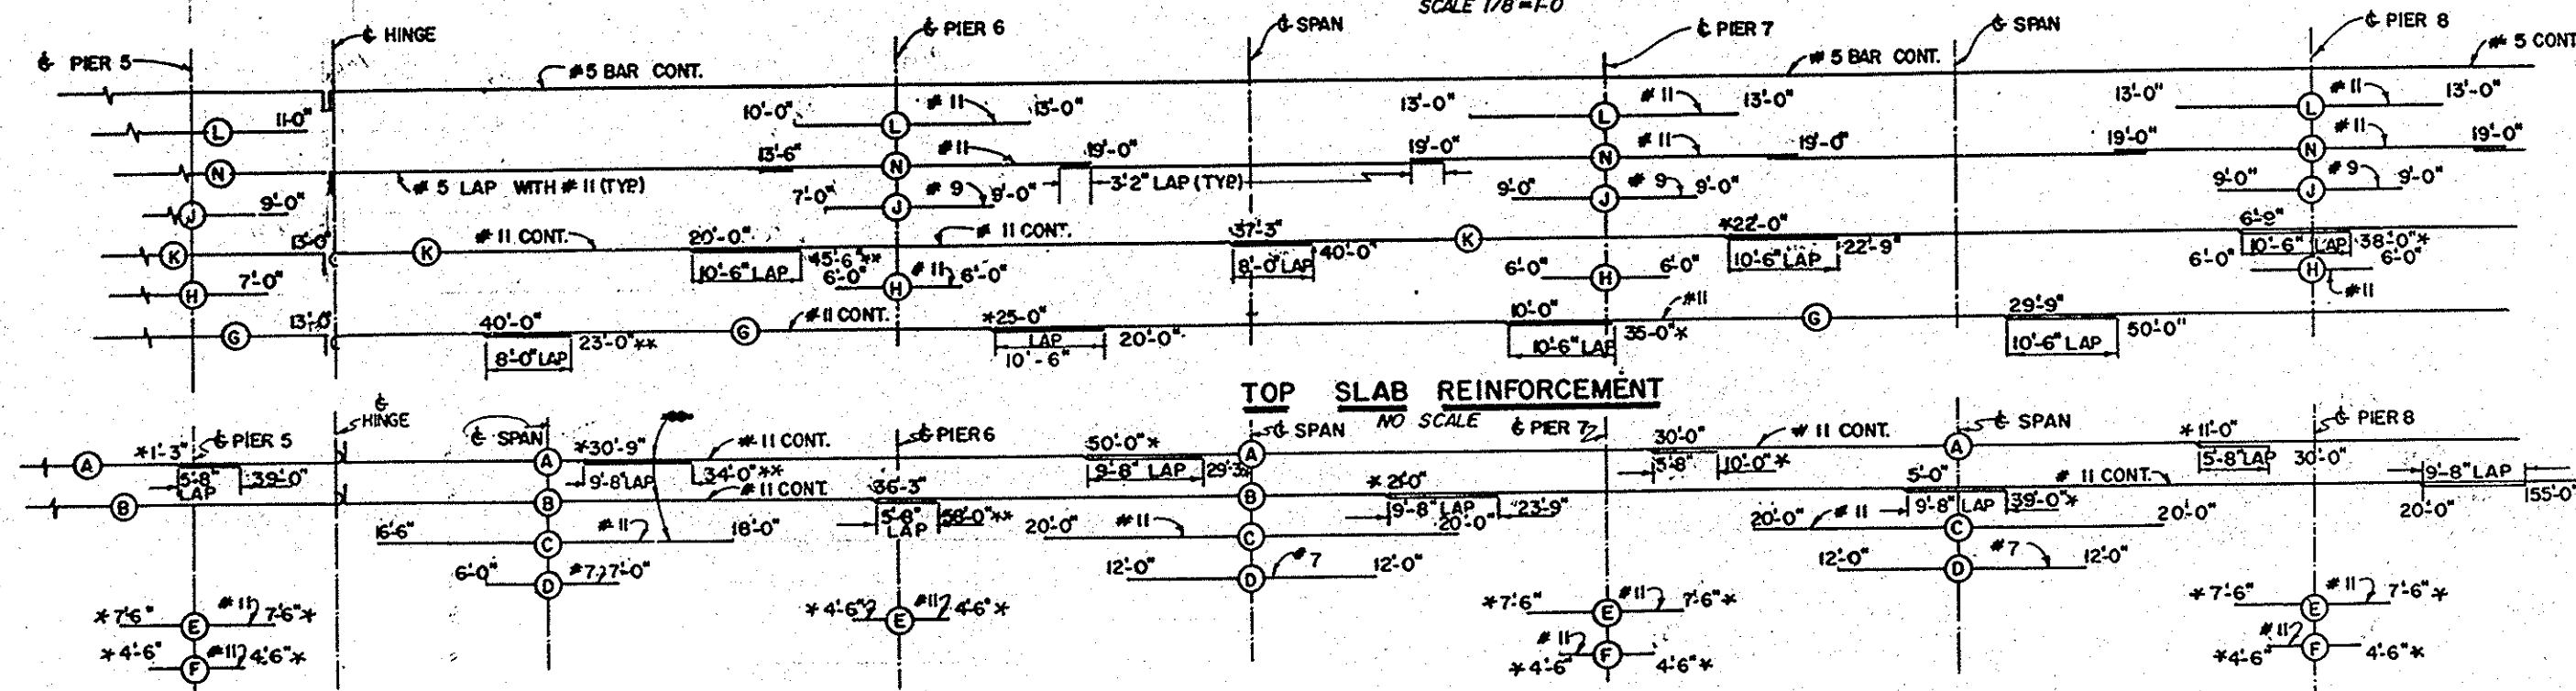
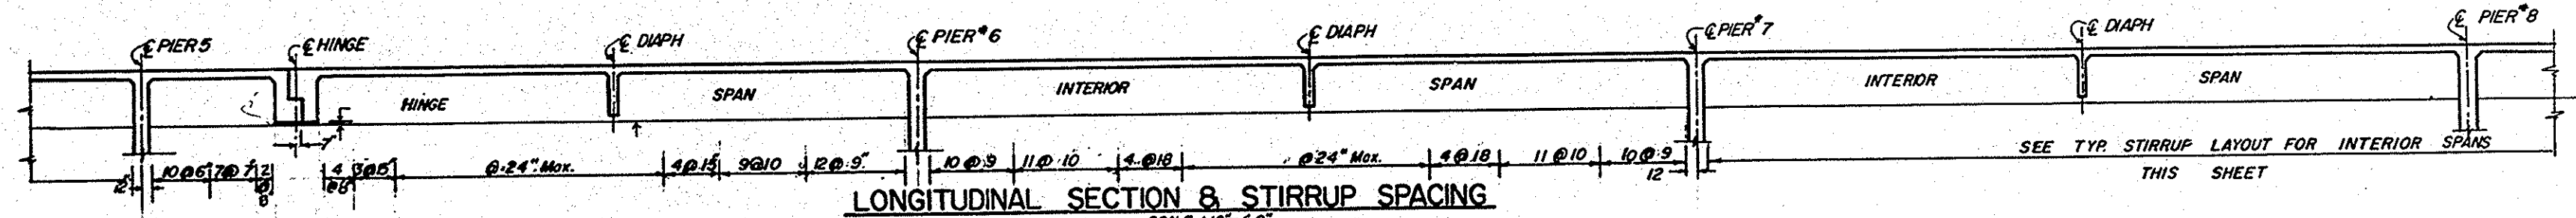


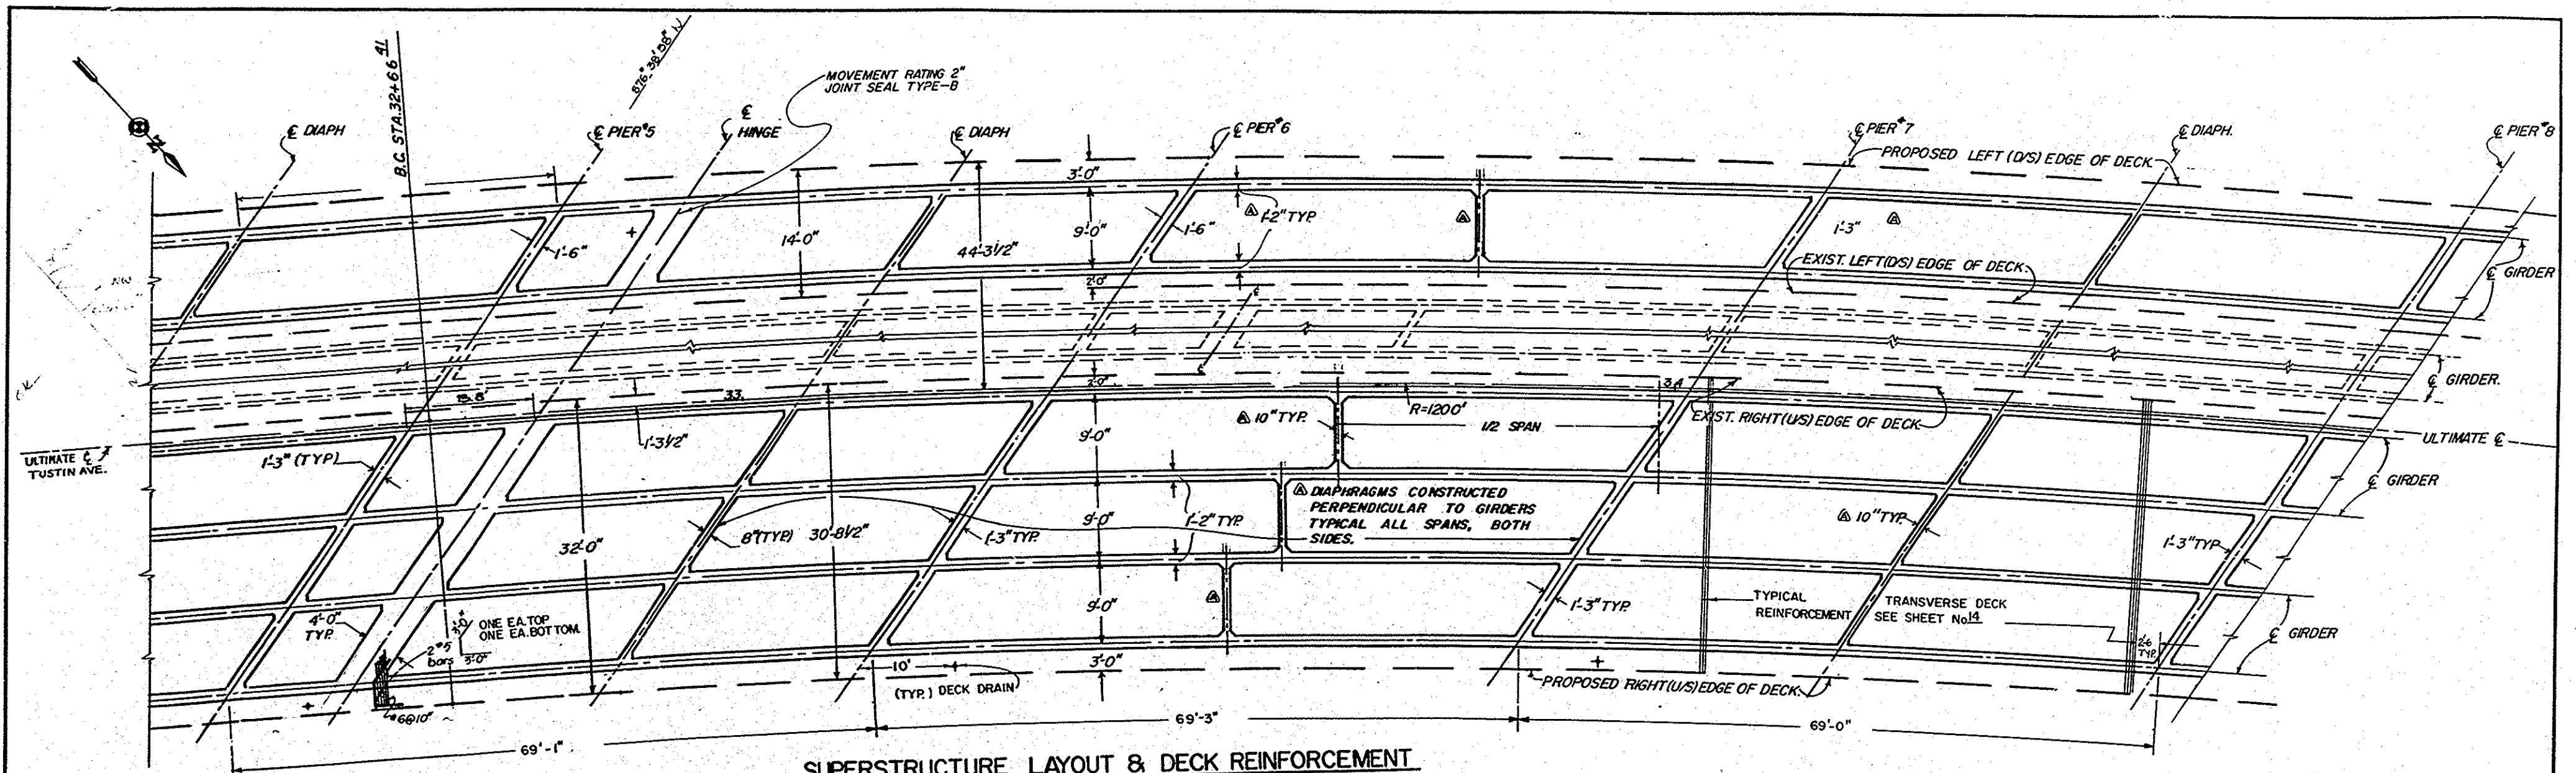

NOTE:
FOR GIRDER REINFORCEMENT
NUMBER AT END OF BAR INDICATES LENGTH FROM G SPAN
* INDICATES LENGTH FROM G PIER
** INDICATES LENGTH FROM DECK JOINT

GIRDER REINFORCEMENT
NO SCALE

NOTE:
SPAN LENGTH VARIES ACROSS DECK
MIN. LAP IS SHOWN.

1 1/2 0 1 2
3 inches on original drawing

ORANGE COUNTY ENVIRONMENTAL MANAGEMENT AGENCY	
TUSTIN AVE BRIDGE SA-7A AT SANTA ANA RIVER	
SUPERSTRUCTURE LAYOUT & REINFORCEMENT	
MARK	DATE
DESIGNED	REVISIONS
DRAWN	DATE
CHECKED	DWG. NO.
SHEET 16/35	

Dr. 8 12952
Street Improvements
Sheet 16 of 35
Red 24:1
Linen