



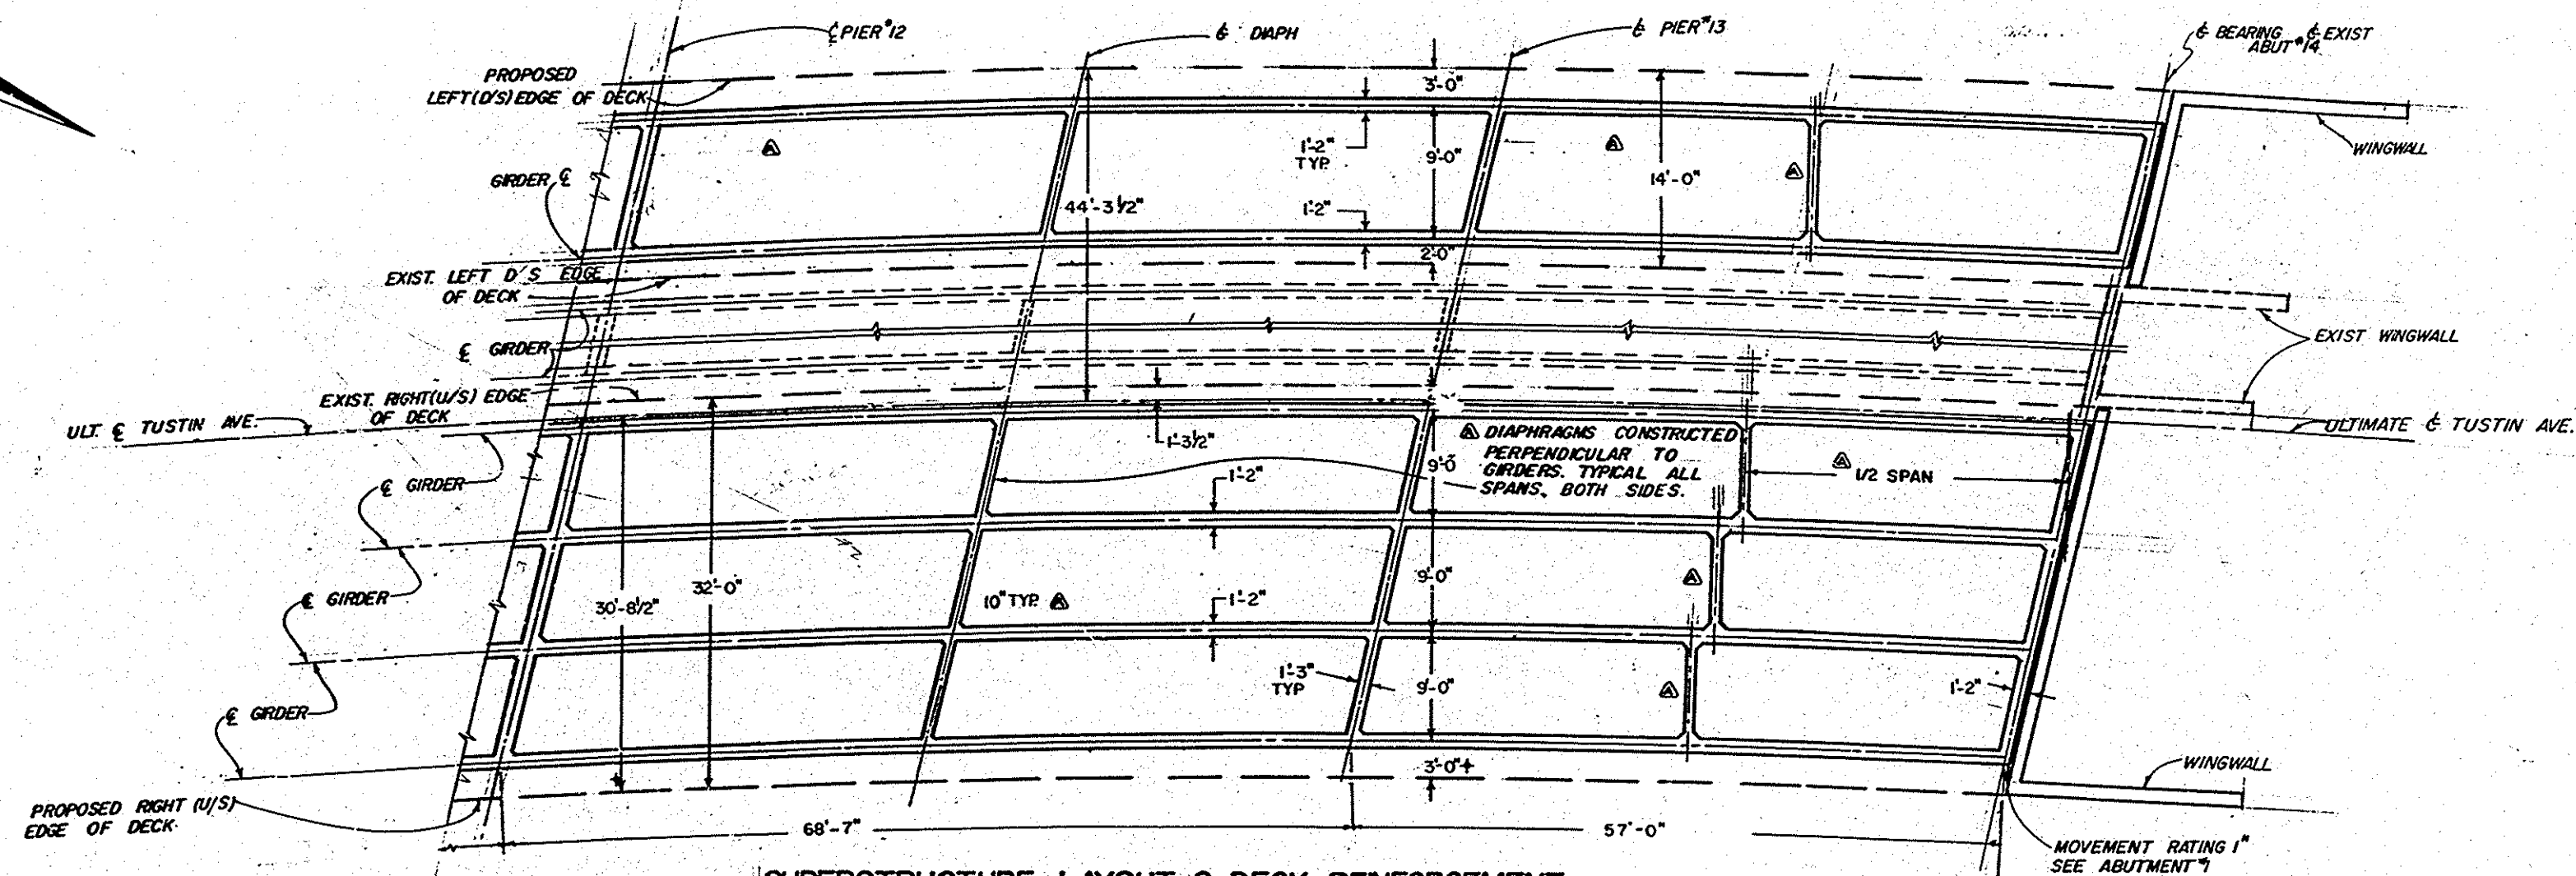

SUPERSTRUCTURE LAYOUT & DECK REINFORCEMENT

SCALE: 1/8"=1'-0"

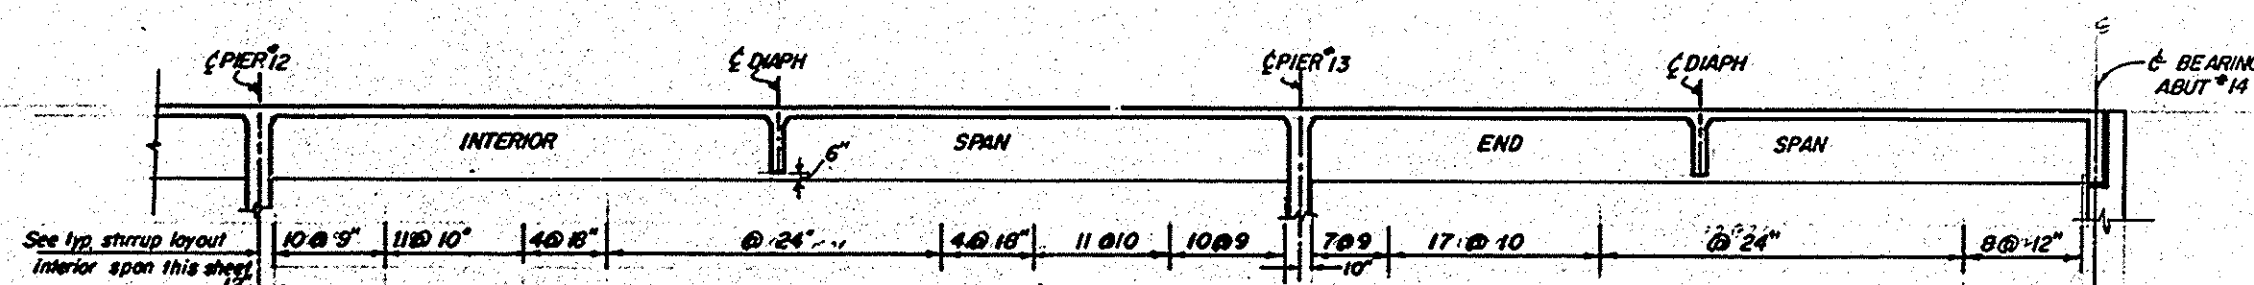

LONGITUDINAL SECTION & STIRRUP SPACING

SCALE 1/8"=1'-0"

NOTE:
FOR TOP AND BOTTOM REINFORCEMENT USE TYPICAL LAYOUT SHEET 12, REVERSED

1 1/2 0 1 2
3 inches on original drawing

ORANGE COUNTY ENVIRONMENTAL MANAGEMENT AGENCY	
TUSTIN AVE. BRIDGE SA-7A AT SANTA ANA RIVER	
SUPERSTRUCTURE LAYOUT & REINFORCEMENT	
MARK	DATE
DESCRIPTION	PREPARED UNDER
REVISIONS	SUPERVISION OF
DESIGNED	SCALE
DRAWN	DATE
CHECKED	DWG. NO.
AS SHOWN	DATE
18	35

Dr. 8 12952
Street Improvements
Sheet 18 of 35
Rev 24:11
Linen

Dr 8 12952