



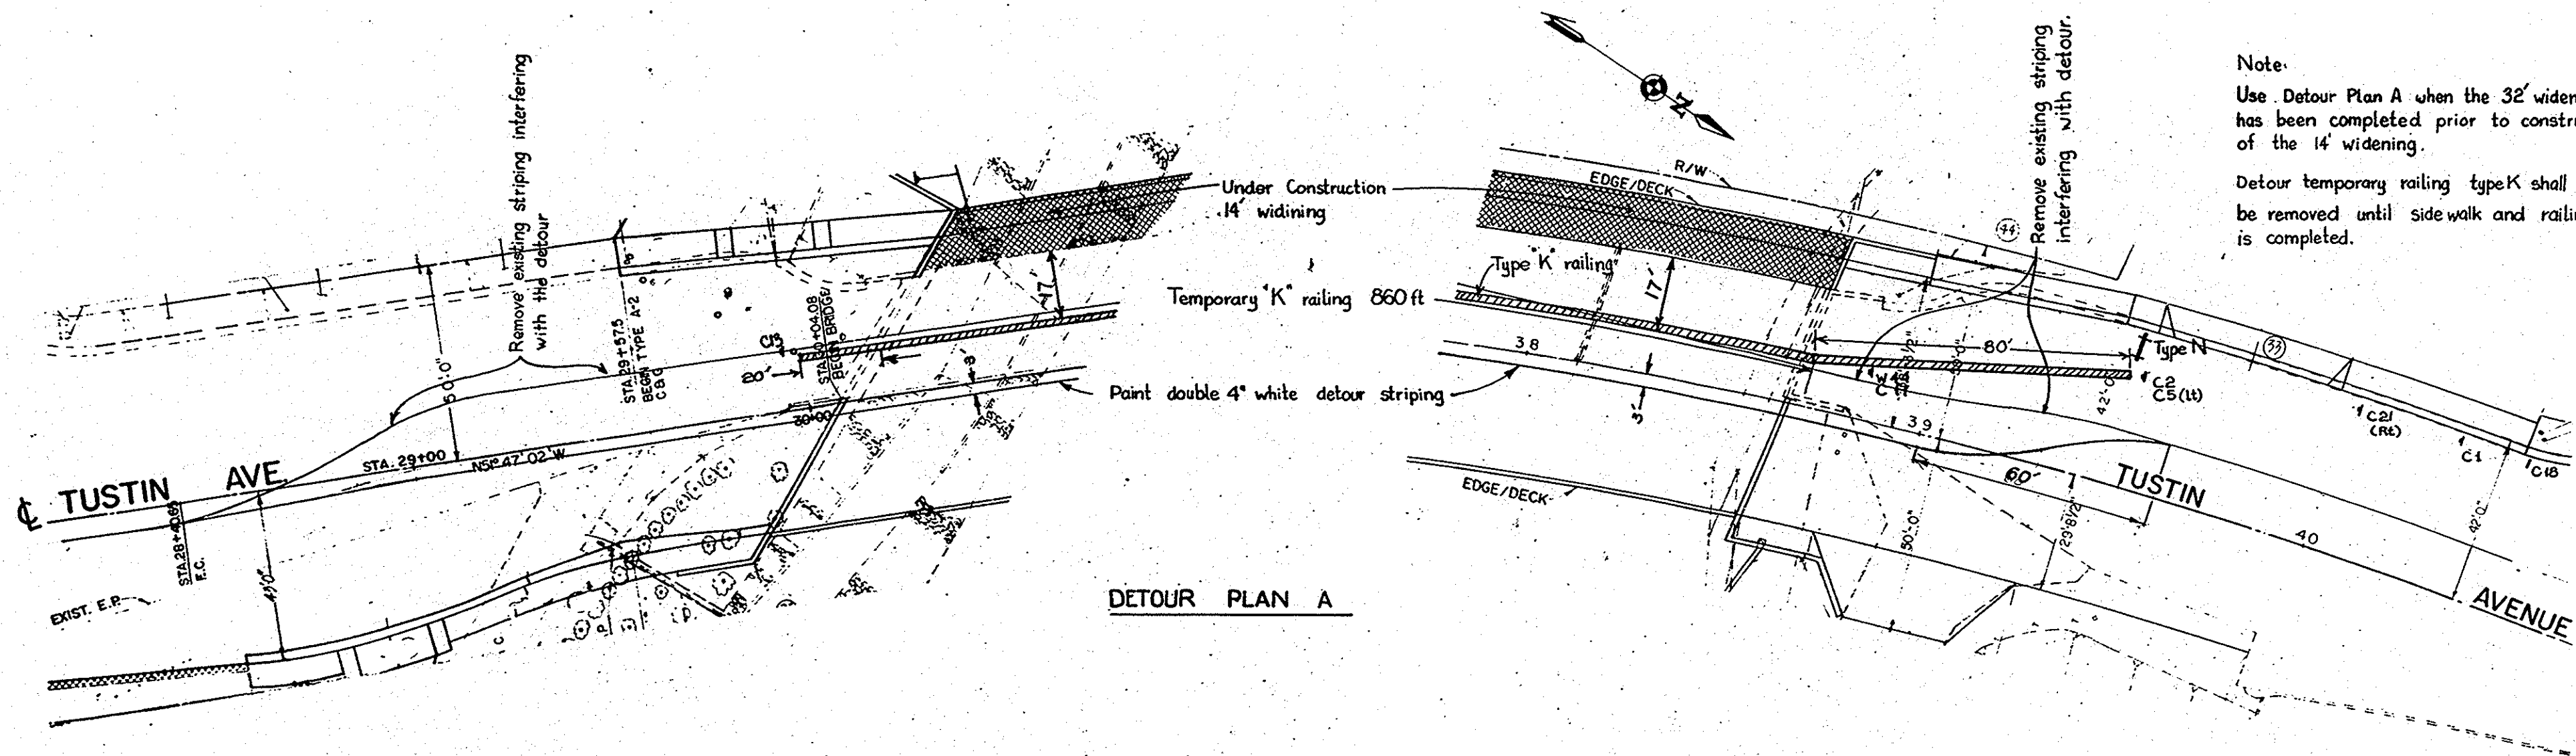

DETOUR PLAN A

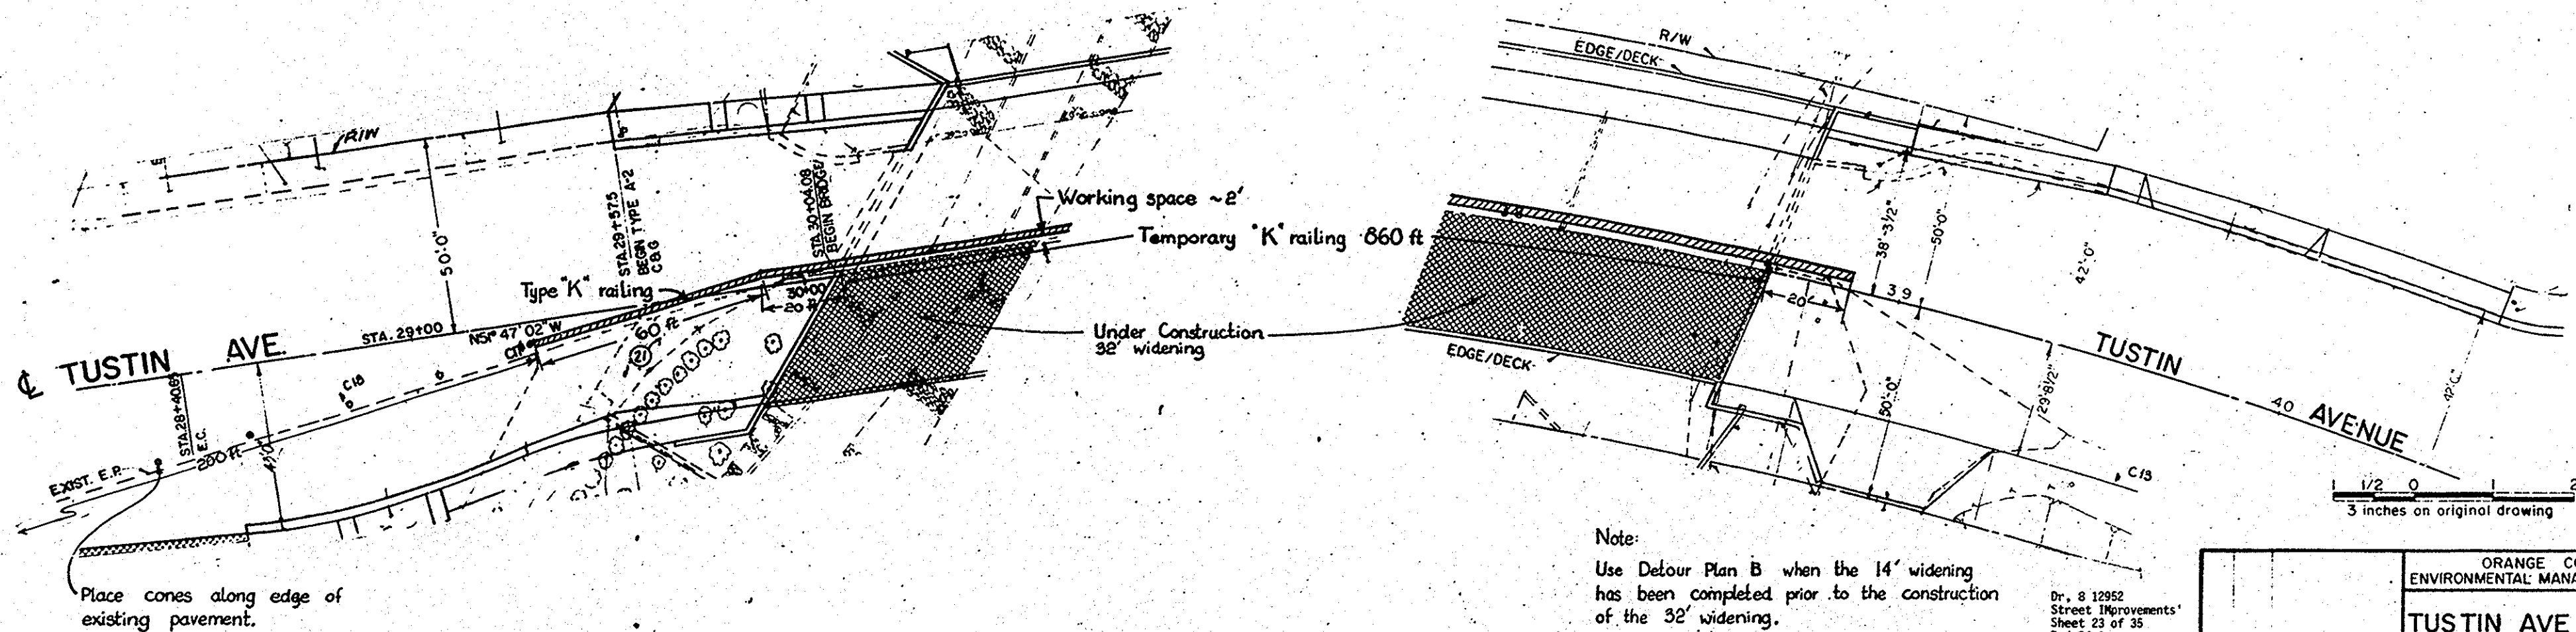

DETOUR PLAN B

Note:
Use Detour Plan A when the 32' widening has been completed prior to construction of the 14' widening.
Detour temporary railing type K shall not be removed until sidewalk and railing is completed.

Note:
Use Detour Plan B when the 14' widening has been completed prior to the construction of the 32' widening.
Detour temporary railing type K shall not be removed until Bridge Railing is completed.

Dr. 8 12952
Street Improvements
Sheet 23 of 35
Red 24:1
Cronaflex

De8 12952

ORANGE COUNTY ENVIRONMENTAL MANAGEMENT AGENCY		TUSTIN AVE BRIDGE SA-7A AT SANTA ANA RIVER	
DETOUR PLAN			
MARK	DATE	PREPARED UNDER SUPERVISION OF	SHEET
DESIGNED	MA	SCALE	DATE
CHECKED	MA	AS SHOWN	DATE
		OWG. NO.	35