
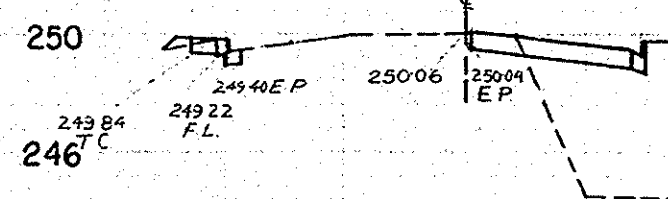


TUSTIN AVE. BRIDGE
X-SECTIONS
ALONG & TUSTIN AVE.
Sht. 28/35
SCALE: HORZ. 1"=20'
VERT. 1"=4'-0"

252



250

246

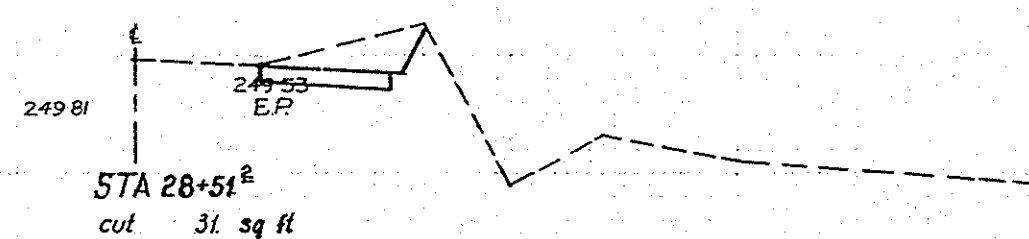


250

246

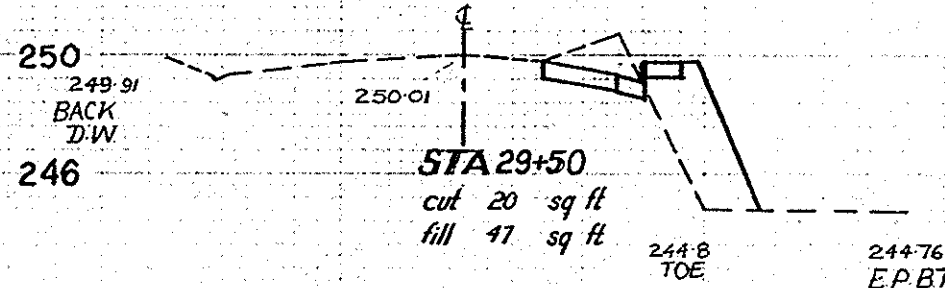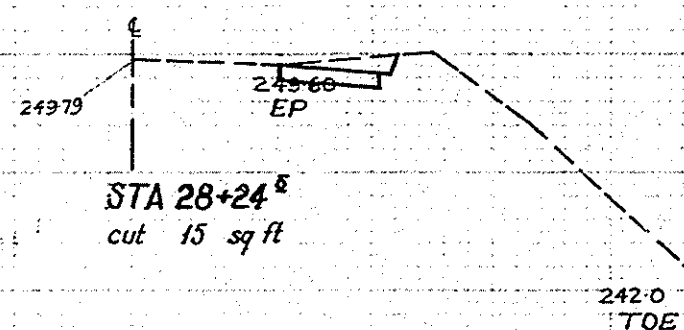

250



246

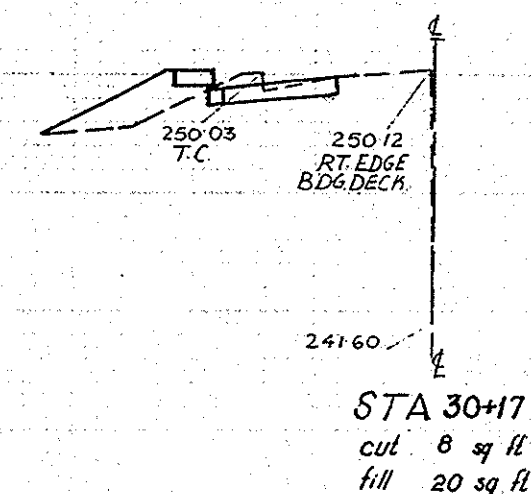

252


250

246

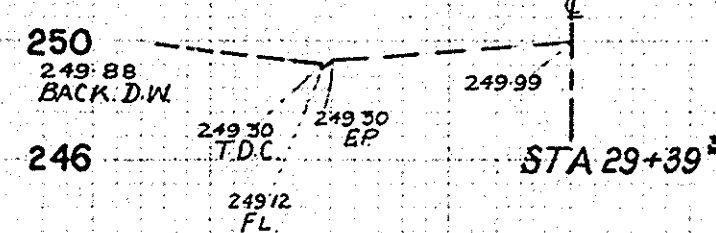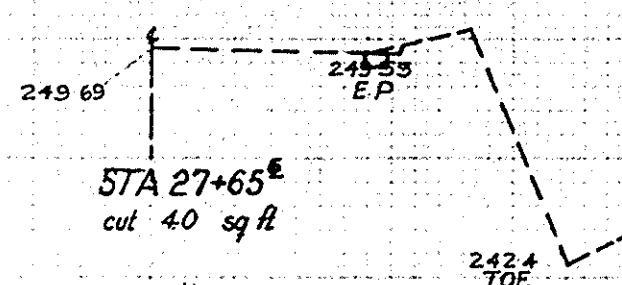



250

246

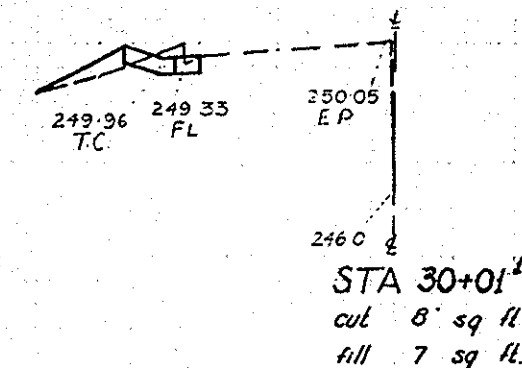

250

246

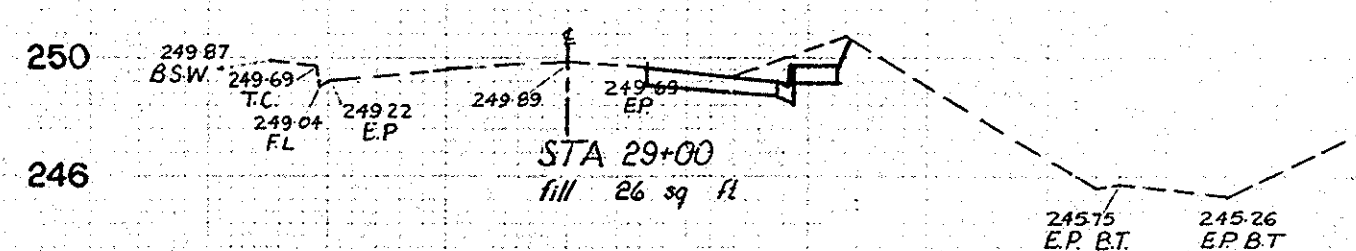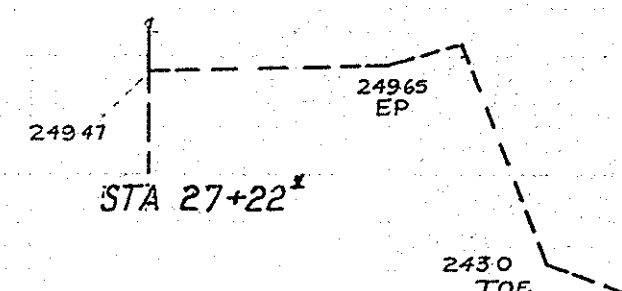

Dr. 8 12952
Street Improvements
Sheet 28 of 35
Red 24:1
Vellum

Dr 8 12952