
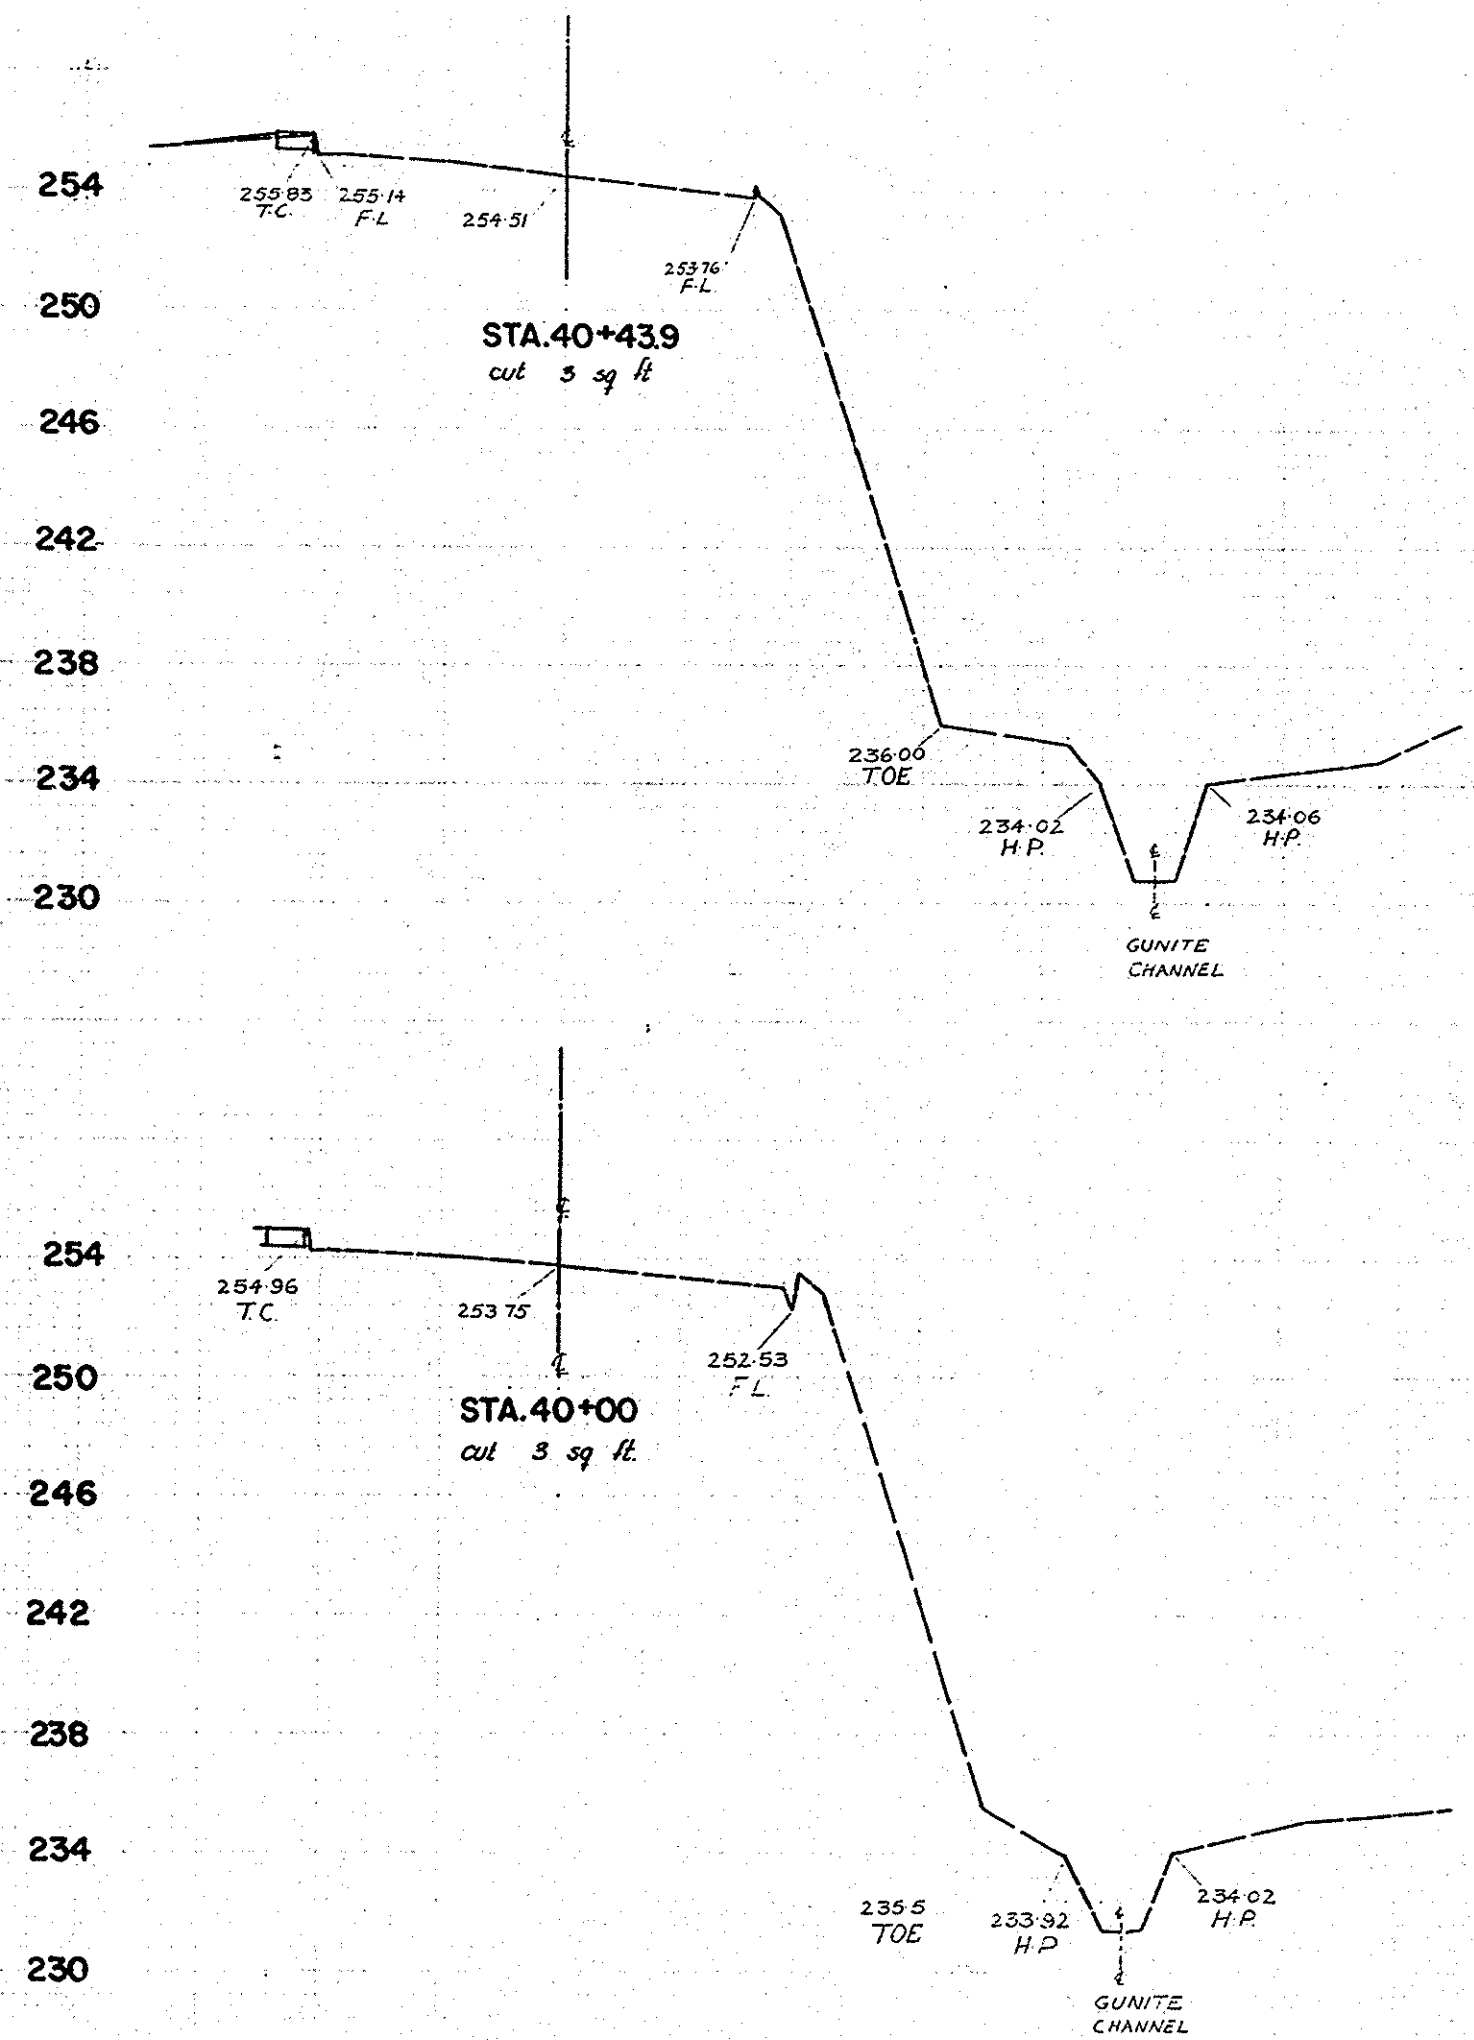


TUSTIN AVE. BRIDGE
X-SECTIONS
ALONG TUSTIN AVE.
SCALE HORZ. 1"=20'
VERT. 1"=4'-0"

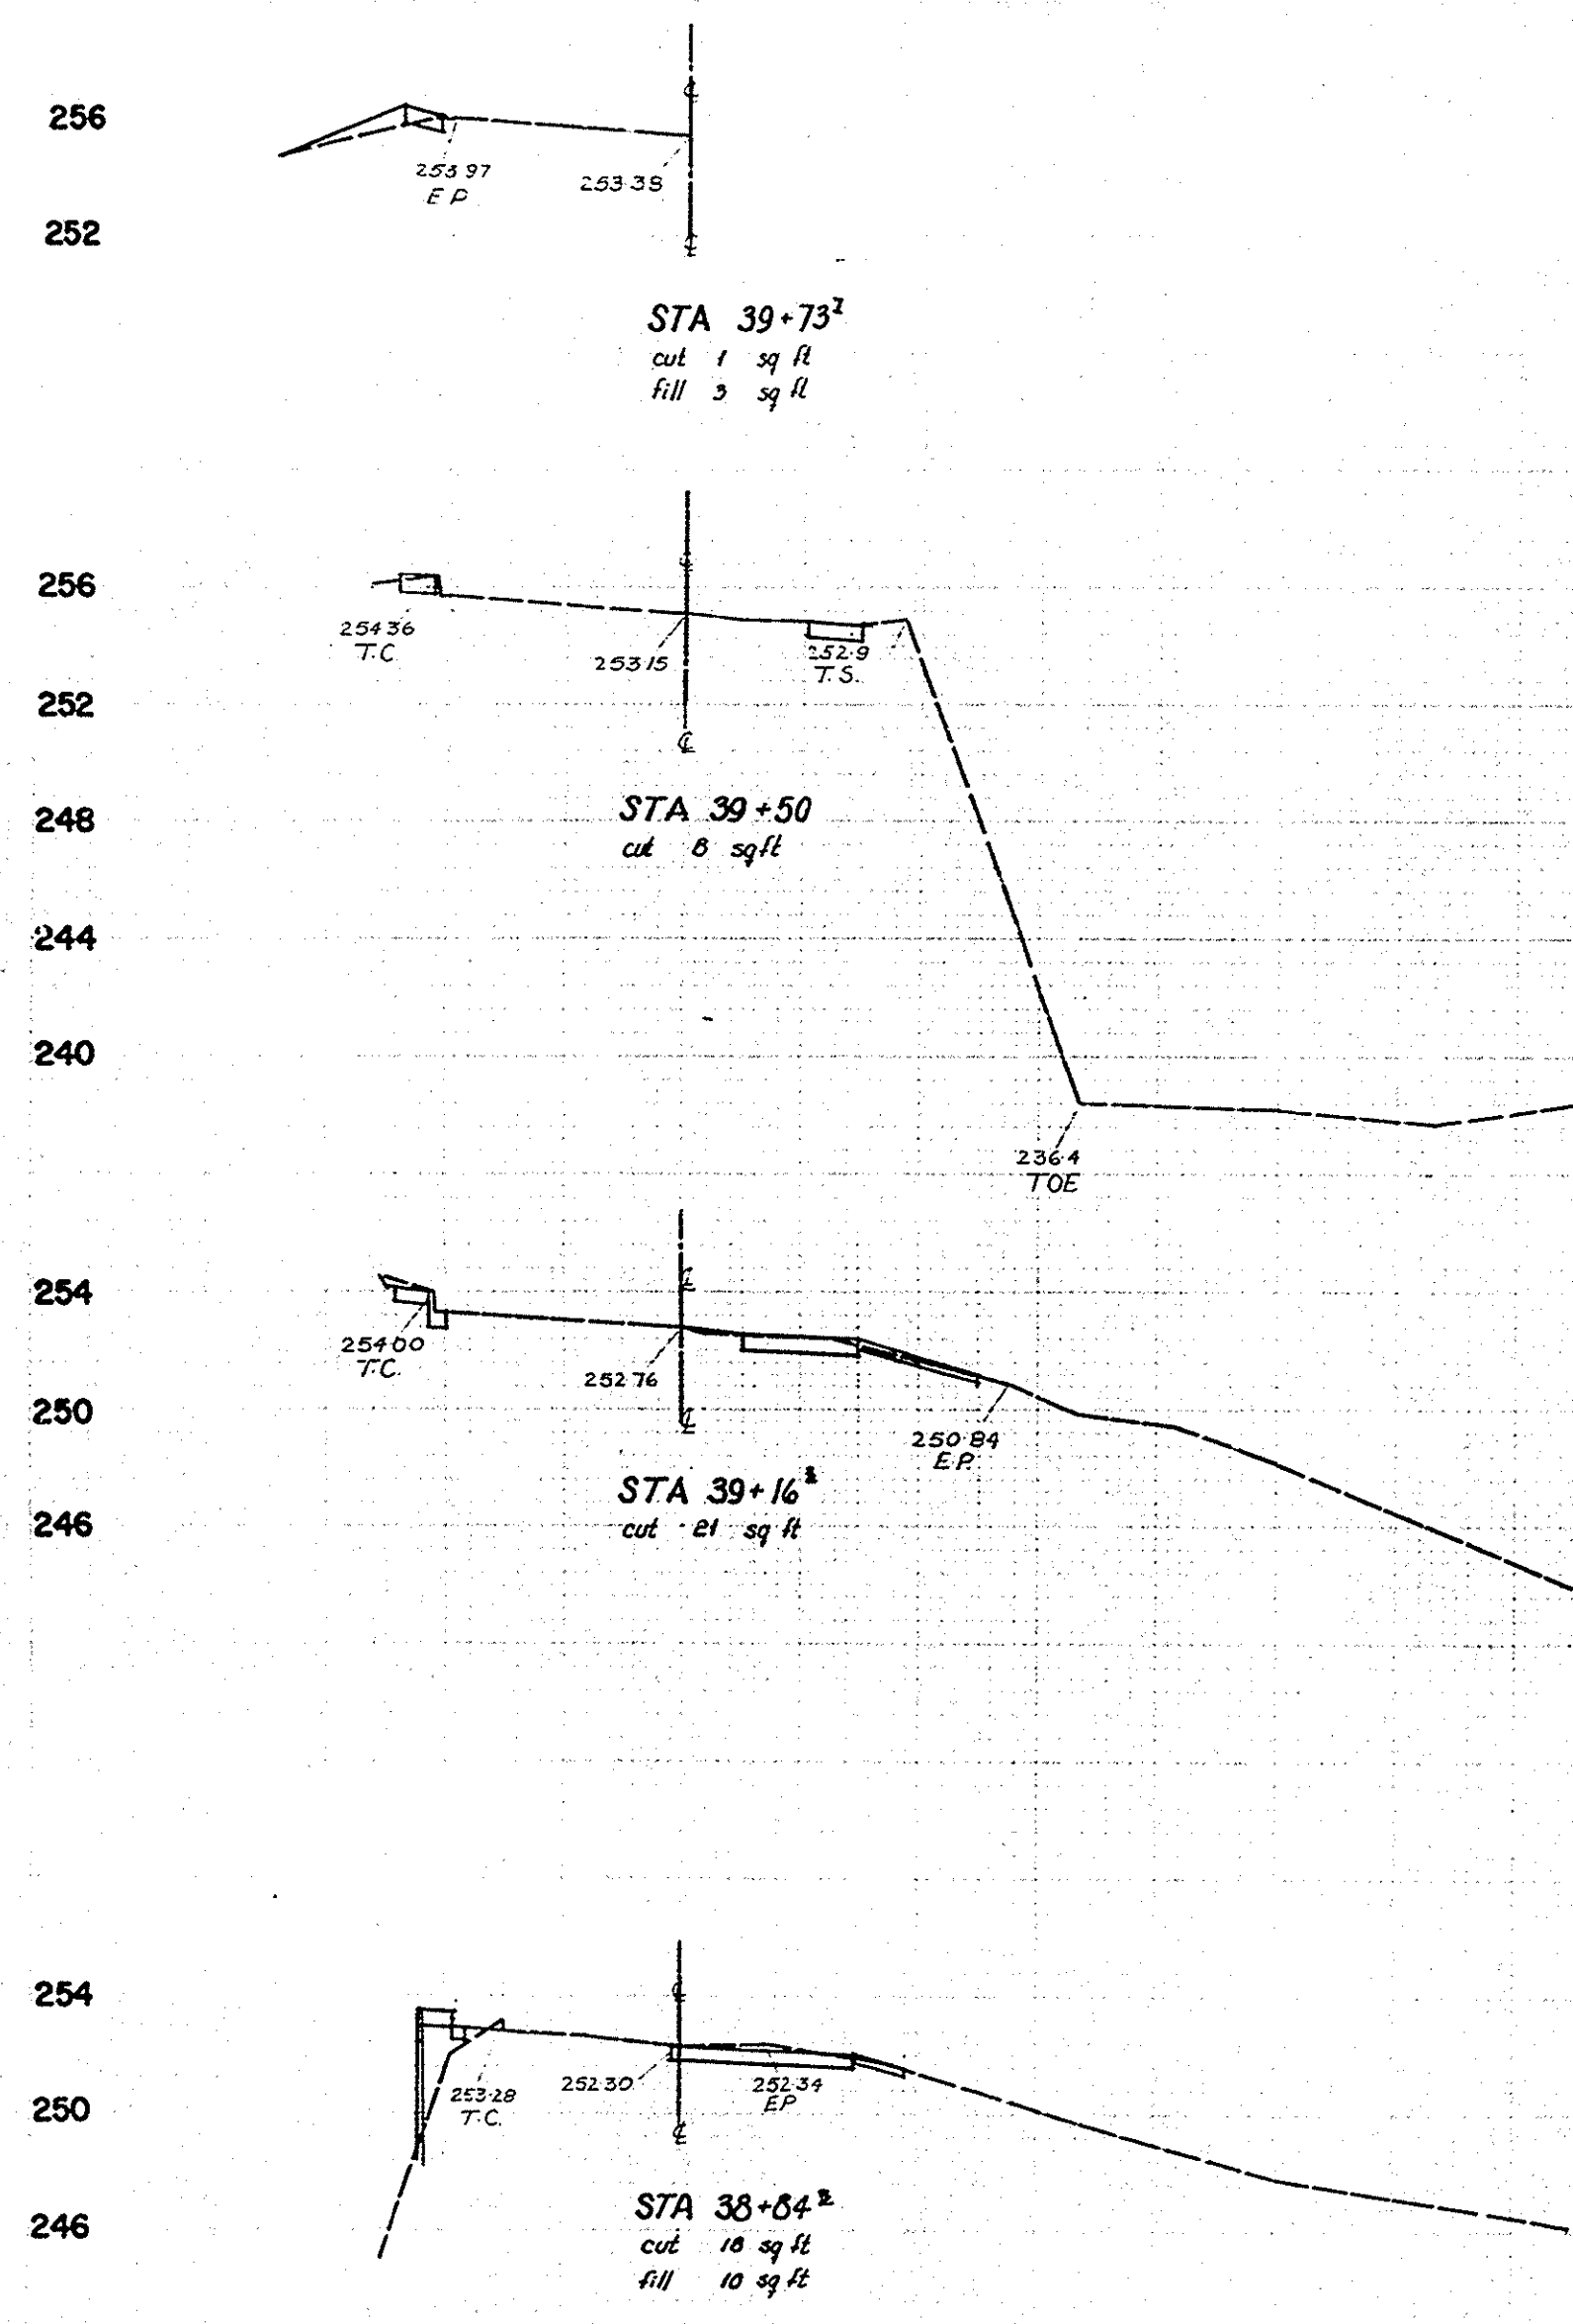

Dr. 8 12952
Street Improvements
Sheet 29 of 35
Red 24:1
Vellum

Dr. 8 12952