
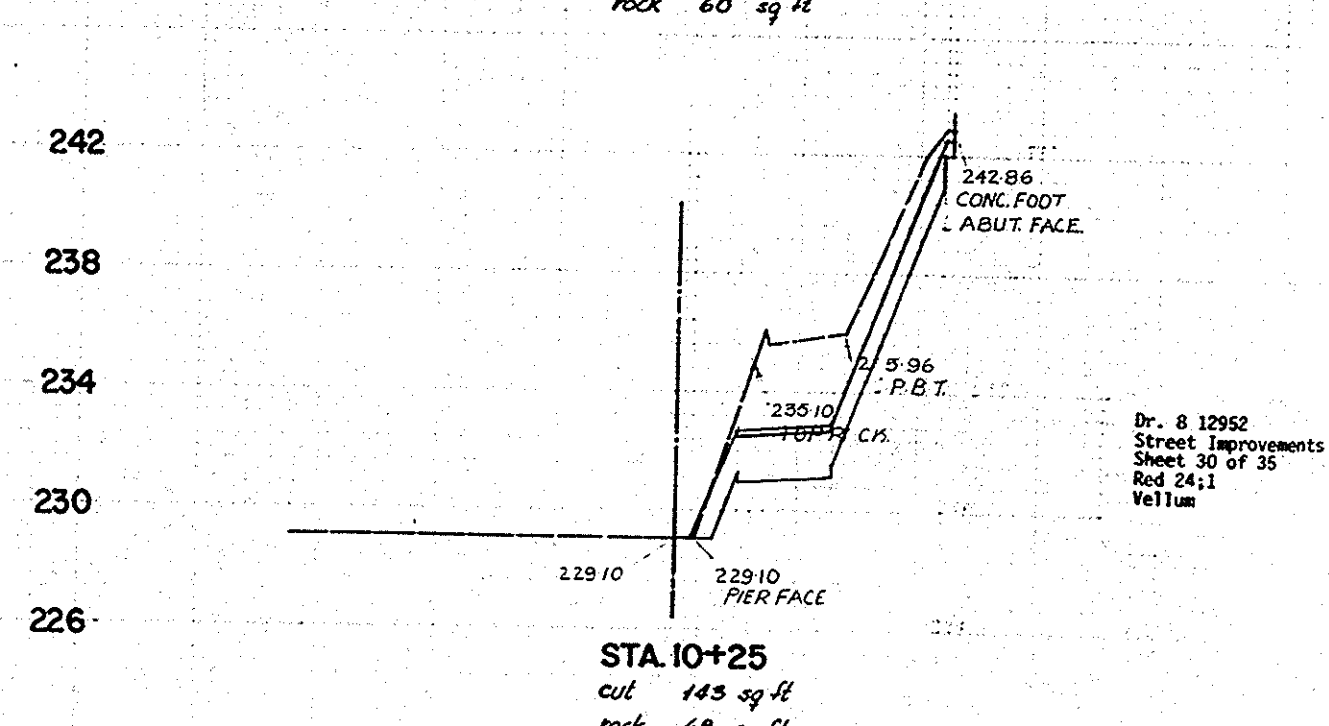
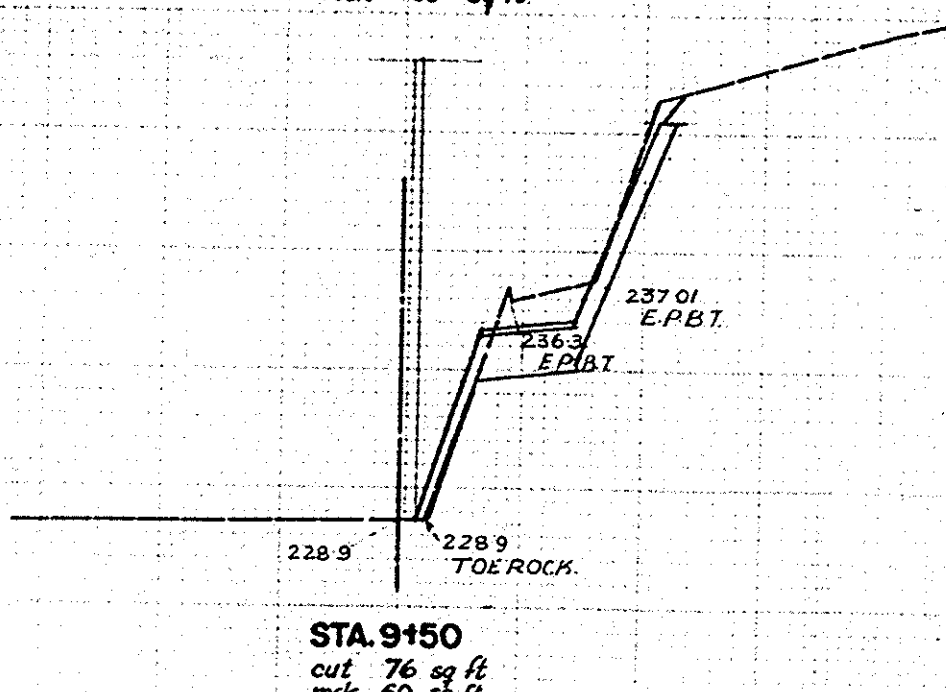
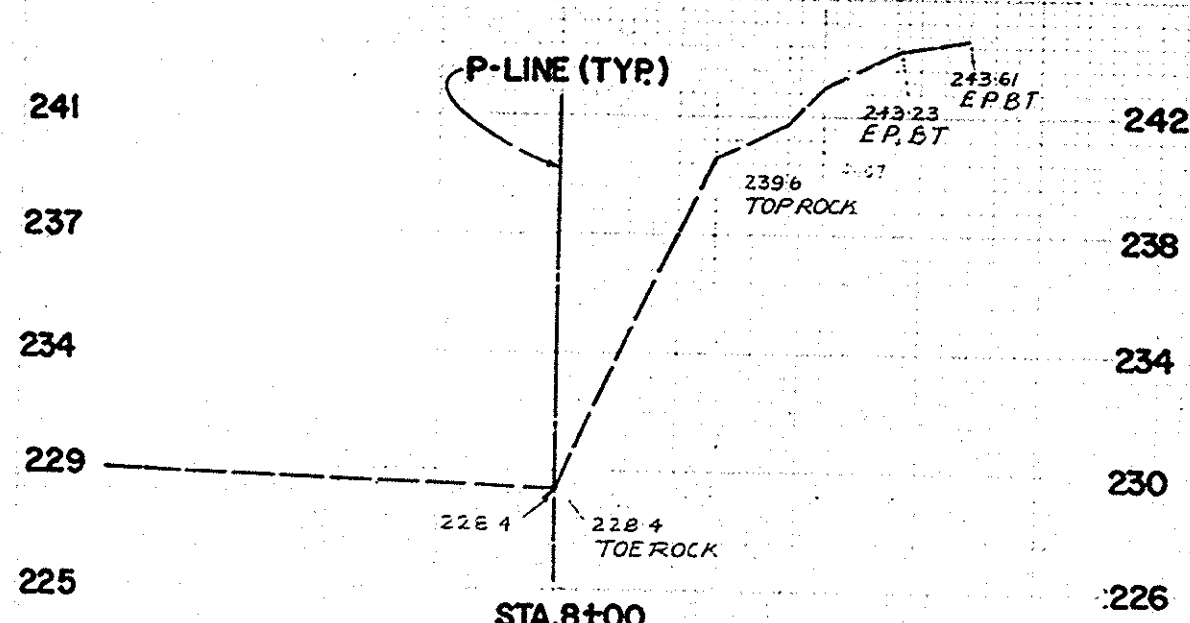
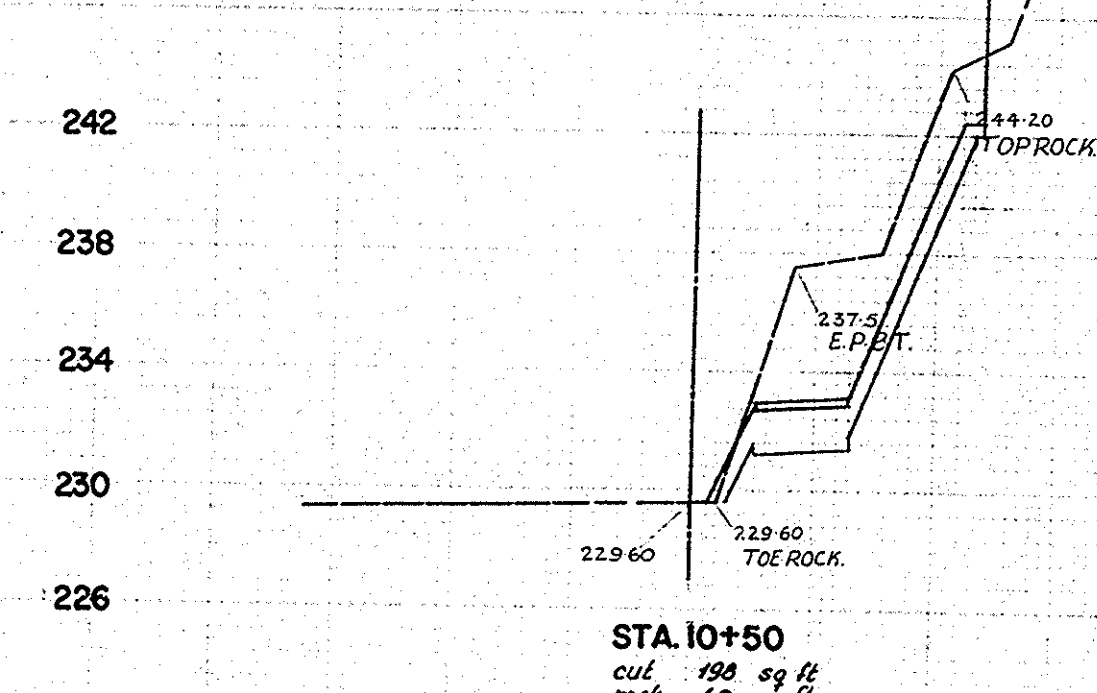
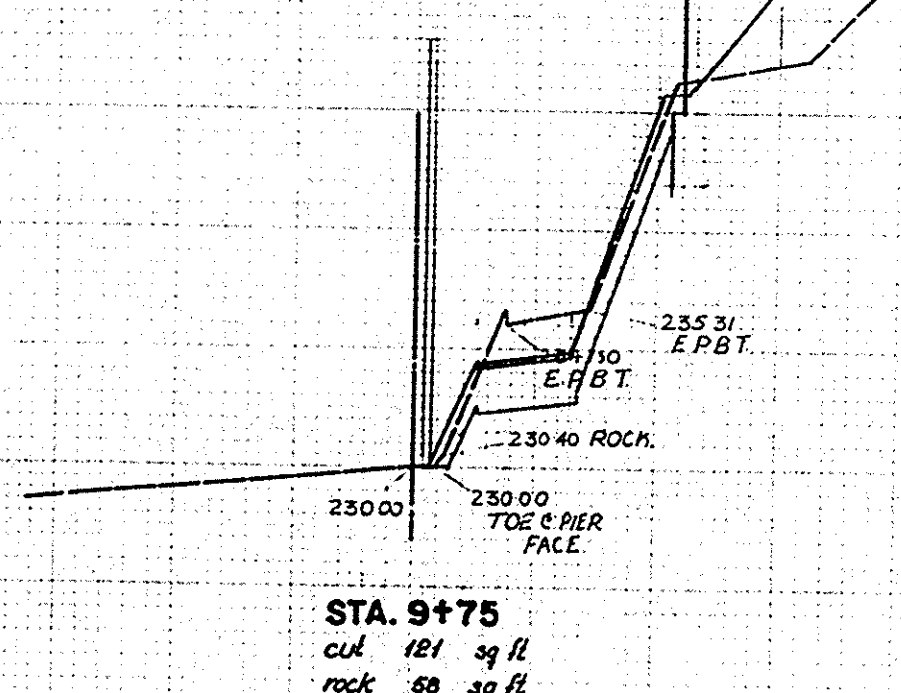
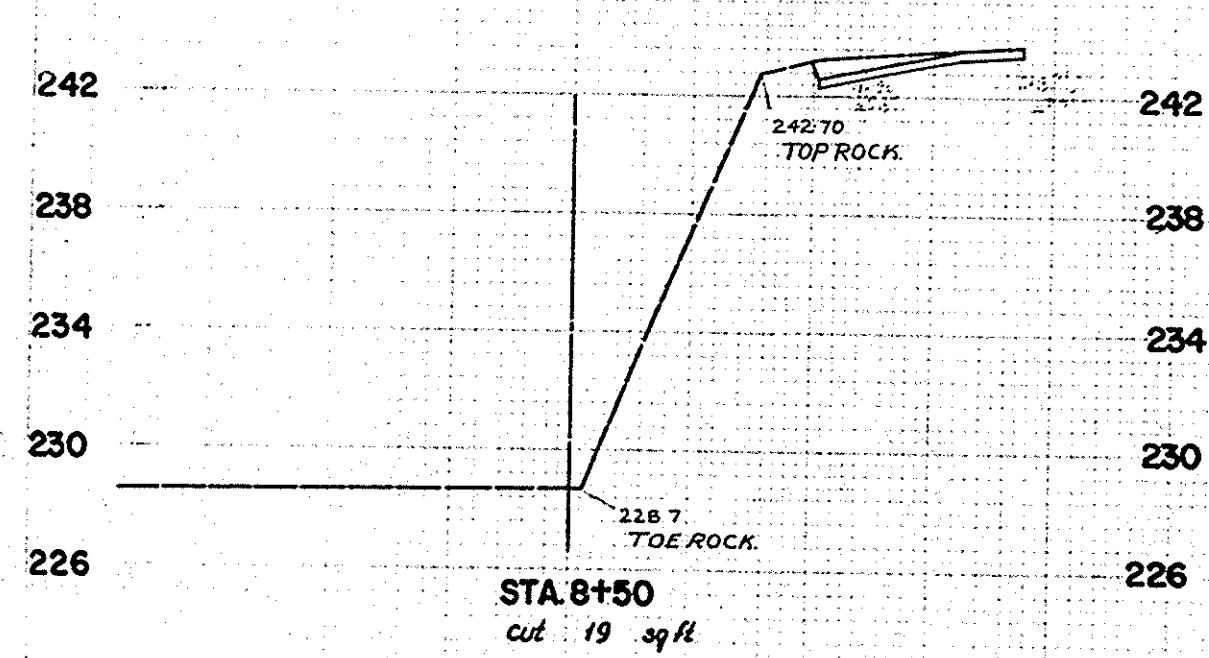
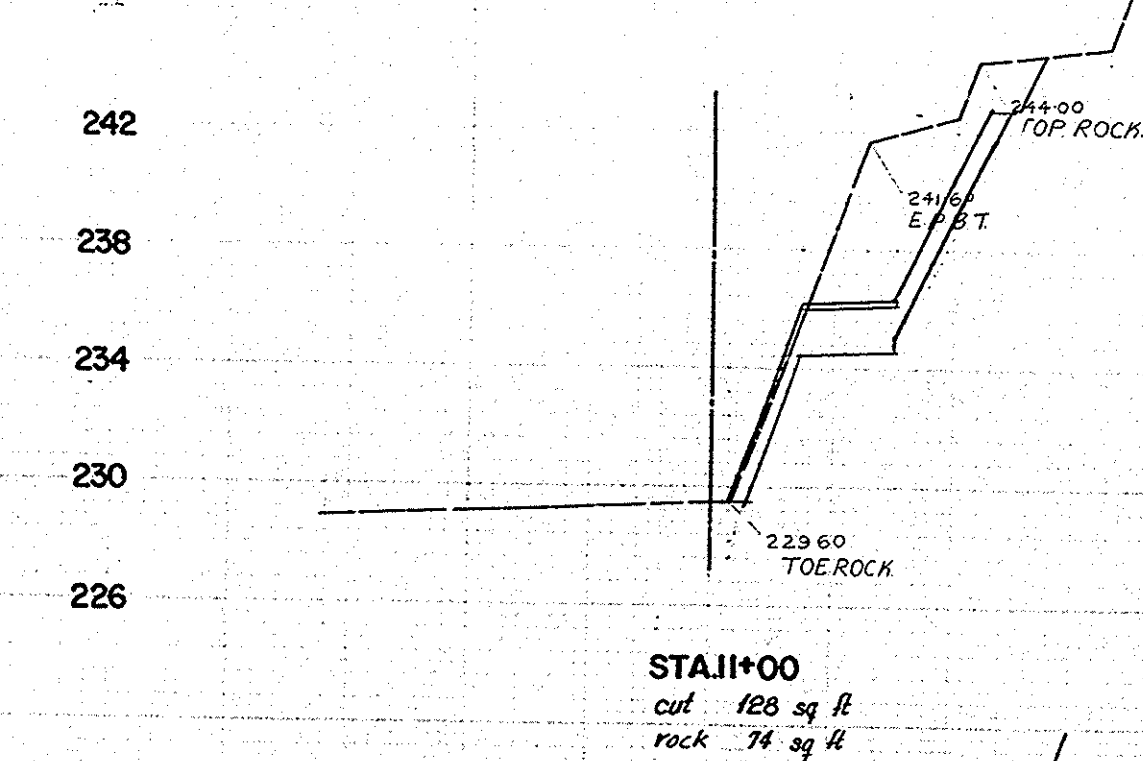
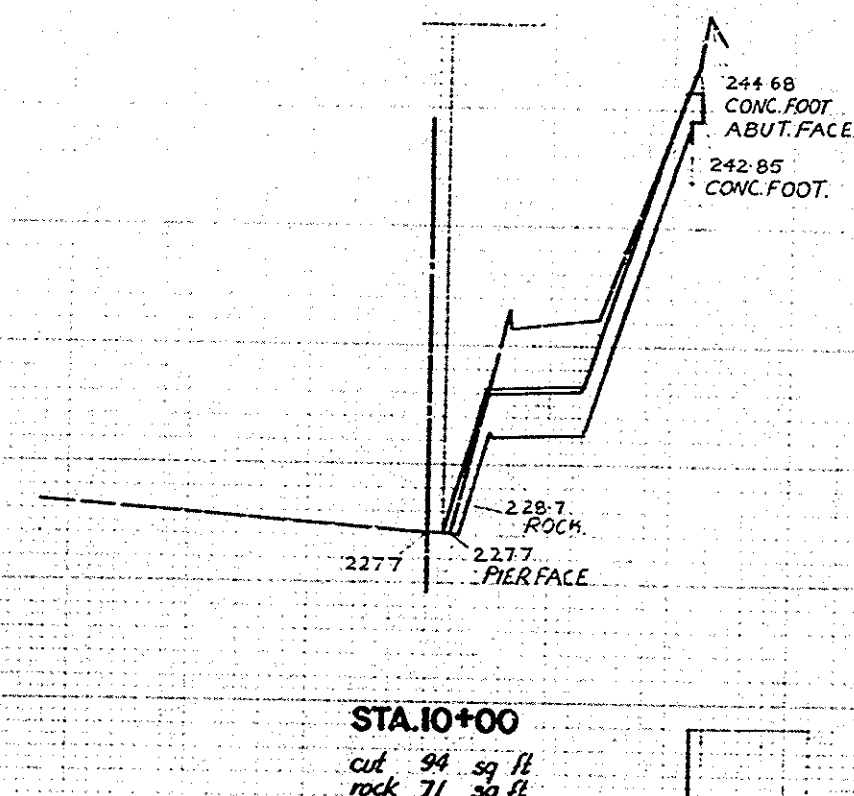


TUSTIN AVE. BRIDGE
X-SECTIONS
ALONG P-LINE #1
SCALE: HORZ. 1"=20'
VERT. 1"=4'-0"

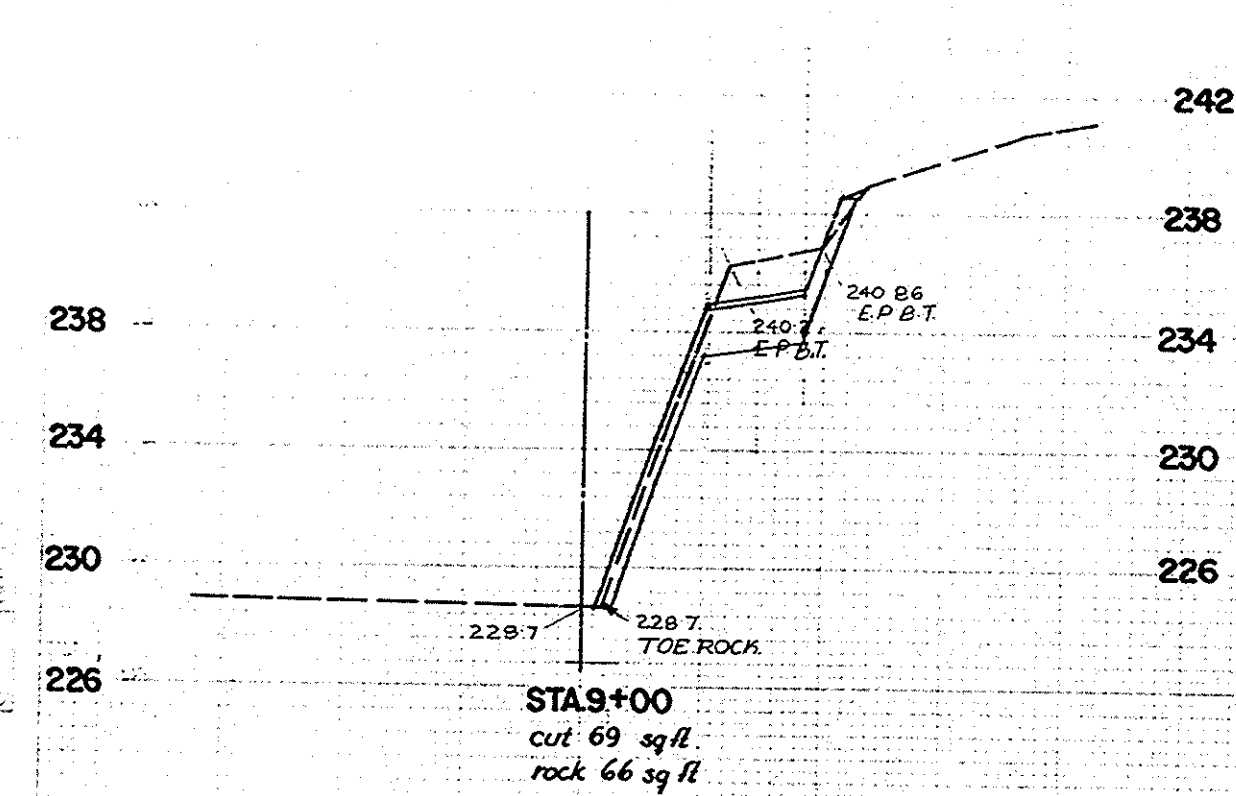

Dr. 8 12952
Street Improvements
Sheet 30 of 35
Red 24:1
Vellum

DR 8 12952