


TUSTIN AVE. BRIDGE
 X-SECTIONS
 ALONG P-LINE #3
 SCALE: HORZ. 1"=20'
 VERT. 1"=4'-0"

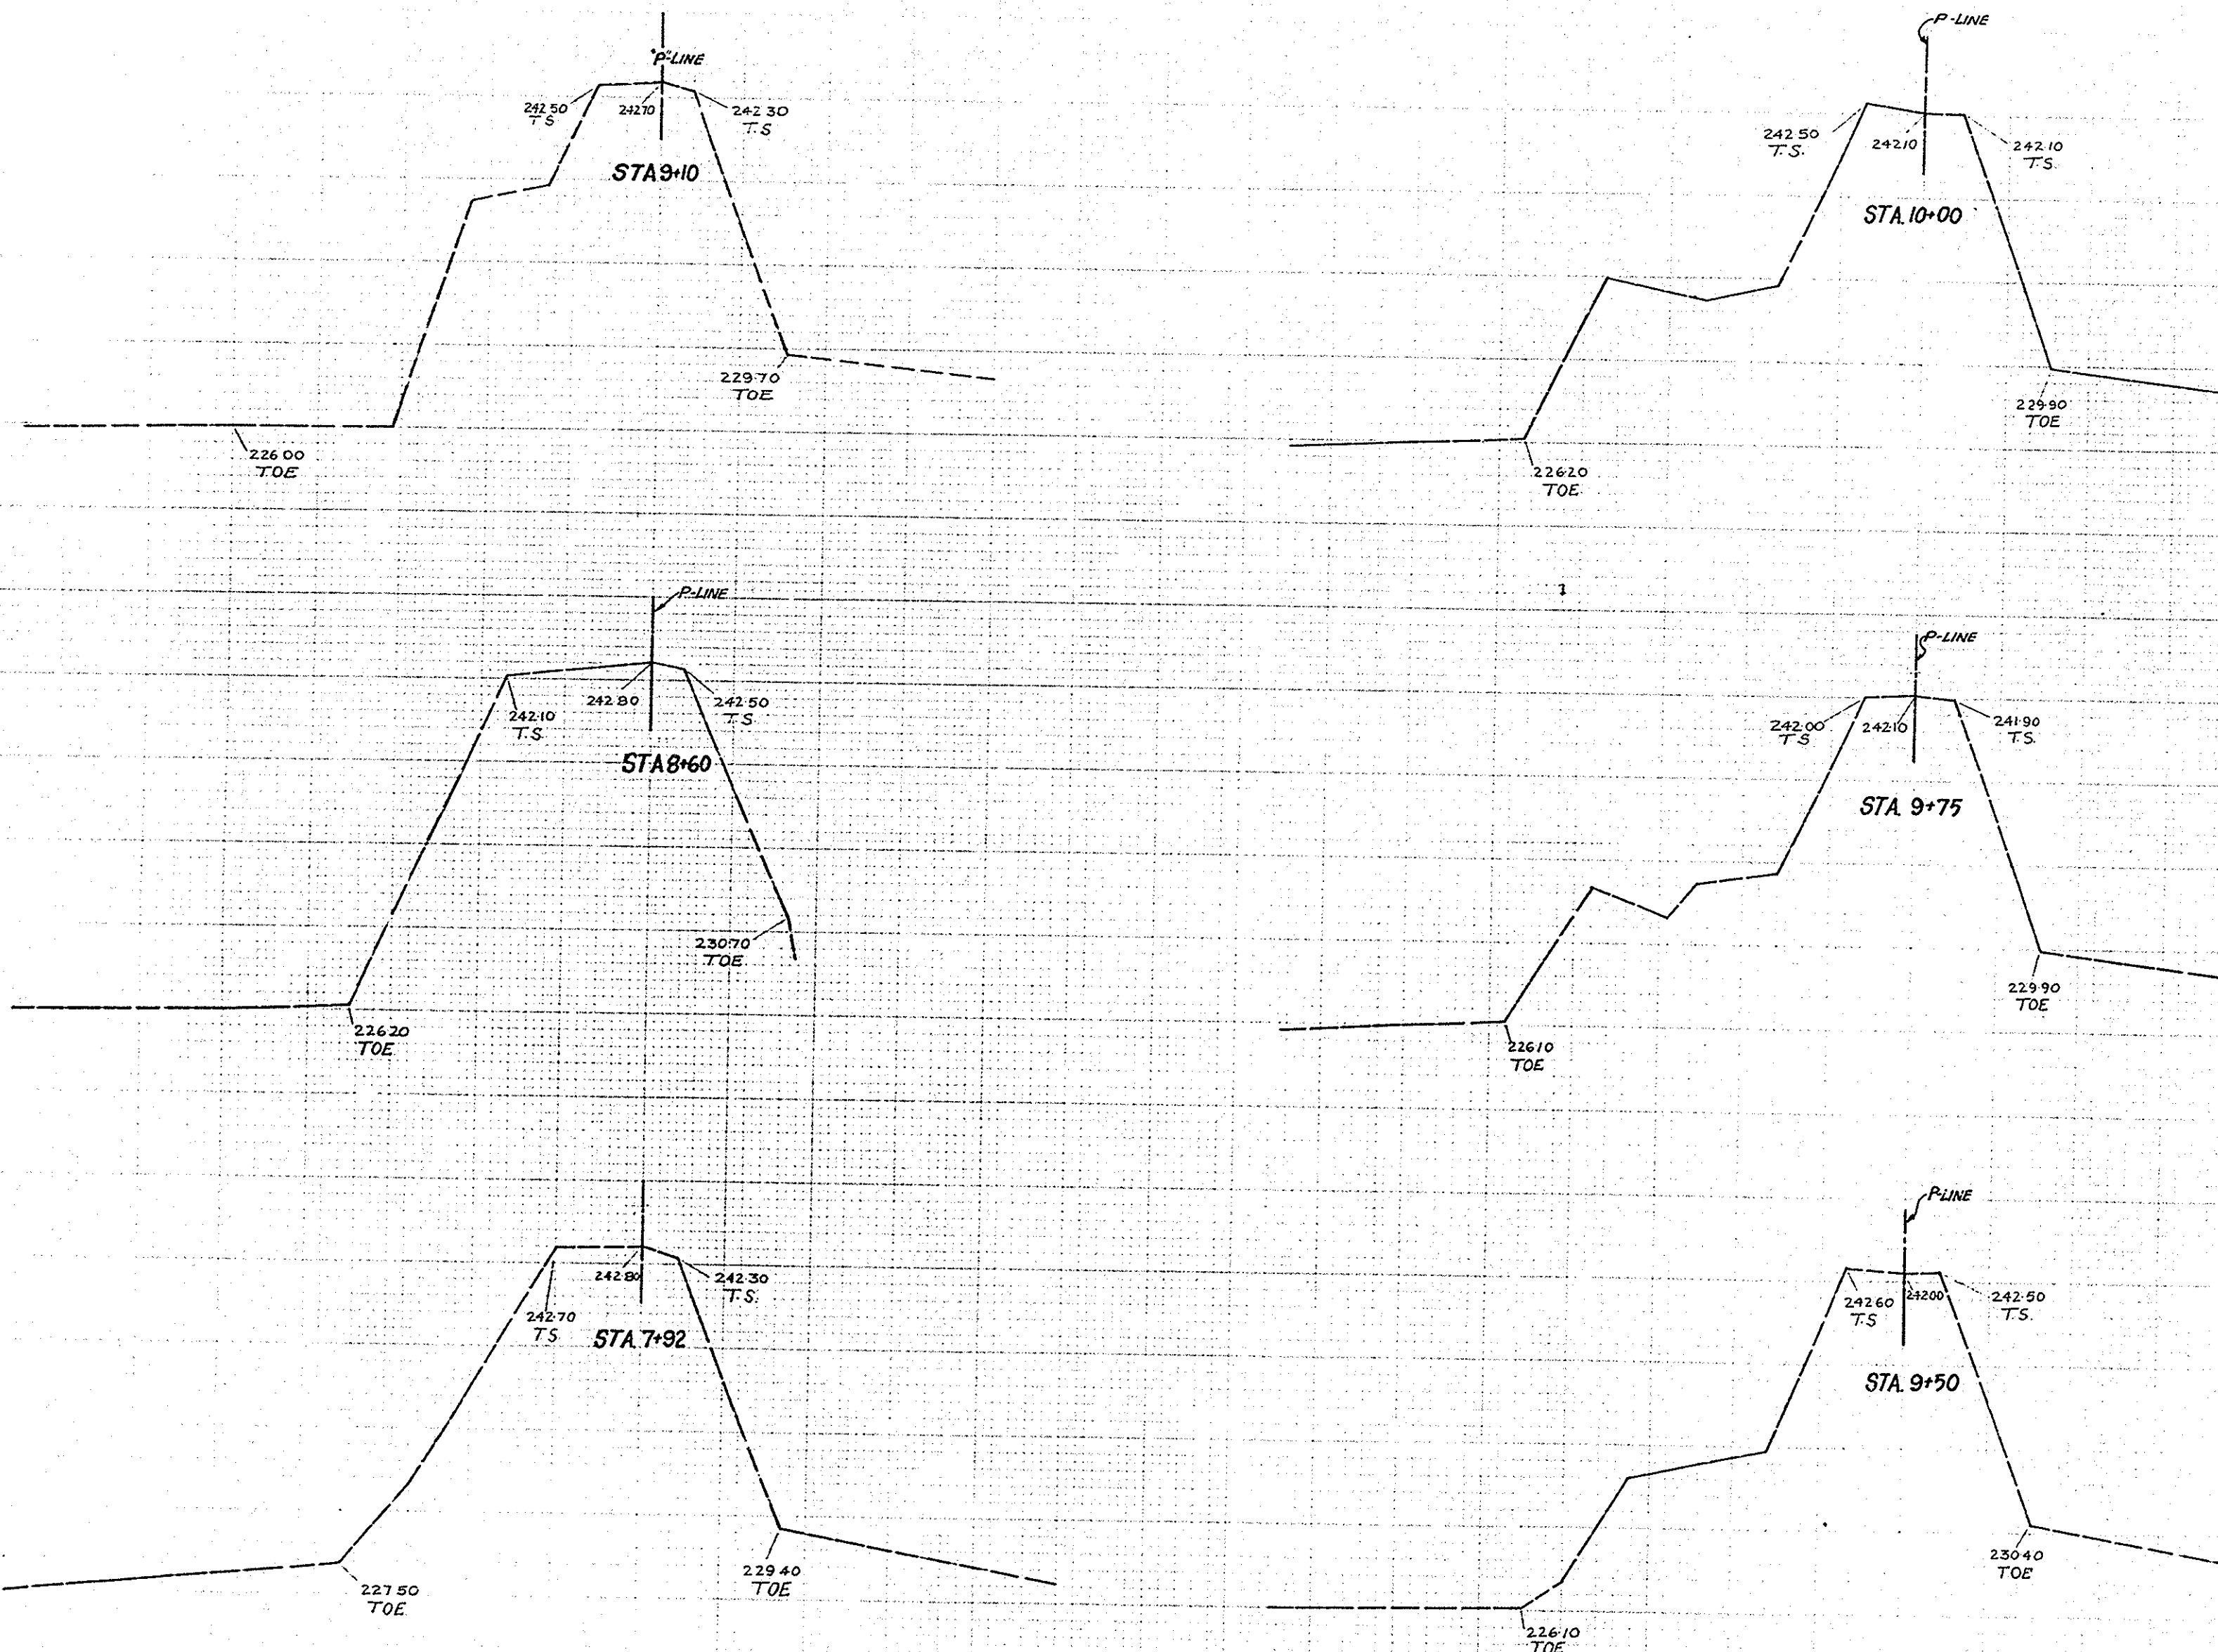

Dr. 8 12952
 Street Improvements
 Sheet 32 of 35
 Red 24.1
 Vellum

De 8 12952