

TUSTIN AVE. BRIDGE
 X-SECTIONS ALONG
 P-LINE #4 SH. 33/35
 Scale
 HOR: 1"=20'-0"
 VERT: 1"=4'-0"

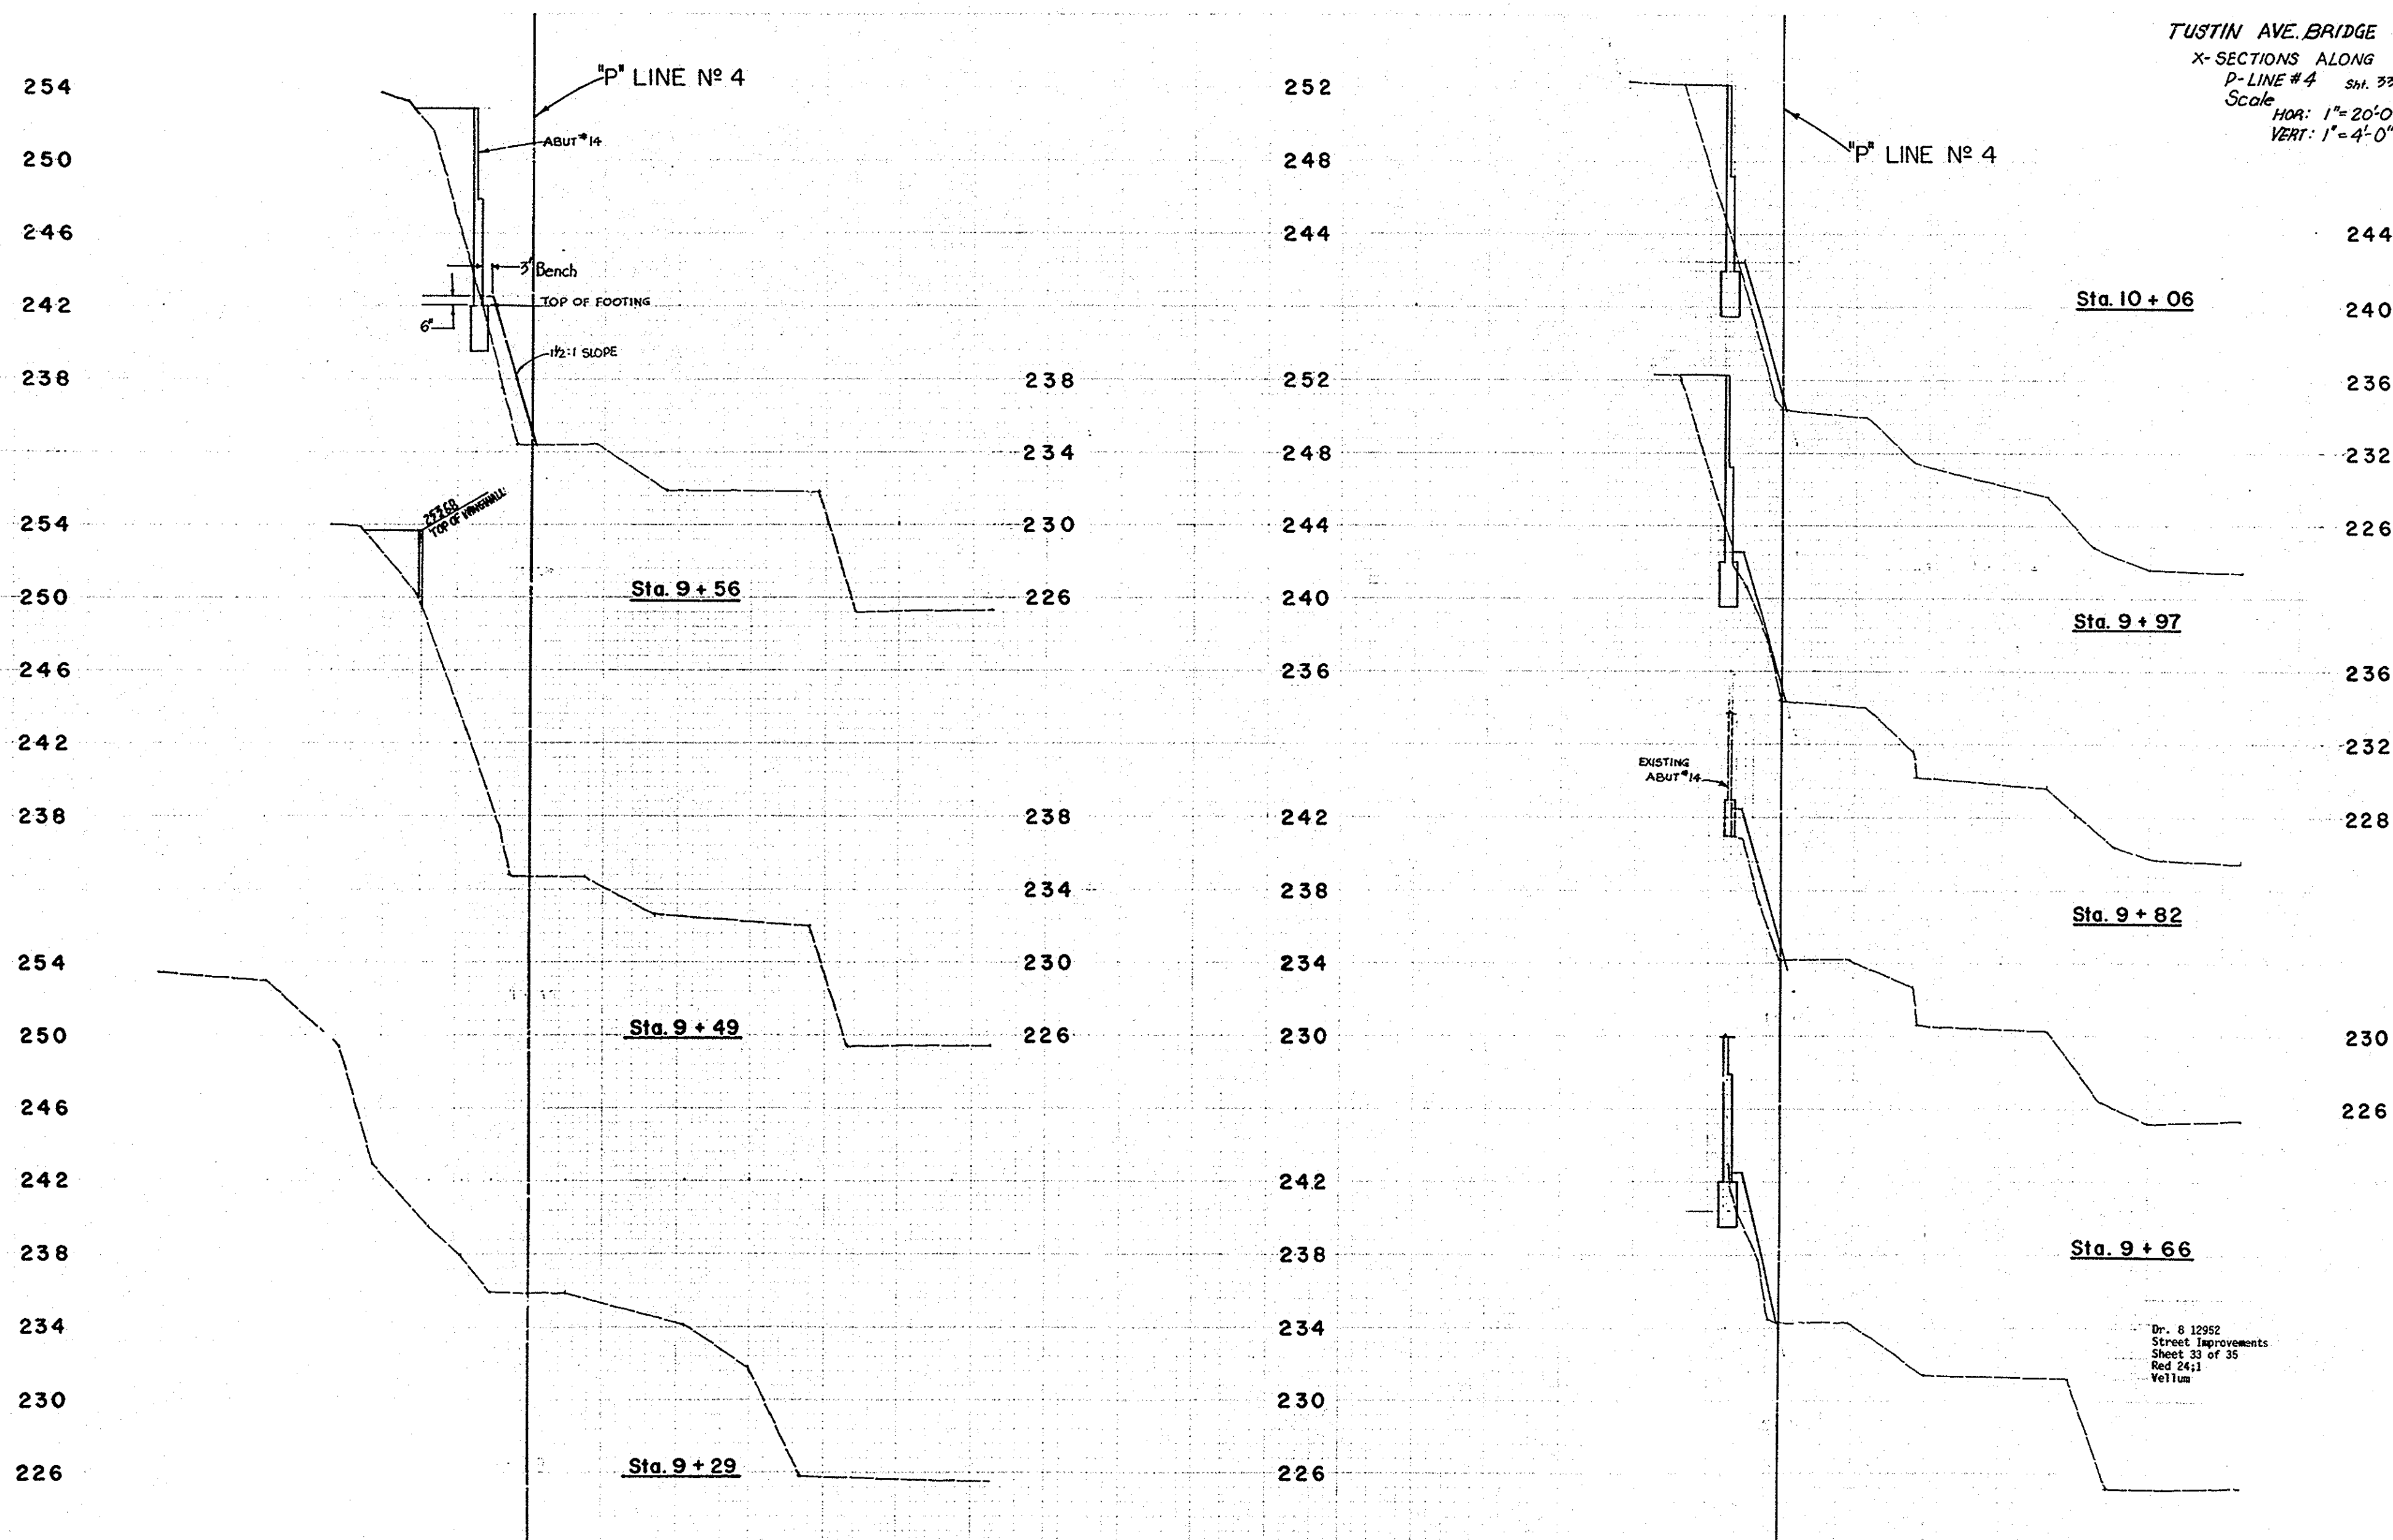


PLATE 2 CROSS SECTION
 REPAIR & IMPROVEMENT
 48 7054 PAVEN CO.

De. 8 12952