


TUSTIN AVE. BRIDGE
X- SECTIONS ALONG
P-LINE # 4 *Sh. 34/35*
Scale HOR: 1" = 20'-0"
 VERT: 1" = 4'-0"

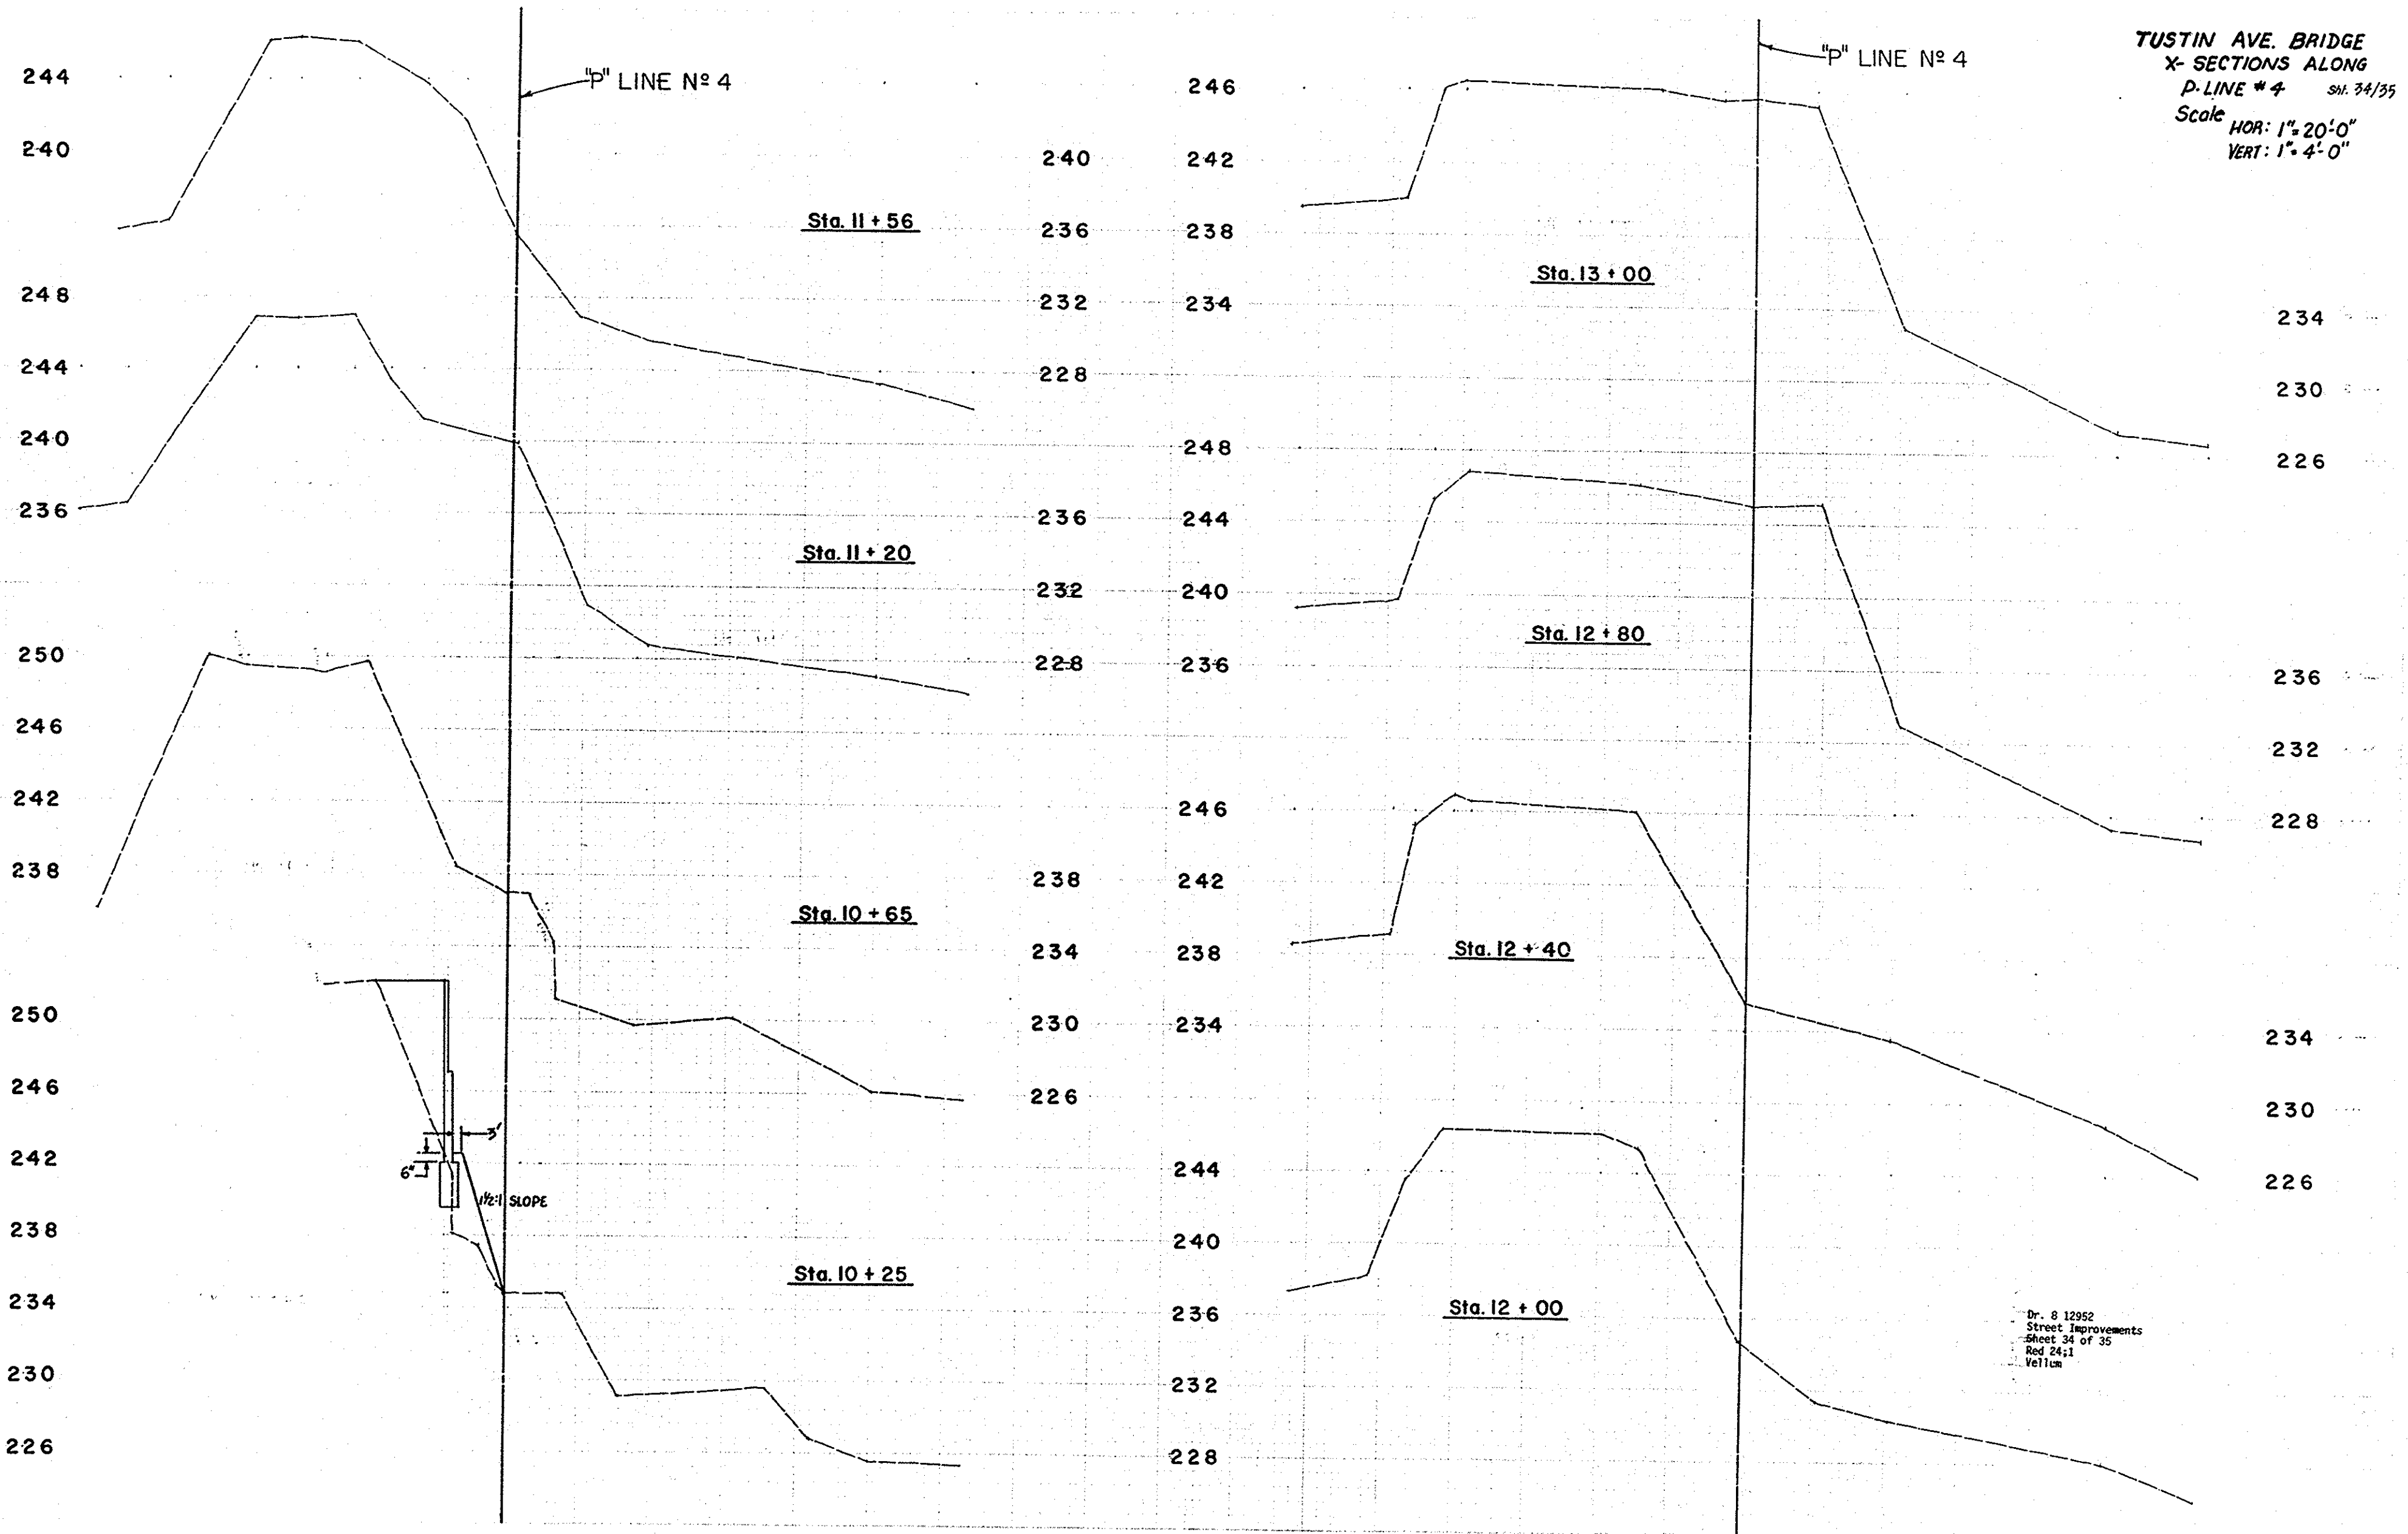

Dr. 8 12952
 Street Improvements
 Sheet 34 of 35
 Red 24:1
 Vellum

Dr 8 12952