

ORANGE COUNTY ROAD DEPT.

STATE OF CALIFORNIA


PROJECT AREA

PLANS FOR CONSTRUCTION ON

(OLD) $\Rightarrow$ **LINDA VISTA AVENUE**
(ROSE DRIVE)
MIRALOMA AVENUE TO ORANGETHORPE AVENUE
TOTAL LENGTH 0.39 MILES

**Now : TUSTIN AVE. BR.
ACROSS ATWOOD CH.
55C-114**

- 1 TITLE SHEET
- 2 TYPICAL SECTIONS & MISC. DETAILS
- 3-4 PLAN AND PROFILES
- 5-6 INTERSECTION DETAILS
- 7 BRIDGE PLAN & PROFILES
- 8 BRIDGE STRUCTURAL DETAILS
- 9-10 PILE STD. DETAILS & BORING LOG
- 11 GUARD RAIL & STRUCT. EXCAVATION-BACKFILL DETAILS
- 12 FENCE DETAILS
- 13-16 CROSS-SECTIONS
- 17-24 TRAFFIC SIGNAL & LIGHTING

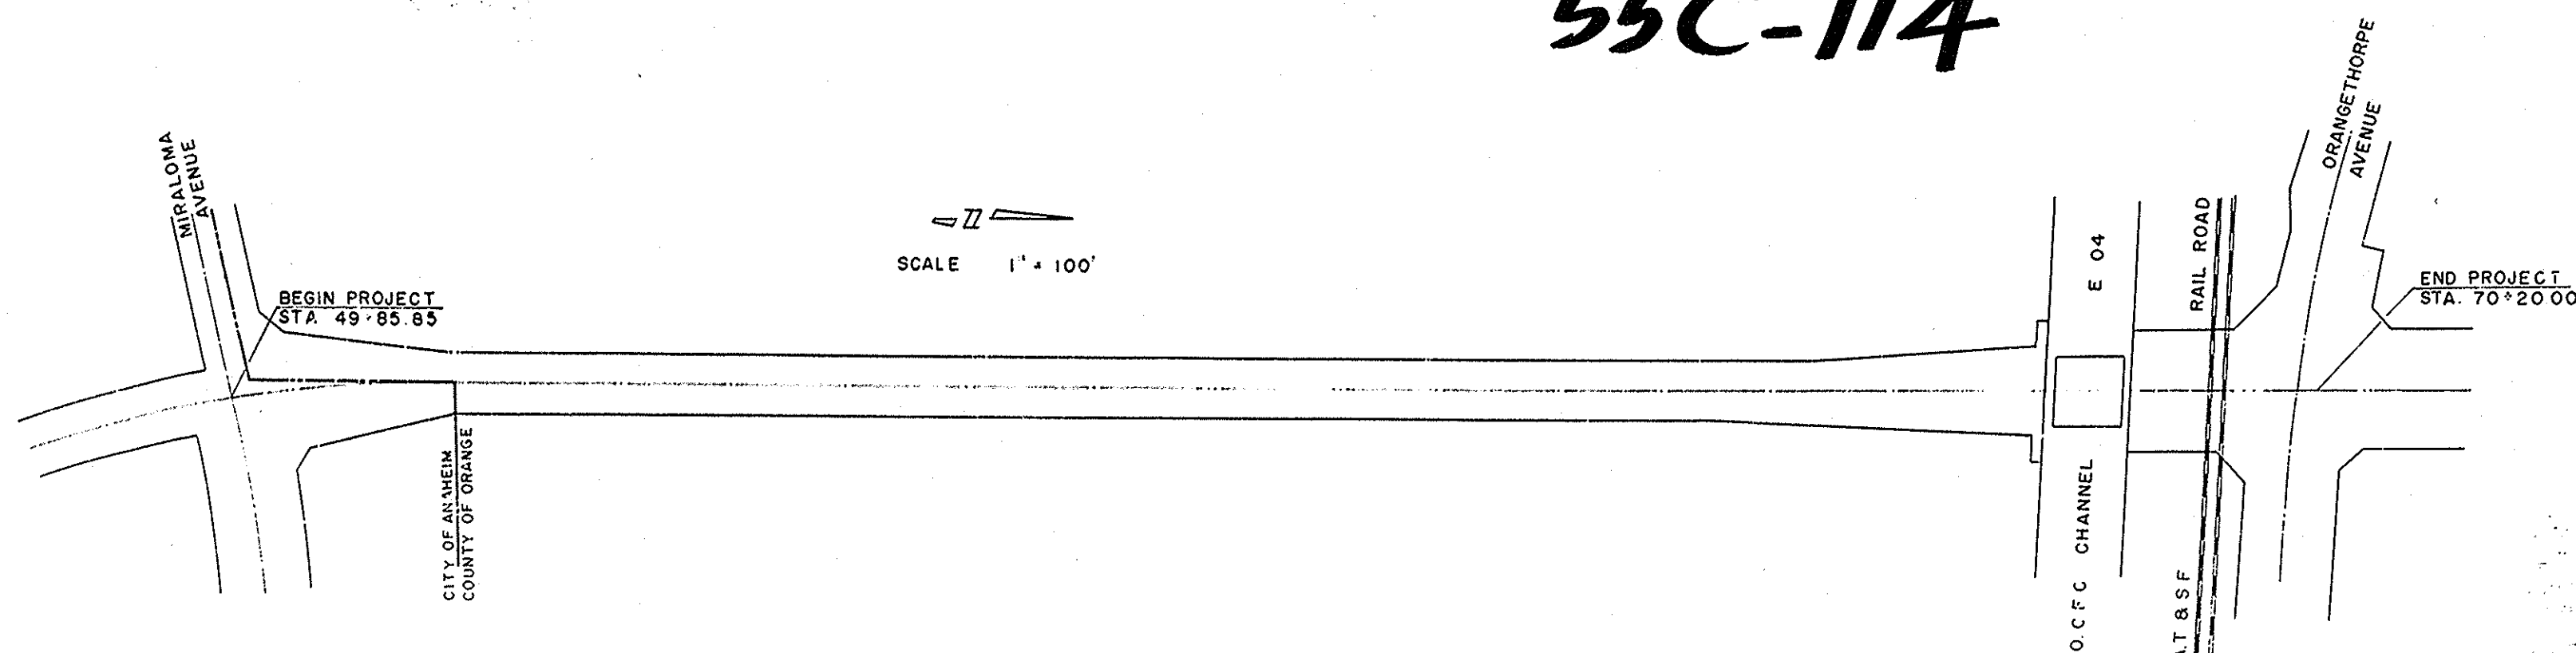

AS BUILT

[Faint, illegible text, likely a title block or project description]

PREPARED UNDER THE SUPERVISION OF
DATE
CLIFFORD C. HOOD RCE 12489

[Handwritten signature] 12-24-68

Microfilm @ Central Files # 982500 1968
FILING @ Name: TUSTIN AVE. BR.
@ ATWOOD CHANNEL
S-258, 55C-114
Thomas: 739-H7

1/24