


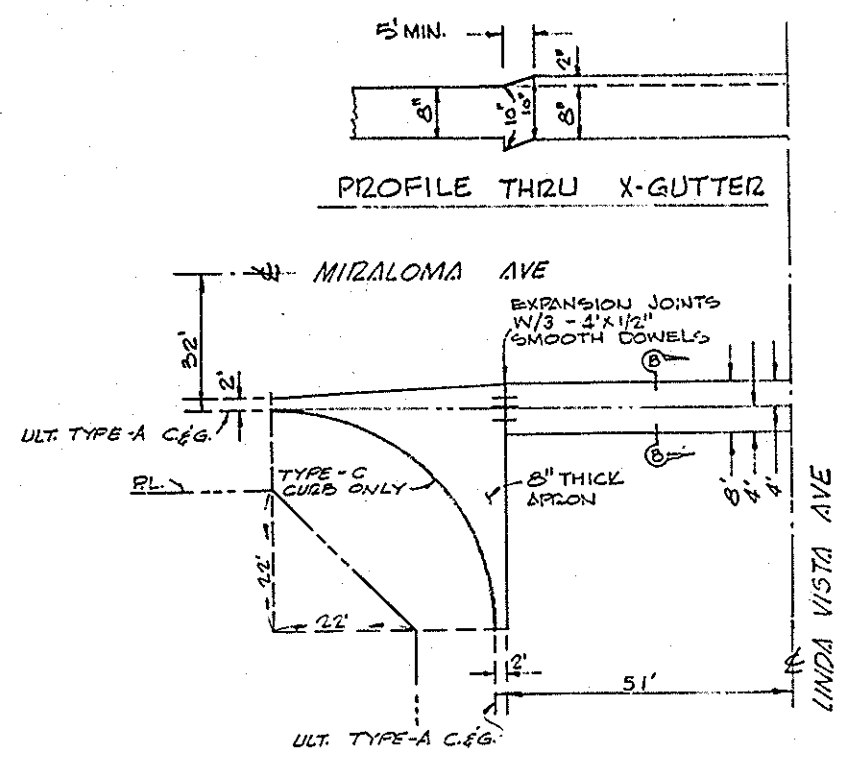
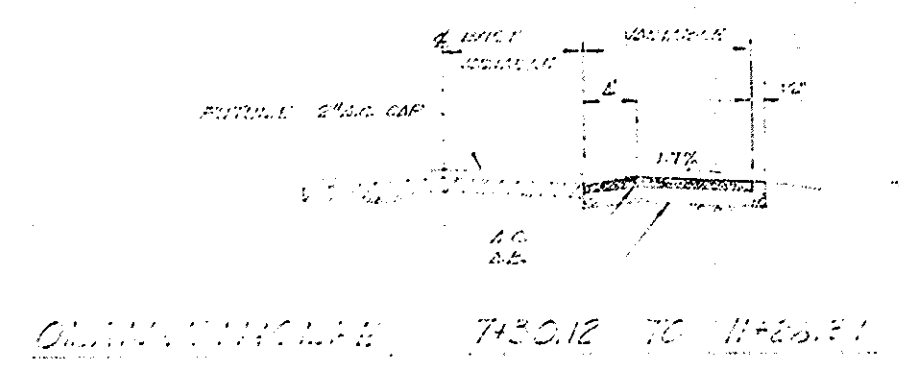
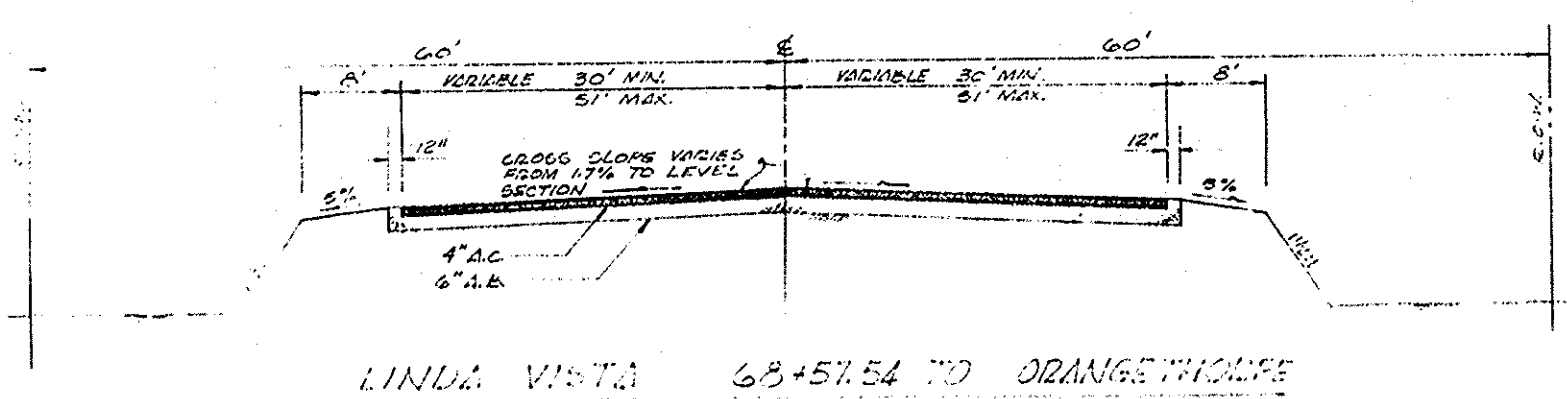
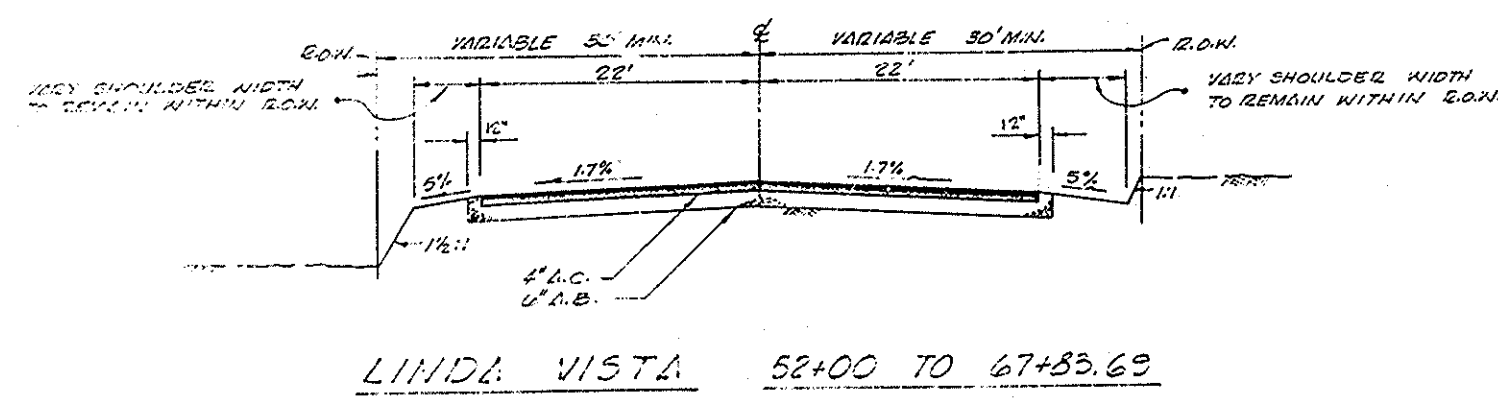


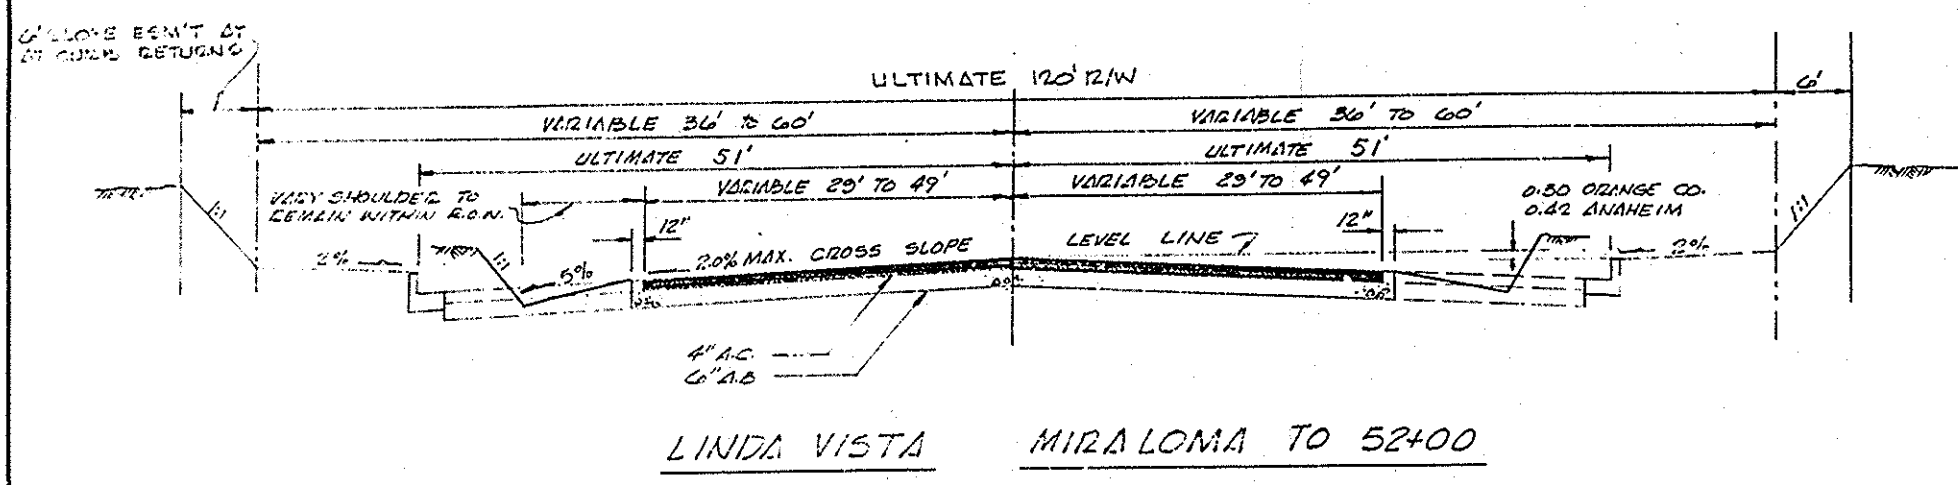


STANDARD STREET INTERSECTION
ANALYSIS STD

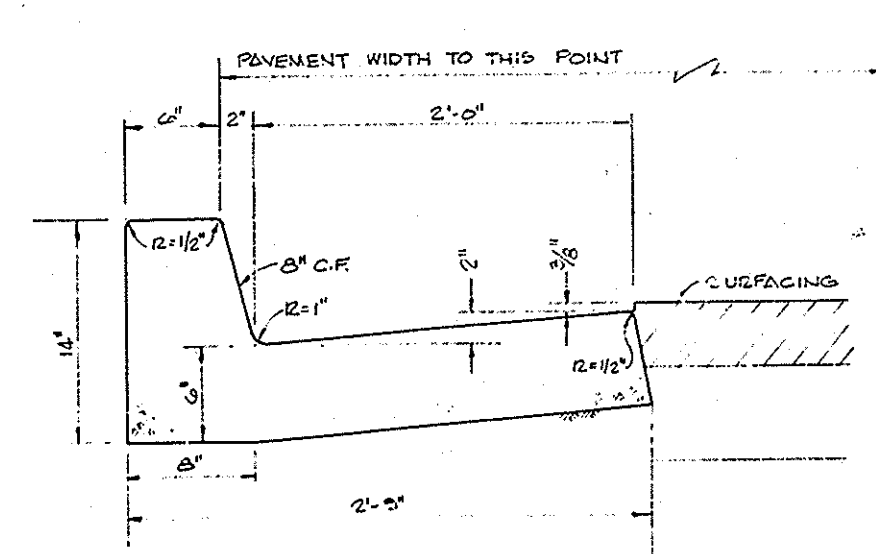

TYPE A-2 CURB & GUTTER
ORANGE CO. ROAD DEPT.

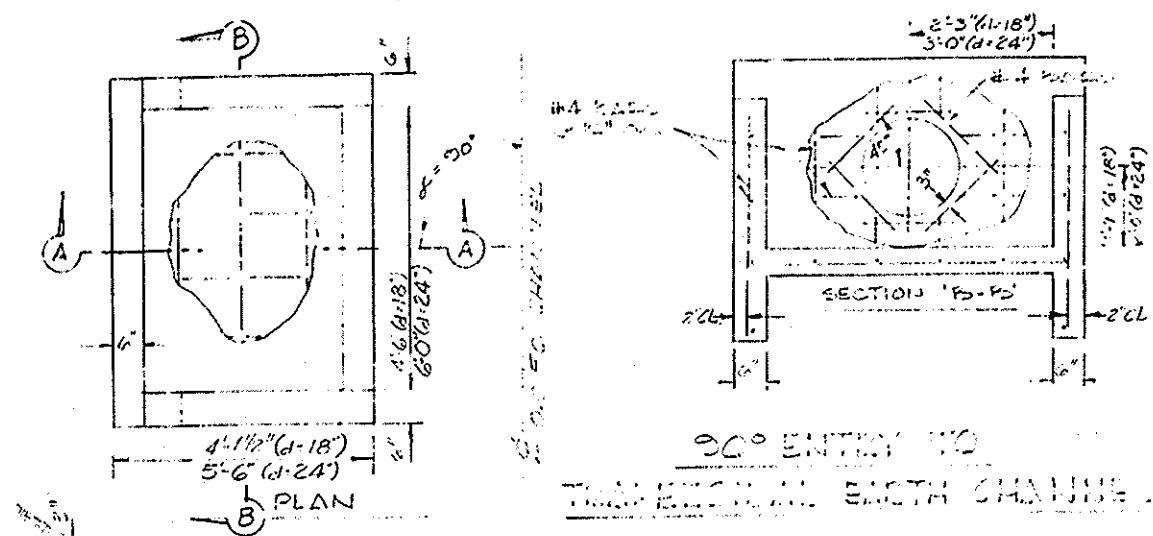


90° ENTRY TO
TRANSVERSE SLOPE CHANGE


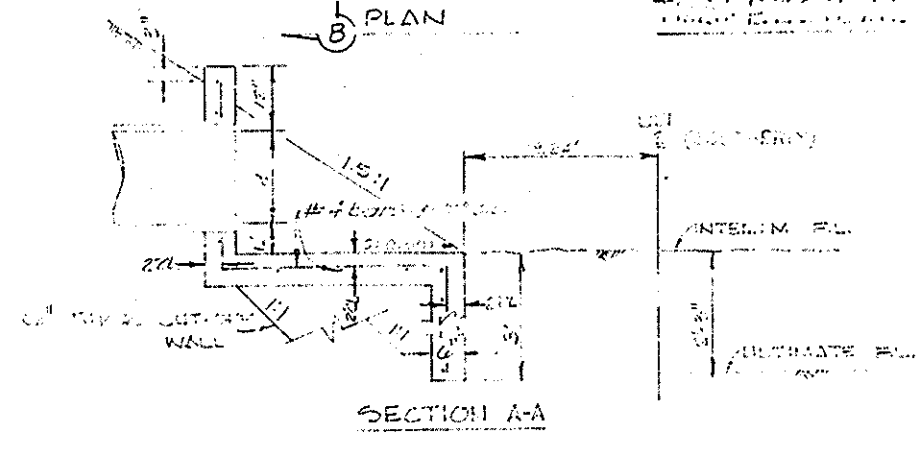


Linda Vista Avenue


ORANGE COUNTY HIGHWAY DEPARTMENT
JENNINGS HALDERMAN HOOD
COUNTY ENGINEER
CHIEF ENGINEER
7-28-67

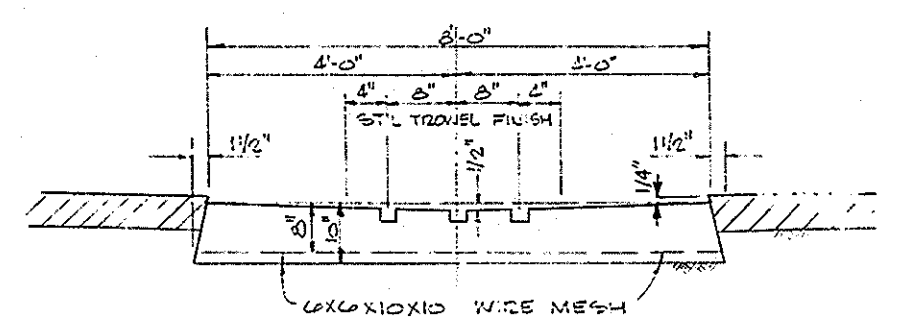


STANDARD GROOVED
CURB & GUTTER
ANALYSIS STD

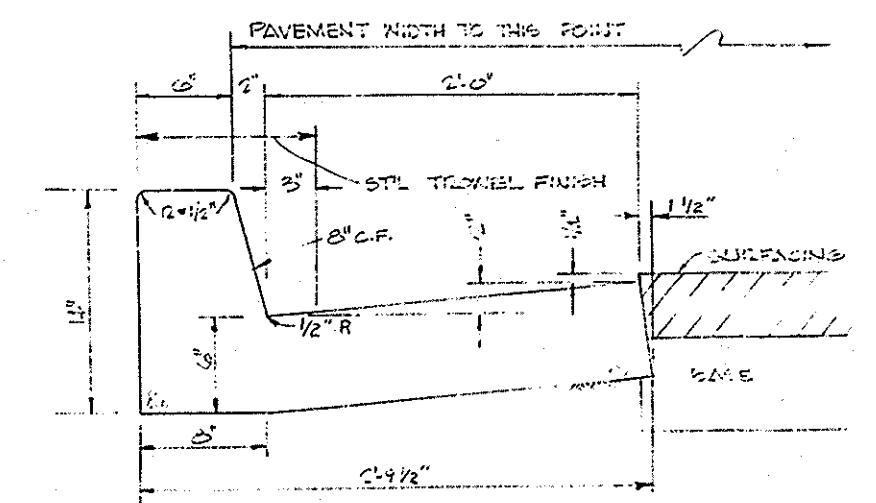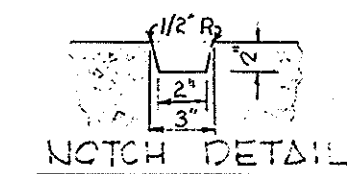

TYPE A-1 CURB & GUTTER
ANALYSIS STD

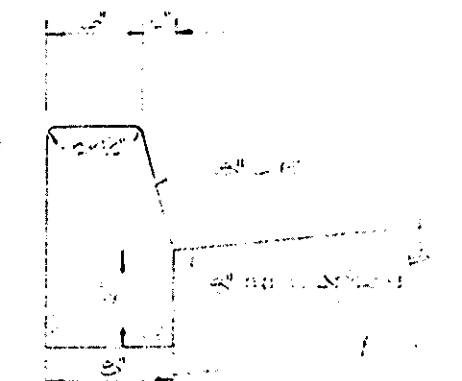

TYPE A-1 CURB & GUTTER
ANALYSIS STD

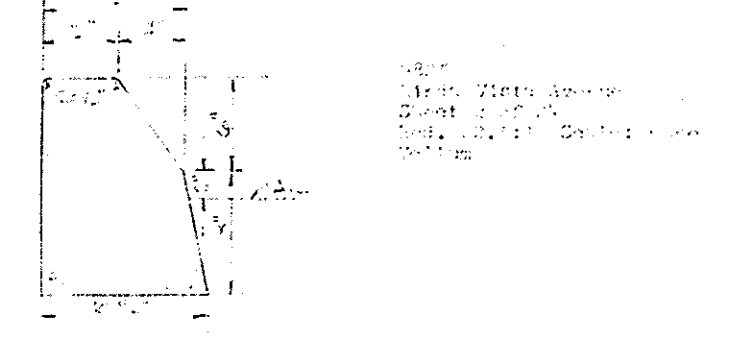

TYPE A-1 CURB & GUTTER
ANALYSIS STD

11/11/98-55