



EXACT

STRAIGHT EDGE RULE SE-48


ORANGE COUNTY HIGHWAY DEPARTMENT	
PROJECT	JENNINGS-HALDERMAN HOOD
LIMITS	7445.00 TO 7445.00
SCALE	AS SHOWN SHEET 4 OF 5

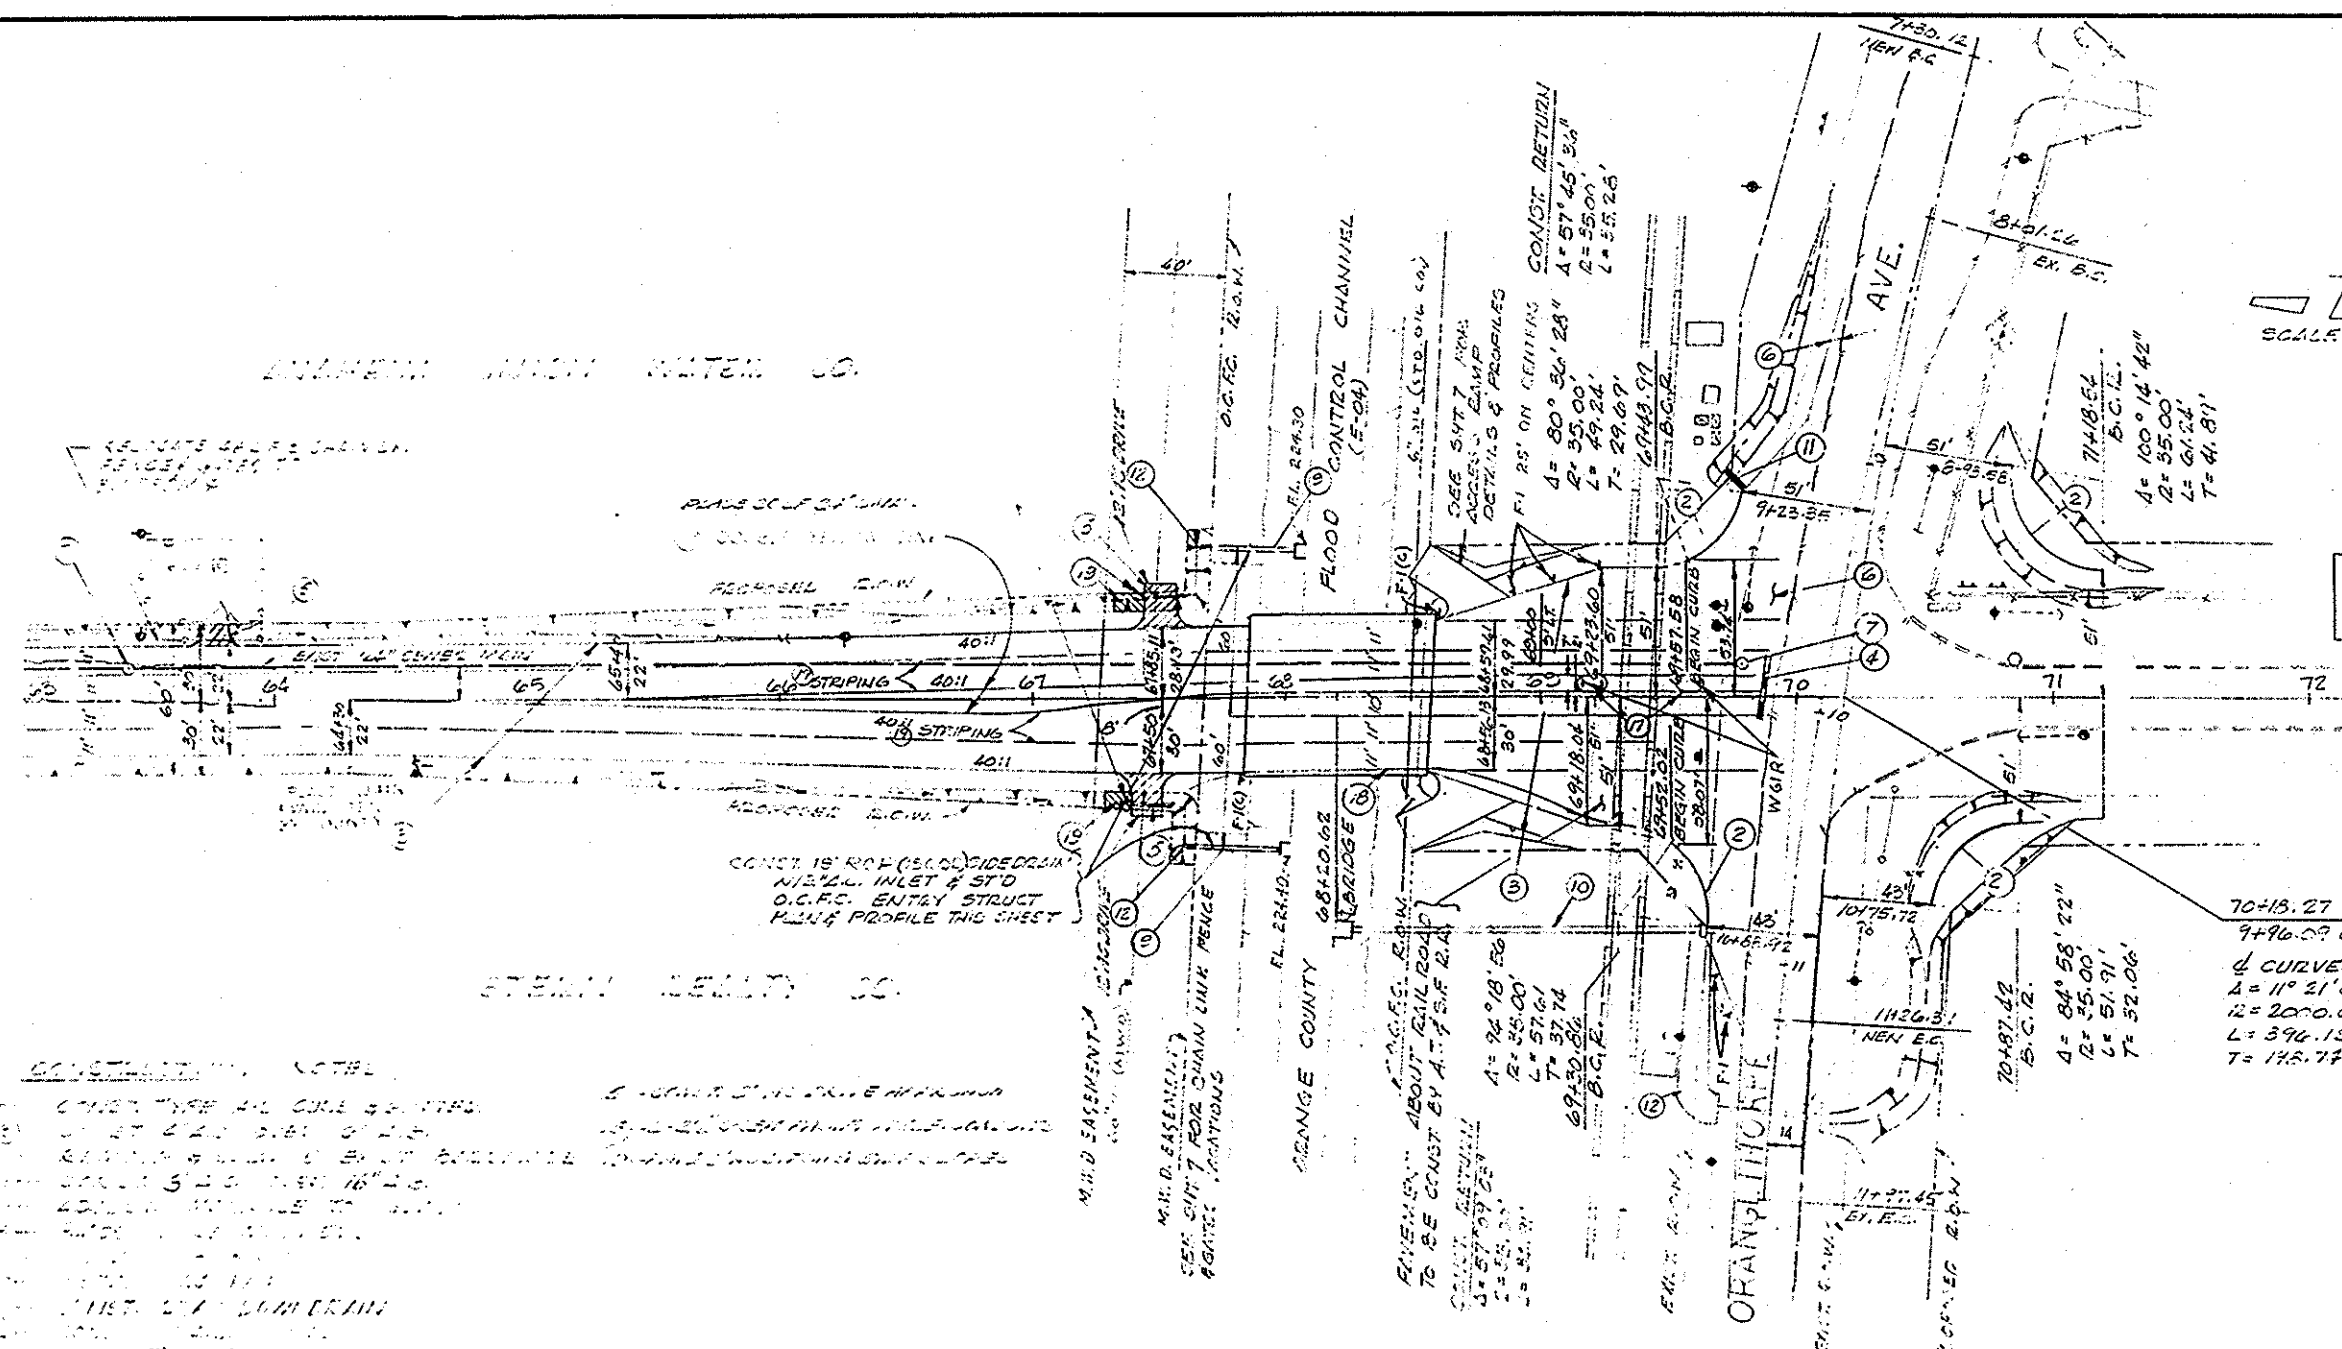

INTERSECTION DETAIL
SEE SHEET 6 OF 10

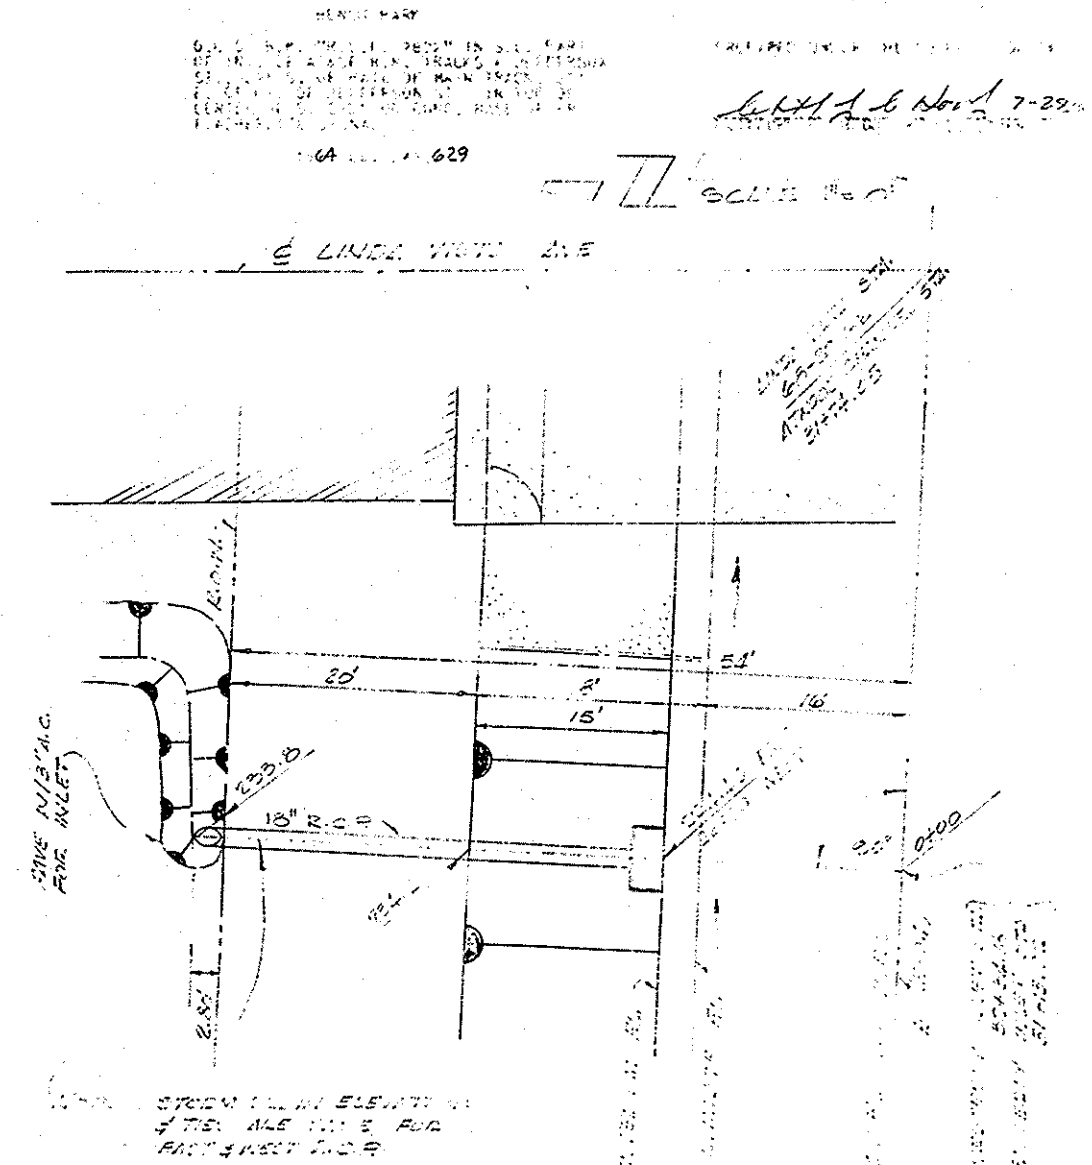

CONSTRUCTION NOTES
(1) EXISTING 24\"/>

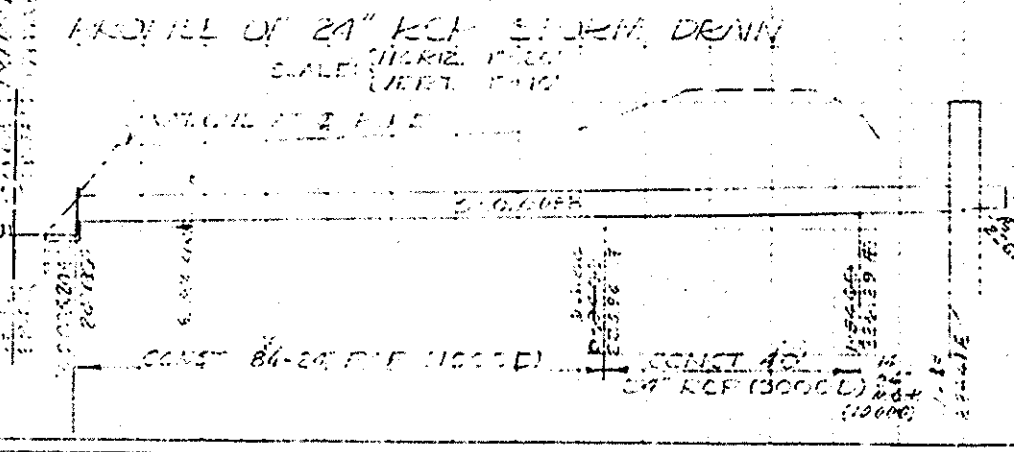

6\"/>

