


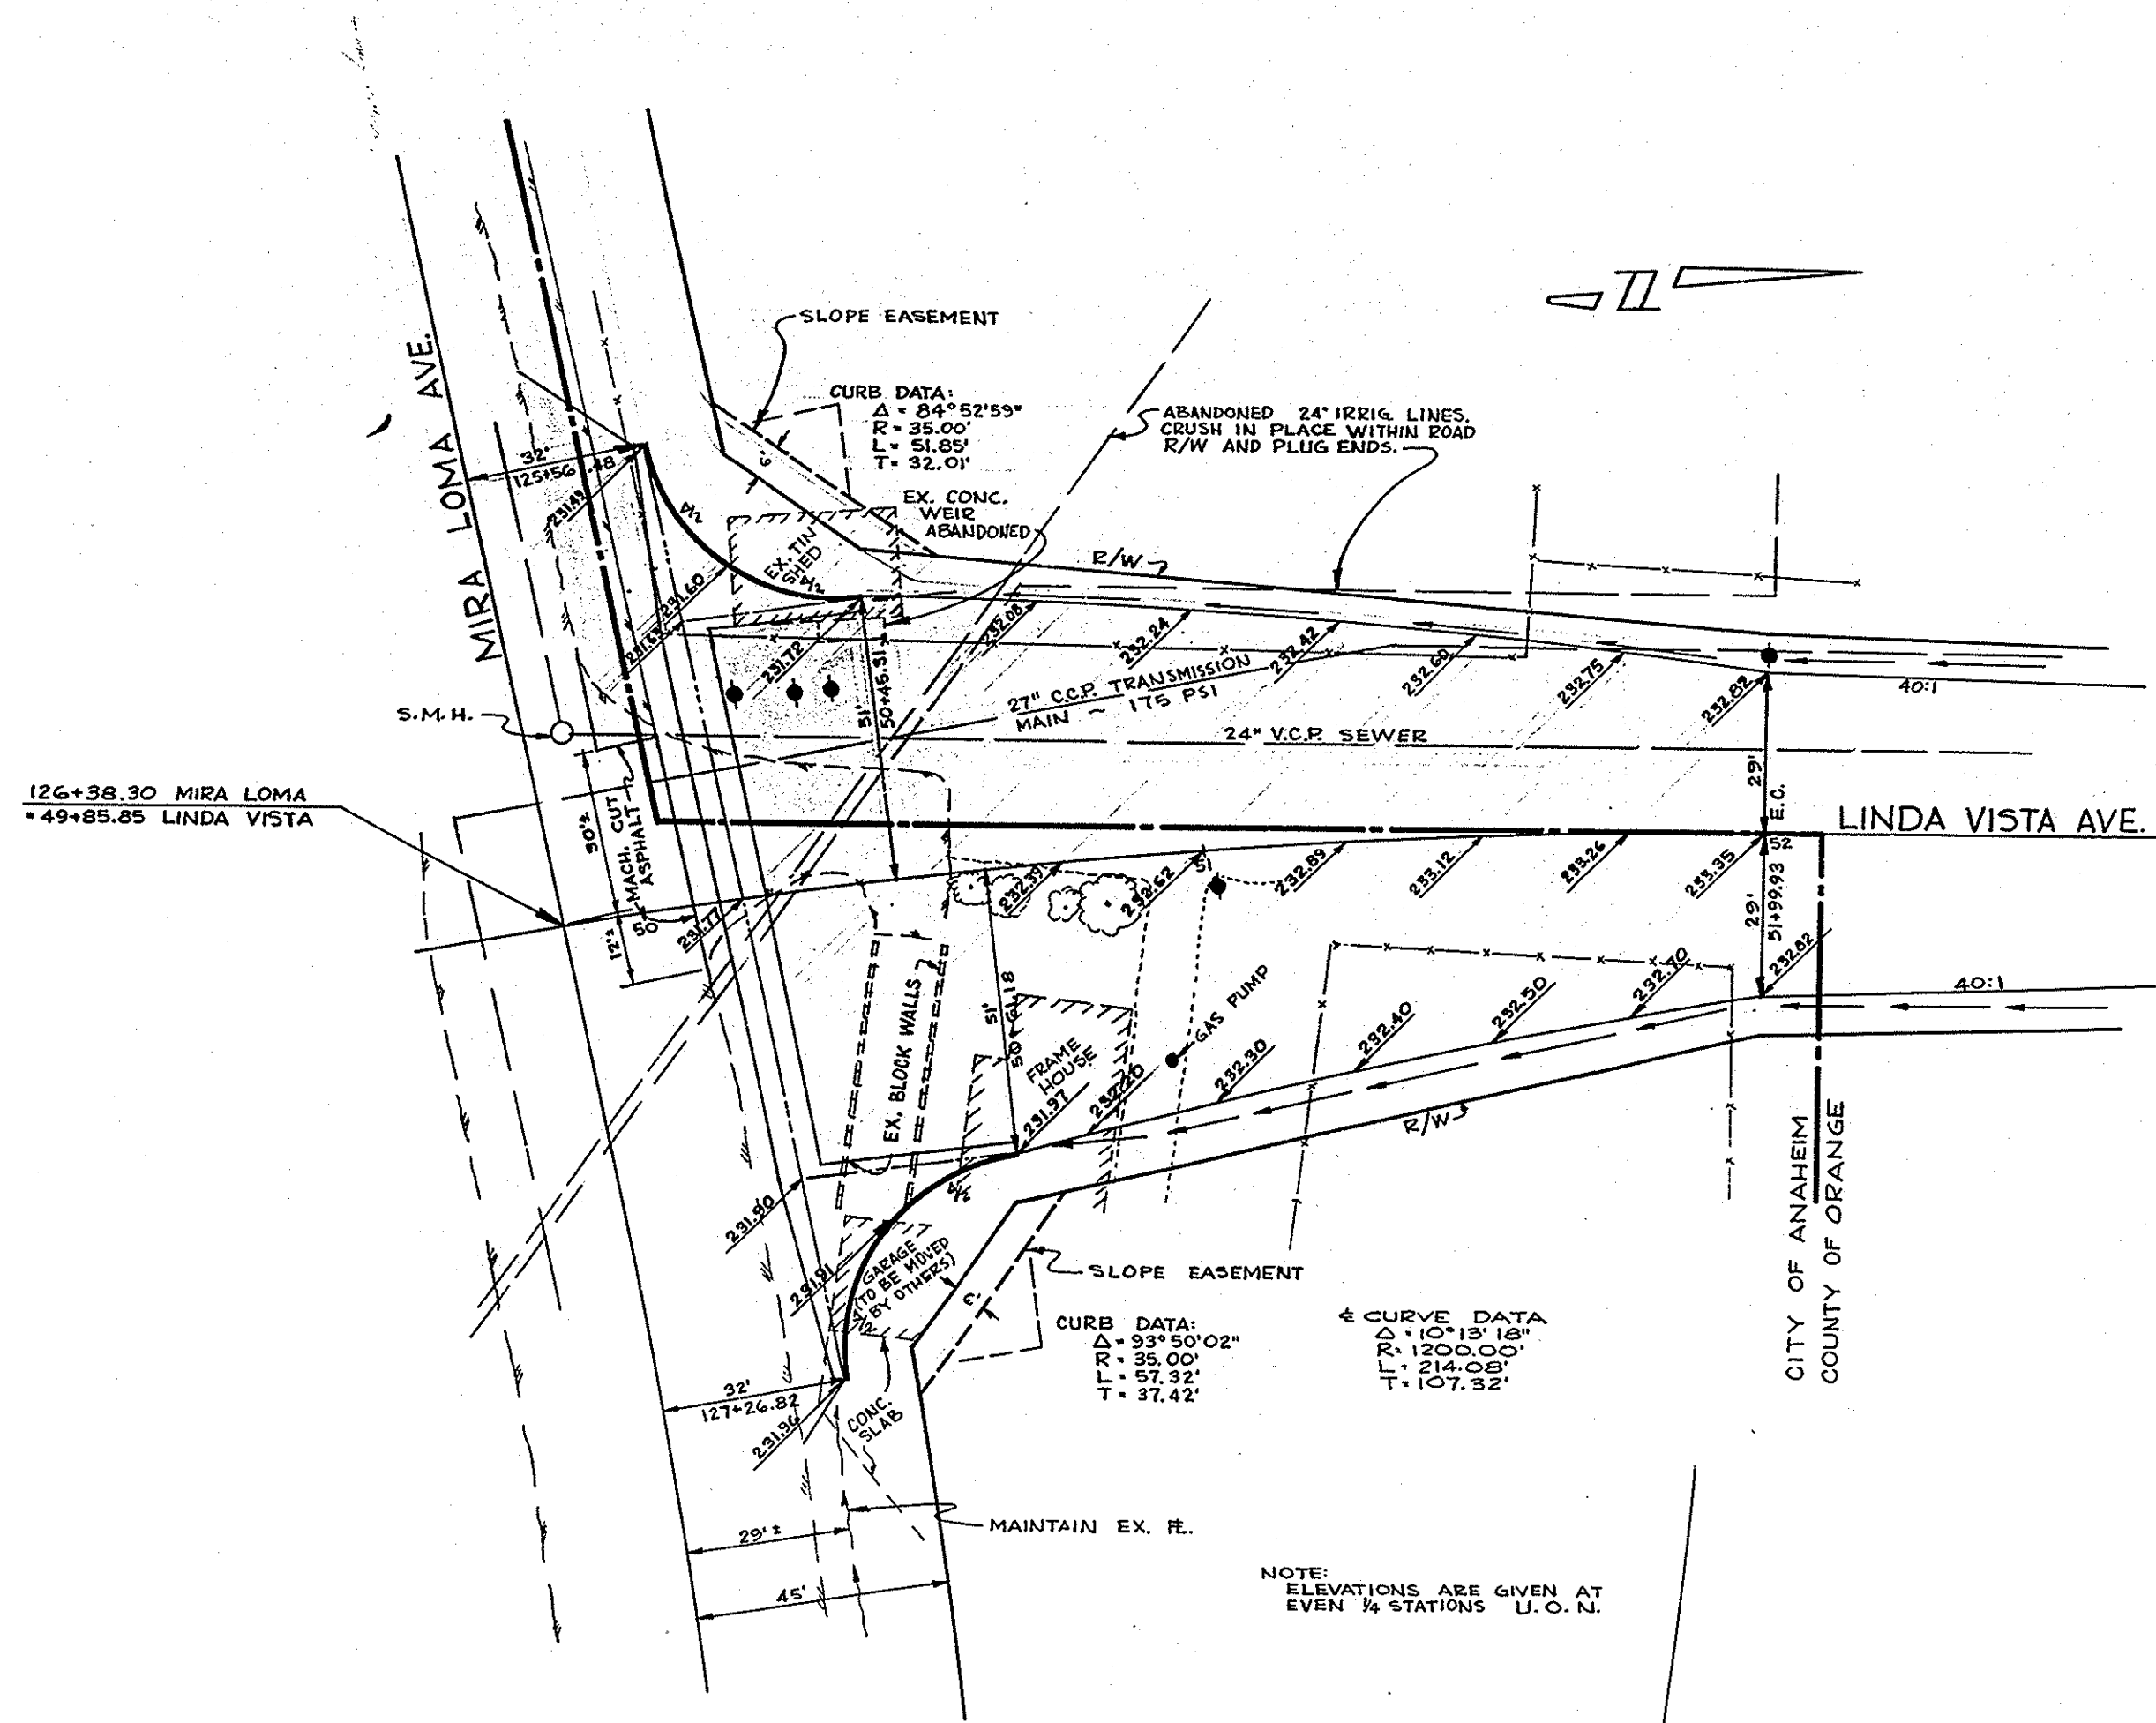

Linda Vista Avenue

12.11(9825)

5/24