


PREPARED UNDER THE SUPERVISION OF :
Clifford C. Hood 7/28/67
 CLIFFORD C. HOOD R.C.F. 12489

NOTE:
FINISH GRADE ELEVATIONS ARE
GIVEN AT EVEN 1/4 STATIONS
UNLESS OTHERWISE NOTED.

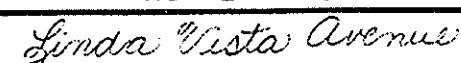

Ar. 11 (9825)

6/24