


EXACT

STRAIGHT EDGE RULE SE-48

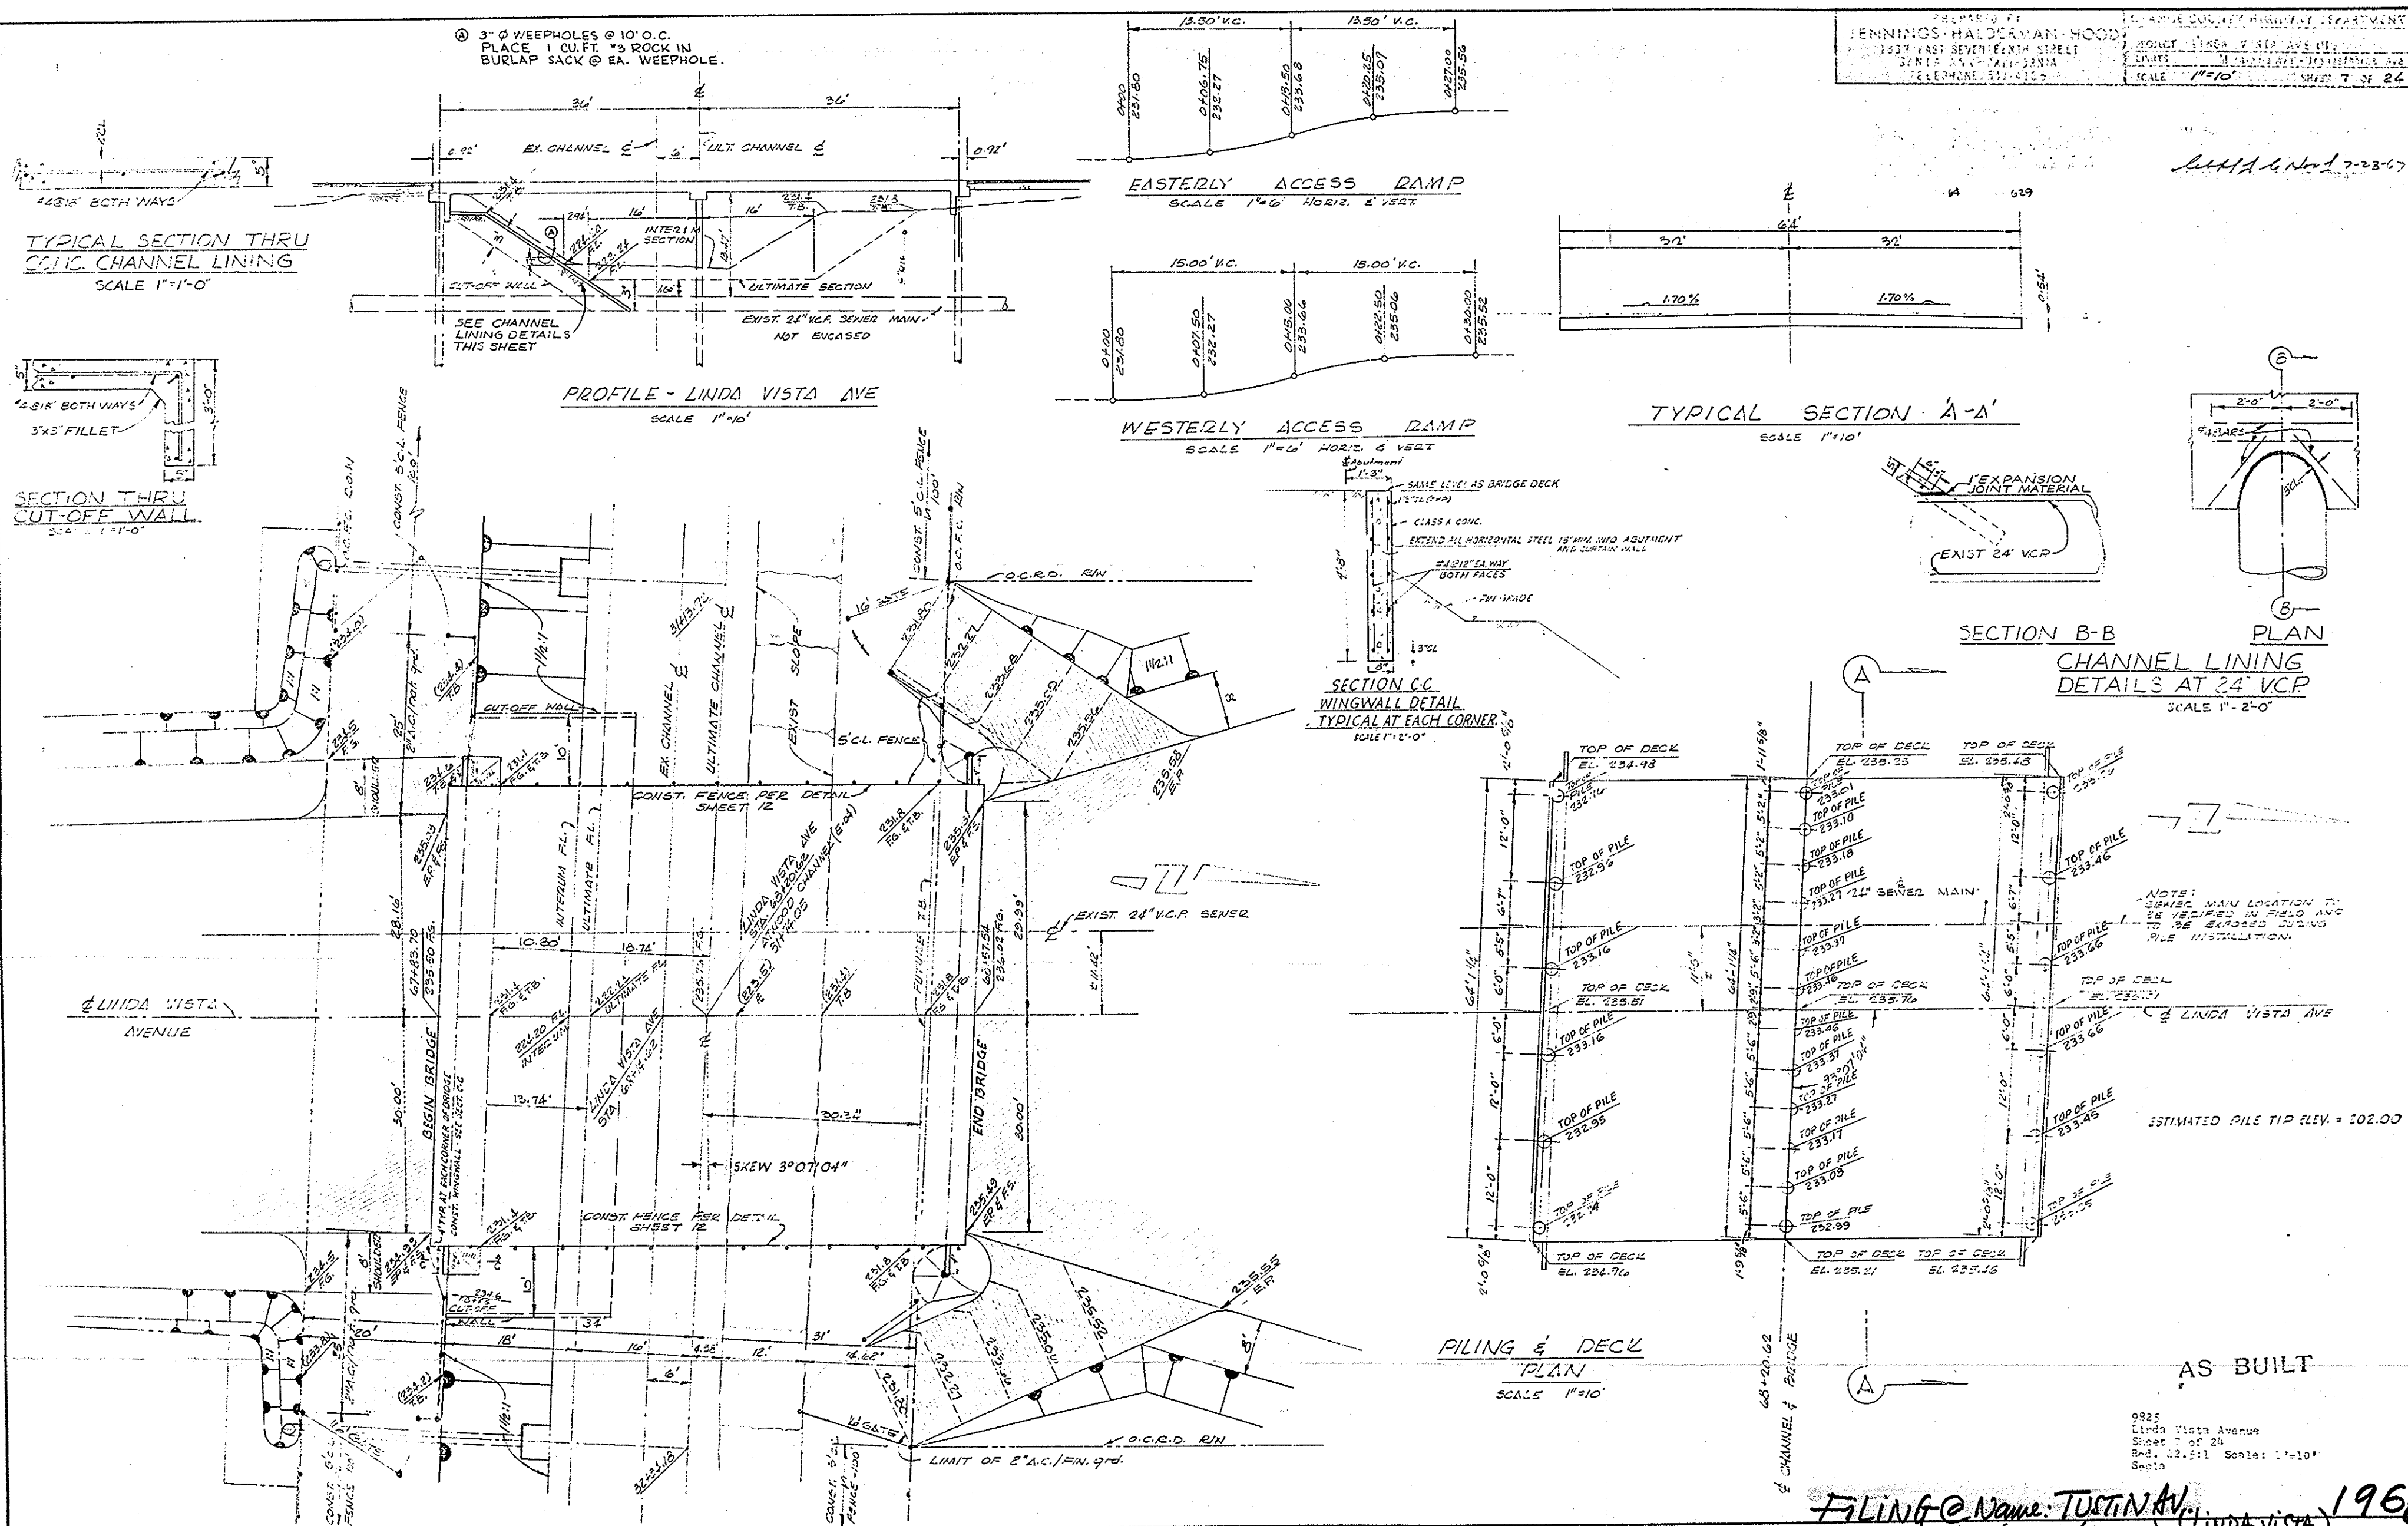

Linda Vista Avenue

1968
Name: TUSTIN AV.
R.D. 11 (9825) LINDA VISTA
ROSE DR. (TUSTIN AV.)
200' S/O Orange - Thorpe Av.
C. ATWOOD CHANNEL
S-258
55C-114
THOS. Map: 739-H7
SHT. 7/24