




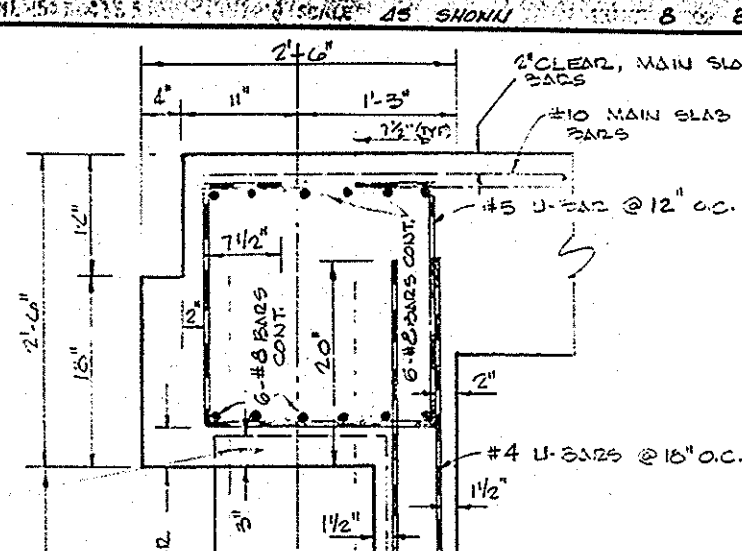

SCALE 1" = 1'-0"

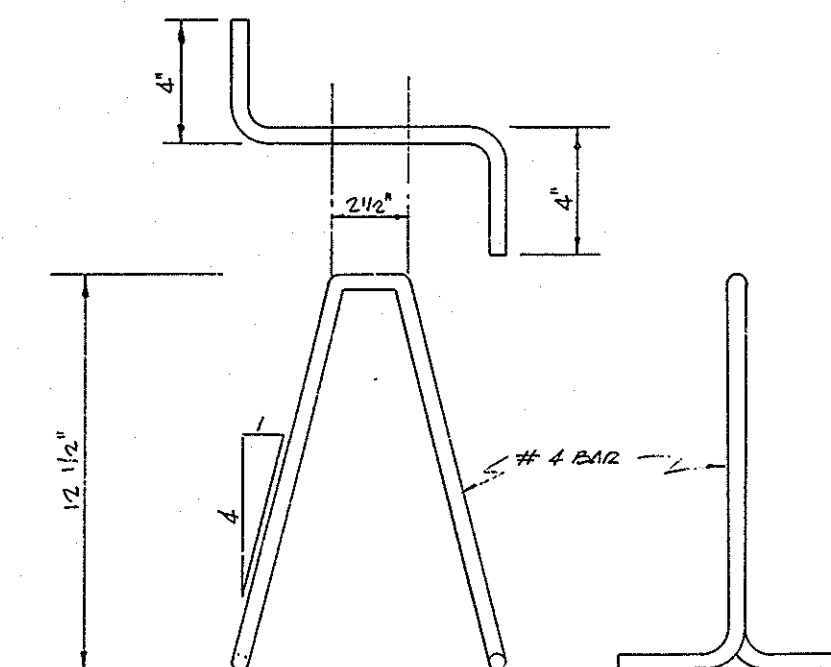

SCALE 11/1/0

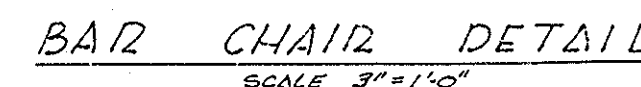

BAD CHAIR DETAIL

NOTES:

- SPLICES IN TOP MAIN BARS TO BE 36 DIA. AND LOCATED NEAR CENTER OF SPAN.
- SPLICES IN BOTTOM MAIN BARS TO BE 20 DIA. AND LOCATED NEAR PENT
- SPACING OF #4 @ 18" IS MEASURED NORMAL TO BARS.
- SPACING OF #5 BARS IN BOTTOM OF SLAB IS MEASURED ALONG E. OF ROADWAY. FOR SPACING IN CENTER HALF OF SPAN, SEE TABLE.
- PLACE ALL TRANSVERSE BARS PARALLEL TO PENT.
- PACIFIC TELEPHONE TO CO-ORDINATE THE INSTALLATION OF A UTILITY CONDUIT IN THE BRIDGE DECK. SEE SPECIAL PROVISIONS.

AS BUILT

9825
Linda Vista Avenue
Street 5 of 24
Box 12.511 Serial: as shown
Serial

Letter to Colonel 7-28-67

1764 EL. 243.629

Linda Vista Avenue

107 11 (9825)

8/24