
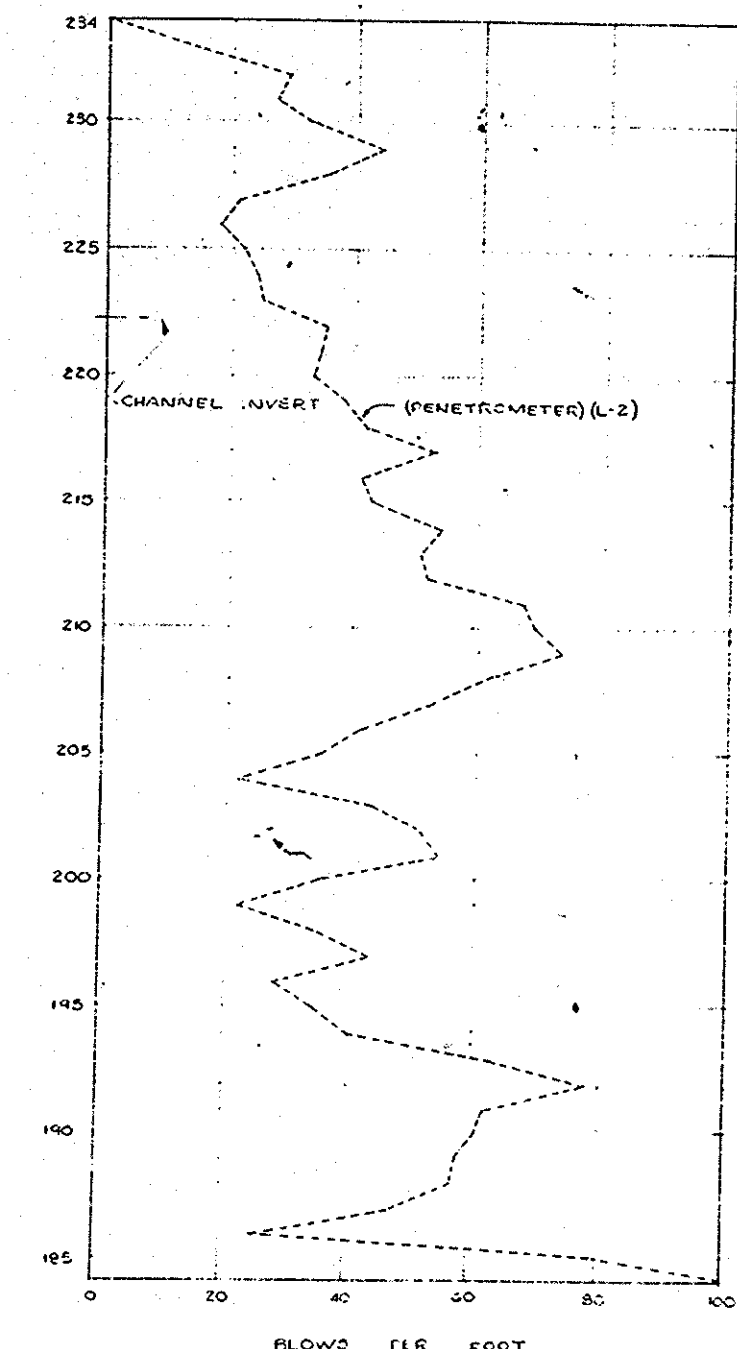
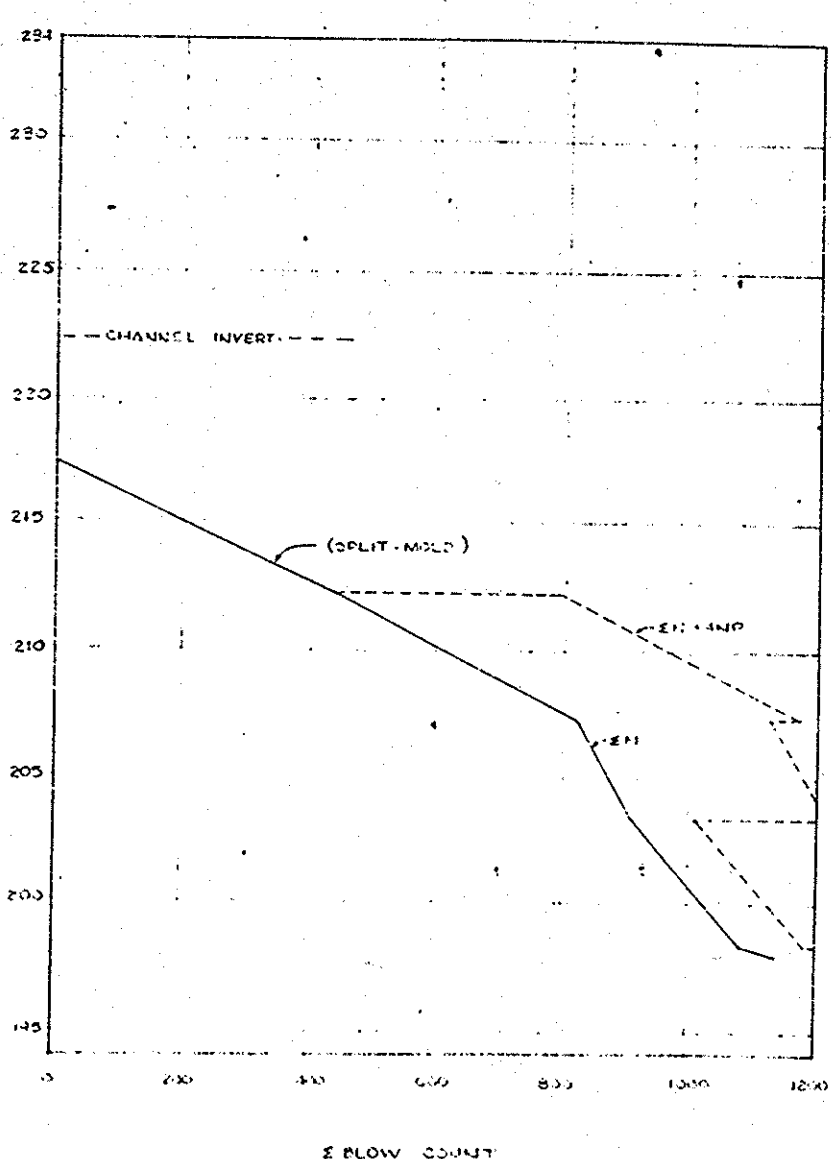
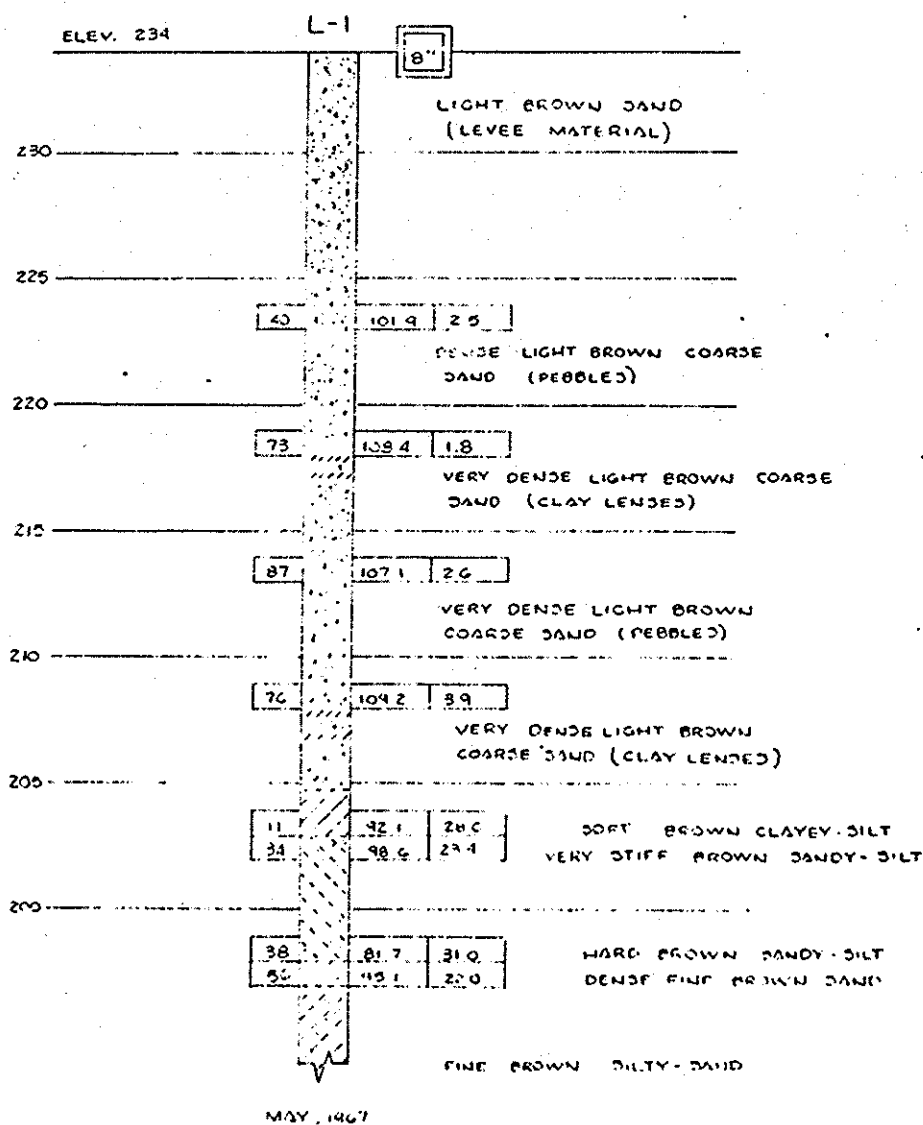


EXACT


STRAIGHT EDGE RULE SE-48

66080

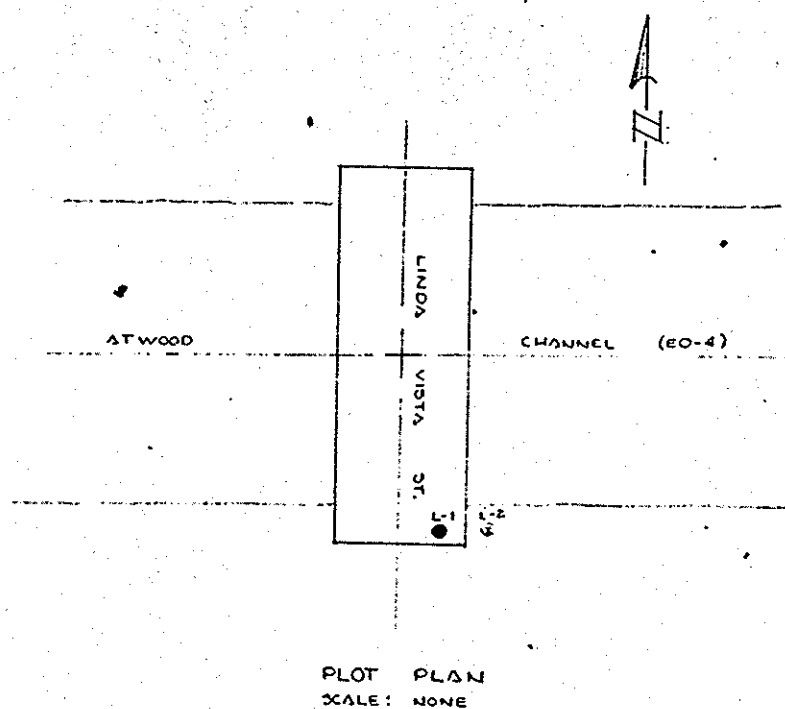

AS BUILT

CLASSIFICATION OF MATERIAL BASED ON STANDARD GRADE SIZE LIMITS

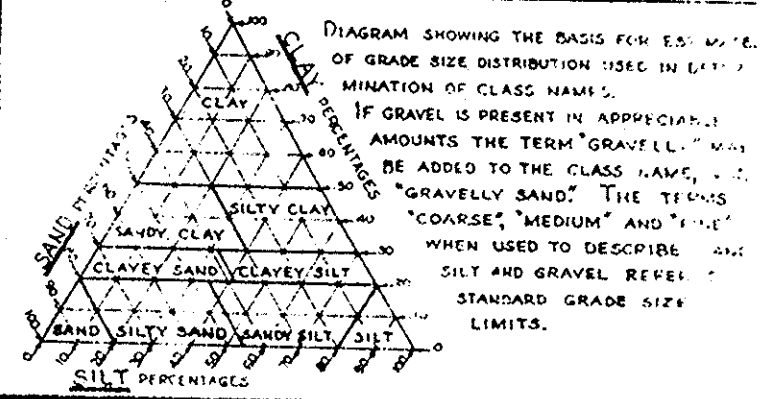

LEGEND OF EARTH MATERIALS

GRAVEL	SILTY CLAY OR CLAYEY SILT
SAND	PEAT AND/OR ORGANIC MATTER
SILT	FILL MATERIAL
CLAY	IGNEOUS ROCK
SANDY CLAY OR CLAYEY SAND	SEDIMENTARY ROCK
SANDY SILT OR SILTY SAND	METAMORPHIC ROCK

LEGEND OF BORING OPERATIONS

PLAN OF ANY BORING	Top Hole E
PENETROMETER	Top Hole E
1" CONE PENETROMETER	Top Hole E
SAMPLED BORING (S-L)	Top Hole E
WATER BORING (W-L)	Top Hole E
ARTESIAN BORING (A-L)	Top Hole E
TEST BORING	Top Hole E
COPE BORING	Top Hole E
TEST PILE	Top Hole E

NOTES
The contractor's attention is directed to Section 2 of the Standard Specifications and to the Special Provisions accompanying this set of plans.
Classification of earth material as shown on this sheet is based upon the following:

ORANGE COUNTY REAL ESTATE
PROJECT: LINDA VISTA STREET BRIDGE
AND THE ATWOOD CHANNEL (EO-4)
IN THE COUNTY OF ORANGE
SHEET NO. OF 34
LOG OF TEST BORINGS
SCALE: 1" = 10'
BRIDGE

Linda Vista Avenue

62-11 (9825)

10/24