




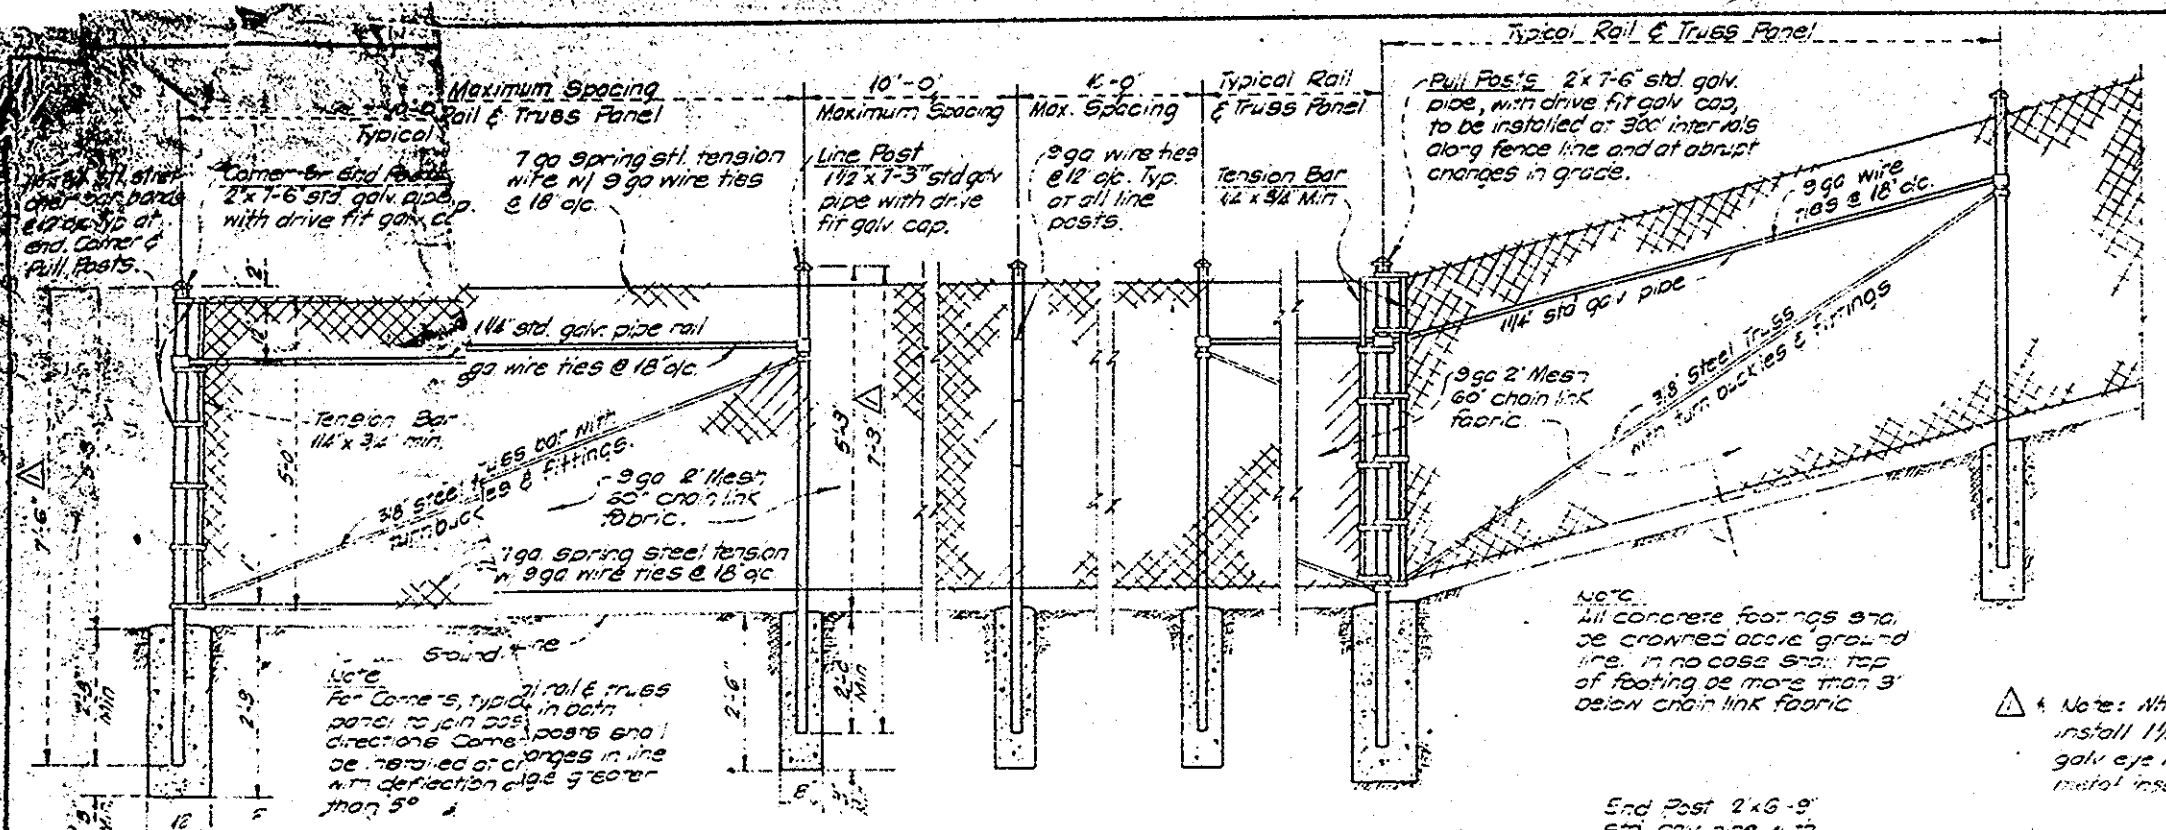


TYPICAL FENCE ELEVATION
TYPE I CHAIN LINK
RIGHT OF WAY FENCE
SCALE 1/2"=1'-0"

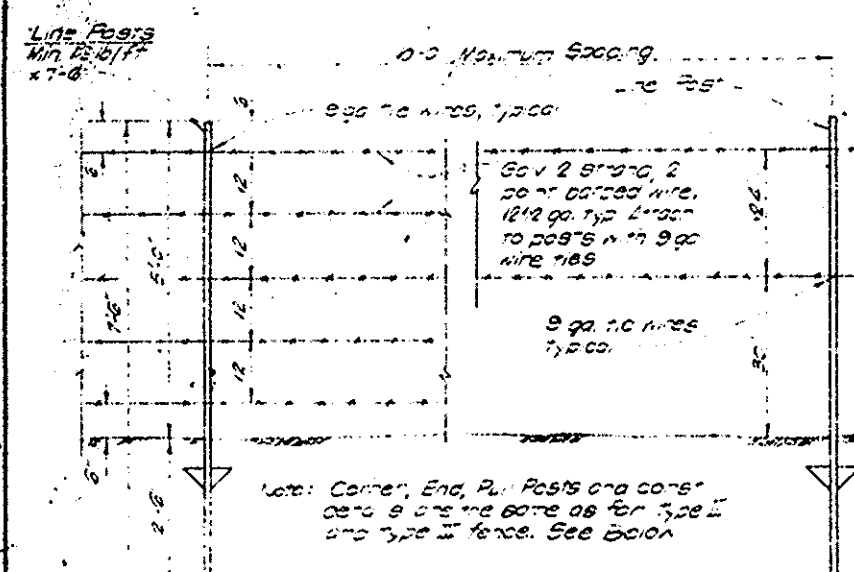


TYPICAL FENCE ELEVATION
TYPE IV-5 STRAND
BARBED WIRE FENCING
SCALE 1/2"=1'-0"

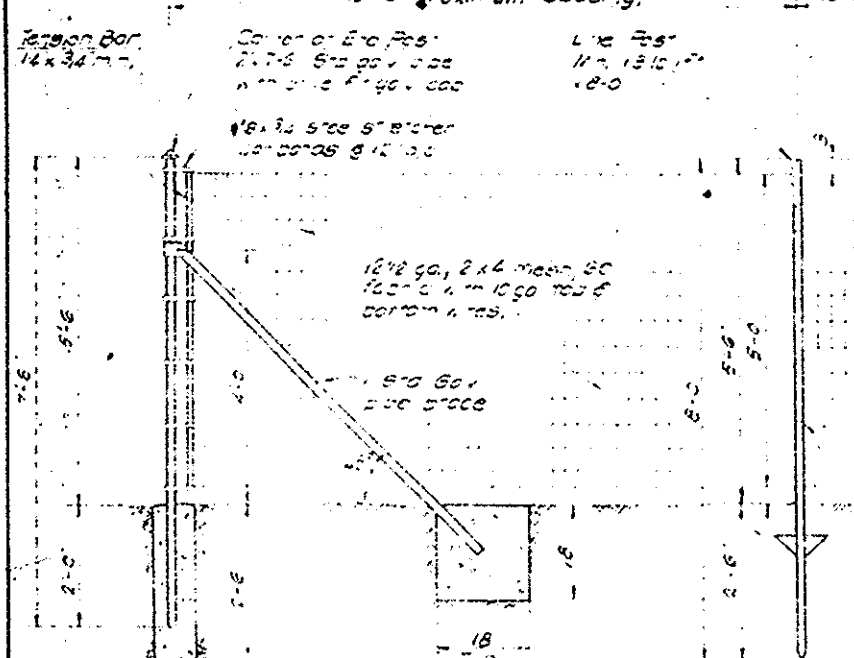


TYPICAL FENCE ELEVATION
TYPE II
2'x4' MESH FENCE
SCALE 1/2"=1'-0"

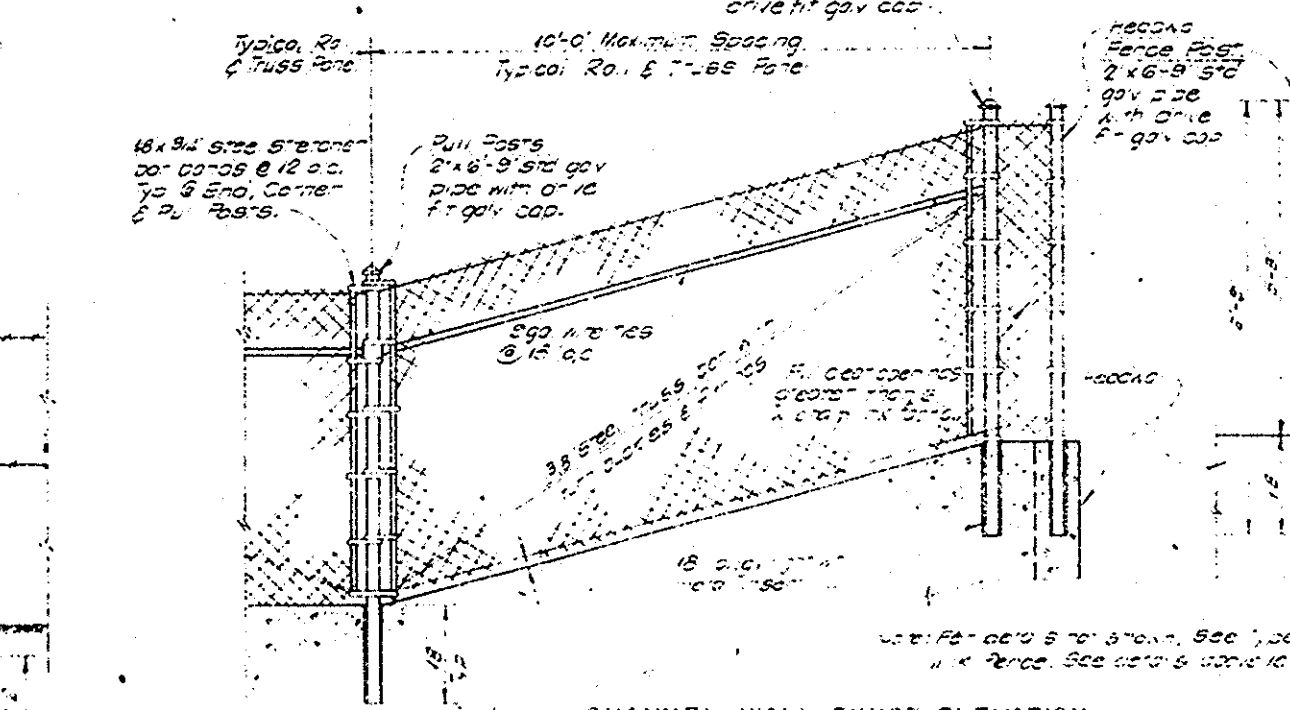


TYPICAL FENCE ELEVATION
TYPE V-2 STRAND
SCALE 1/2"=1'-0"

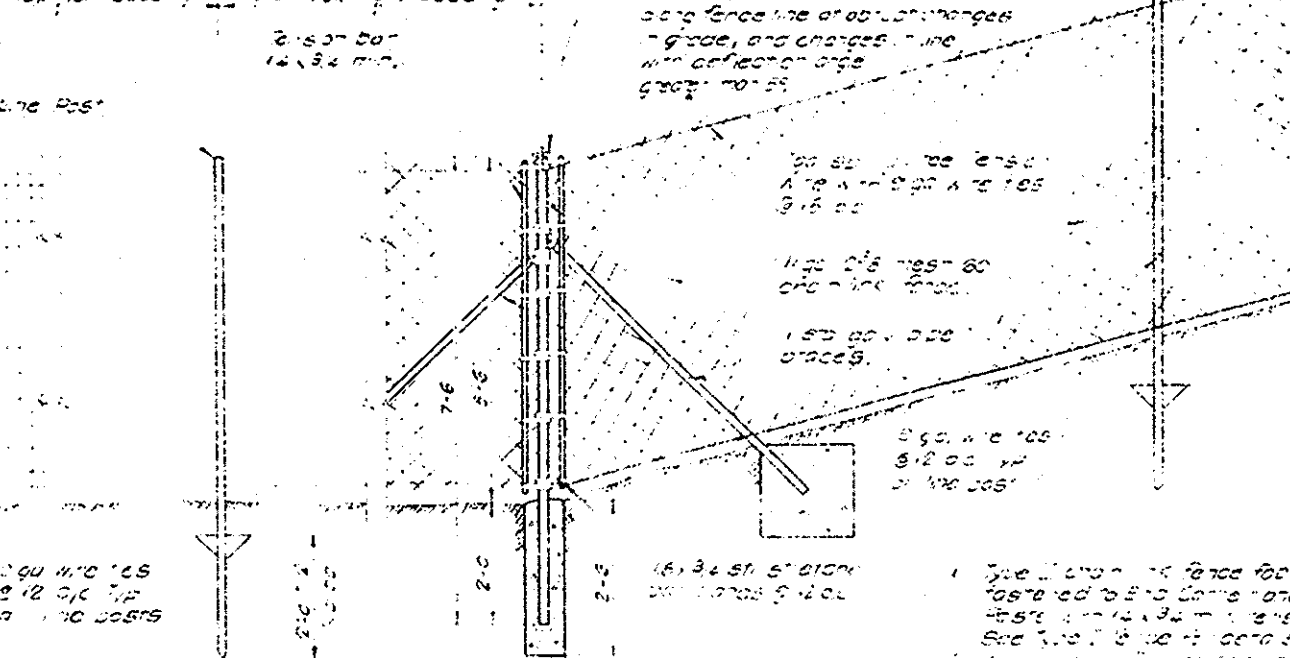

TYPICAL FENCE ELEVATION
TYPE III
CHAIN LINK FENCE
SCALE 1/2"=1'-0"

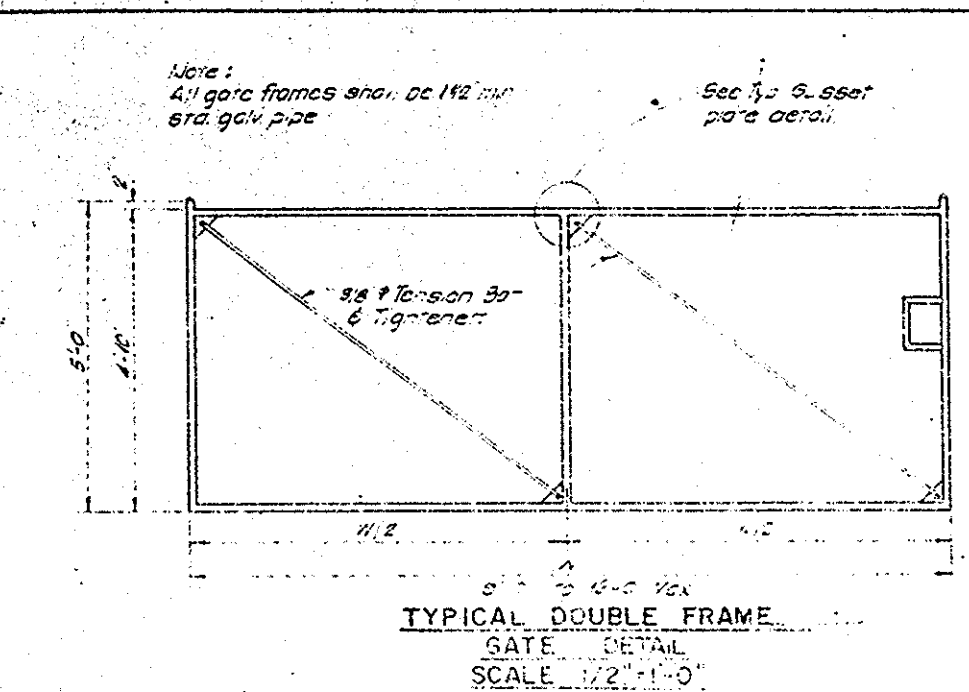


TYPICAL DOUBLE FRAME
GATE DETAIL
SCALE 1/2"=1'-0"

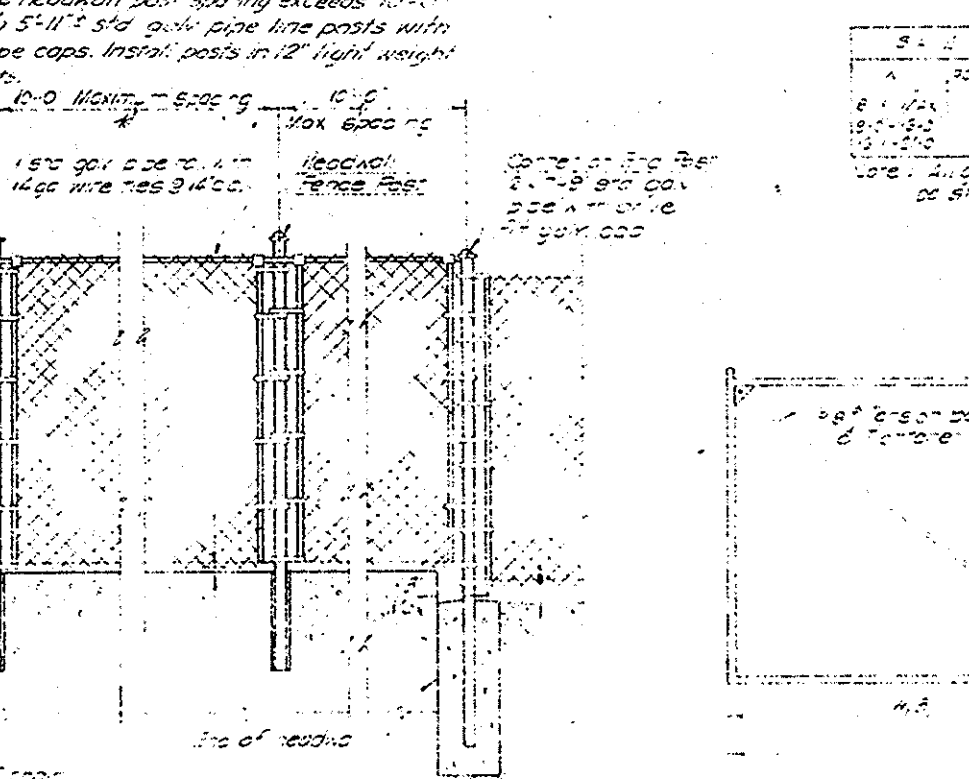

TYPICAL SINGLE FRAME GATE
AND GATE POST DETAIL
SCALE 1/2"=1'-0"

TYPICAL GUSSET
PLATE DETAIL
NO SCALE

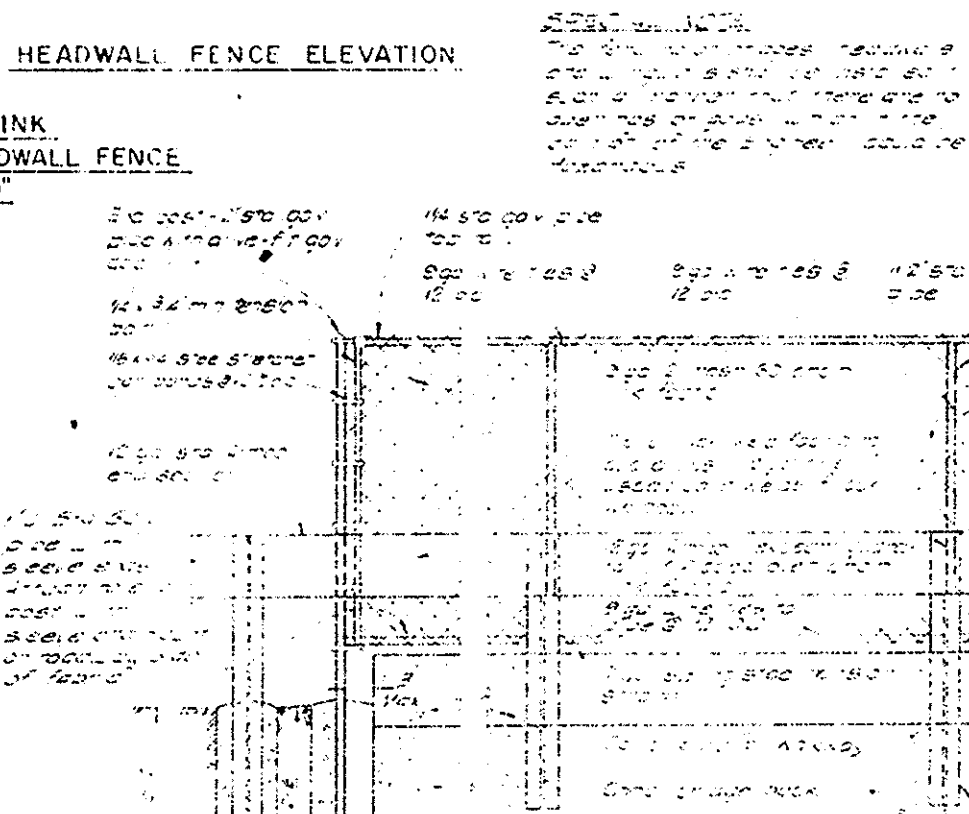

TYPICAL TRIPLE FRAME
GATE DETAIL
SCALE 1/2"=1'-0"

- GENERAL NOTES**
1. All fence posts shall be of heavy duty galvanized steel pipe, 2" x 6" x 8" for end posts and 2" x 4" x 6" for intermediate posts. Posts shall be set in concrete footings, 12" x 12" x 24" for end posts and 12" x 12" x 18" for intermediate posts. Posts shall be set in concrete footings, 12" x 12" x 24" for end posts and 12" x 12" x 18" for intermediate posts.
 2. All fence rails and trusses shall be of heavy duty galvanized steel pipe, 1/4" x 1/2" for rails and 1/4" x 1/2" for trusses. Rails and trusses shall be set in concrete footings, 12" x 12" x 24" for end posts and 12" x 12" x 18" for intermediate posts.
 3. All fence tension bars shall be of heavy duty galvanized steel pipe, 1/2" x 1/2" for tension bars. Tension bars shall be set in concrete footings, 12" x 12" x 24" for end posts and 12" x 12" x 18" for intermediate posts.
 4. All fence end posts shall be of heavy duty galvanized steel pipe, 2" x 6" x 8" for end posts. End posts shall be set in concrete footings, 12" x 12" x 24" for end posts and 12" x 12" x 18" for intermediate posts.
 5. All fence intermediate posts shall be of heavy duty galvanized steel pipe, 2" x 4" x 6" for intermediate posts. Intermediate posts shall be set in concrete footings, 12" x 12" x 24" for end posts and 12" x 12" x 18" for intermediate posts.
 6. All fence rails and trusses shall be of heavy duty galvanized steel pipe, 1/4" x 1/2" for rails and 1/4" x 1/2" for trusses. Rails and trusses shall be set in concrete footings, 12" x 12" x 24" for end posts and 12" x 12" x 18" for intermediate posts.
 7. All fence tension bars shall be of heavy duty galvanized steel pipe, 1/2" x 1/2" for tension bars. Tension bars shall be set in concrete footings, 12" x 12" x 24" for end posts and 12" x 12" x 18" for intermediate posts.
 8. All fence end posts shall be of heavy duty galvanized steel pipe, 2" x 6" x 8" for end posts. End posts shall be set in concrete footings, 12" x 12" x 24" for end posts and 12" x 12" x 18" for intermediate posts.
 9. All fence intermediate posts shall be of heavy duty galvanized steel pipe, 2" x 4" x 6" for intermediate posts. Intermediate posts shall be set in concrete footings, 12" x 12" x 24" for end posts and 12" x 12" x 18" for intermediate posts.

AS BUILT

BRIDGE GUARDRAIL AND FENCE DETAIL
SCALE 1/2"=1'-0"

DRAWING INFORMATION		REVISIONS	
NO.	DESCRIPTION	NO.	DESCRIPTION
1	AS BUILT		

ORANGE COUNTY FLOOD CONTROL DISTRICT

TYPICAL FENCE AND GATE DETAILS

SCALE 1/2"=1'-0"

DATE 11/11/98

DESIGNED BY [Signature]

CHECKED BY [Signature]

APPROVED BY [Signature]

Inda Vista Avenue

11/11/98 25 SHEET 12 OF 24

12/24