


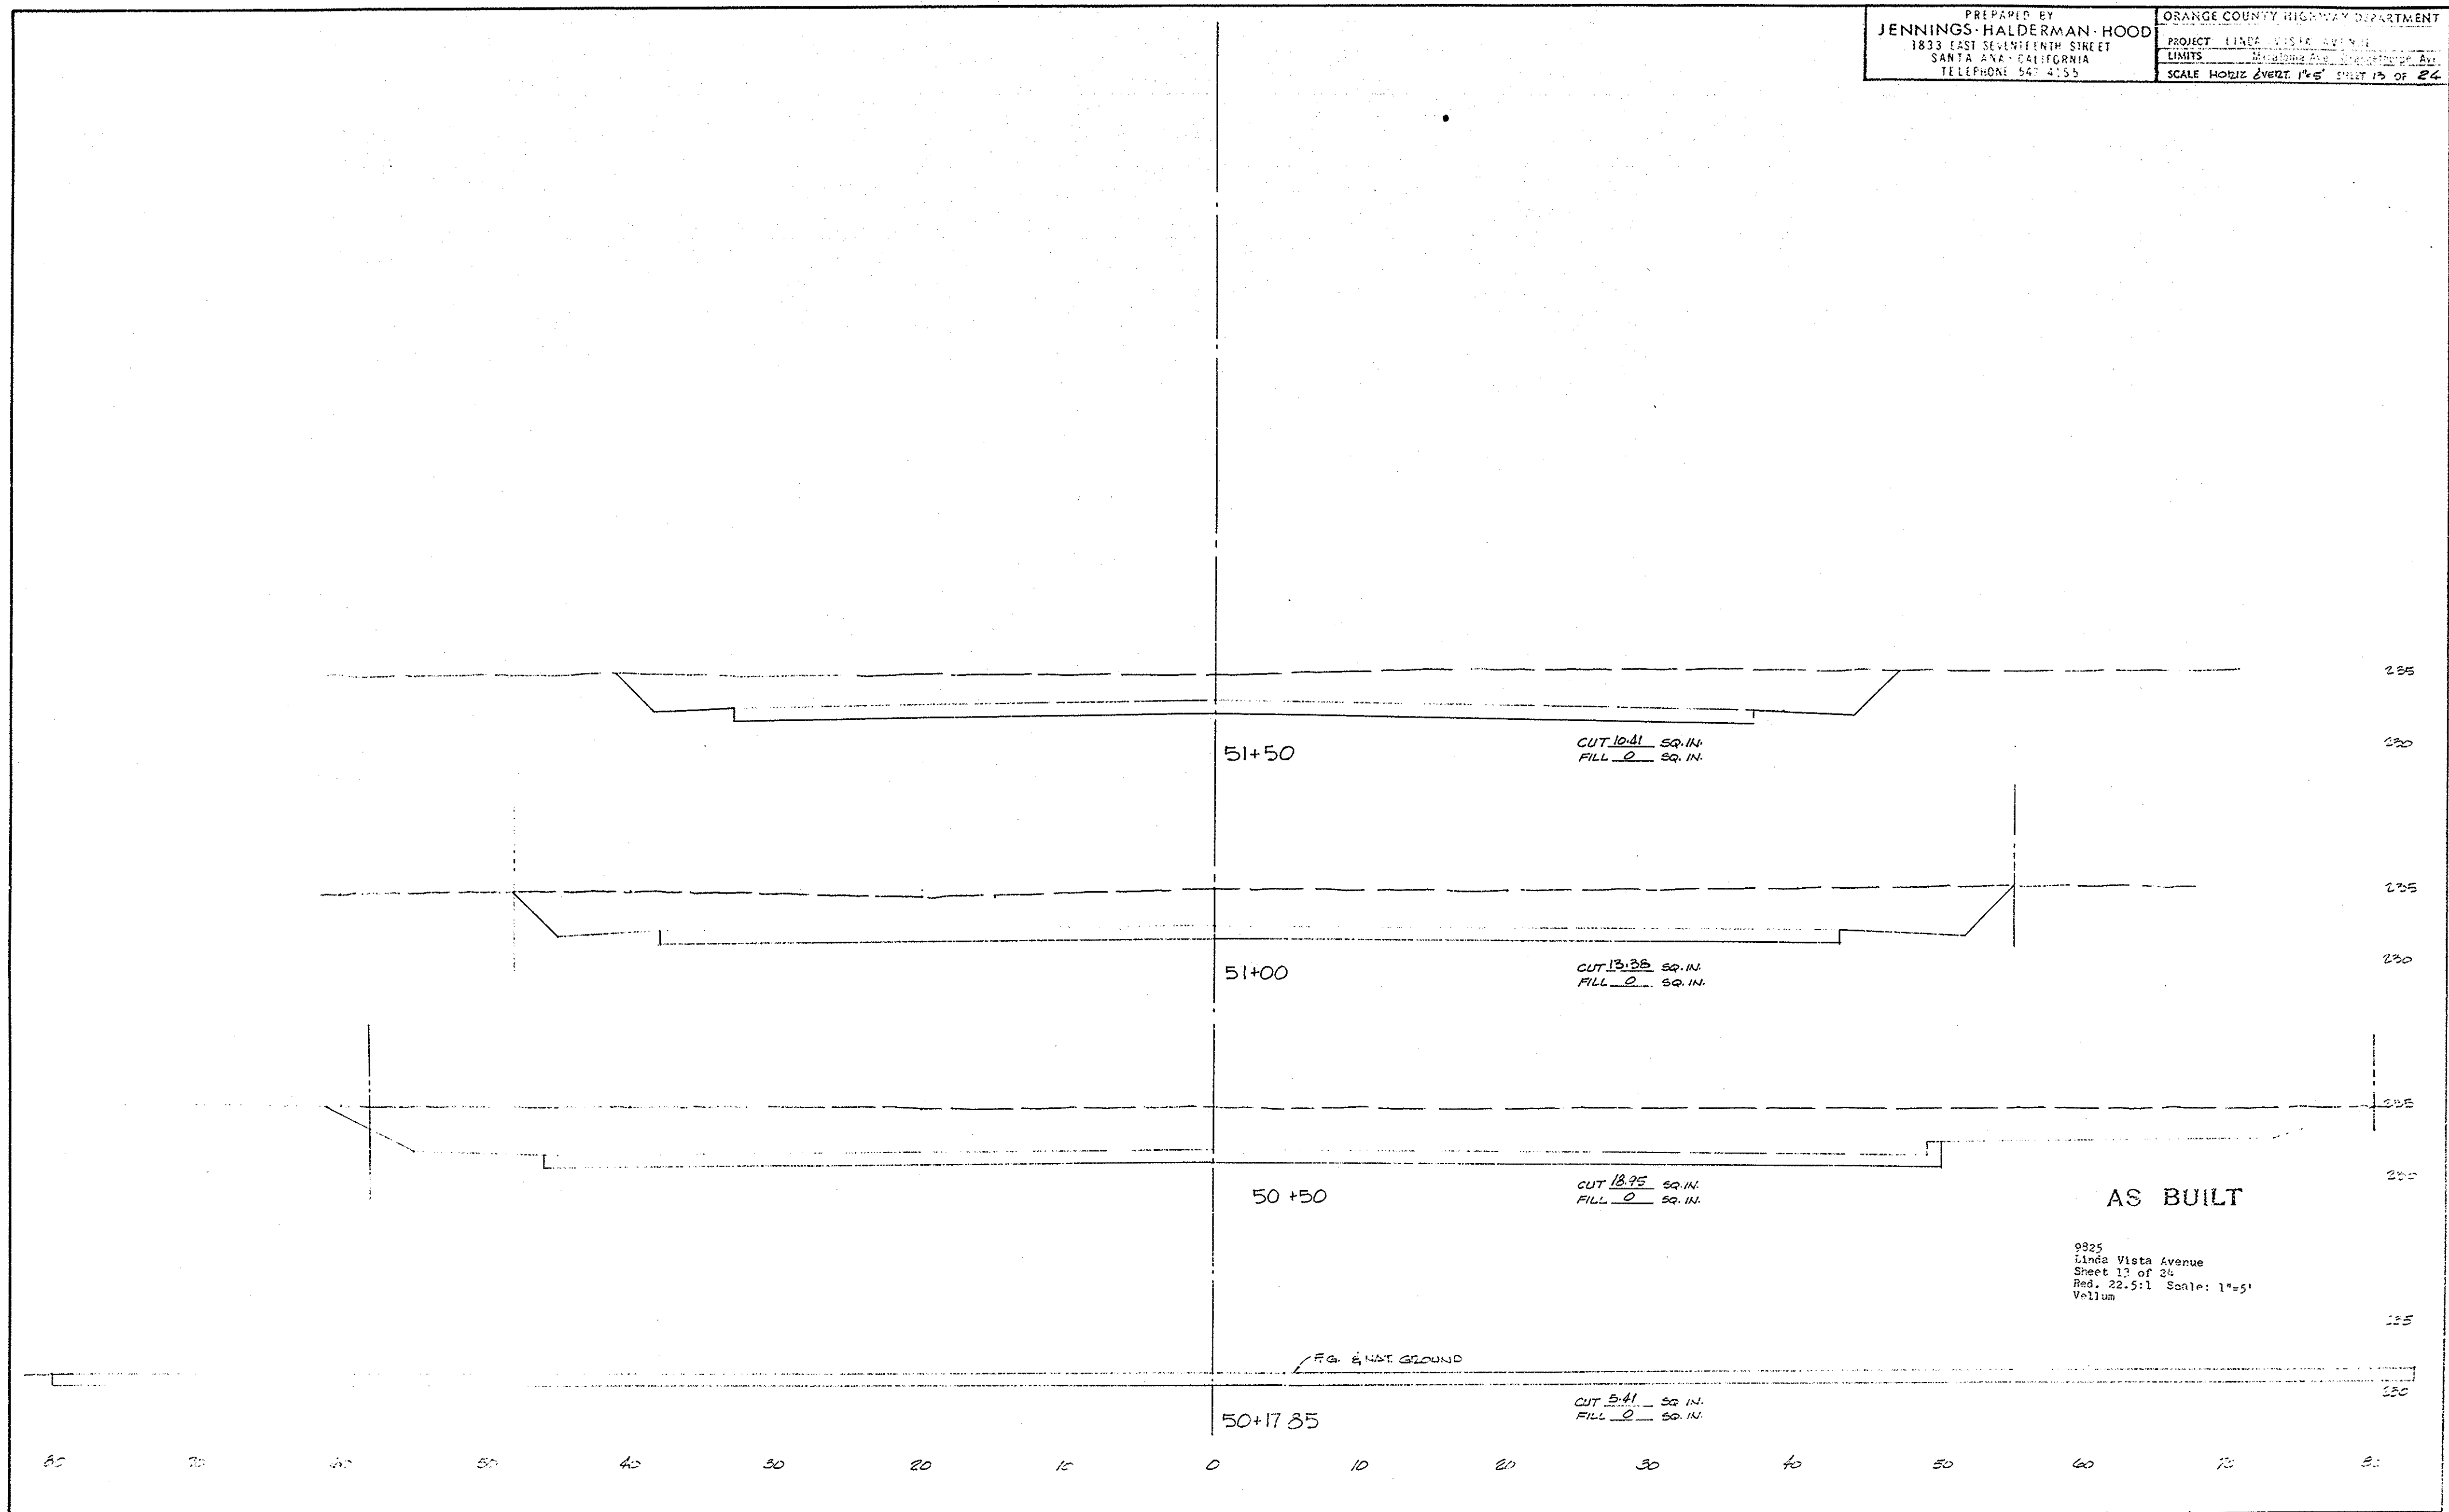

Linda Vista Avenue

9925

13/24