


PREPARED BY
JENNINGS-HALDERMAN-HOOD
 1833 EAST SEVENTEENTH STREET
 SANTA ANA - CALIFORNIA
 TELEPHONE 547-4155

ORANGE COUNTY HIGHWAY DEPARTMENT
 PROJECT: LINDA VISTA AVENUE
 LIMITS: 9825 TO 9825+20
 SCALE: HORIZ. 1"=50' VERT. 1"=5'

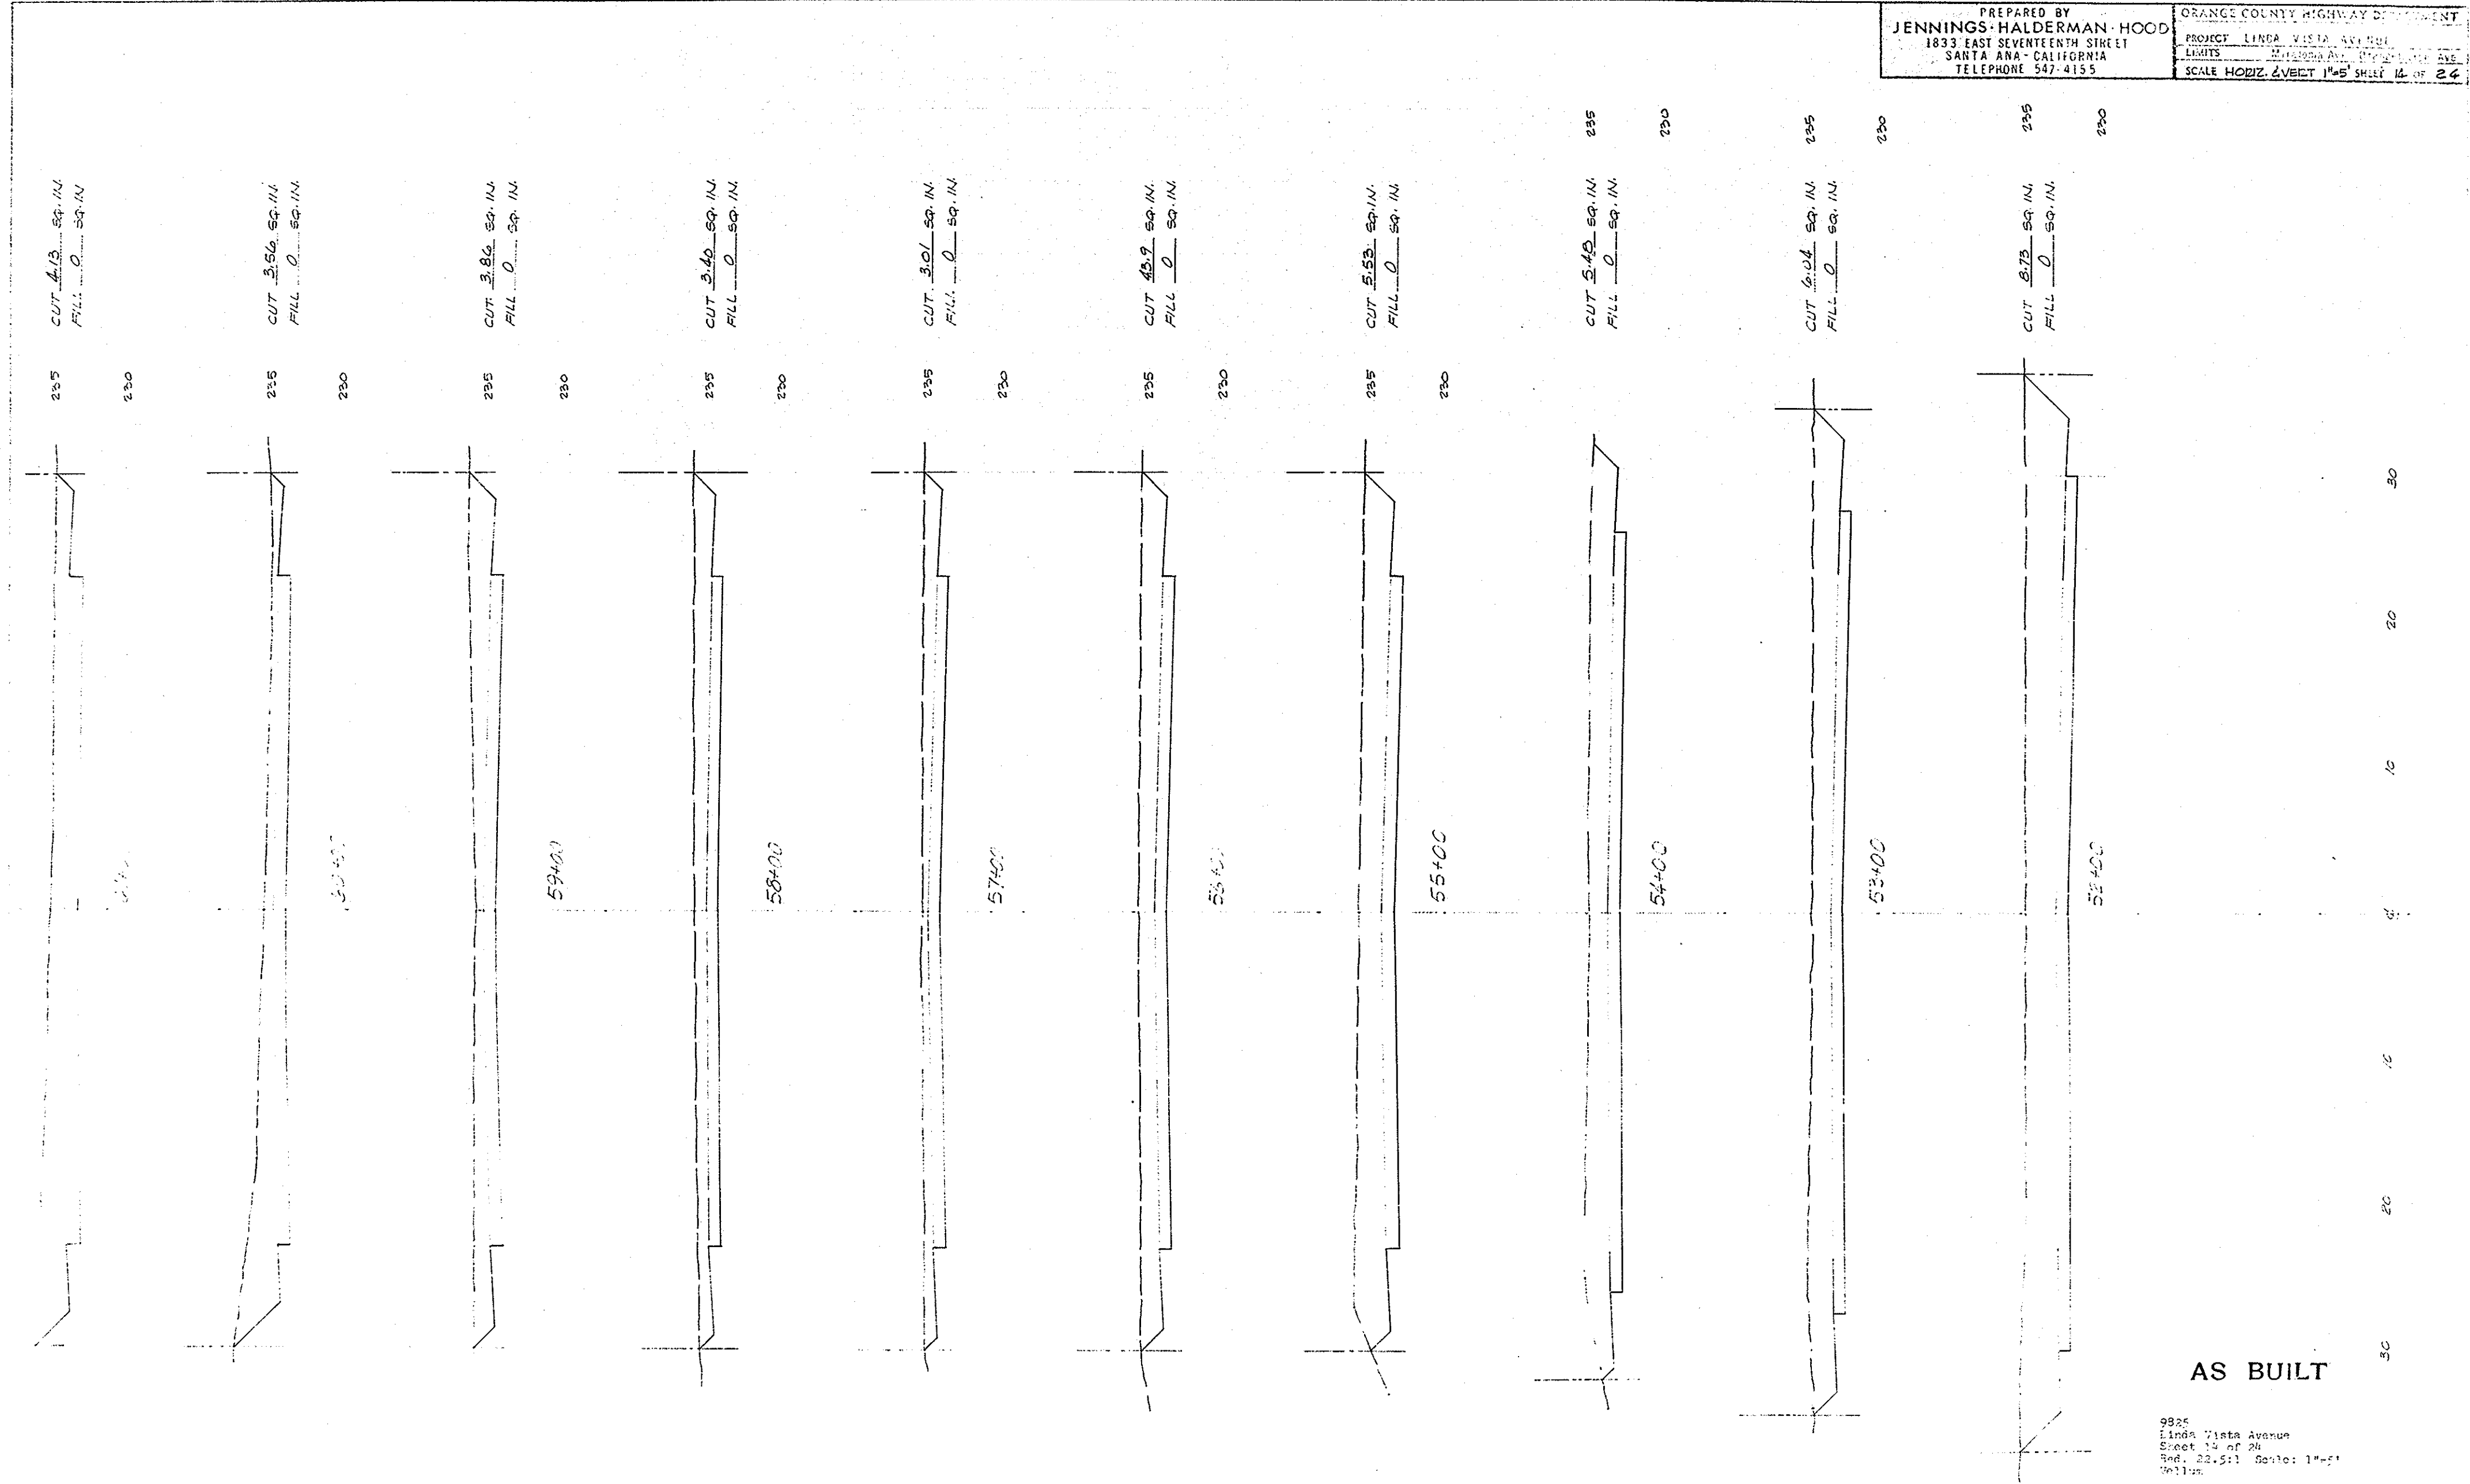

AS BUILT

9825
 Linda Vista Avenue
 Sheet 14 of 20
 Red. 22.5:1 Scale: 1"=5'

Linda Vista Avenue

Dr. 11 (9825)

14/24