


PREPARED BY JENNINGS, HALDERMAN, HOOD 1833 EAST SEVENTEENTH STREET SANTA ANA, CALIFORNIA TELEPHONE 547-4155	ORANGE COUNTY HIGHWAY DEPARTMENT PROJECT: LINDA VISTA AVENUE LIMITS: Miraloma Ave - Orange Harbor Ave SCALE: HORIZ. & VERT. 1"=5' SHEET 15 OF 24
--	---

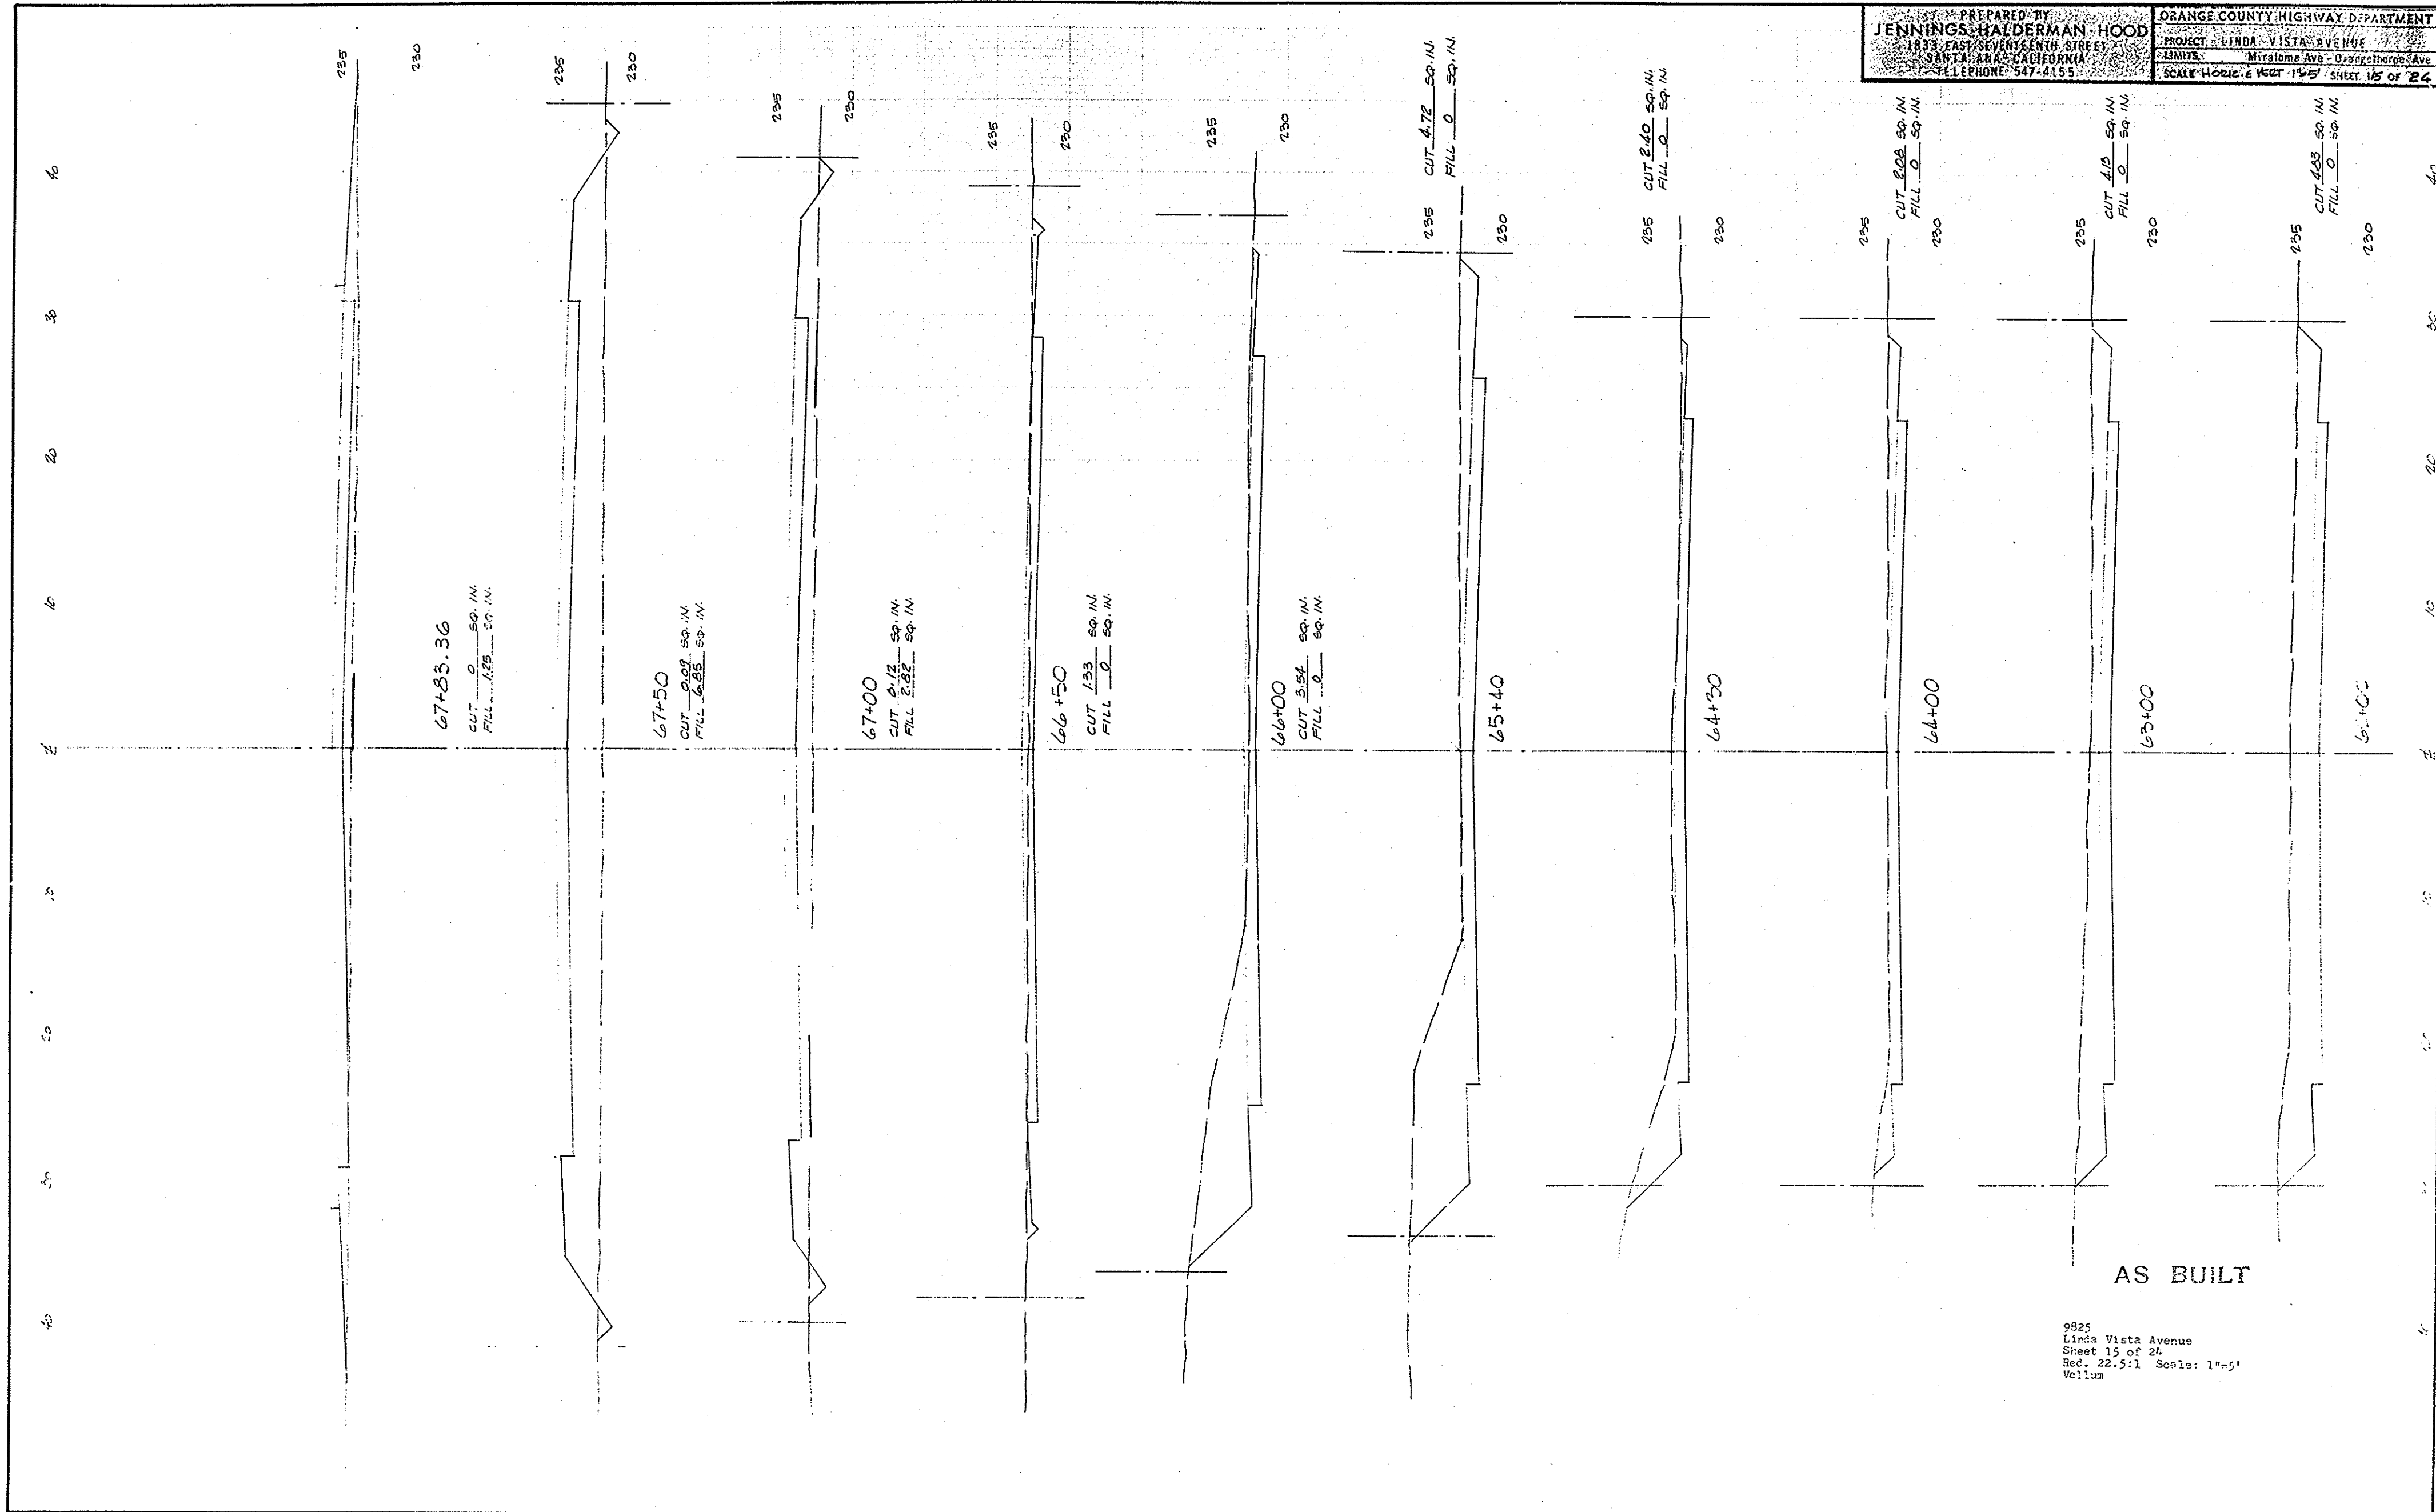

Linda Vista Avenue

15 11 (9925)

15/24