


|                                                                                                                               |                                                                                                                                                               |
|-------------------------------------------------------------------------------------------------------------------------------|---------------------------------------------------------------------------------------------------------------------------------------------------------------|
| PREPARED BY<br><b>JENNINGS HALDERMAN HOOD</b><br>1833 EAST SEVENTEENTH STREET<br>SANTA ANA - CALIFORNIA<br>TELEPHONE 547-4155 | ORANGE COUNTY HIGHWAY DEPARTMENT<br>PROJECT: LINDA VISTA AVENUE<br>LIMITS: Miraloma Ave - Orangefhorpe Ave<br>SCALE: HORIZ. 1"=50' VERT. 1"=5' SHEET 16 OF 24 |
|-------------------------------------------------------------------------------------------------------------------------------|---------------------------------------------------------------------------------------------------------------------------------------------------------------|

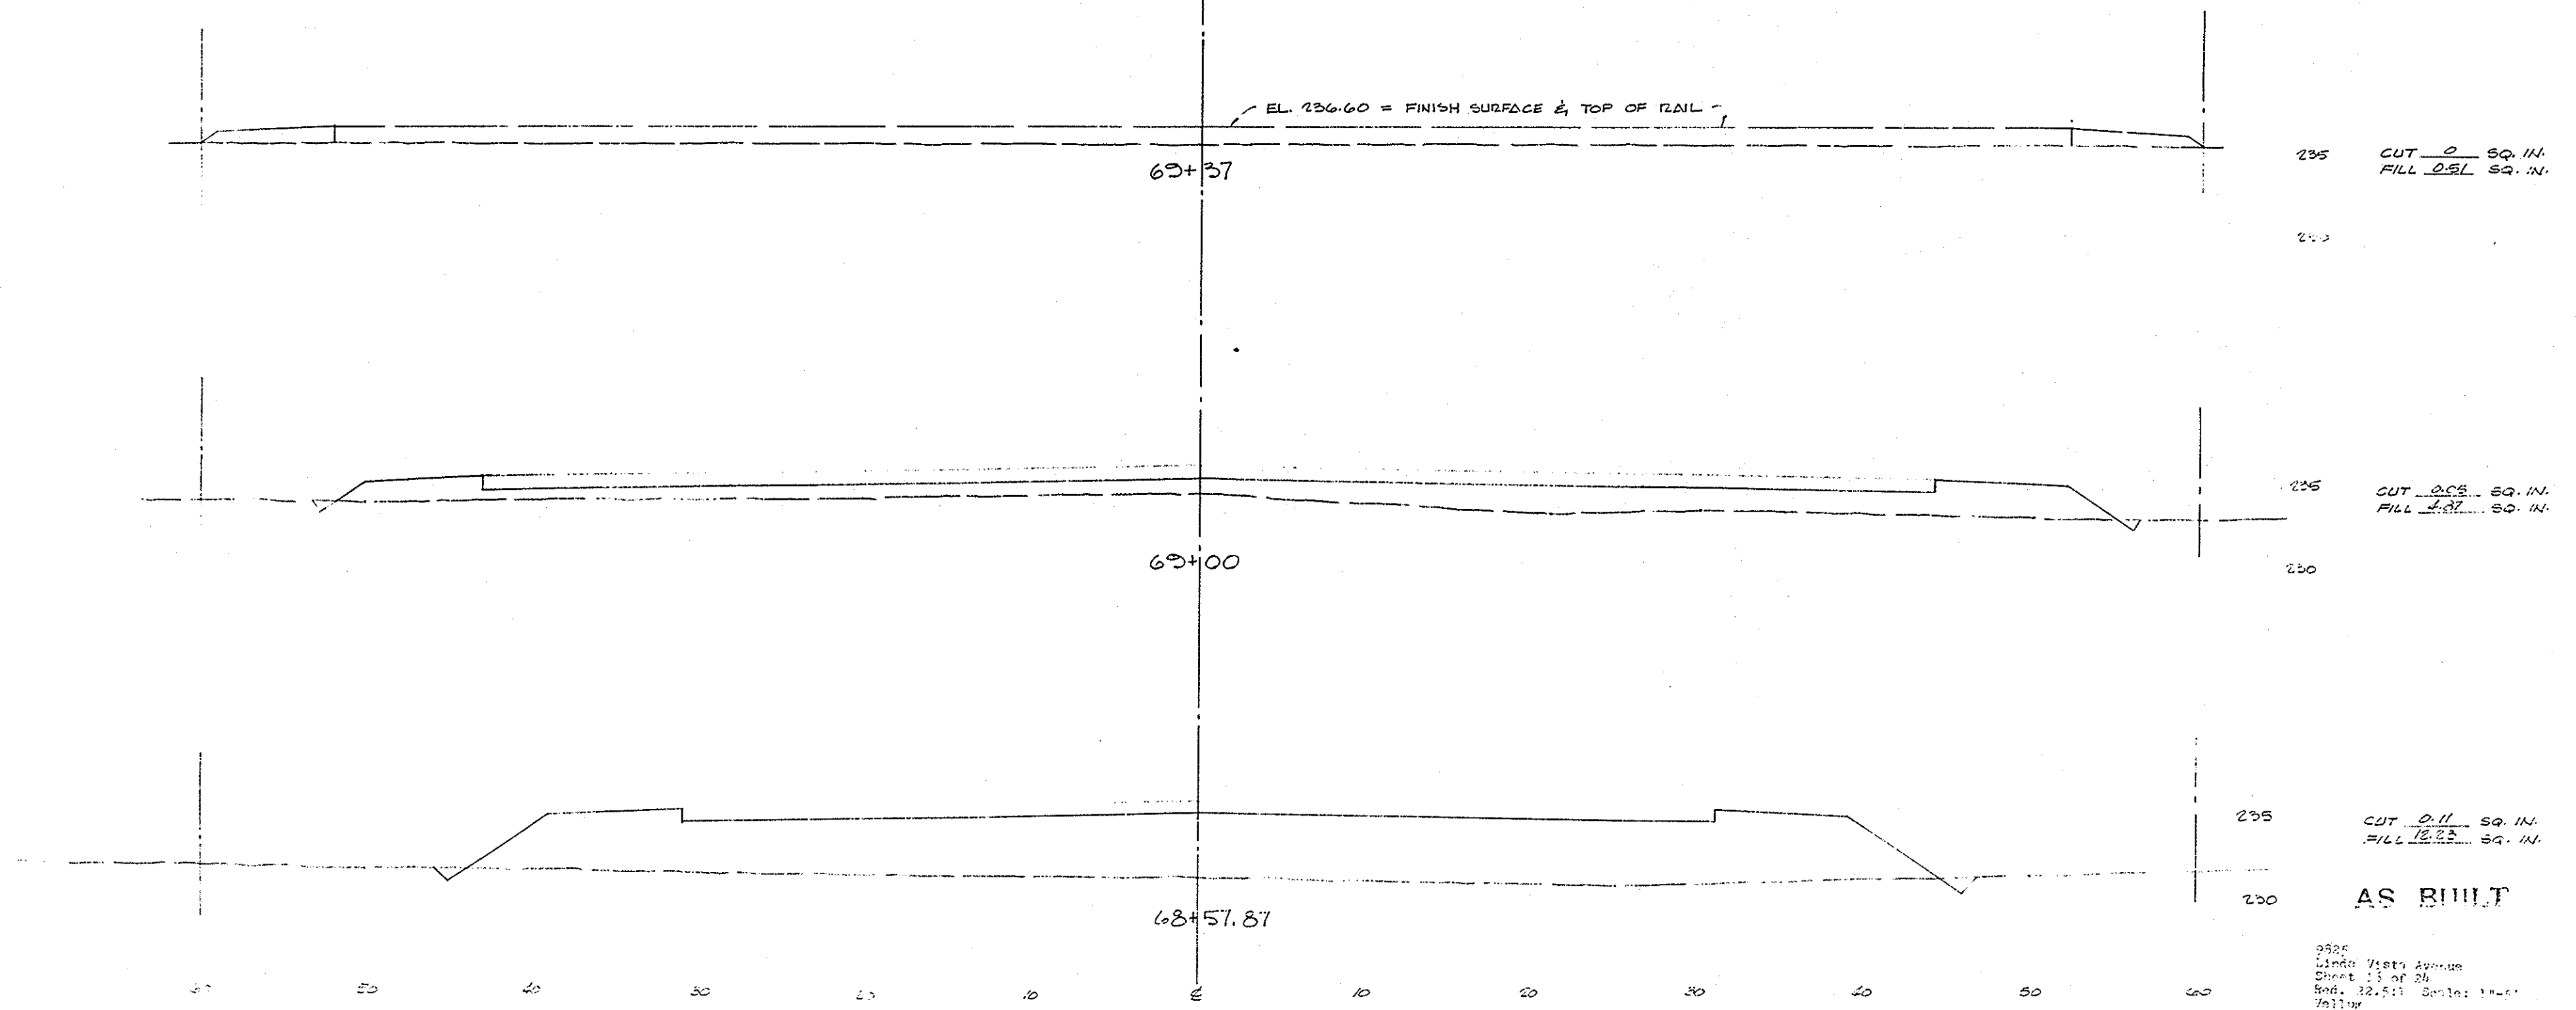

Linda Vista Avenue

68+11 (9875)

16/24