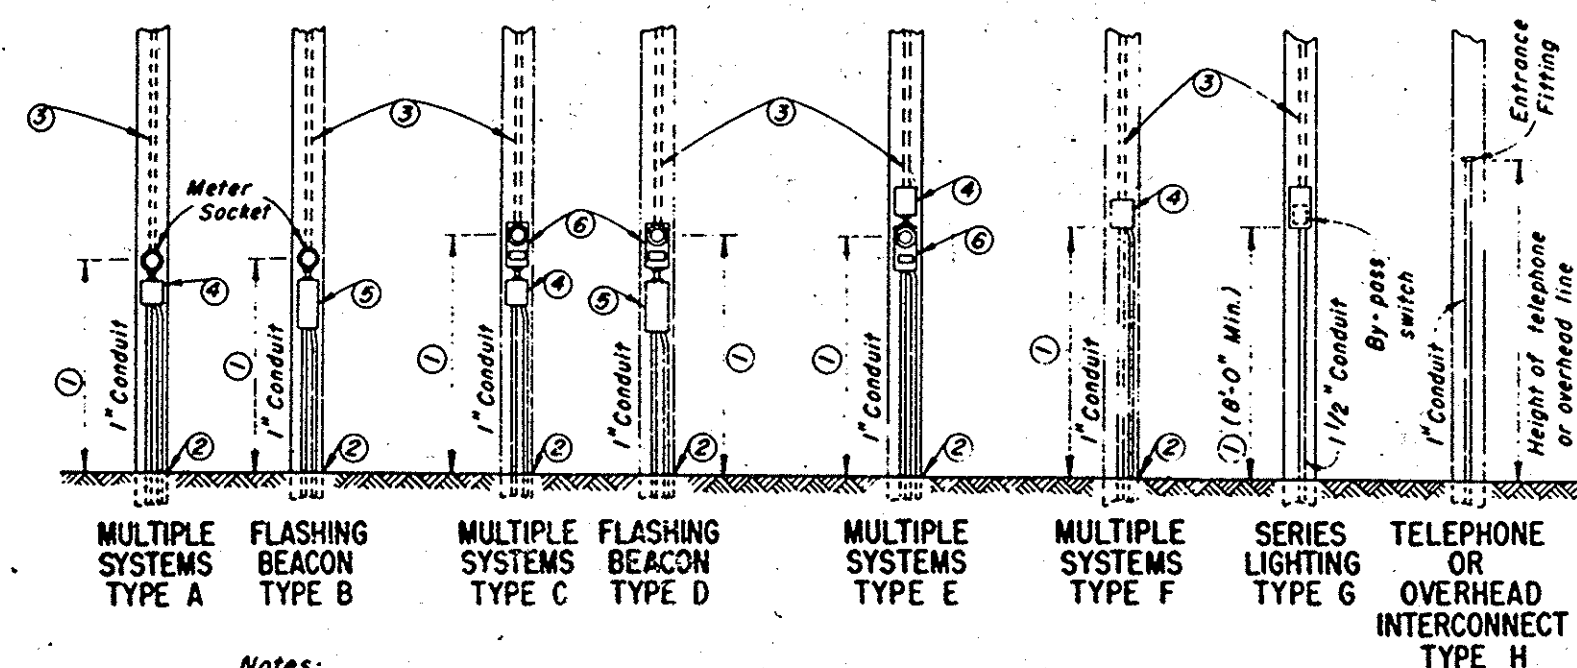


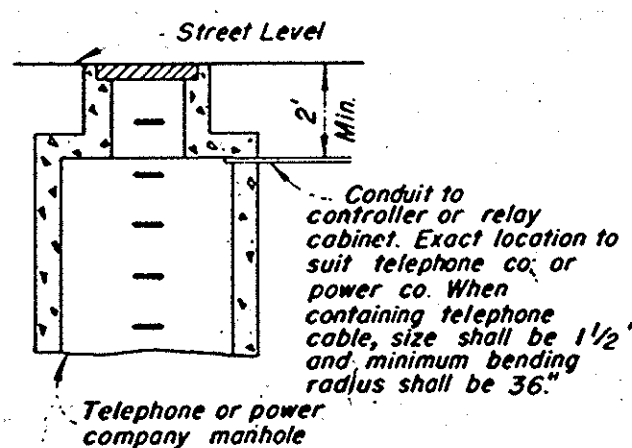


Notes:

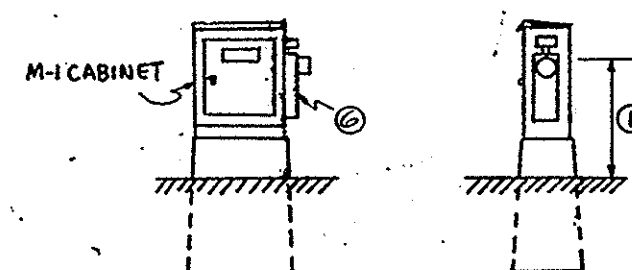
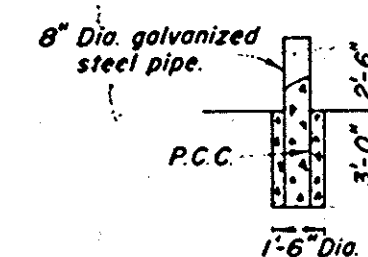
- ① Position of service equipment to be determined by serving utility.
- ② See "Service Grounding" detail.
- ③ If service pole is utility owned, service riser shall be furnished by contractor and installed by serving utility. On state owned poles, the service riser shall be furnished and installed by contractor. Service riser conduit shall be terminated with a service head and shall be sealed to prevent the entrance of water, as approved by serving utility.
- ④ Service switch.
- ⑤ Flashing beacon control with service switch.
- ⑥ Meter socket box with either manual circuit closing device or space for test block as specified.

ELECTRICAL AND TELEPHONE SERVICE DETAILS

NO SCALE

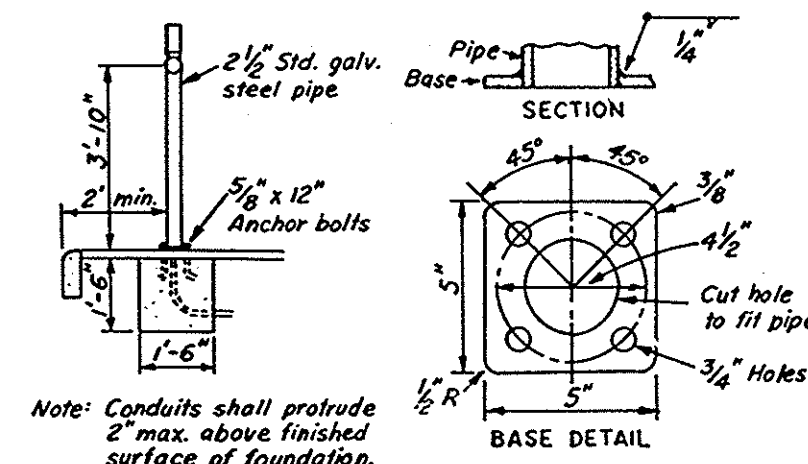
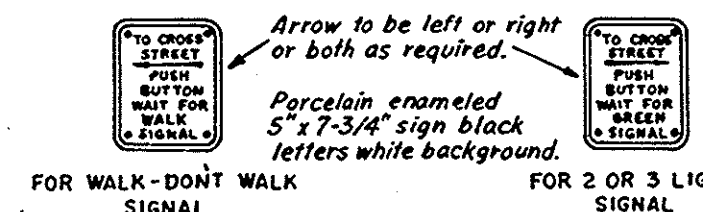


UNDERGROUND

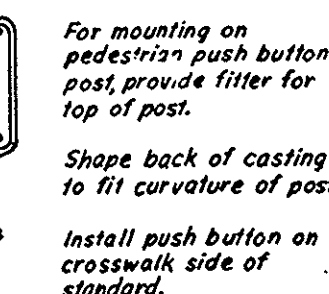
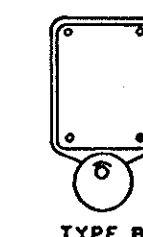
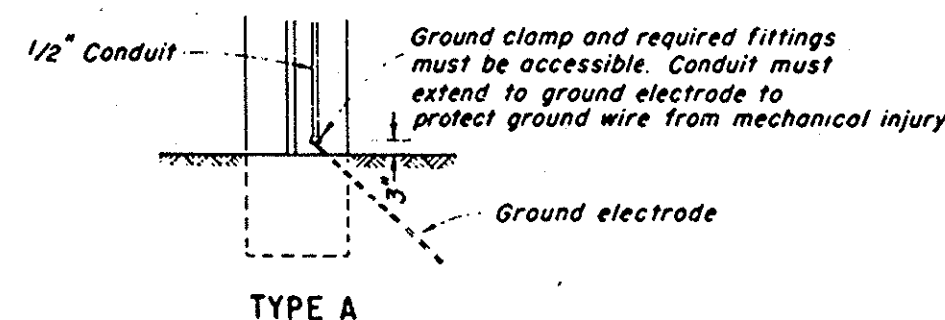
MULTIPLE SYSTEMS
TYPE J

GUARD POST

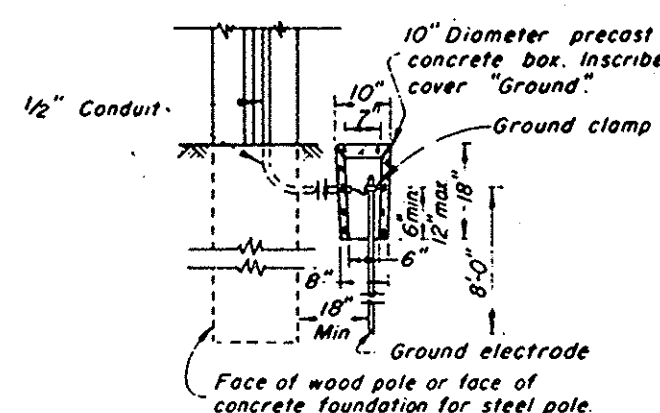
NO SCALE

PEDESTRIAN PUSH
BUTTON POST

SIGNS

PEDESTRIAN PUSH
BUTTON & SIGN

TYPE A



TYPE B

(Install in sidewalk or paved areas)

SERVICE GROUNDING

NO SCALE

Notes:
When water pipe is used for ground, wire shall be enclosed in galvanized rigid conduit, or equivalent mechanical protection.

Rod or pipe electrodes shall be driven to a depth of at least 8 ft. below surrounding grade.

AS BUILT

ORANGE COUNTY ROAD DEPARTMENT

ORANGETHORPE AVE.-
LINDA VISTA AVE.
INTERSECTION

TRAFFIC SIGNAL &
LIGHTING STD. DETAILS

SCALE: 23/24

Project Engineer	Date	Design Engineer	Date	Approval Recommended By	Date

152
17/100 (7708)

Linda Vista Avenue Dr. 11 (9825)

FORM 1000-23

23/24