
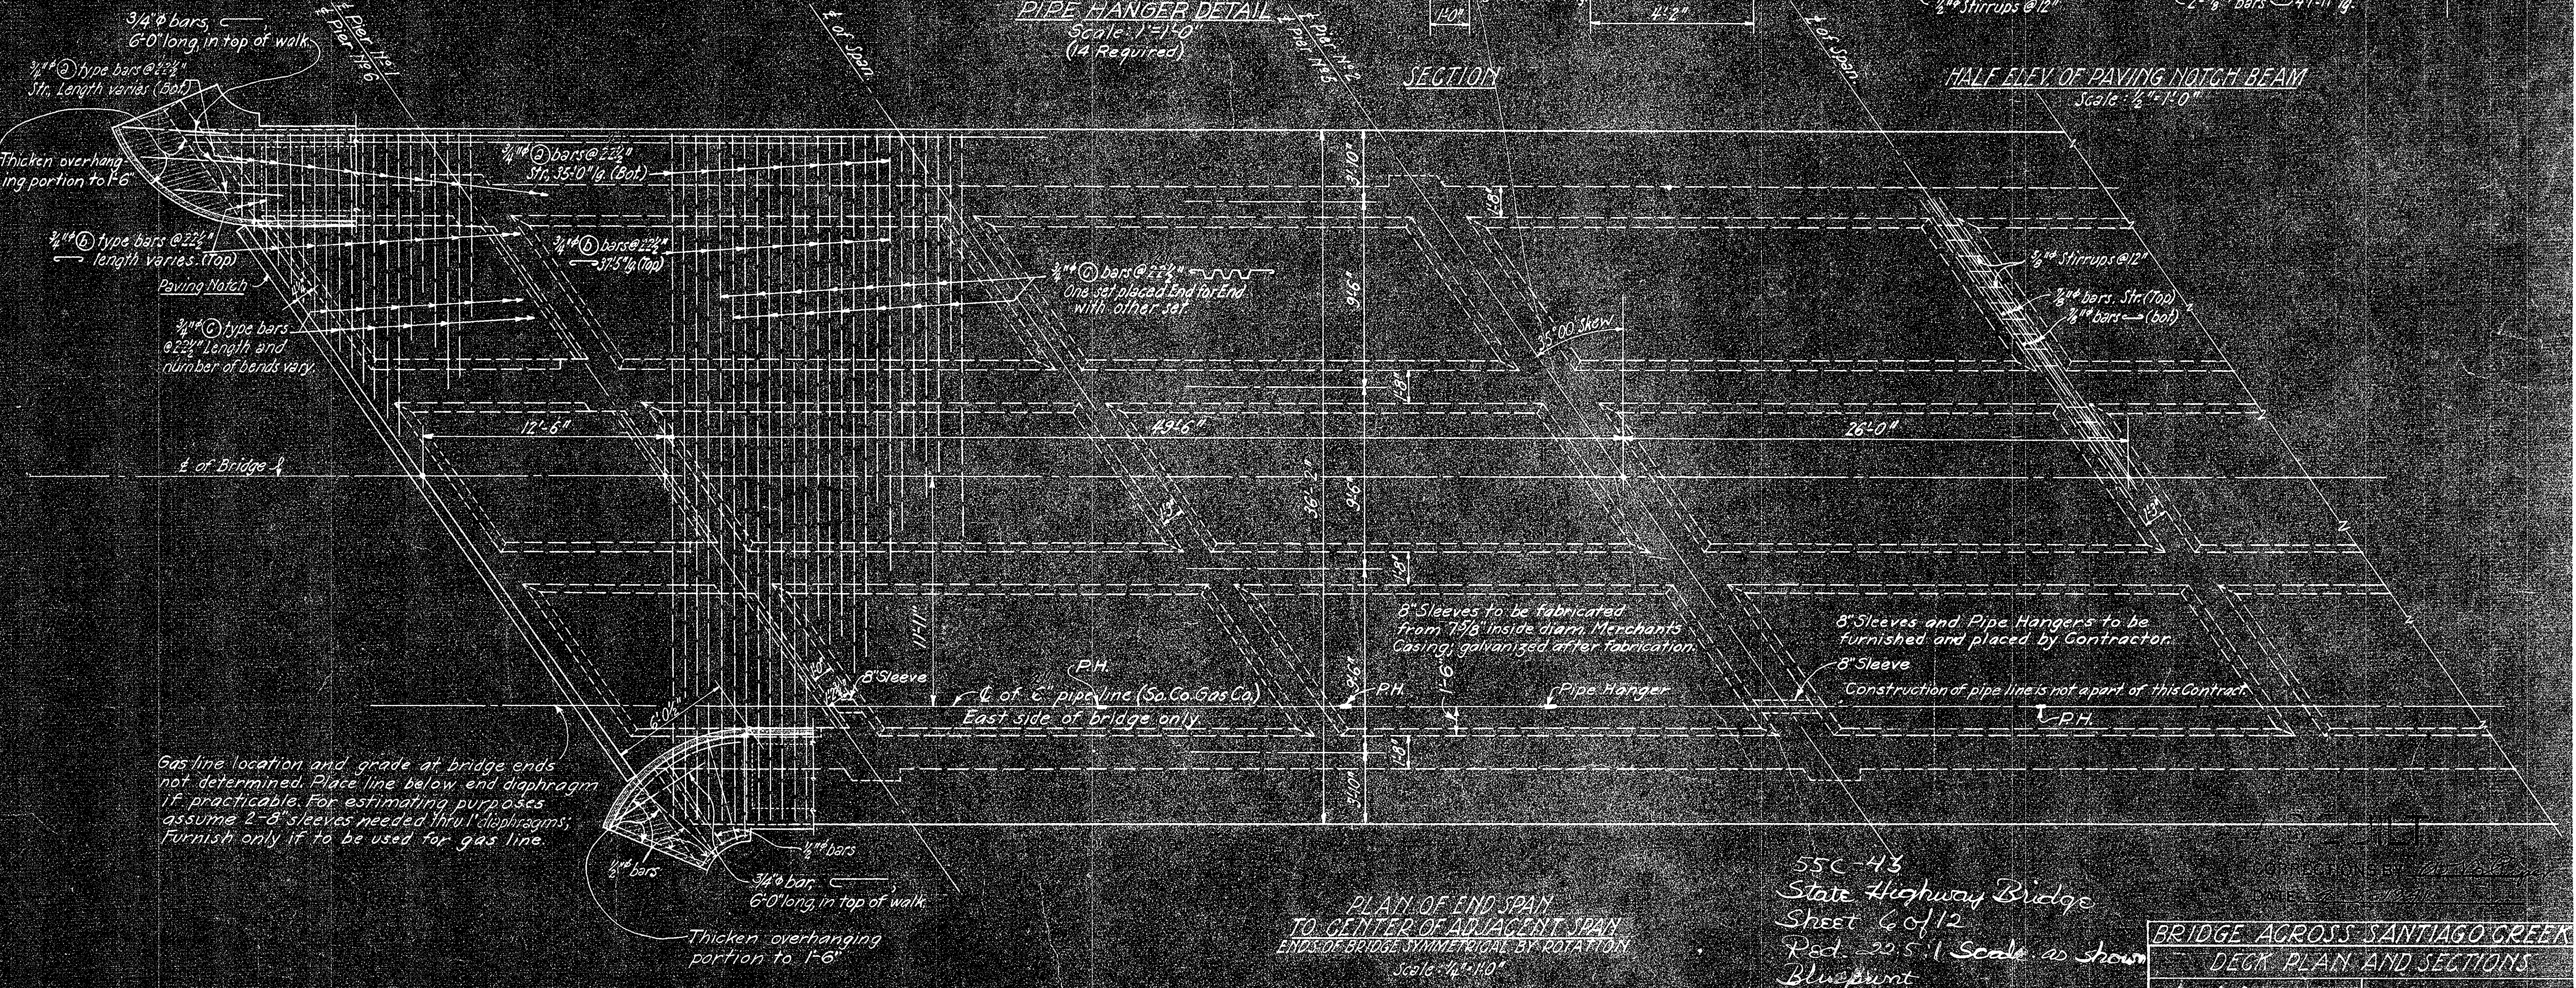
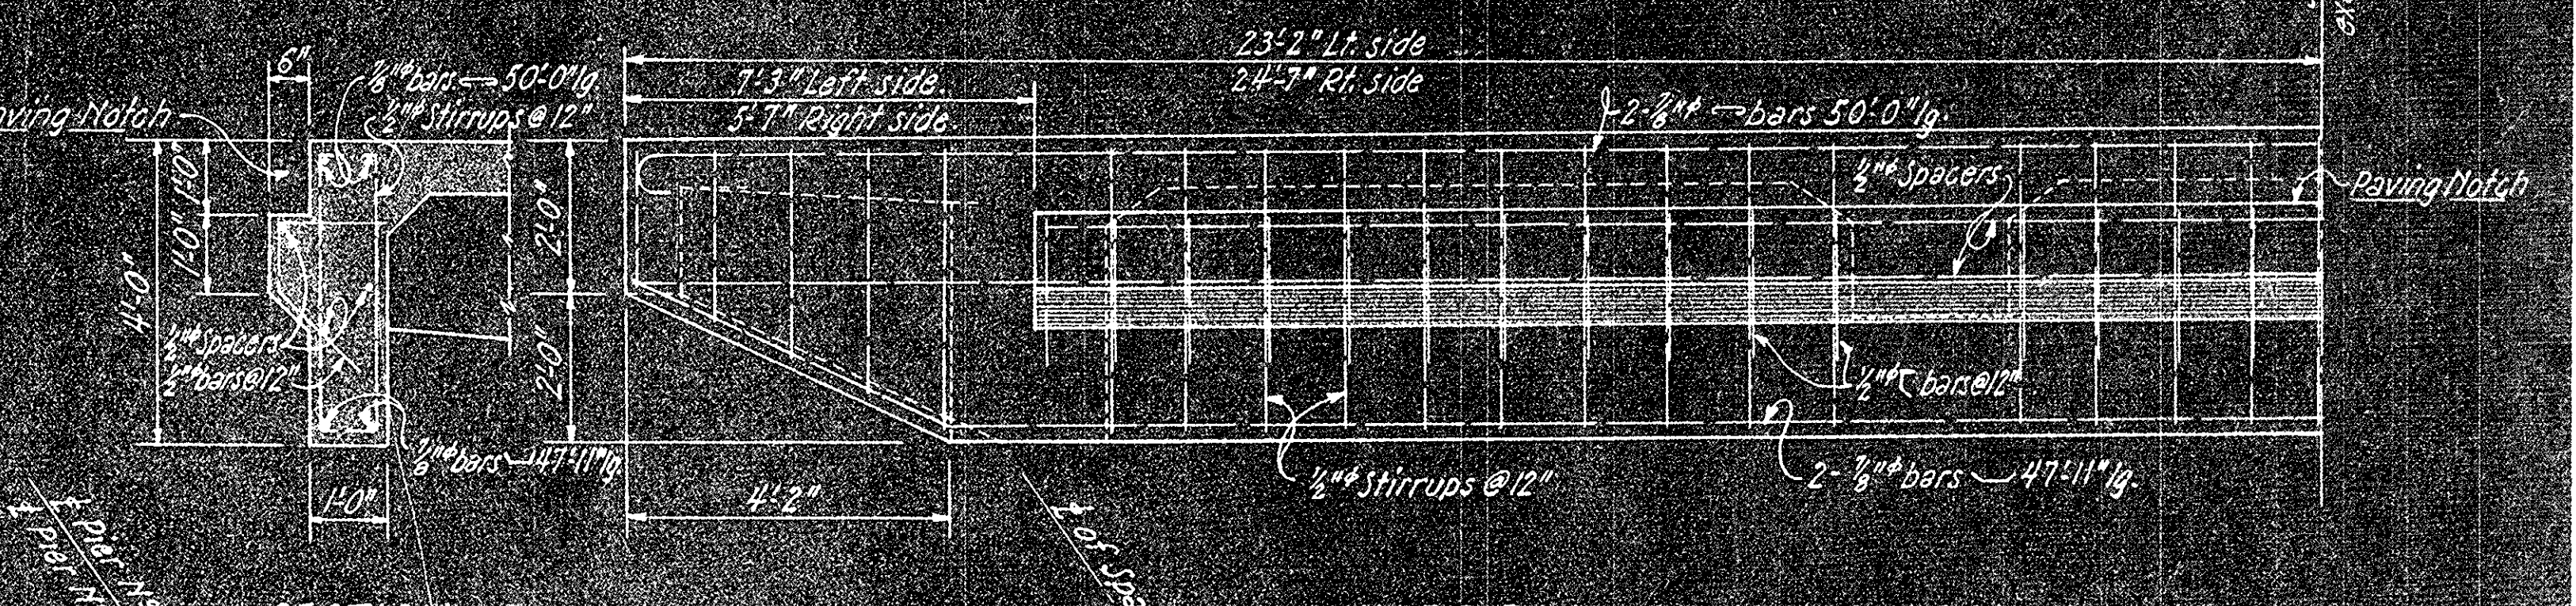
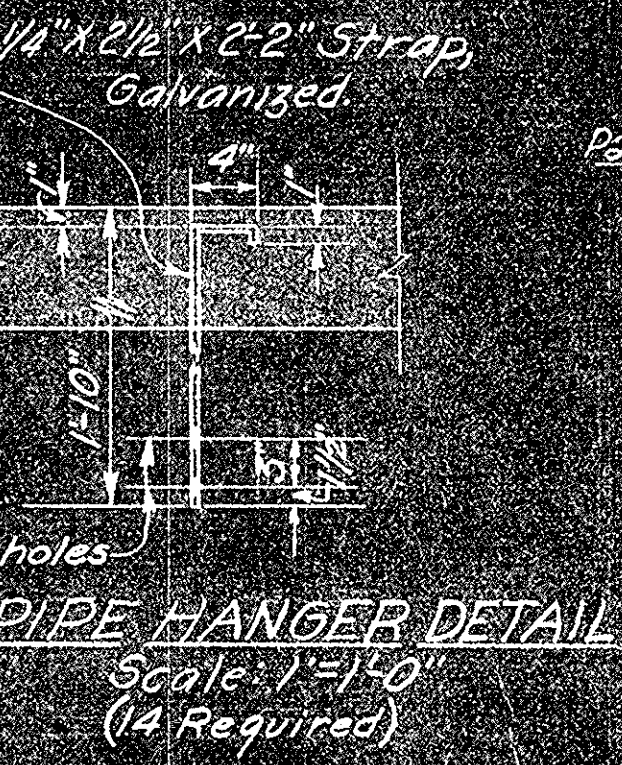
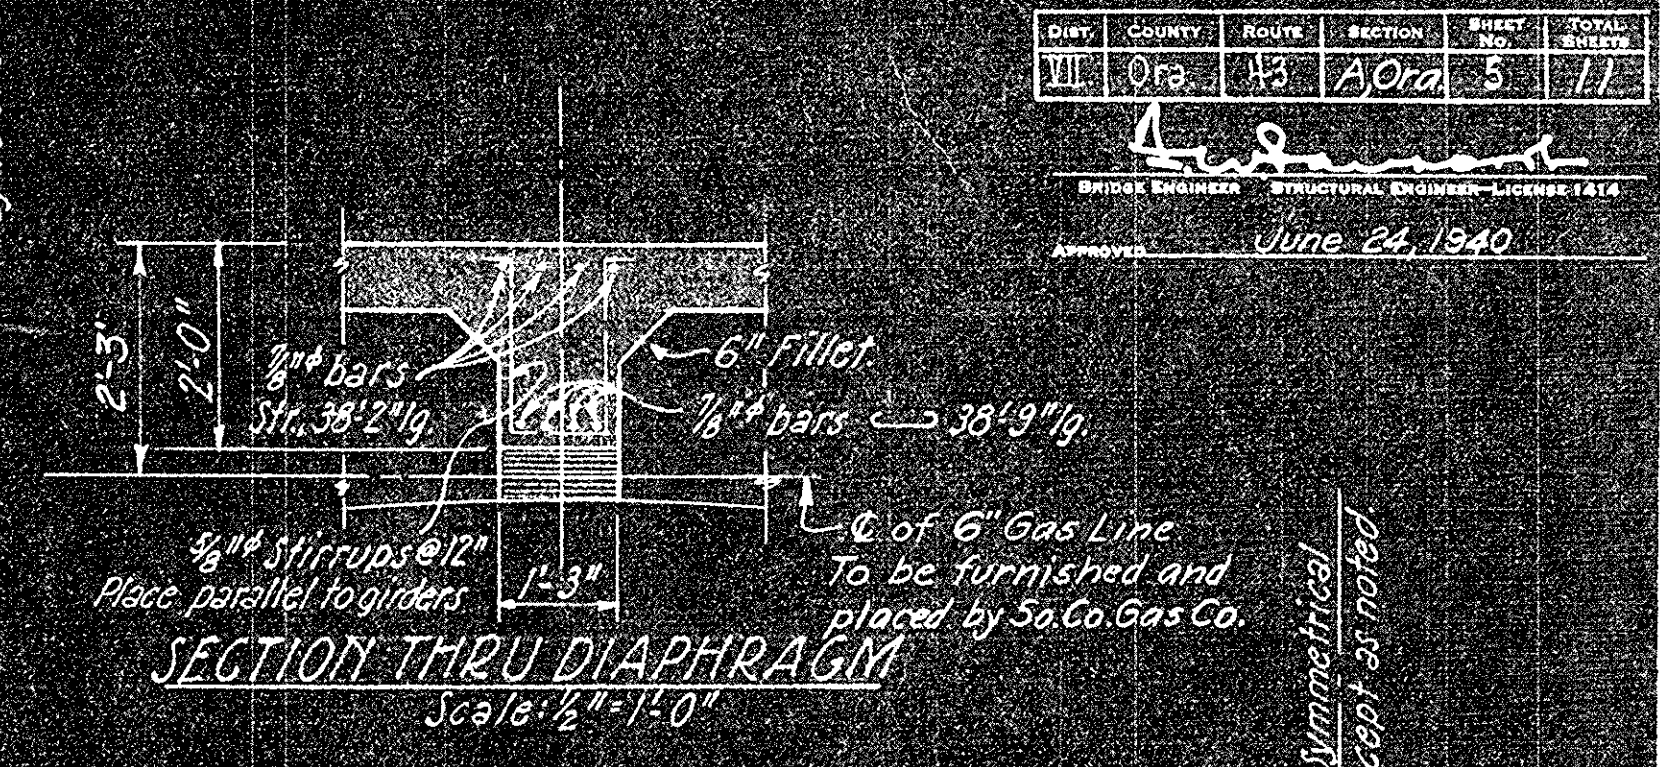
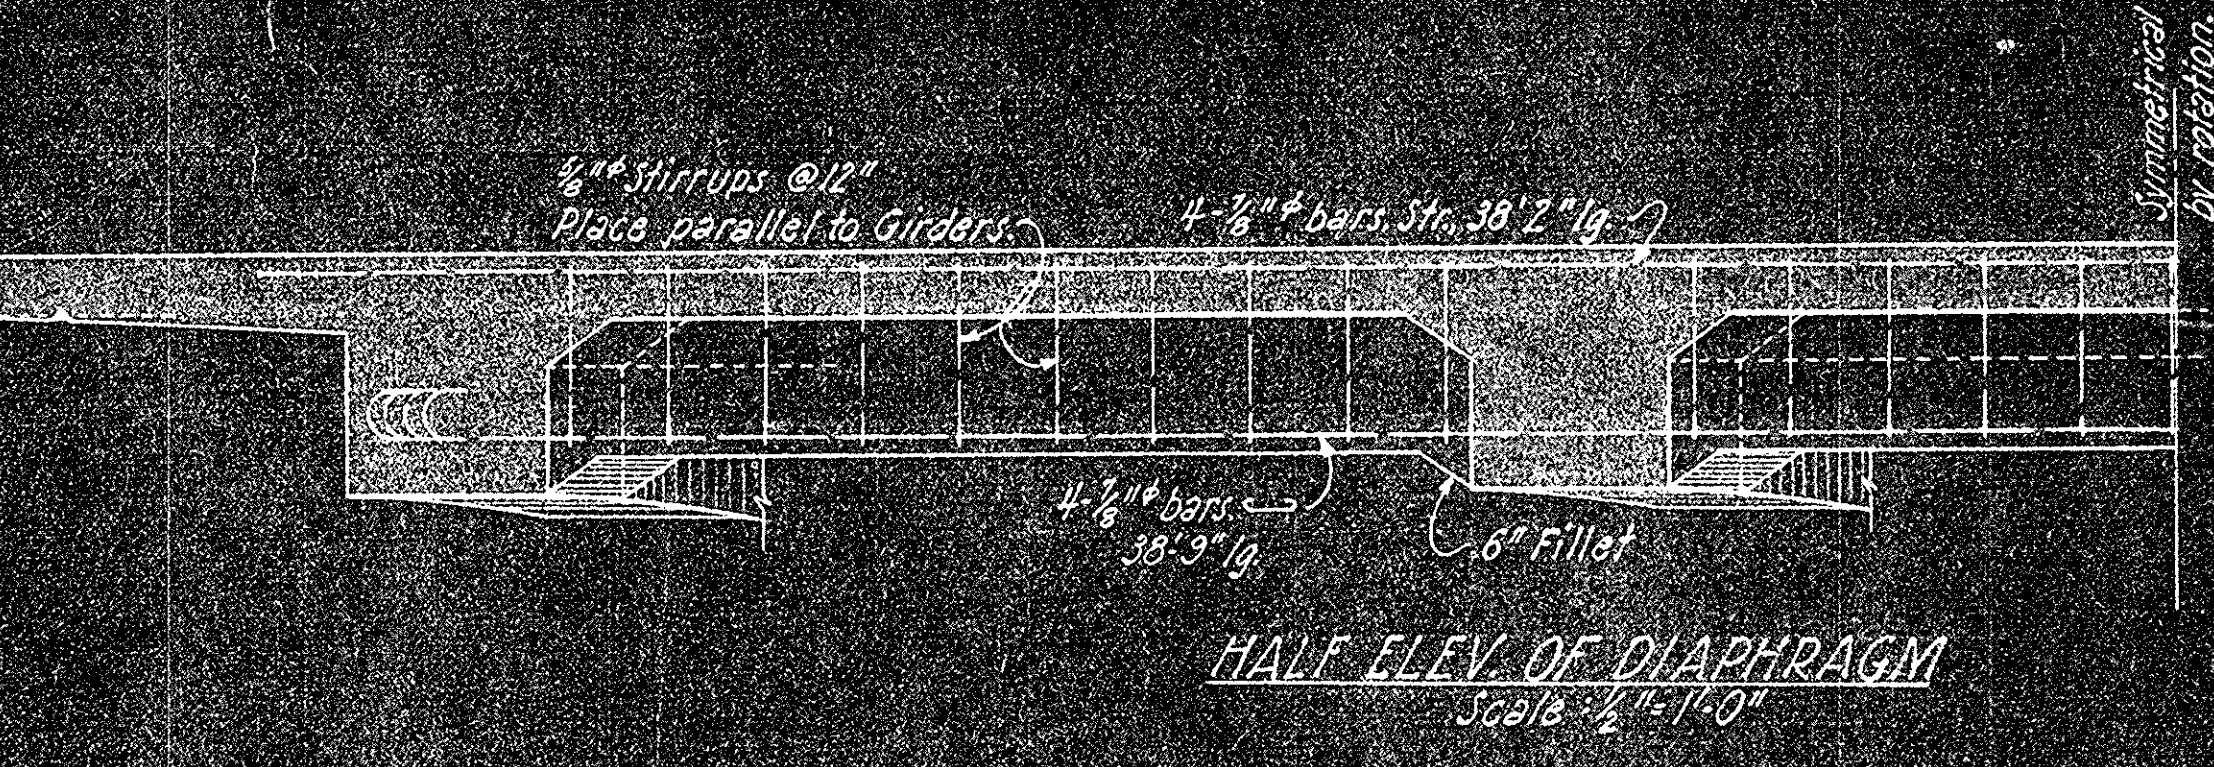


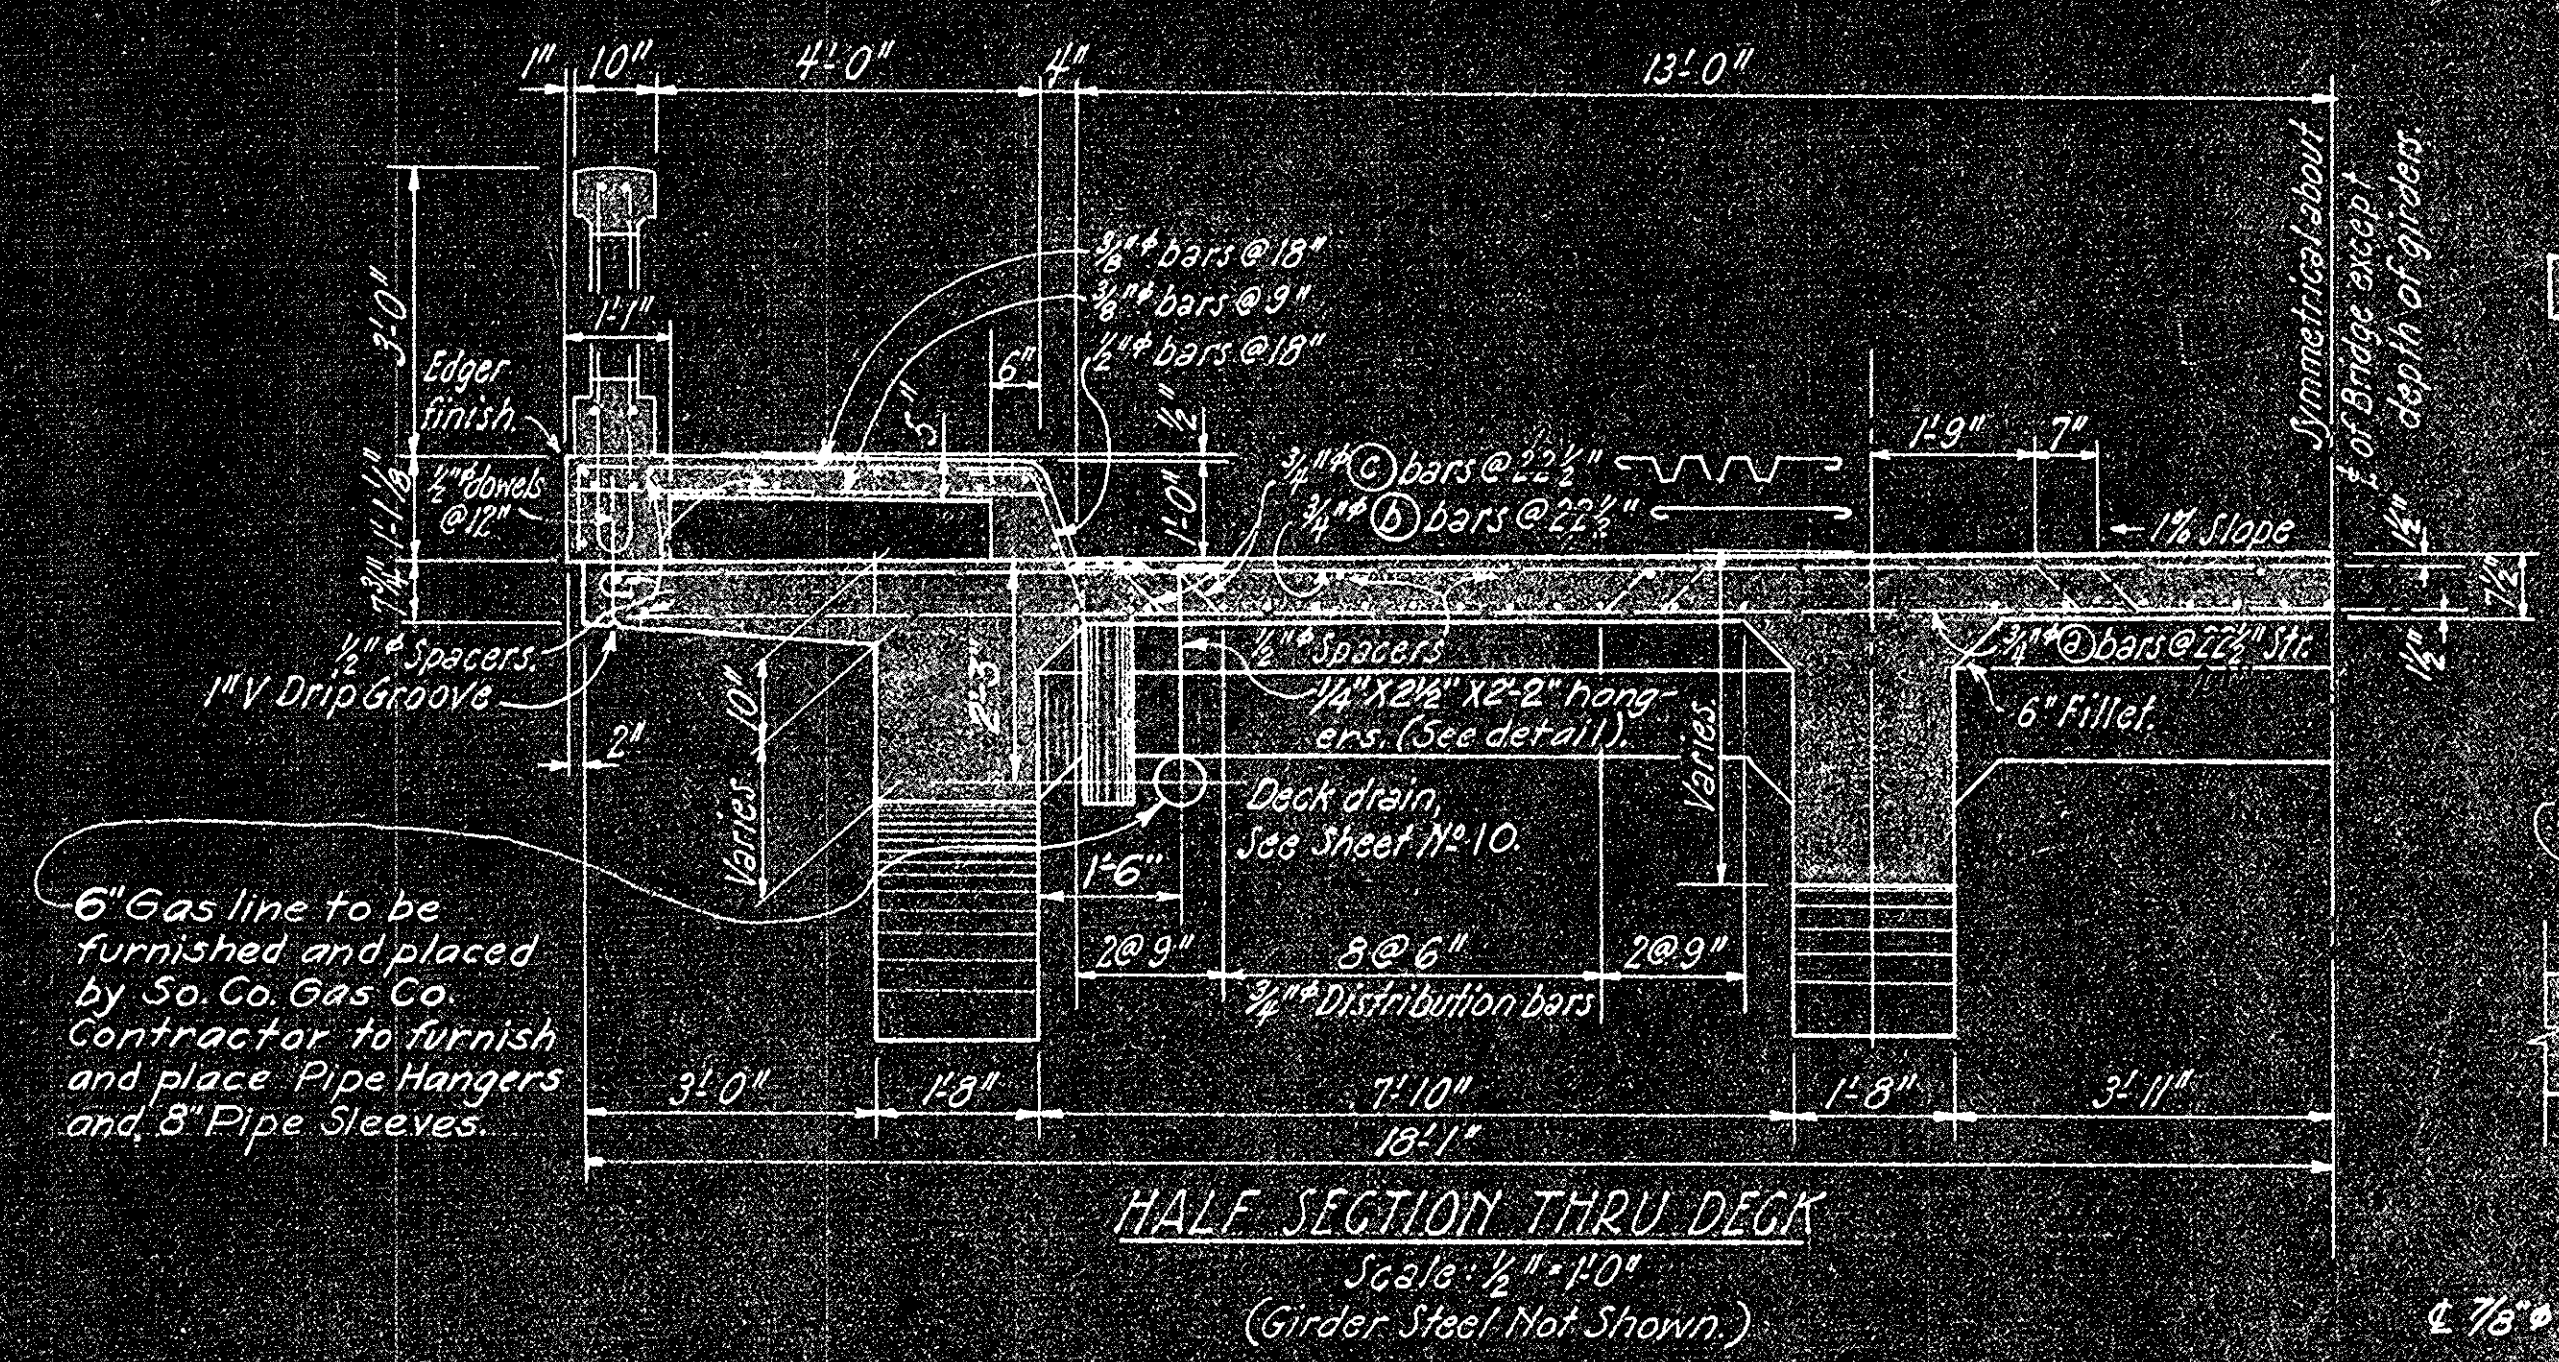

55C-43
 State Highway Bridge
 Sheet 6 of 12
 Red 22.5:1 Scale as shown
 Blueprint

BRIDGE ACROSS SANTIAGO CREEK	
DECK PLAN AND SECTIONS	
SCALE: As Shown	FILE NO.
BRIDGE NO. 55-33	DRAWING NO. C-1144-5

STATE OF CALIFORNIA
 DEPARTMENT OF HIGHWAYS
 BRIDGE DIVISION

Project No.	Sheet No.	Date
55C-43	6	6-24-40
55C-43	5	6-24-40
55C-43	4	6-24-40
55C-43	3	6-24-40
55C-43	2	6-24-40
55C-43	1	6-24-40