


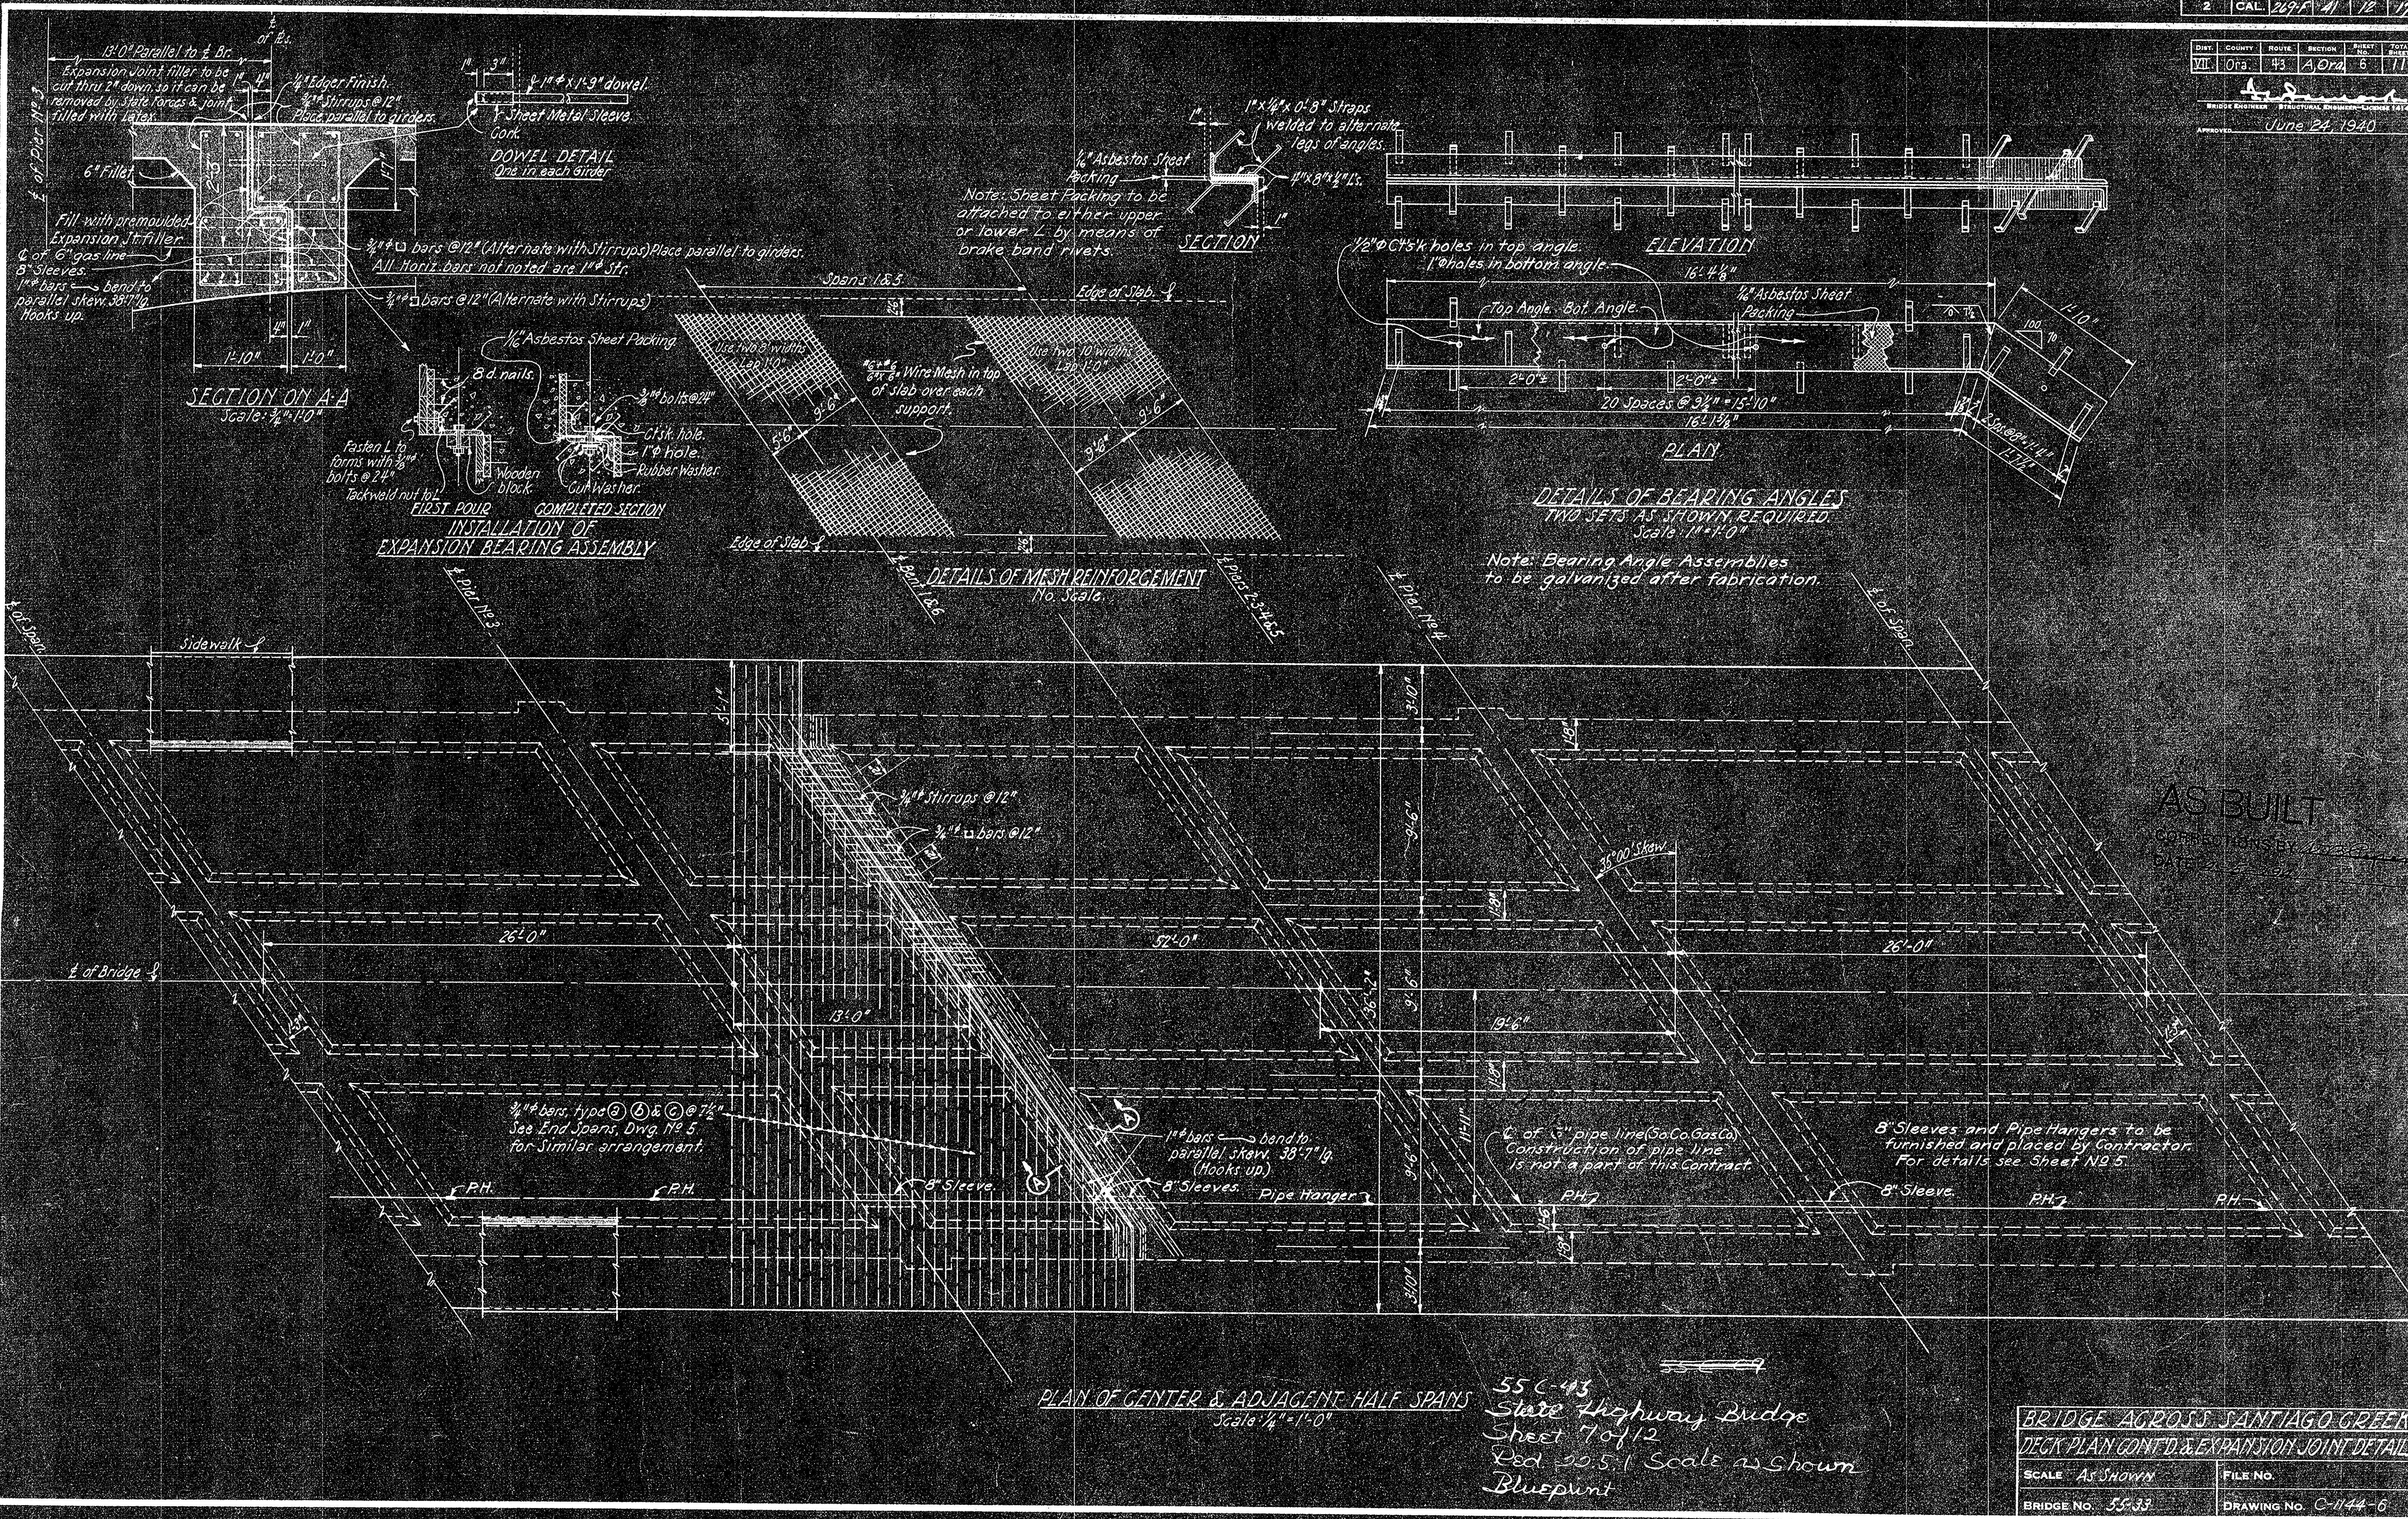

STATE OF CALIFORNIA
 DEPARTMENT OF HIGHWAYS
 DIVISION OF HIGHWAYS

Drawn by	Checked by	Date
W. C. ...	W. C. ...	4-20-40
W. C. ...	W. C. ...	5-2-40
W. C. ...	W. C. ...	5-10-40
W. C. ...	W. C. ...	5-20-40

55C-43
 State Highway Bridge
 Sheet 7 of 12
 Red 20.5:1 Scale as shown
 Blueprint