
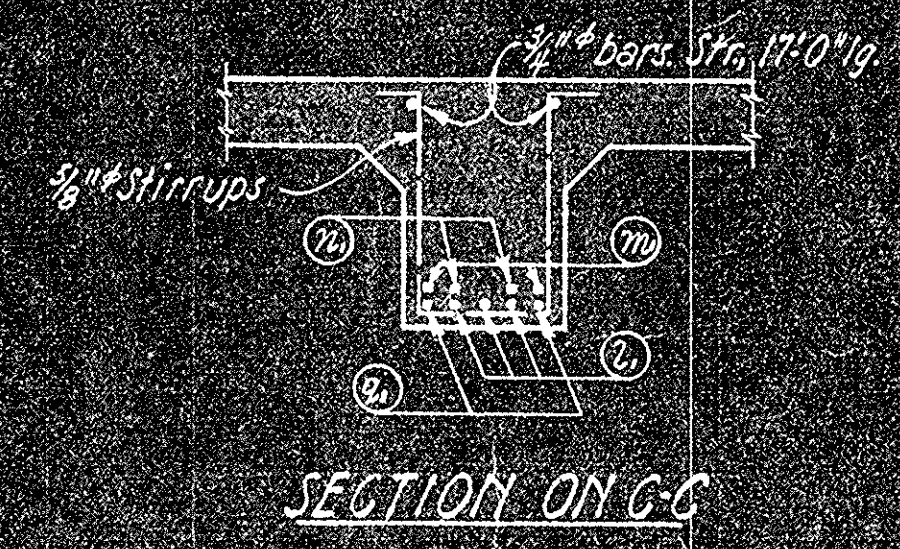
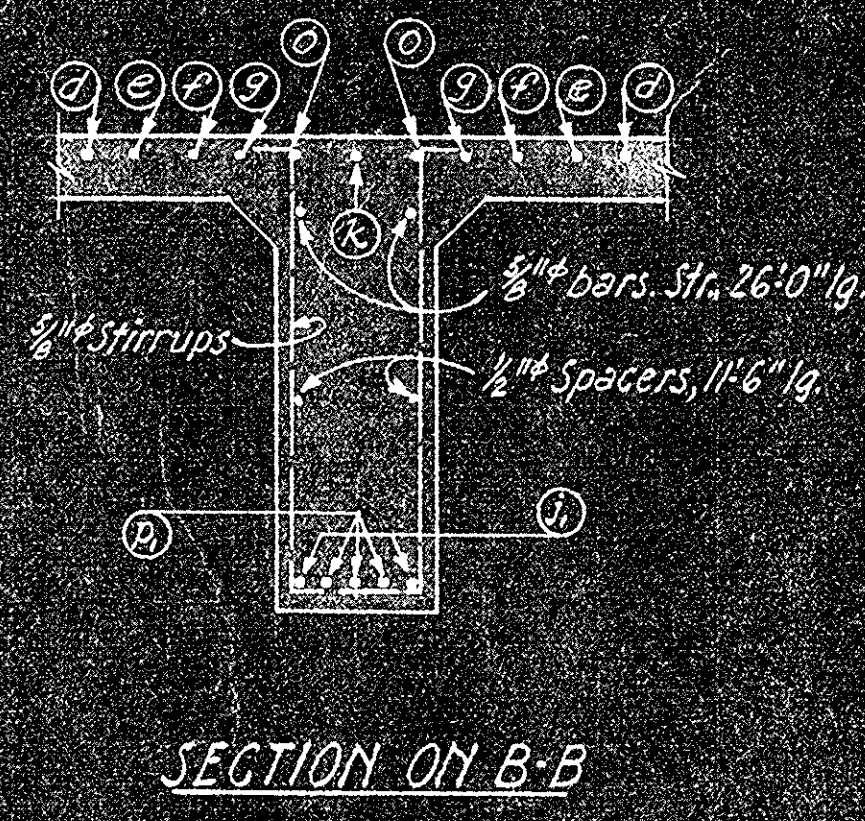


STATE OF CALIFORNIA
 DEPARTMENT OF PUBLIC WORKS
 BRIDGE DIVISION

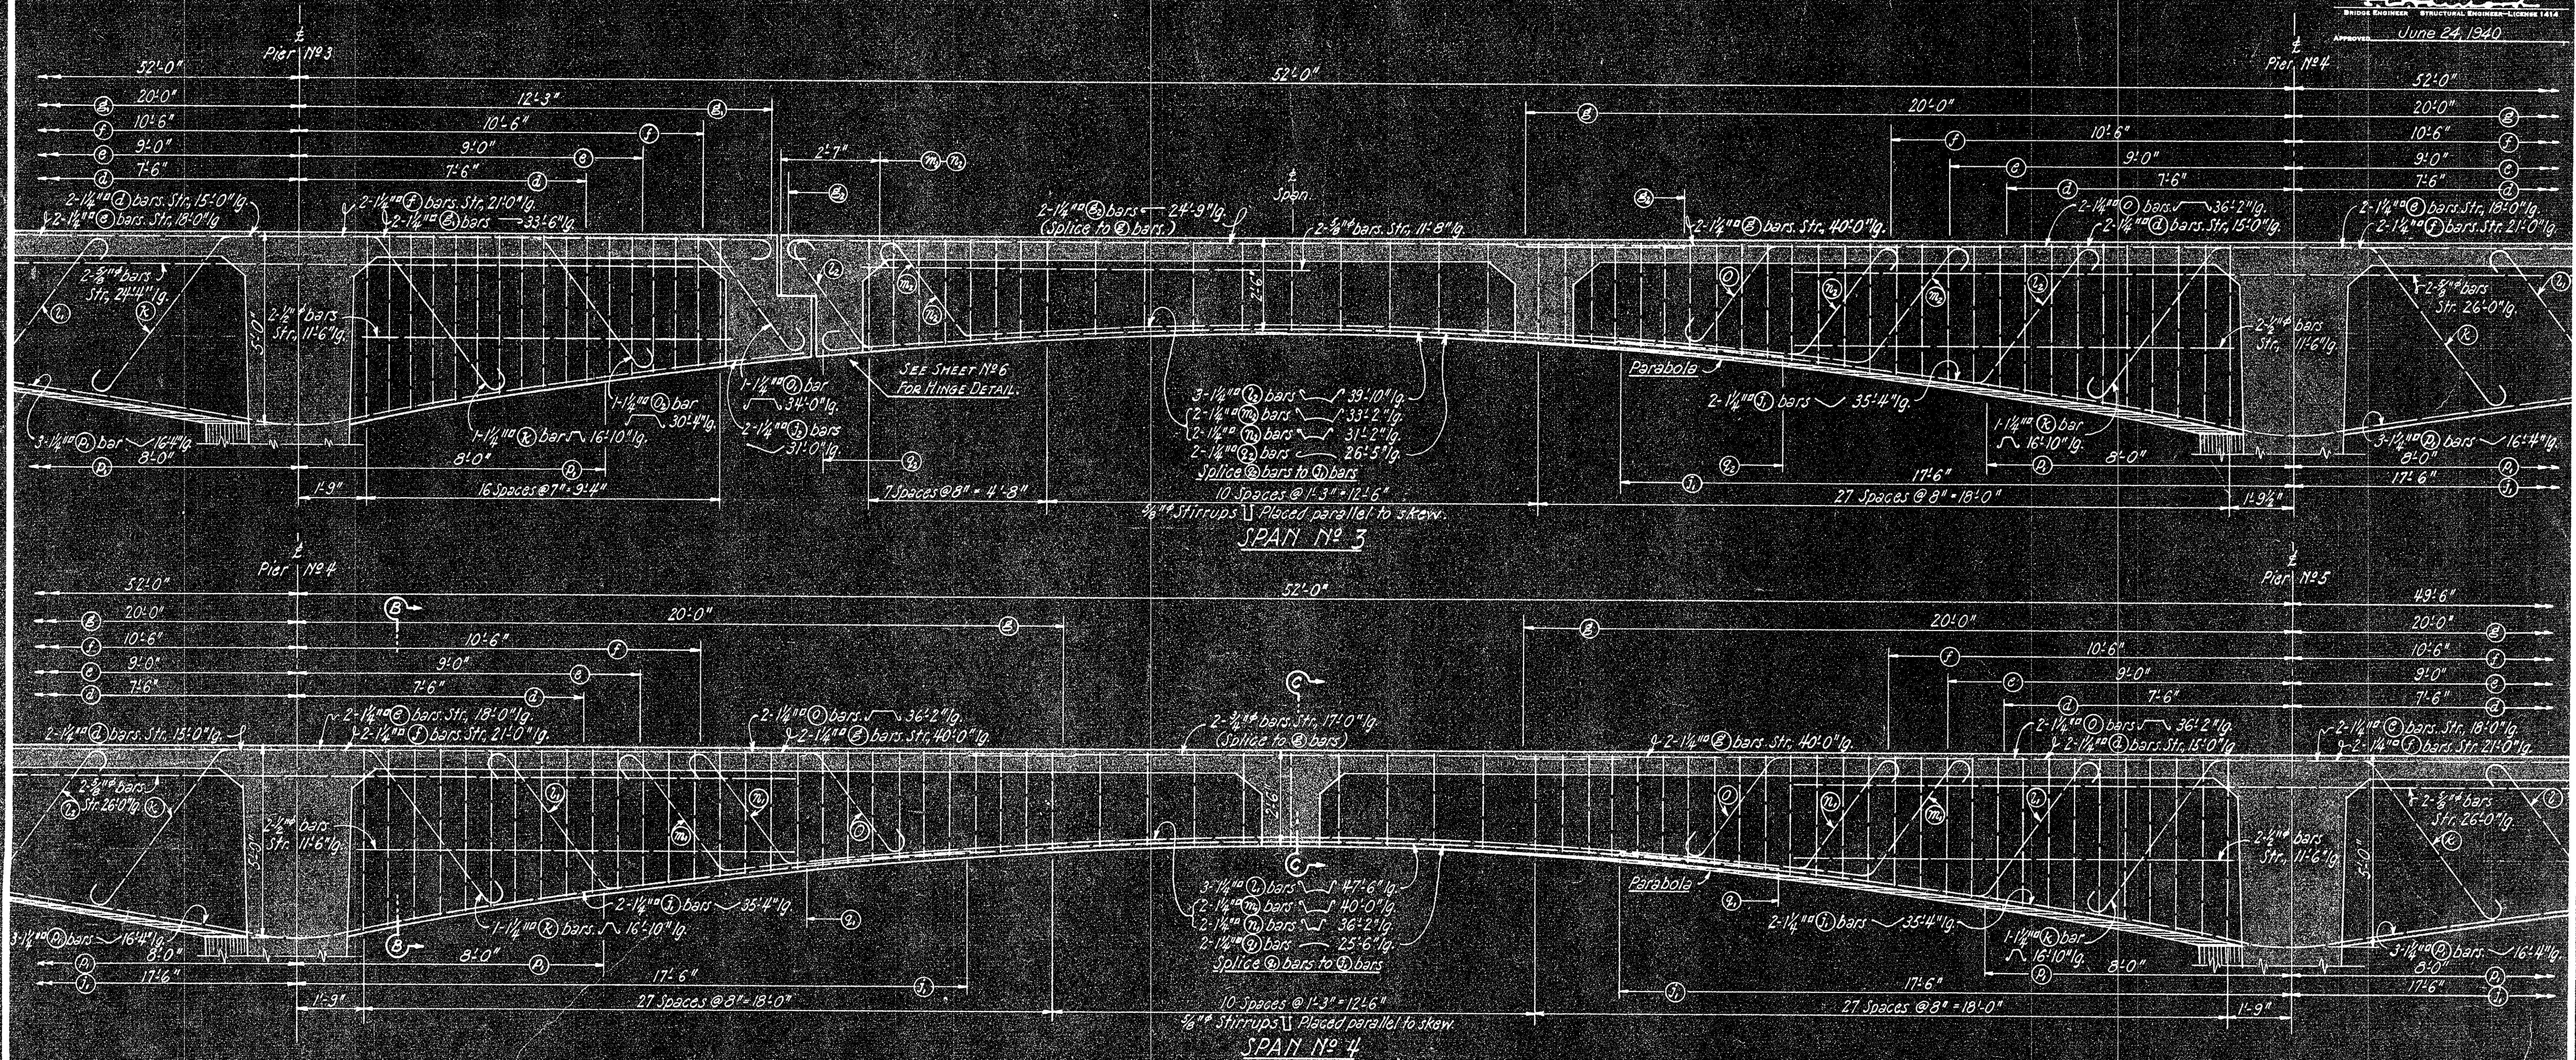

55C-43
 State Highway Bridge
 Sheet 9 of 12
 Red 22.5:1 Scale 1/2" = 1'
 Blue print

BRIDGE ACROSS SANTIAGO CREEK	
GIRDER DETAILS CONTINUED	
SCALE 1/2" = 1'-0"	FILE NO.
BRIDGE NO. 55-33	DRAWING NO. C-1144-B