

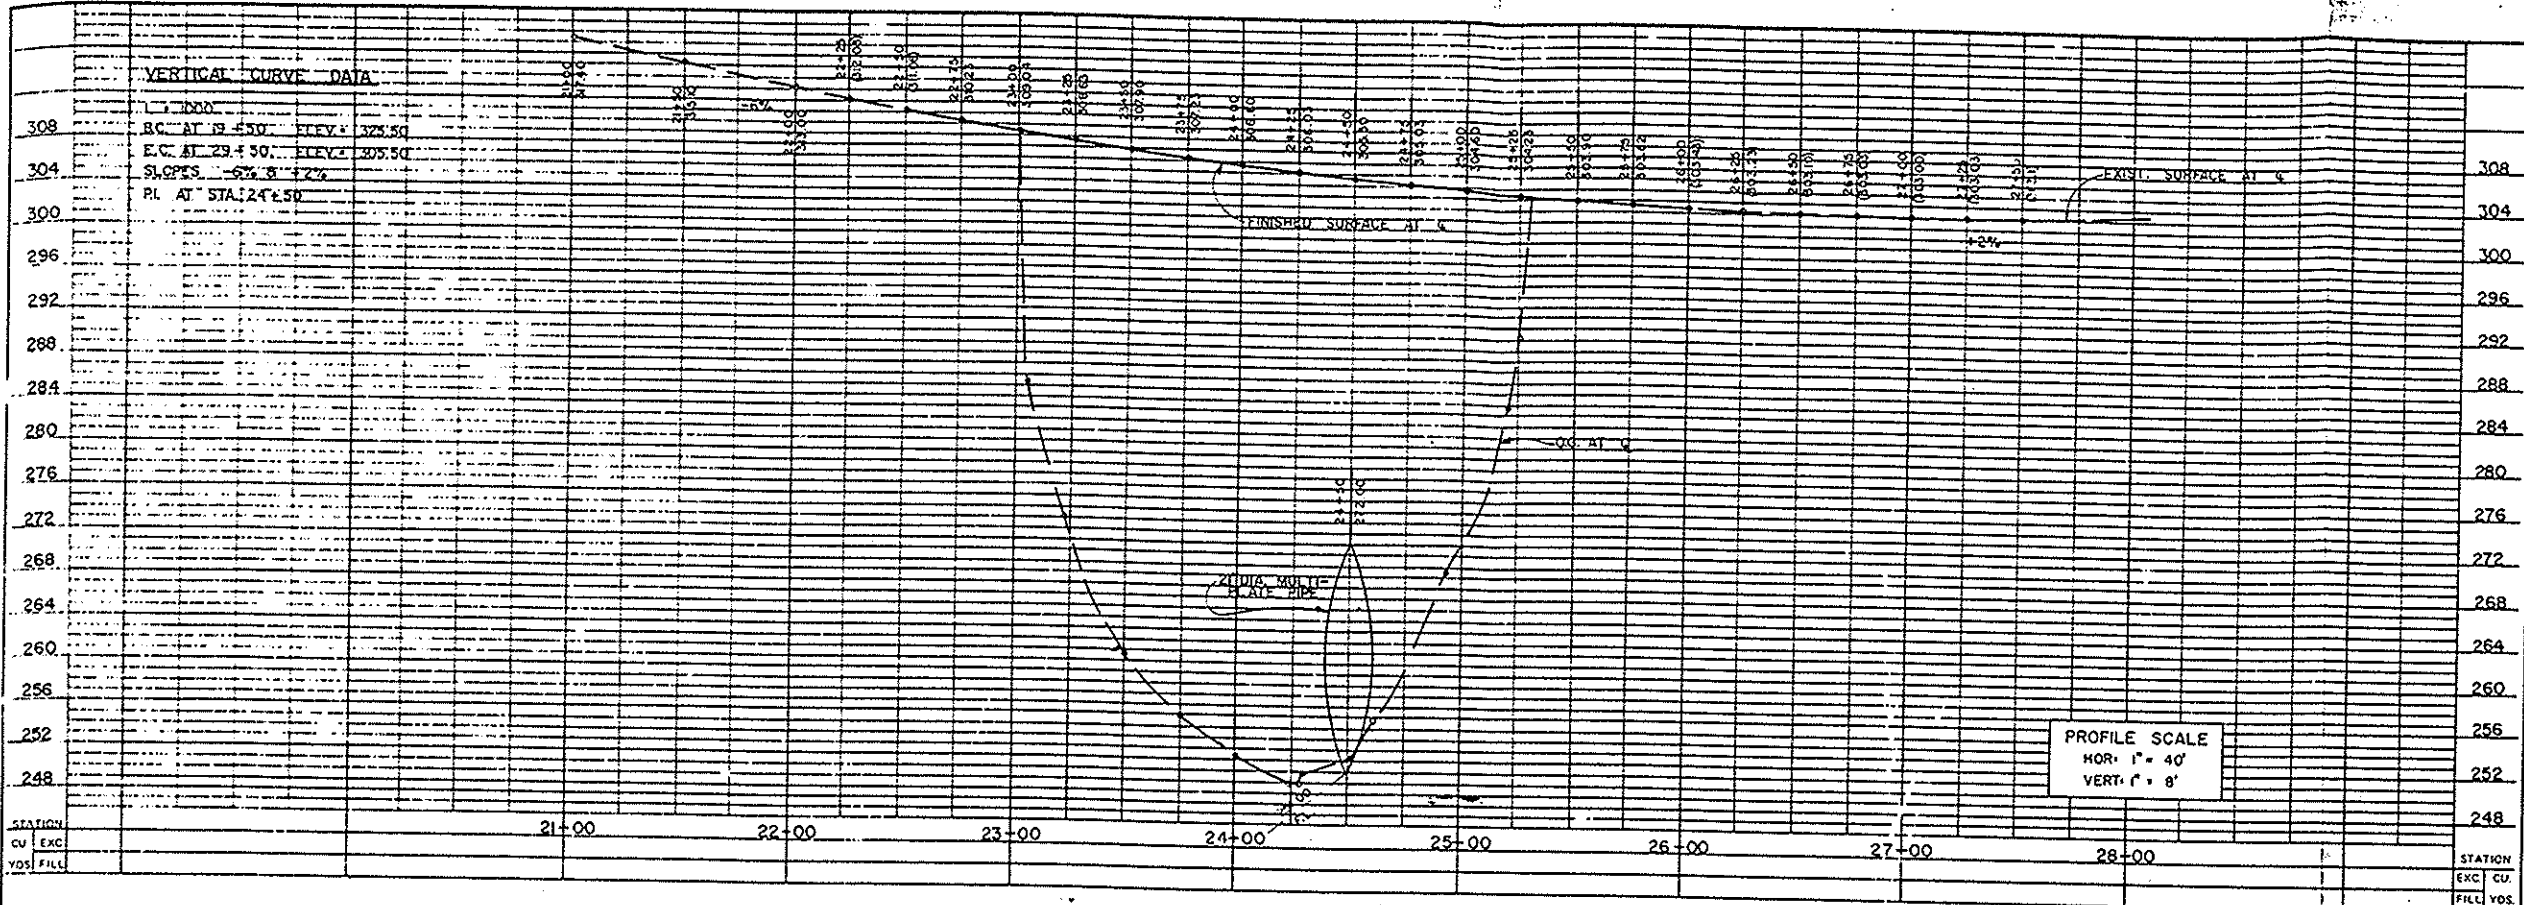


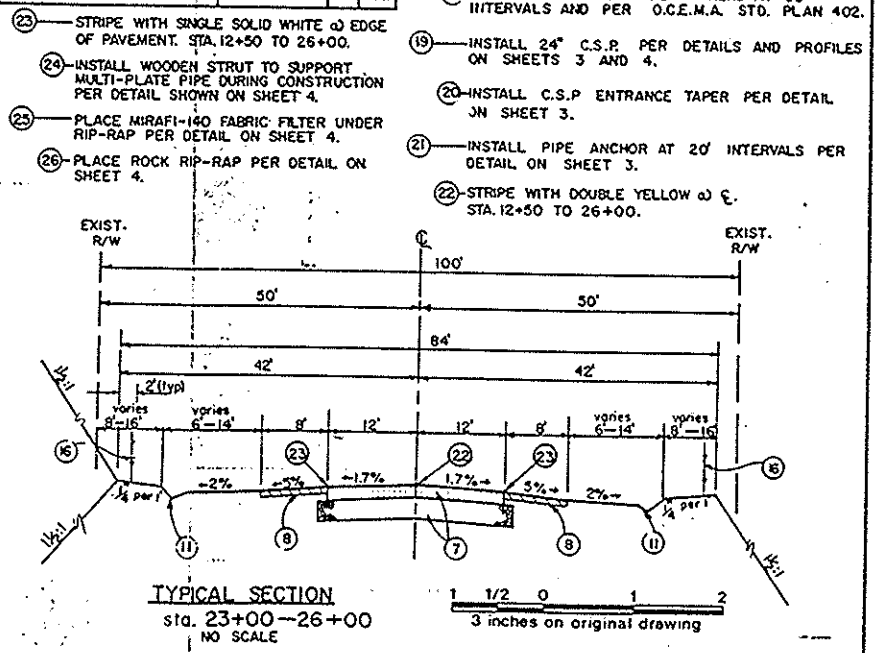

CONSTRUCTION NOTES

- ① JOIN EXISTING.
- ② SAWCUT PAVEMENT.
- ③ REMOVE DAMAGED FENCE.
- ④ REMOVE A.C. DIKE.
- ⑤ REMOVE 8' A.C. DITCH
- ⑥ REMOVE A.C. PAVEMENT AND AGGREGATE BASE.
- ⑦ CONSTRUCT 4" A.C. OVER 8" A.B.
- ⑧ CONSTRUCT 3" A.C. OVER NATIVE SOIL SHOULDER.
- ⑨ CONSTRUCT 8" A.C. DIKE PER O.C.E.M.A. STANDARD PLAN 201.
- ⑩ CONSTRUCT 8' WIDE A.C. DITCH PER DETAIL ON SHEET 3.
- ⑪ CONSTRUCT 6' WIDE A.C. DITCH PER DETAIL ON SHEET 3.
- ⑫ RECONSTRUCT A.C. DITCH TO MATCH EXISTING.
- ⑬ CONSTRUCT REINFORCED CONCRETE PARAPET WALL, COLLAR HEADWALL, FOOTING AND CUTOFF WALL AT EACH END OF PIPE PER DETAILS SHOWN ON SHEET 3.
- ⑭ INSTALL 21" DIAMETER CORRUGATED STEEL MULTI-PLATE PIPE (GAGE NO. 5) PER DETAILS ON SHEET 4 AND PER MANUFACTURER DETAILS AND PROCEDURES.
- ⑮ CONSTRUCT GROUTED RIP-RAP PER DETAILS AND DIMENSIONS ON SHEET 4.
- ⑯ CONSTRUCT CHAIN LINK FENCE CL-5 PER O.C.E.M.A. STD. PLAN 412.
- ⑰ CONSTRUCT GROUTED RIP-RAP FOR DITCH PER DETAIL ON SHEET 3.
- ⑱ PLACE F-1 TYPE GUIDE MARKERS AT 50' INTERVALS AND PER O.C.E.M.A. STD. PLAN 402.
- ⑲ INSTALL 24" C.S.P. PER DETAILS AND PROFILES ON SHEETS 3 AND 4.
- ⑳ INSTALL C.S.P. ENTRANCE TAPER PER DETAIL ON SHEET 3.
- ㉑ INSTALL PIPE ANCHOR AT 20' INTERVALS PER DETAIL ON SHEET 3.
- ㉒ STRIPE WITH DOUBLE YELLOW ω C. STA. 12+50 TO 26+00.

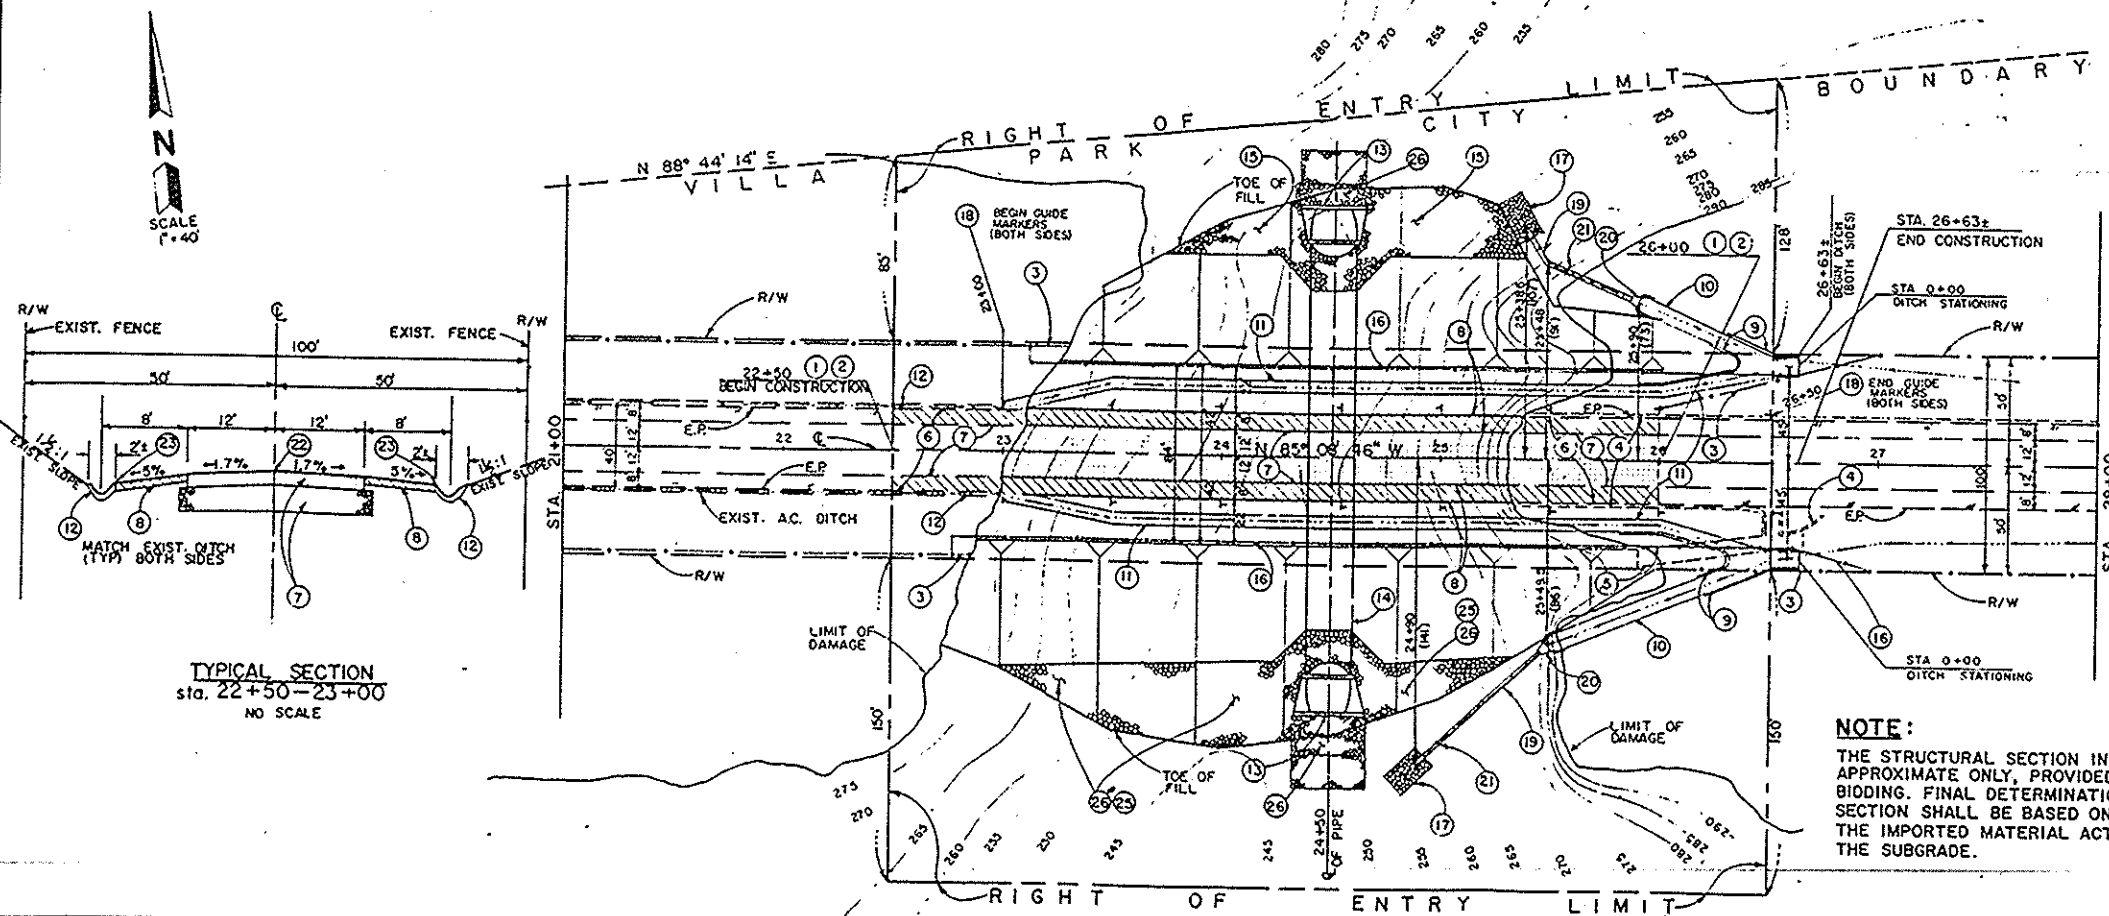

ORANGE COUNTY
ENVIRONMENTAL MANAGEMENT AGENCY

VILLA PARK ROAD PLAN VIEW AND PROFILE

DATE	DESCRIPTION	PREPARED UNDER	DATE	SHEET
DESIGNED: M. KADER	REVISIONS	SUPERVISION OF: J. D. [Signature]	DATE	2/9
DRAWN: RHA	SCALE	DATE	DATE	
	AS SHOWN			