

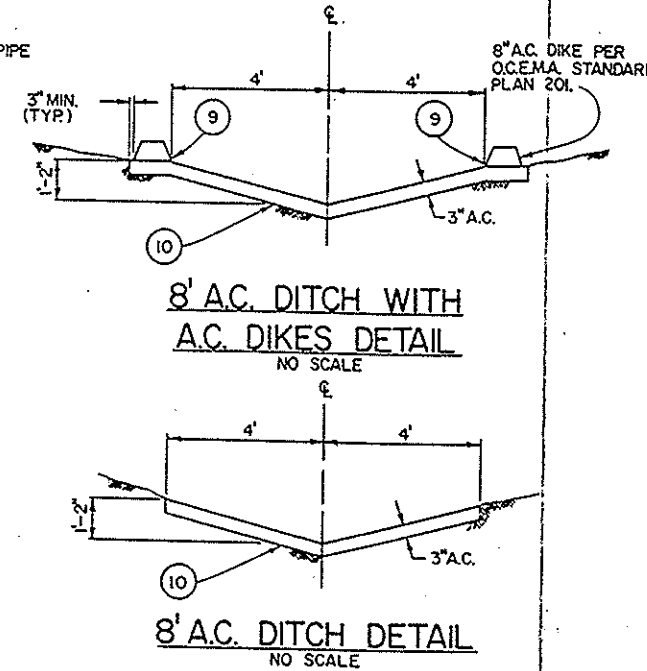
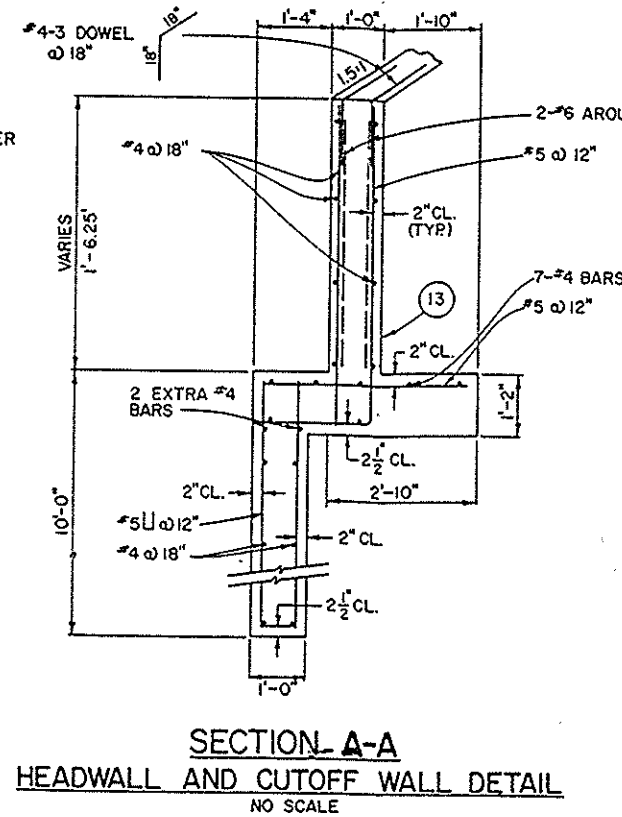
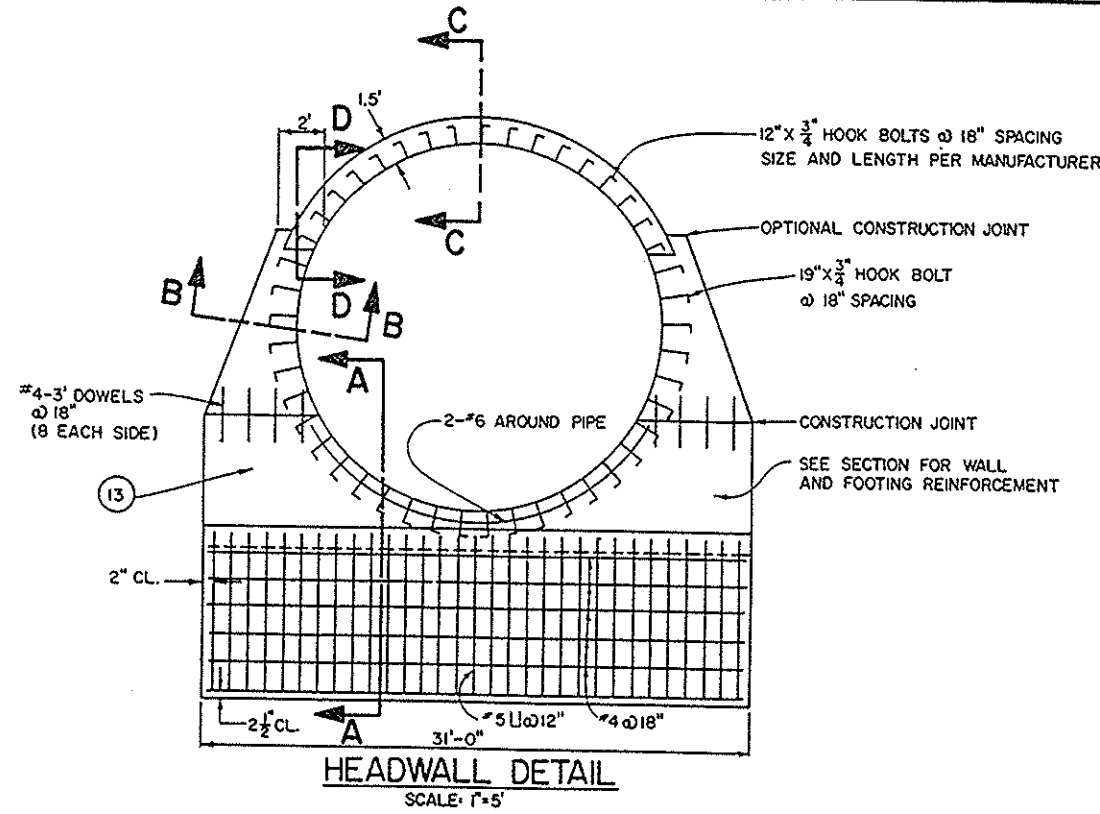








6' A.C. DITCH DETAIL
NO SCALE

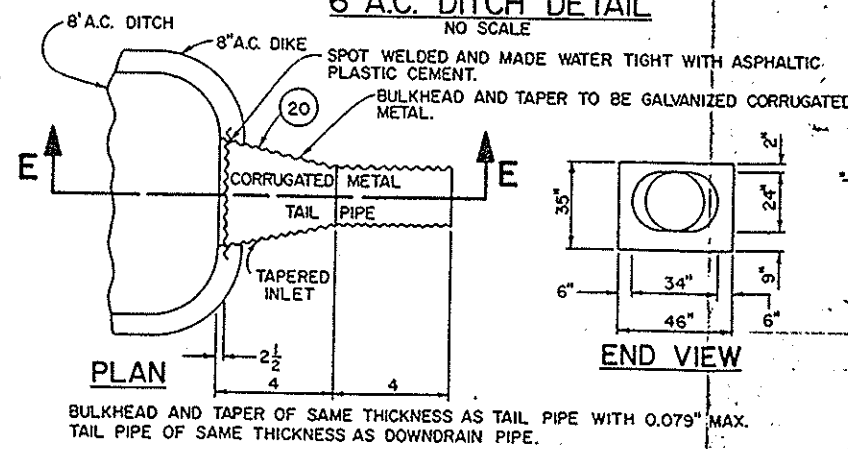

24" C.S.P. ENTRANCE TAPER
NO SCALE

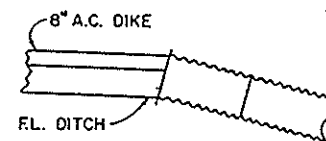


SECTION E-E
NO SCALE

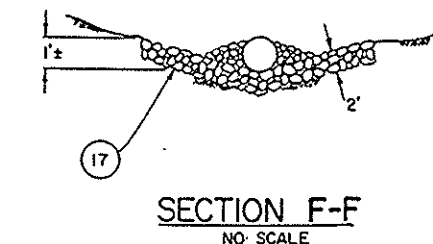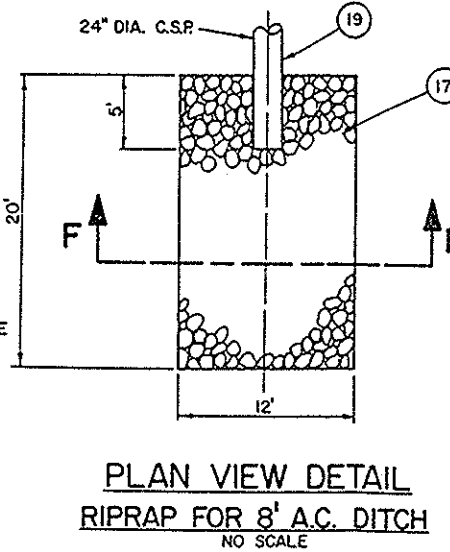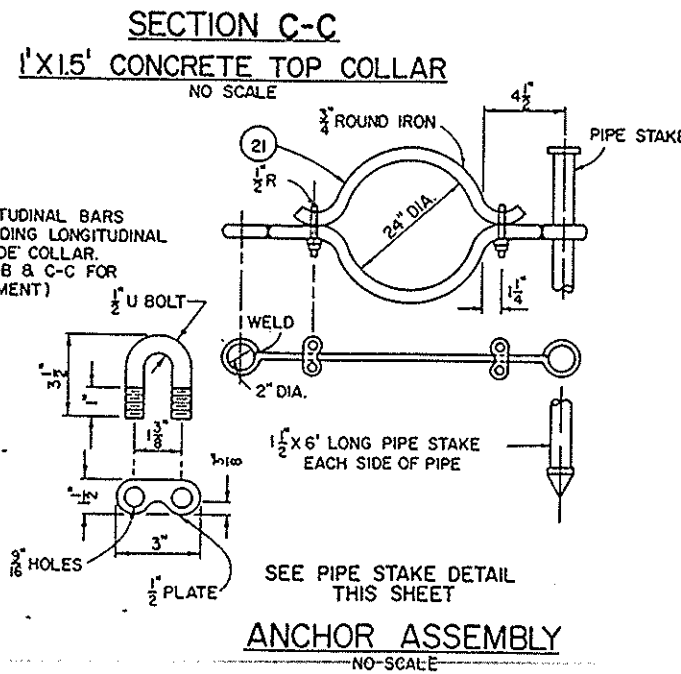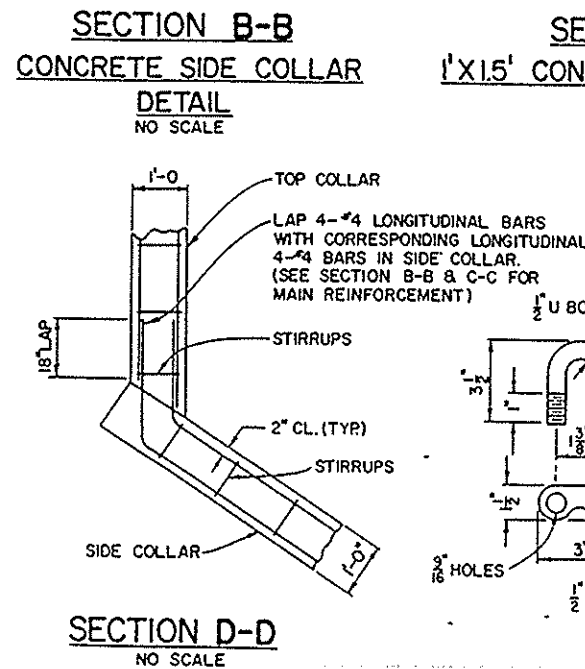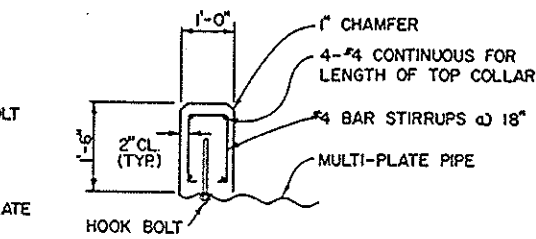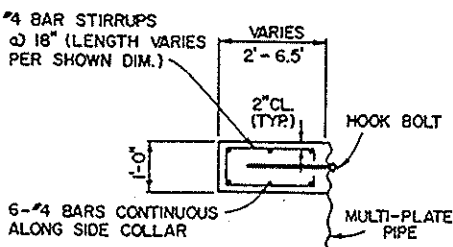

SECTION F-F
NO SCALE

CONSTRUCTION NOTES

9. CONSTRUCT 8-INCH ASPHALT CONCRETE DIKE PER OCEMA STD. PLAN 201.
10. CONSTRUCT 8-FOOT WIDE ASPHALT CONCRETE DITCH.
11. CONSTRUCT 6-FOOT WIDE ASPHALT CONCRETE DITCH PER DETAIL ON SHEET 3.
13. CONSTRUCT REINFORCED CONCRETE PARAPET WALL, COLLAR, HEADWALL, FOOTING AND CUTOFF WALL AT EACH END OF PIPE PER DETAILS SHOWN ON SHEET 3.
17. CONSTRUCT GROUTED RIPRAP FOR DITCH PER DETAIL ON SHEET 3.
19. INSTALL 24" C.S.P. PER DETAILS AND PROFILES ON SHEETS 3 & 4.
20. INSTALL C.S.P. ENTRANCE TAPER PER DETAIL ON SHEET 3.
21. INSTALL PIPE ANCHOR AT 20' INTERVALS PER DETAIL ON SHEET 3.

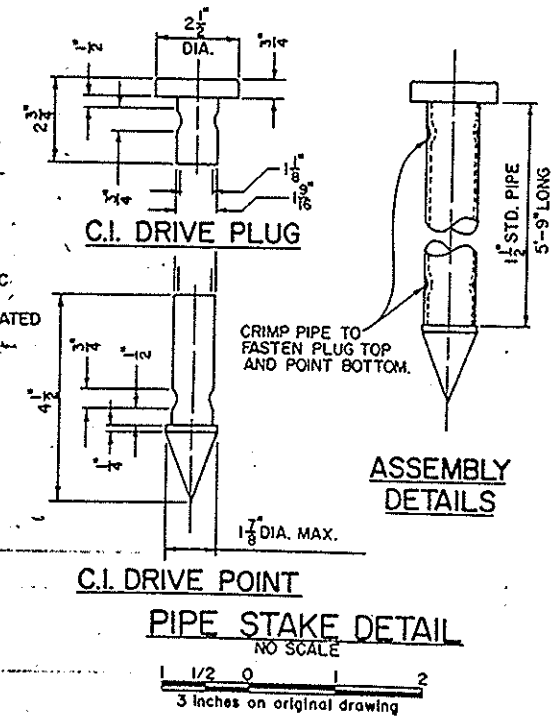

C.I. DRIVE POINT

PIPE STAKE DETAIL
NO SCALE

1 1/2 0 1 2
3 inches on original drawing

ORANGE COUNTY ENVIRONMENTAL MANAGEMENT AGENCY			
VILLA PARK ROAD			
DETAIL SHEET			
DATE	DESCRIPTION	PREPARED UNDER	SHEET
REVISIONS		SUPERVISION OF	3/9
DRAWN BY	M. KADER	SCALE	DATE
CHECKED BY		AS SHOWN	DWG. NO.