


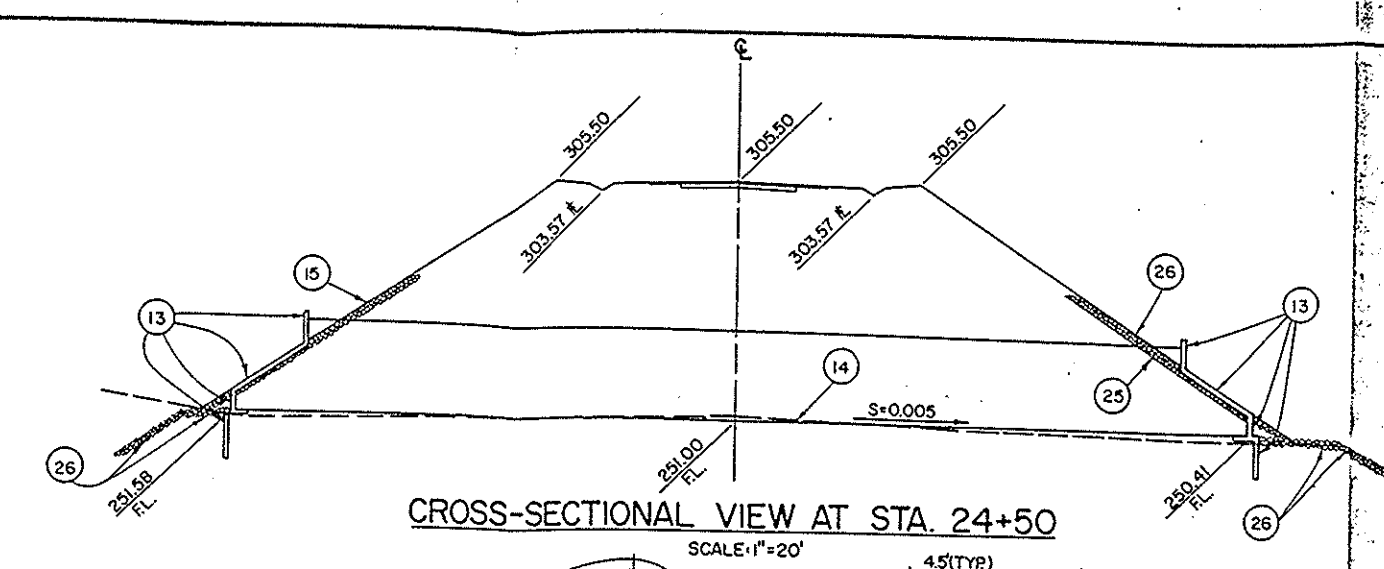

SCALE: 1"=20'

		ORANGE COUNTY ENVIRONMENTAL MANAGEMENT AGENCY	
		VILLA PARK ROAD	
		DETAIL SHEET	
MARK	DATE	DESCRIPTION	PREPARED UNDER SUPERVISION OF <i>L.D. Hanks Jr. / g/f/r</i>
REVISIONS			DATE
DESIGNED	<i>M. KADER</i>	SCALE	SHEET <i>4</i> <i>9</i>
DRAWN	<i>A.A.</i>	CHECKED <i>J.D.</i>	
		DATE	DWG. NO.